

Environmental Programs

P.O. Box 1663, MS M991

Los Alamos, New Mexico 87545

(505) 606-2337/FAX (505) 665-1812

OS



National Nuclear Security Administration

Los Alamos Site Office, MS A316

Environmental Restoration Program

Los Alamos, New Mexico 87544

(505) 667-4255/FAX (505) 606-2132

Date: **NOV 03 2011**

Refer To: EP2011-0368

John Kieling, Acting Bureau Chief
Hazardous Waste Bureau
New Mexico Environment Department
2905 Rodeo Park Drive East, Building 1
Santa Fe, NM 87505-6303

Subject: Submittal of the Fact Sheets for Regional Well R-62

Dear Mr. Kieling:



Enclosed please find two hard copies with electronic files of the Fact Sheets for R-62. Because several challenges were encountered during completion of this well, Los Alamos National Laboratory (the Laboratory) is including a brief narrative of the backfilling operations in this letter. Additional detail will be provided in the well completion report that will be submitted by March 1, 2012.

An annular seal was set at the base of the 16-in. casing at 672 to 708 ft below ground surface (bgs), before the 12-in. casing was advanced. Drilling continued with the 12-in. casing to a total depth of 1260 ft after which the borehole collapsed to 1239 ft. A single-screen, 5-in.-diameter well was built and properly completed, as depicted in the attached R-62 fact sheet. A calculated volume of 745.3 ft³ of annular backfill was needed to complete the well. The actual volume of material used to backfill the well was 733.7 ft³, which was 98.4% of the calculated volume (from the point when the 16-in. casing was stuck).

The borehole had been backfilled to 952 ft bgs with bentonite chips/pellets, when a 954-ft section of 12-in. casing was dropped down hole and lodged in the bentonite at 1004 ft bgs. The annular space between the outside of the 5-in. well casing and the inside of the 12-in. drill casing was then filled with bentonite chips and hydrated.

After lifting the 16-in. casing several inches, it became apparent that it was stuck in the borehole and 666 ft was left in place. A modified completion plan was submitted to and approved by the New Mexico Environment Department. In the plan, the Laboratory proposed to fill the annulus with a combination of Barotherm Gold bentonite grout (28% solids) and a cement mix.

To ensure optimal cure time and proper placement, the bentonite grout was tremied down hole in multiple lifts (from 952 to 600 ft bgs) to seal off the annular space between the 12-in. casing and the 16-in. casing and between the borehole wall and the 12-in. casing below the 16-in. casing. The



Laboratory ran gamma logs after each lift to evaluate the grout placement. After the grout was emplaced between the 12-in. and 16-in. casing, the 16-in. casing was sealed and pressurized to 40 pounds per square inch to force the grout between the casing and the borehole wall to form a tight seal. After the pressure test was determined to have been successful, bentonite grout was placed between the borehole wall and the outside of the 16-in. casing from 952 to 50 ft bgs.

A 20-ft lift of neat cement was pumped into the interval above the bentonite and allowed to cure for 12-plus hours. Then, a cement mix was placed in the annular space between the 12-in. and 16-in. casing, between the 5-in. and the 16-in. casing, and between the borehole wall and the 16-in. casing (see as-built diagram included with the R-62 fact sheets). Upon completion of backfilling activities, the Laboratory ran another gamma log to further evaluate the grout and cement placement. Examples of the gamma logs are attached. Figure 1 is the gamma log collected after the second lift of bentonite was added up to a target depth of 800 ft bgs, and Figure 2 is the gamma log collected after backfilling was completed.

If you have any questions, please contact Ted Ball at (505) 665-3996 (tedball@lanl.gov) or Woody Woodworth at (505) 665-5820 (lance.woodworth@doe.nnsa.gov).

Sincerely,

Handwritten signature of Michael J. Graham in blue ink, appearing to read "B-G Schynell for M.J.G."

Michael J. Graham, Associate Director
Environmental Programs
Los Alamos National Laboratory

Sincerely,

Handwritten signature of George J. Rael in blue ink, appearing to read "George J. Rael for".

George J. Rael, Assistant Manager
Environmental Projects Office
Los Alamos Site Office

MG/GR/CD/TB:sm

Enclosures: Two hard copies with electronic files – Fact Sheets for Regional Well R-62
(LA-UR-11-6229)

Cy: (w/enc.)
Neil Weber, San Ildefonso Pueblo
Woody Woodworth, DOE-LASO, MS A316
Ted Ball, EP-CAP, MS M996
RPF, MS M707 (electronic)
Public Reading Room, MS M992 (hard copy)

Cy: (Letter and CD and/or DVD only)
Laurie King, EPA Region 6, Dallas, TX
Steve Yanicak, NMED-DOE-OB, MS M894
Hai Shen, DOE-LASO, MS A316
Richard Knapp, Eberline, Los Alamos, NM (w/ MS Word files on CD)
William Alexander, EP-BPS, MS M992

Cy: (w/o enc.)
Tom Skibitski, NMED-OB, Santa Fe, NM (date-stamped letter emailed)
Annette Russell, DOE-LASO (date-stamped letter emailed)
Craig Douglass, EP-CAP, MS M992 (date-stamped letter emailed)
Michael J. Graham, ADEP, MS M991 (date-stamped letter emailed)

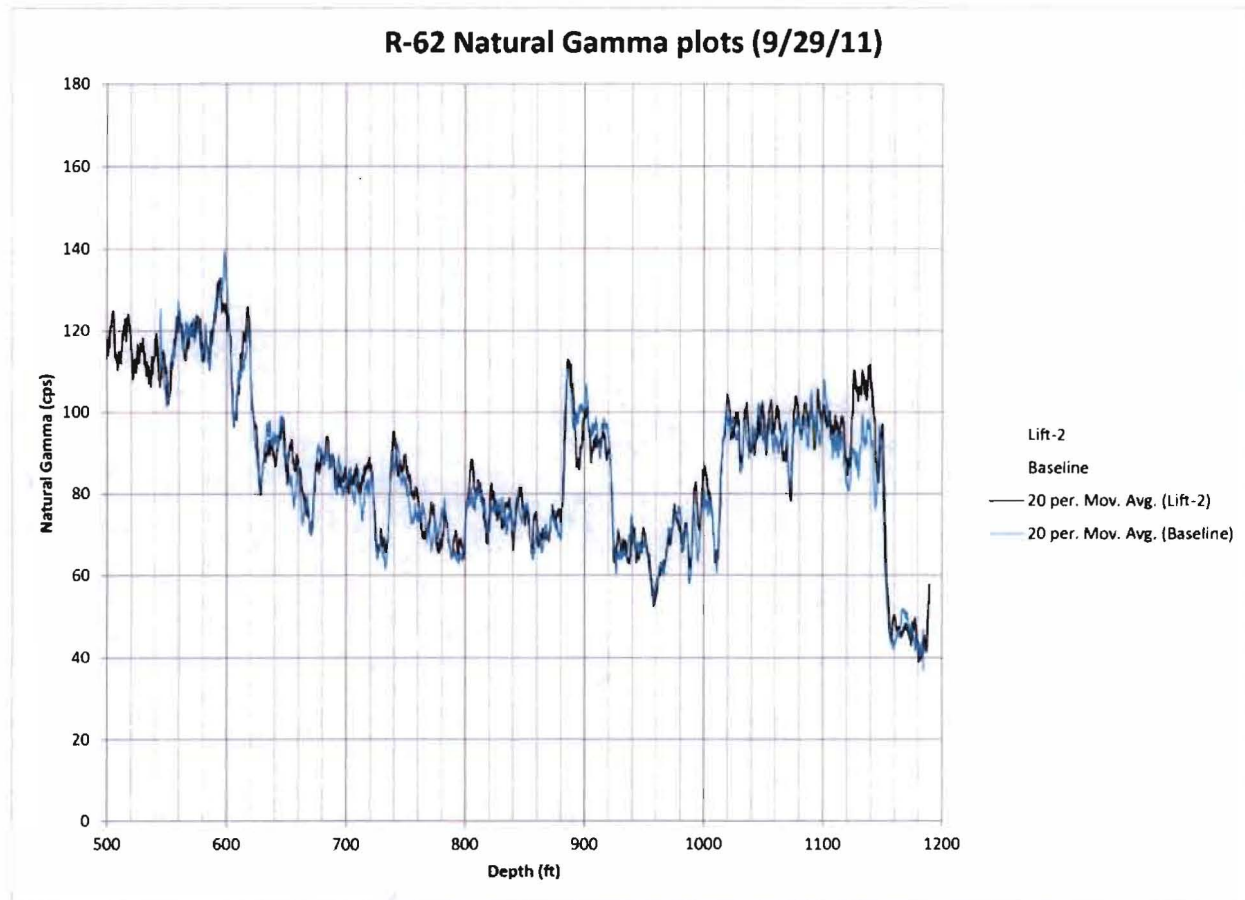


Figure 1 Gamma log collected after the second lift of bentonite was added


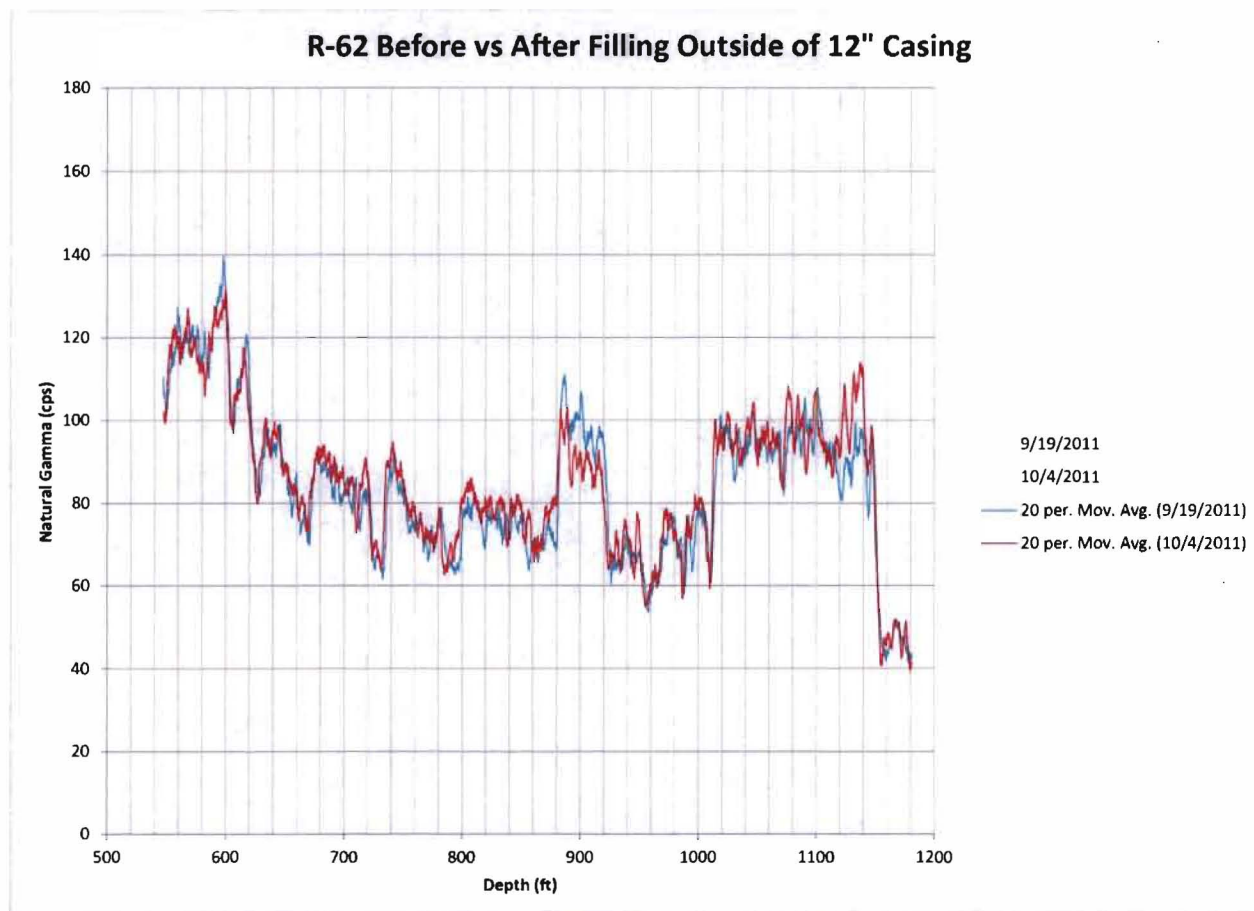


Figure 2 Gamma log collected after backfilling was completed

DEPTH (FT BGS)

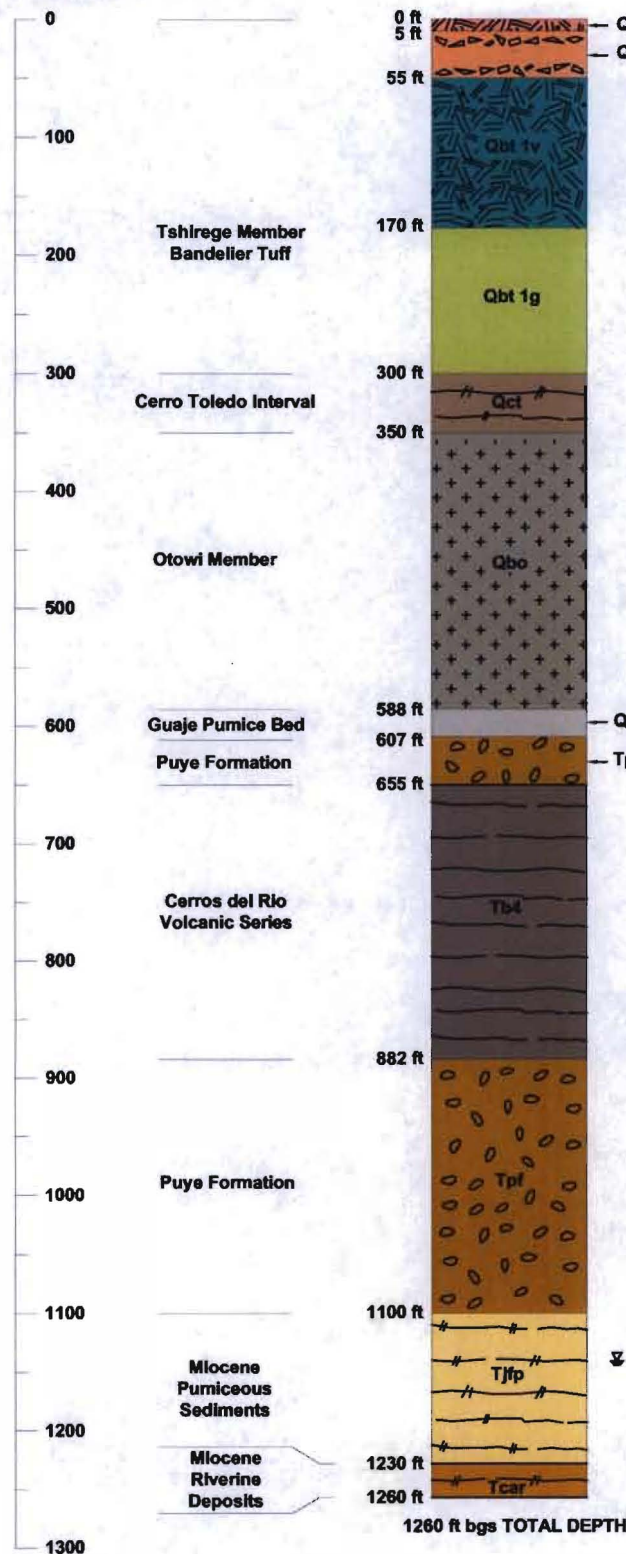

DRILLING INFORMATION

DRILLING COMPANY/PERSONNEL:
 YELLOW JACKET DRILLING
 S. EDWARDS
 Q. STEVENS
 L. McCAULEY
 A. LAMON
 M. PHILLIPS

DRILL RIG:
 FOREMOST DR-24 HD

DRILLING METHOD:
☒ FLUID ASSISTED AIR ROTARY
☒ FLUID ASSISTED DUAL ROTARY

DRILLING FLUID TYPE:
☒ WATER
☒ AIR
 0 ft bgs 1260 ft bgs
☒ AQF-2 FOAM
 308 ft bgs 975 ft bgs

DRILLING START / FINISH:
 DATE: 7/30/11 TIME: 07:00
 DATE: 8/30/11 TIME: 08:18

GEOLOGISTS:
 EBERLINE
 J. MARIN

KLEINFELDER
 C. VALLEJO
 D. KRUPICKA
 D. NEIDIGH
 E. SHANNON

Depth: 1142 ft Date: 8/29/2011

The information included on this graphic representation has been compiled from a variety of sources and is subject to change without notice. Kleinfelder makes no representations or warranties, express or implied, as to accuracy, completeness, timeliness, or rights to the use of such information. This document is not intended for use as a land survey product nor is it designed or intended as a construction design document. The use or misuse of the information contained on this graphic representation is at the sole risk of the party using or misusing the information.



PROJECT NO. 120764
 DRAWN: 10/5/2011
 DRAWN BY: PD
 CHECKED BY: BB
 FILE NAME: 120764 R-62.dwg

R-62 WELL SUMMARY DATA SHEET BOREHOLE STRATIGRAPHY

TA-05
 LOS ALAMOS NATIONAL LABORATORY
 LOS ALAMOS, NEW MEXICO
 ORIGINATOR: B. EVERETT
 APPROVED BY:
 DRAWING CATEGORY: 2

FIGURE

**FACT
 SHEET**

TOTAL LENGTH
 CASING AND SCREEN (ft) 1189.7
DEPTH TO WATER
 AFTER WELL DEVELOPMENT &
 AQUIFER TESTING (ft bgs) 1142.5 10/26/2011

DIAMETER OF BOREHOLE
 20.0 (in.) FROM 0 TO 29.1 (ft bgs)
 17.5 (in.) FROM 29.1 TO 490.0 (ft bgs)
 16.0 (in.) FROM 490.0 TO 678.0 (ft bgs)
 14.8 (in.) FROM 678.0 TO 923.0 (ft bgs)
 12.5 (in.) FROM 923.0 TO 1015.0 (ft bgs)
 13.4 (in.) FROM 1015.0 TO 1260.0 (ft bgs)

OUTER CEMENT SEAL TO (ft bgs)

SURFACE COMPLETION INFORMATION - PENDING

PROTECTIVE CASING
 TYPE SIZE (in) OD
 PAD AND PROTECTIVE POSTS INSTALLED
 CHECK FOR SETTLEMENT
 PAD MATERIAL
 REINFORCED WITH
 PAD DIMENSIONS (ft) (L) (W) (H)

16-in. CARBON STEEL CASING
 0 TO 666 (ft bgs)

12-in. CARBON STEEL CASING
 50 TO 1004 (ft bgs)

STAINLESS STEEL CENTRALIZERS USED
☒ YES AT 1157.2 (ft bgs) AND 1180.2 (ft bgs)

TYPE OF CASING

MATERIAL PASSIVATED A304 STAINLESS STEEL
 ID (in.) 5.0 OD (in.) 5.6
 JOINT TYPE THREADED / COUPLED

FINE SAND COLLAR

1149.6 TO 1152.6 (ft bgs)
 SIZE/TYPE 20/40 SILICA SAND
 QUANTITY USED 3.0 ft³ CALCULATED 2.5 ft³

PRIMARY FILTER PACK

1152.6 TO 1182.4 (ft bgs)
 SIZE/TYPE 10/20 SILICA SAND
 QUANTITY USED 46.5 ft³ CALCULATED 24.7 ft³

SCREENED INTERVAL 1158.4 TO 1179.1 (ft bgs)

SCREEN TYPE A304 STAINLESS STEEL
 ID (in.) 5.0 OD (in.) 5.6
 SLOT SIZE 0.20
 JOINT TYPE THREADED / COUPLED

BOTTOM OF WELL CASING 1189.7 (ft bgs)

BOTTOM OF BORING 1260.0 (ft bgs)

LOCKING COVER

ELEVATION (ft amsl)

WELL CASING TBD
 PROTECTIVE CASING TBD
 GROUND SURFACE TBD
 MONUMENT MARKER TBD

SLOPED CONCRETE
 SURFACE COMPLETION PAD

SURFACE SEAL 5 TO 665.3 (ft bgs)
 MIX (WT%) CEMENT 29% - TREMIED
 QUANTITY USED 368.6 ft³ CALCULATED 318.7 ft³

ANNULAR FILL BETWEEN 12-in. AND 16-in. CASING AND THE BOREHOLE

50 TO 952.0 (ft bgs)
 TYPE BAROTHEM® GOLD BENTONITE GROUT (28% SOLIDS) TREMIED
 QUANTITY USED 365.1 ft³ CALCULATED 426.6 ft³

ANNULAR FILL BETWEEN 12-in. AND 5-in. CASING

59.0 TO 916.5 (ft bgs)
 TYPE 0.375-in BENTONITE CHIPS FREEFALL
 QUANTITY USED 584.6 ft³ CALCULATED 531.7 ft³

ANNULAR FILL BETWEEN 16-in. DIAMETER BOREHOLE AND 14.75-in. DIAMETER BOREHOLE

672.0 TO 708.0 (ft bgs)
 TYPE 0.375-in HYDRATED BENTONITE CHIPS TREMIED

ANNULAR FILL BETWEEN 12-in. AND 5-in. CASING

916.5 TO 952.0 (ft bgs)
 TYPE BENTONITE PELLETS TREMIED
 QUANTITY USED 19.3 ft³ CALCULATED 20.8 ft³

ANNULAR FILL

952.0 TO 1128.9 (ft bgs)
 TYPE 66%-0.375-in. BENTONITE CHIPS / 33% 10/20 SAND TREMIED
 QUANTITY USED 176.9 ft³ CALCULATED 136.4 ft³

ANNULAR SEAL

1128.9 TO 1145.8 (ft bgs)
 TYPE 0.375-in. BENTONITE CHIPS TREMIED
 QUANTITY USED 12.7 ft³ CALCULATED 14.2 ft³

PRIMARY ANNULAR SEAL

1145.8 TO 1149.6 (ft bgs)
 TYPE HYDRATED 0.375-in. BENTONITE CHIPS TREMIED
 QUANTITY USED 5.5 ft³ CALCULATED 3.2 ft³

BACKFILL ANNULAR SEAL

1182.4 TO 1189.9 (ft bgs)
 TYPE HYDRATED 0.375-in. BENTONITE CHIPS TREMIED
 QUANTITY USED 6.3 ft³ CALCULATED 6.3 ft³

SLOUGH 1189.9 TO 1202.4 (ft bgs)

BASE ANNULAR SEAL

1202.4 TO 1239.0 (ft bgs)
 TYPE 68%-0.375-in. BENTONITE CHIPS / 33% 10/20 SAND TREMIED
 QUANTITY USED 46.8 ft³ CALCULATED 30.7 ft³

SLOUGH 1239.0 TO 1260.0 (ft bgs)

WELL DEVELOPMENT BEGAN

DATE 10/4/2011
 TIME 13:40

WELL DEVELOPMENT FINISHED

DATE IN PROGRESS
 TIME

DEVELOPMENT METHOD

☒ SWABBING ☒ BAILING
☒ PUMPING
 TOTAL PURGE VOLUME gal.

FINAL PARAMETERS

pH
 TEMPERATURE (°C)
 SPECIFIC
 CONDUCTANCE (µS/cm)
 TURBIDITY (NTU)

WELL COMPLETION BEGAN

DATE 9/22/2011 TIME 18:40

WELL COMPLETION FINISHED

DATE 10/3/2011 TIME 14:20

The information included on this graphic representation has been compiled from a variety of sources and is subject to change without notice. Kleinfelder makes no representations or warranties, express or implied, as to accuracy, completeness, timeliness, or rights to the use of such information. This document is not intended for use as a land survey product nor is it designed or intended as a construction design document. The use or misuse of the information contained on this graphic representation is at the sole risk of the party using or misusing the information.

DATA AS OF 10/18/2011



PROJECT NO. 120764
 DRAWN: 10/5/2011
 DRAWN BY: PD
 CHECKED BY: BB
 FILE NAME: 120764 R-62.dwg

R-62 WELL CONSTRUCTION DIAGRAM (AS BUILT)

TA-05
 LOS ALAMOS NATIONAL LABORATORY
 LOS ALAMOS, NEW MEXICO

ORIGINATOR: C. VALLEJO
 APPROVED BY: B. EVERETT

DRAWING
 CATEGORY: 2

FIGURE

FACT SHEET