


2982

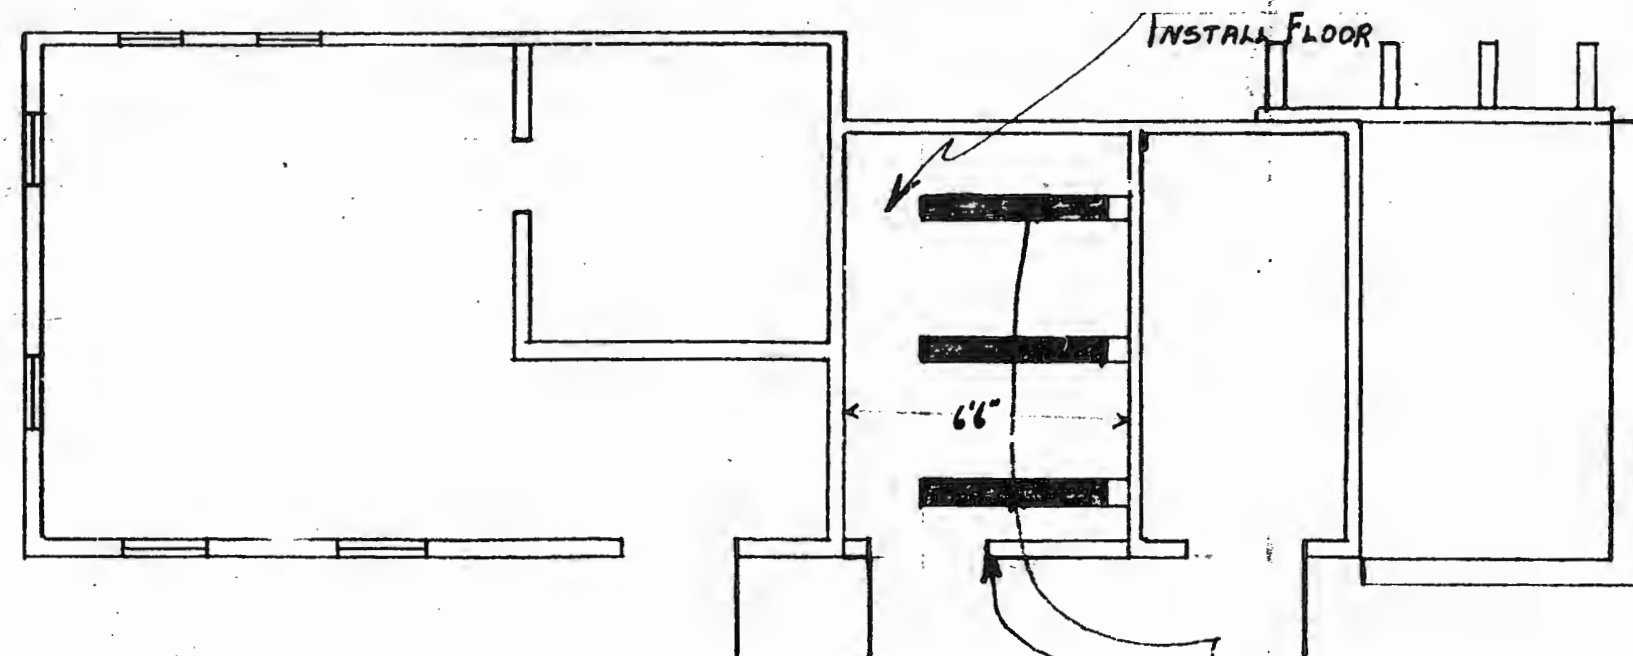


PLAN

INSTALL FLOOR

BRACES TO BE REMOVED

INSTALL WALL & 2'8" X 6'8" DOOR

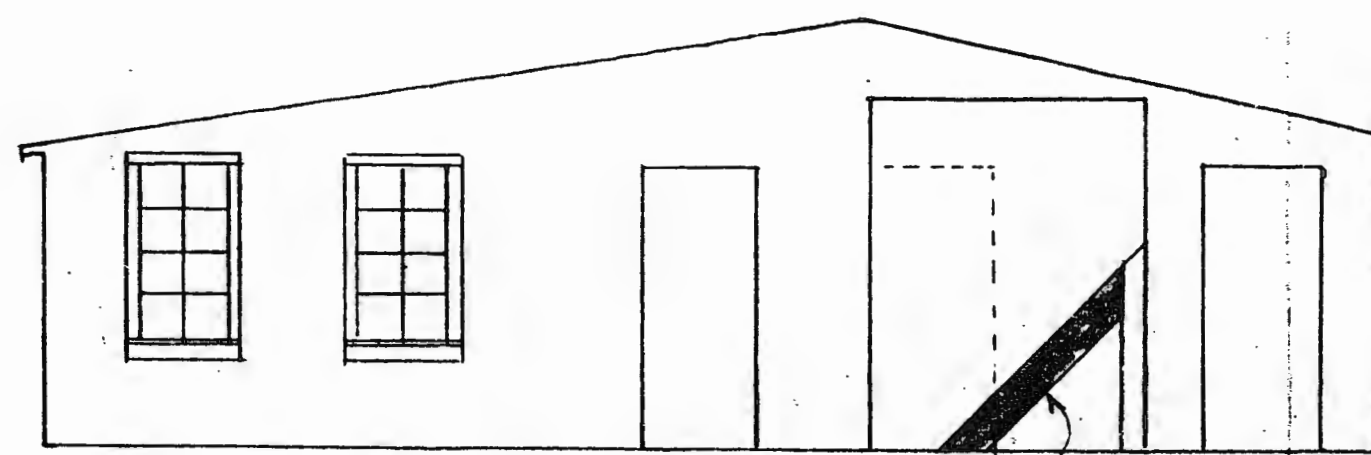

BLDG 10 ELEVATION

REMOVE BRACES

RECORD DRAWING - AS BUILT CONSTRUCTION

OBSOLETE
DEAD STORAGE

2-62353 REC No REVISION AS BUILT STATUS: V.O.I.

SUBMITTED FOR THE AB. IR.	RECOMMENDED: A.E.C.	APPROVED: A.E.C.
---------------------------	---------------------	------------------

IMPORTANT WORKMEN MUST CLEAR WITH *M. R.* FOR WORK IS STARTED ON THIS ORDER. 563 R

AUTHORIZED FOR

HEALTH
SAFETY
FIRE PROT. ✓	<i>J.R.R.</i>
PROCUREMENT
COMMUNICATIONS
SECURITY

PLAN & ELEVATION

1 WAS A5M-378 (REV. 7-29-50) C.W.

MAKE NEW ROOM IN BLDG #1049 MAKE MESSAGE #13963

SCALE	DWG. <i>C.S.</i>	DATE <i>11-6-47</i>
	CKD.	DATE
	APPVD. <i>[Signature]</i>	DATE <i>11-7-47</i>

TE H	SKETCH No.
MAINTENANCE GROUP	<i>154</i>



3028