

CERTIFIED MAIL  
Z 426 728 684



March 19, 1996

Mr. Stuart Dinwiddie  
Permitting Section  
New Mexico Environment Department  
Hazardous and Radioactive Materials Bureau  
PO Box 26110  
Santa Fe, New Mexico 87502

RE: Safety-Kleen Corp., Farmington Facility - 7-008-21  
4210 A Hawkins Road  
Farmington, New Mexico 87401  
US EPA ID No. NMD000804294

Class 1 Permit Modification

Dear Mr. Dinwiddie:

Safety-Kleen respectfully requests a class determination on the permit re-design for the Farmington, New Mexico facility.

In addition to the requested modifications, Safety-Kleen wishes to notify the New Mexico Environment Department of maintenance that has been undertaken on the Farmington tank farm piping system. This maintenance replaced and upgraded valves, and valve secondary containment on the tanker load line and the return/fill line piping systems.

Thank you for your assistance. Should you have any questions, please contact me at (505)884-0260.

Sincerely,


A handwritten signature in black ink, appearing to read "P. Olsen".

Peter Olsen  
Environment Health and Safety Manager  
Safety-Kleen Corp.  
2720 Girard N.E  
Albuquerque, New Mexico 87107

bcc: Regional EHS File #II, Farmington, NM, 7-008-21  
EE File #II, Farmington, NM  
Farmington, NM EHS File #1020

GENERAL NOTES

THIS DRAWING CONTAINS INFORMATION PROPRIETARY TO SAFETY-KLEEN CORP. ANY REPRODUCTION, DISCLOSURE OR USE OF THIS DRAWING IS EXPRESSLY PROHIBITED EXCEPT BY SAFETY-KLEEN OR AS SAFETY-KLEEN MAY AGREE IN WRITING.

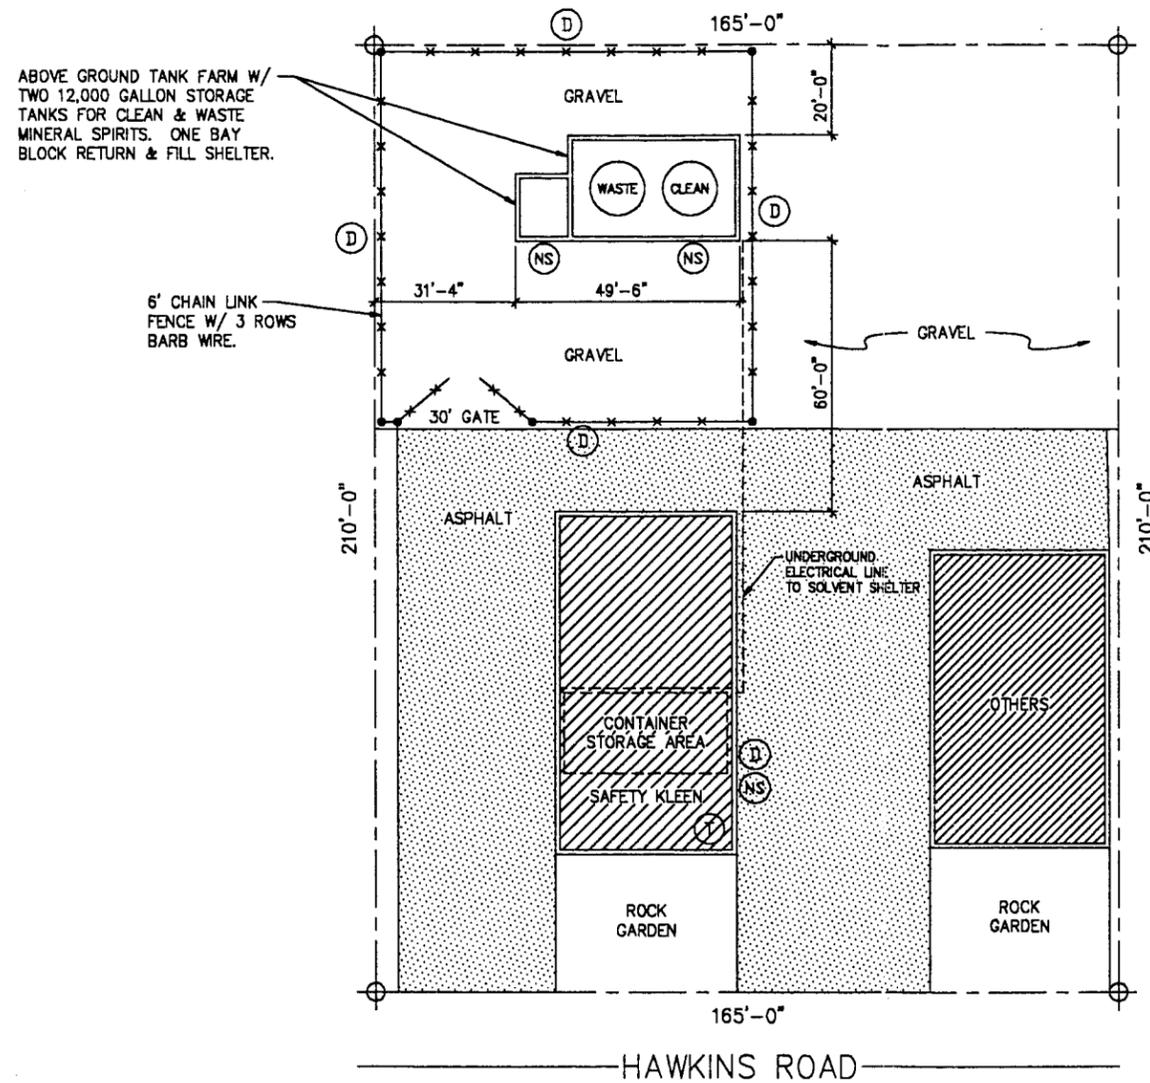

ABOVE GROUND TANK FARM W/  
TWO 12,000 GALLON STORAGE  
TANKS FOR CLEAN & WASTE  
MINERAL SPIRITS. ONE BAY  
BLOCK RETURN & FILL SHELTER.

6' CHAIN LINK  
FENCE W/ 3 ROWS  
BARB WIRE.

HAWKINS ROAD

- (T) (T) - TELEPHONE
- (FE) (FE) - FIRE EXTINGUISHER (TYPICAL 10# ABC)
- (FA) (FA) - FIRST AID STATION
- (D) (D) - 'DANGER' SIGN
- (NS) (NS) - 'NO SMOKING' SIGN
- (COR) (COR) - 'CORROSIVE' SIGN
- NEW ——— EXISTING

PLOT DATE: 2-1-96

				TITLE			
				SITE PLAN 4210A HAWKINS ROAD			
				<b>S</b> SAFETY-KLEEN CORP. 777 BIG TOWER ROAD ELGIN, ILLINOIS 60120 PHONE 708-497-8468			
00	REVISED SAFETY KLEEN DRAWING TO CADD AS DATED. REPLACES SAFETY KLEEN DRAWING 013712	ALJ	1-25-91	SCALE 1" = 20'-0"	BY VEY	CHKD P.E. APPR	DP. APPR DATE 10/30/89
NO.	DESCRIPTION	BY	CHK	APPR	DATE	SERVICE CENTER BRANCH AT FARMINGTON, N.M.	STD-DWG-REV NO. 700821-0001-00
REVISIONS							

RED SKF 196

GENERAL NOTES


THIS DRAWING CONTAINS INFORMATION PROPRIETARY TO SAFETY-KLEEN CORP. ANY REPRODUCTION, DISCLOSURE OR USE OF THIS DRAWING IS EXPRESSLY PROHIBITED EXCEPT BY SAFETY-KLEEN OR AS SAFETY-KLEEN MAY AGREE IN WRITING.



TRENCH CAPACITY

V = Width(ft.) x Depth(ft.) x Length(ft.) x 7.48 gallons/cu.ft.  
 = 1.72 x 2.54 x 11.71 x 7.48  
 = 382 Gallons

- (T) - TELEPHONE
- (FE) - FIRE EXTINGUISHER (TYPICAL 10# ABC)
- (FA) - FIRST AID STATION
- (D) - 'DANGER' SIGN
- (NS) - 'NO SMOKING' SIGN
- (COR) - 'CORROSIVE' SIGN

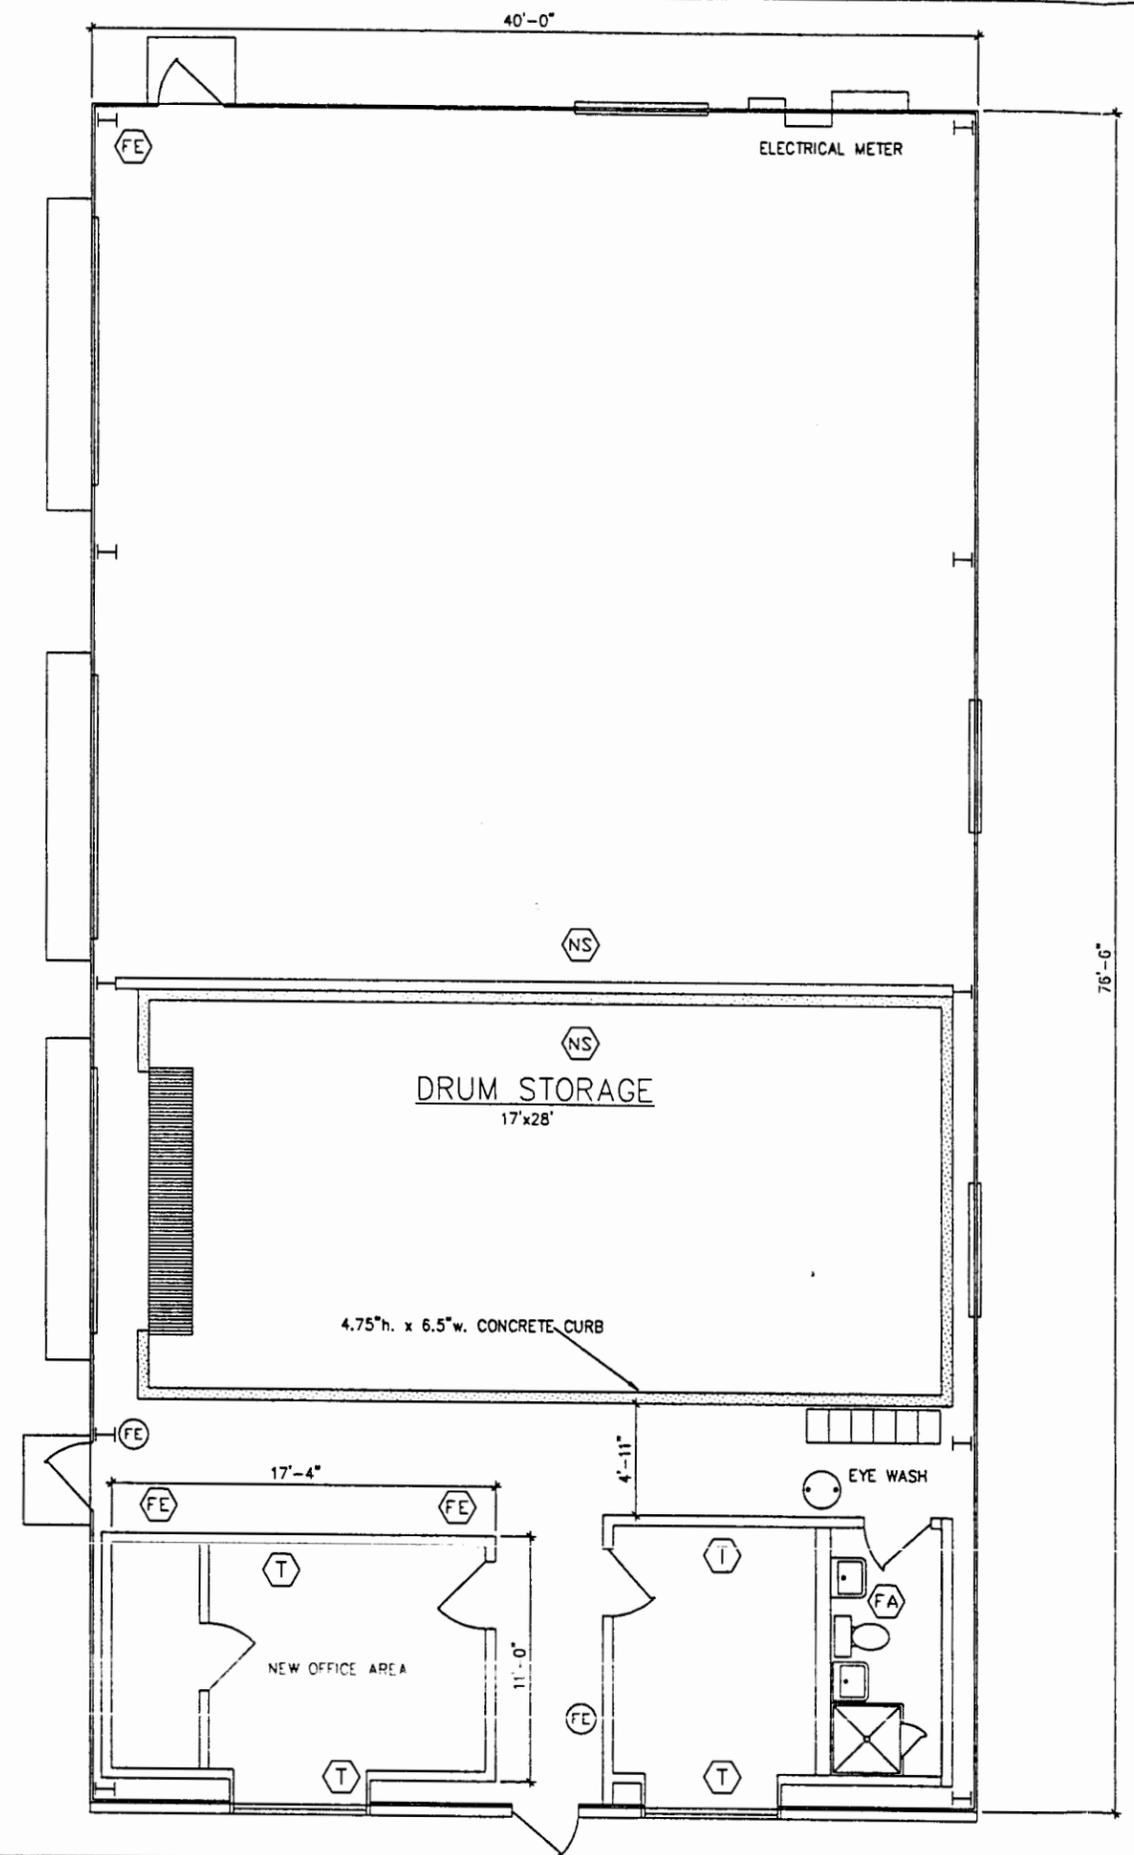

*Thomas H. Wimbro*  
 APR 24, 1996

PLOT DATE: 4-19-96

REVISIONS		TITLE		DATE	
03	REVISE CONTAINMENT CALCULATIONS, CONFIRM 'AS BUILT' DIMENSIONS - TERA, INC.	AFM	TRB	THW	4-19-96
02	REVISE CONTAINMENT CALCULATIONS AND SHOW NEW OFFICE AREA	WEY			2-1-96
00	REVISED SAFETY KLEEN DRAWING TO CADD AS DATED REPLACES SAFETY KLEEN DRAWING D-10239	ALI			2-25-91
NO.	DESCRIPTION	BY	CHK	APPR	DATE

TITLE FLOOR PLAN 4210A HAWKINS ROAD				SCALE 1/4"=1'-0"	
SAFETY-KLEEN CORP. 800 N. BARNALL ROAD ELEM. BLDG. GREENE 800-669-5046				BY	DATE
SERVICE CENTER BRANCH AT FARMINGTON, N.M.				OP. APPR	DATE
				STD-DWG-REV NO.	700821-7001-03