Los Alamos

Los Alamos National Laboratory
Los Alamos, New Mexico 87545

memorandum

TO: Geri Rodriguez, ESH-19, MS K498

DATE: November 9, 1994

FROM: Facilities Engineering Margie Pacheco

MAIL STOP/TELEPHONE: M703/5-5902

SYMBOL: ENG-7-94-05

BOOK NO. 95

SUBJECT: **TECHNICAL AREA STRUCTURE LOCATION MAPS**

Attached for your reference is one set of the Structure Location Maps. The index lists all of the maps in the order of their occurrence within the book. Additional books of maps may be obtained upon request to ENG-7.

A graphic scale is included in each drawing and varies from site to site. Due to reduction from the original 24" by 36" size of the drawings, it will not in all instances conform to standard measuring scales.

As the drawings are individually revised on a annual basis, distribution of the revised prints will be made to all individuals who own a book of plans; the revised prints may be easily inserted in the book to replace the map or maps that have become obsolete.

If you have any suggestions or comments concerning the contents or composition of this book, please contact Bryan Comer at 7-4711 or Margie Pacheco at 5-5902.

MP/mlm

cy: ENG-7 File

12550

LEGEND

BUILDING WITH STRUCTURE NUMBER

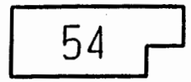

UNDERGROUND BUILDING

PARKING AREA

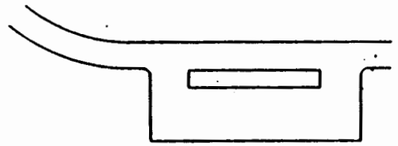

PAVED ROAD

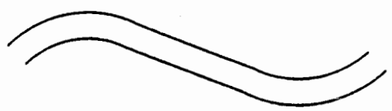

GRAVEL OR DIRT ROAD

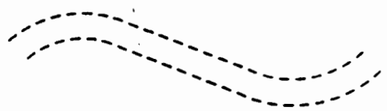

TRAIL

CONCRETE PAD

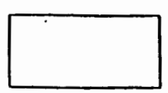

SIDEWALKS

SECURITY FENCE

INDUSTRIAL FENCE

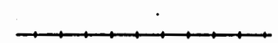

GATES

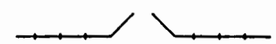

DOE BOUNDARY

RETAINING WALL

EARTH BERM

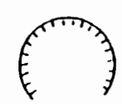

NO	DATE	CLASS REV	REVISIONS	DWN	VER	CHKD	REL	SUB	REC	APP

JOHNSON CONTROLS WORLD SERVICES INC.

AS-BUILT STRUCTURE LOCATION MAPS

TECH AREA MAP LEGEND

DRAWN J. HORN
VERIFIED J. HORN
CHECKED H. SALAZAR
RELEASED H. SALAZAR
DATE 05-06-93

SUBMITTED J.A. FORTE
RECOMMENDED D.E. COHEN
APPROVED

Los Alamos — Los Alamos National Laboratory, Los Alamos, New Mexico 87545

SHEET 1 of 1

CLASSIFICATION UNC — REVIEWED H. SALAZAR — DATE 05-07-93

PROJECT ID 11952 — DRAWING NO. AB8 — REV.

JCI 91-020

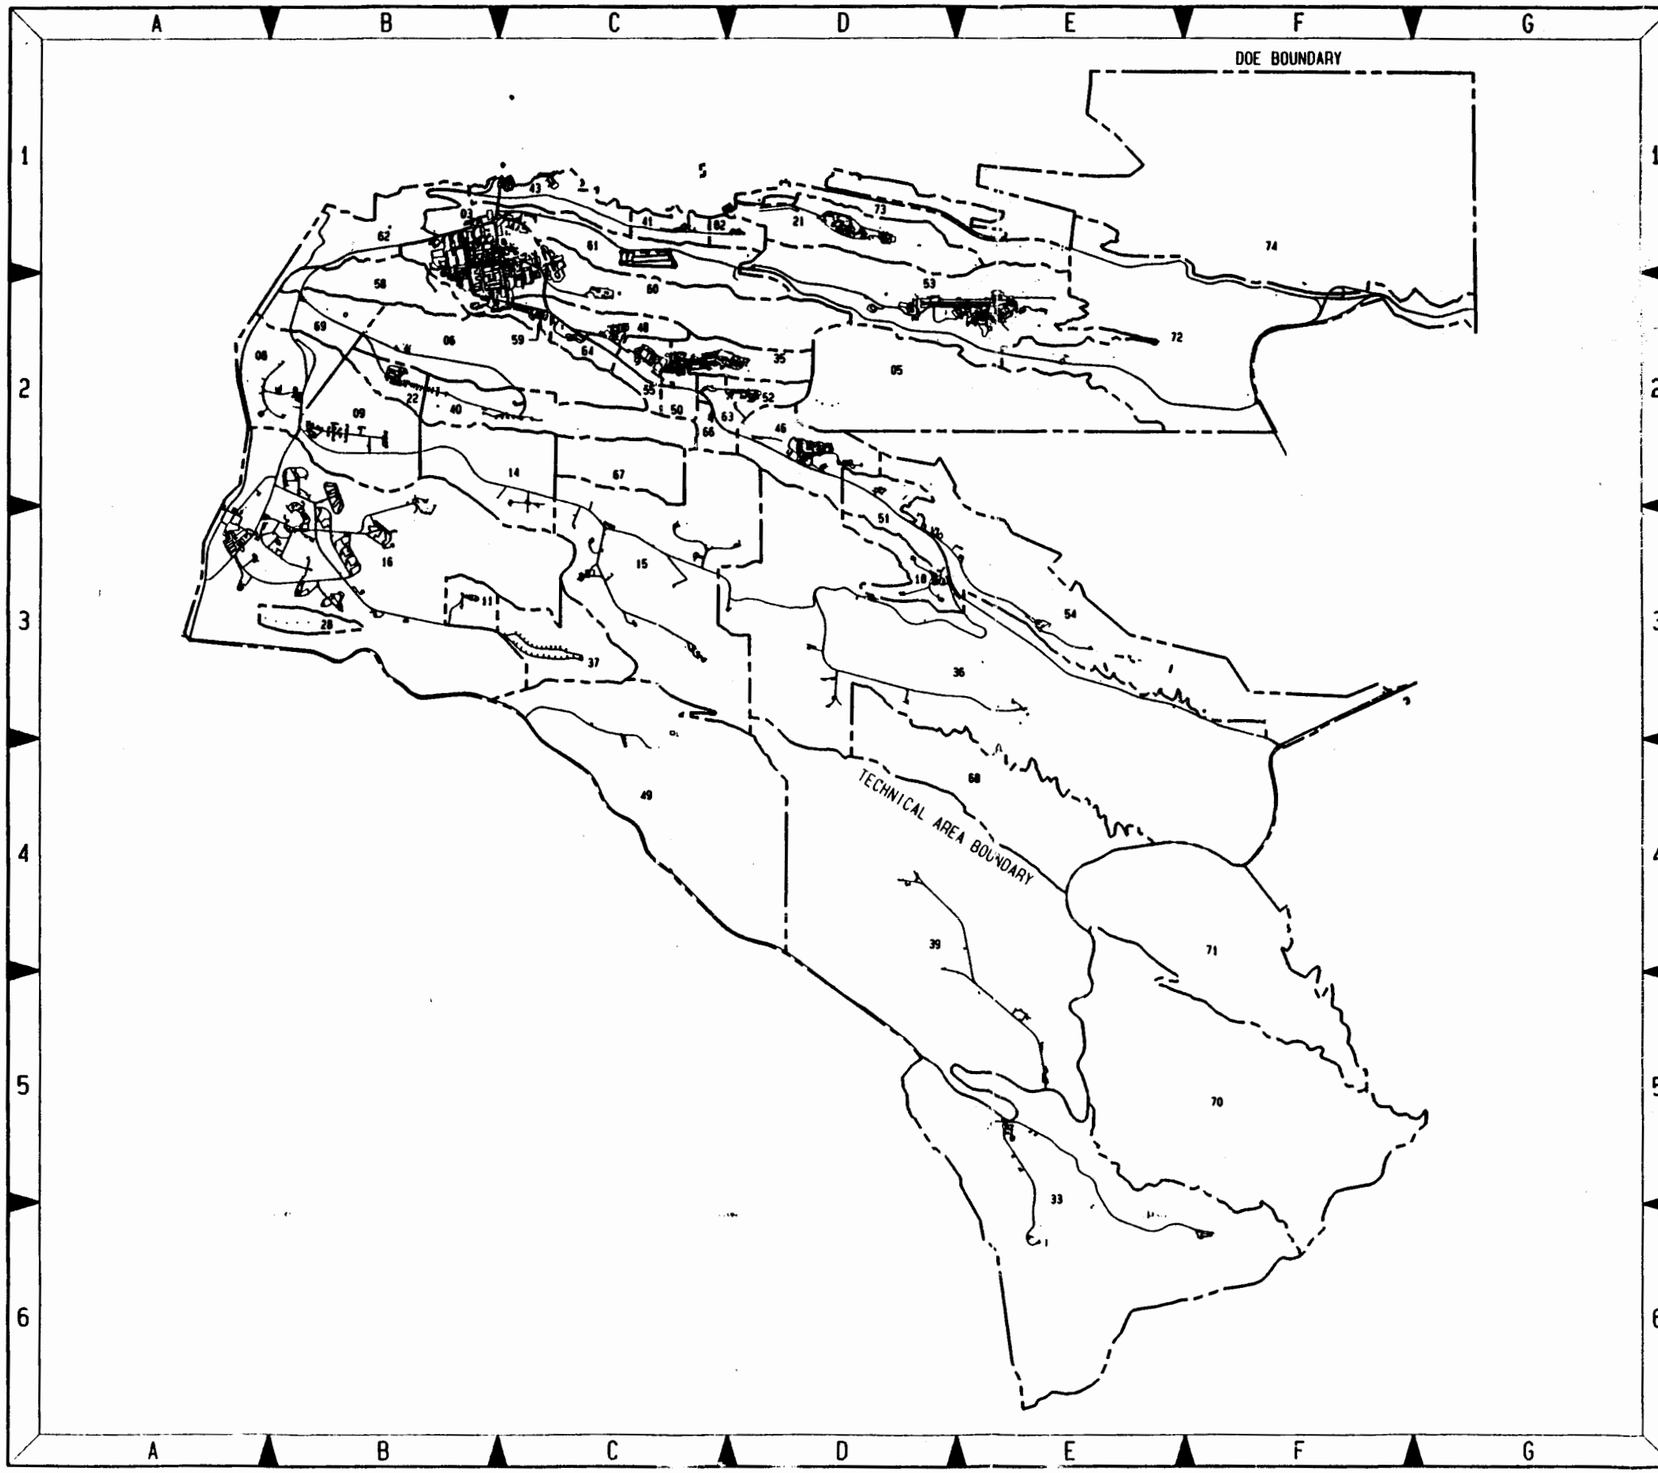

TECHNICAL AREA LOCATIONS

TECH AREA NUMBER	TECHNICAL AREA NOMENCLATURE	TECH AREA LOCATOR SHEET NO.	TECH AREA LOCATOR MAP KEY
TA-00	OFF SITE	-	***
TA-02	OMEGA SITE	1	C-1
TA-03	SOUTH MESA SITE	1	B-1
TA-05	BETA SITE	1	D-2
TA-06	TWO MILE MESA SOUTH SITE	1	B-2
TA-08	ANCHOR WEST SITE	1	A-2
TA-09	ANCHOR EAST SITE	1	B-2
TA-11	K SITE	1	B-3
TA-14	Q SITE	1	C-2
TA-15	R SITE	1	C-3
TA-16	S SITE	1	B-3
TA-18	PAJARITO LABORATORY	1	D-3
TA-21	DP SITE	1	D-1
TA-22	TD SITE	1	B-2
TA-28	MAGAZINE AREA A	1	B-3
TA-33	HP SITE	1	E-5
TA-35	TEN SITE	1	D-2
TA-36	KAPPA SITE	1	E-3
TA-37	MAGAZINE AREA C	1	C-3
TA-39	ANCHO CANYON SITE	1	D-4
TA-40	DF SITE	1	B-2
TA-41	W SITE	1	C-1
TA-43	HEALTH RESEARCH LABORATORY	1	C-1
TA-46	WA SITE	1	D-2
TA-48	RADIOCHEMISTRY SITE	1	C-2
TA-49	FRIJOLES MESA SITE	1	C-4
TA-50	WASTE MANAGEMENT SITE	1	C-2
TA-51	ENVIRONMENTAL RESEARCH SITE	1	D-3
TA-52	REACTOR DEVELOPMENT SITE	1	D-2
TA-53	MESON PHYSICS FACILITY	1	D-2
TA-54	WASTE DISPOSAL SITE	1	E-3
TA-55	PLUTONIUM FACILITY SITE	1	C-2
TA-57	FENTON HILL SITE	-	***
TA-58	TWO MILE MESA NORTH SITE	1	B-2
TA-59	OH SITE	1	C-2
TA-60	SIGMA MESA SITE	1	C-2
TA-61	EAST JEMEZ SITE	1	C-1
TA-62	NORTHWEST SITE	1	B-1
TA-63	PAJARITO SERVICE SITE	1	D-2
TA-64	CENTRAL GUARD SITE	1	C-2
TA-66	CENTRAL TECHNICAL SUPPORT SITE	1	C-2
TA-67	PAJARITO MESA SITE	1	C-2
*TA-68	WATER CANYON SITE	1	E-4
TA-69	ANCHOR NORTH SITE	1	B-2
*TA-70	RIO GRANDE SITE	1	F-5
*TA-71	SOUTHEAST SITE	1	F-4
TA-72	EAST ENTRY SITE	1	E-2
TA-73	AIRPORT SITE	1	D-1
*TA-74	OTOWI SITE	1	F-1

*** OUTSIDE OF LABORATORY BOUNDARY. SEE APPROPRIATE TECHNICAL AREA MAP.

* MAPS NOT INCLUDED IN STRUCTURE LOCATION MAPS

LEGEND

— — — — TECHNICAL AREA/DOE BOUNDARY

N

SCALE: 1" 28800

2400 0 2400 4800

FEET

NO	DATE	CLASS REV	REVISIONS	DWN	VER	CHKD	REL	SUB	REC	APP

JOHNSON CONTROLS WORLD SERVICES INC.

AS-BUILT STRUCTURE LOCATION MAPS

LABWIDE

TECHNICAL AREA BOUNDARY MAP

DRAWN H. SALAZAR
VERIFIED N/A
CHECKED J. ROBERTS
RELEASED H. SALAZAR
DATE 07-29-94

SUBMITTED JERRY FORTE
RECOMMENDED DAYAN COMER
APPROVED ROBERT PROMMEL

Los Alamos — Los Alamos National Laboratory, Los Alamos, New Mexico 87545

SHEET 1 OF 1

CLASSIFICATION U REVIEWER H SALAZAR DATE 8-2-94

PROJECT ID 11952

DRAWING NO AB9

REV

TA-00

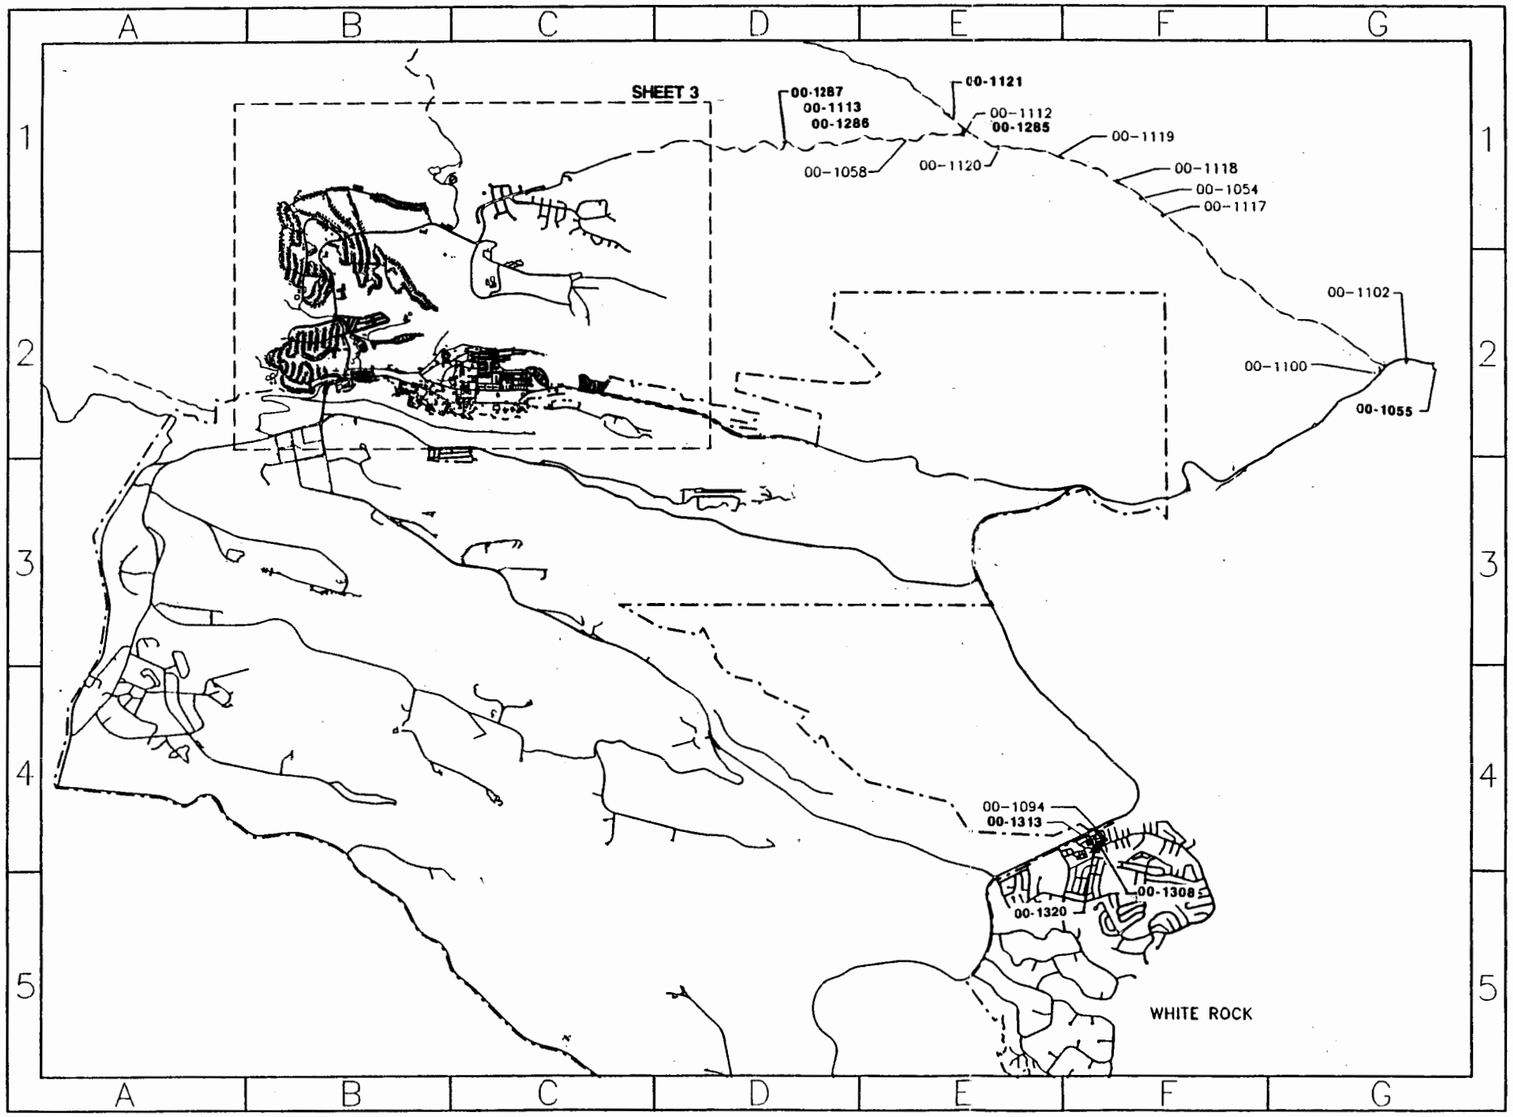

SCALE 1: 36000

3000 0 3000 6000 FEET

N

LATEST DISTRIBUTION

15JULY94

EMERGENCY RESPONSE MAP
UPDATED DRAWING

NO.	DATE	CLASS REV.	REVISIONS	DWN	DES	CKD	REL	SUB	REC	APP

FACILITIES ENGINEERING DIVISION

STRUCTURE LOCATION MAP
TA-00

DRAWN	C.SANDOVAL
DESIGN	
CHECKED	B. COMER
RELEASED	B. COMER
DATE	03-06-91

BLDG.

SUBMITTED | RECOMMENDED | APPROVED

LOS ALAMOS — LOS ALAMOS NATIONAL LABORATORY, LOS ALAMOS, NEW MEXICO, 87545

SHEET 2 OF 3

CLASSIFICATION U REVIEWER DATE 4-15-91

LAB JOB NO.

DRAWING NO. ENG-R 5101

REV. 13

AUTOGIS

TA-00

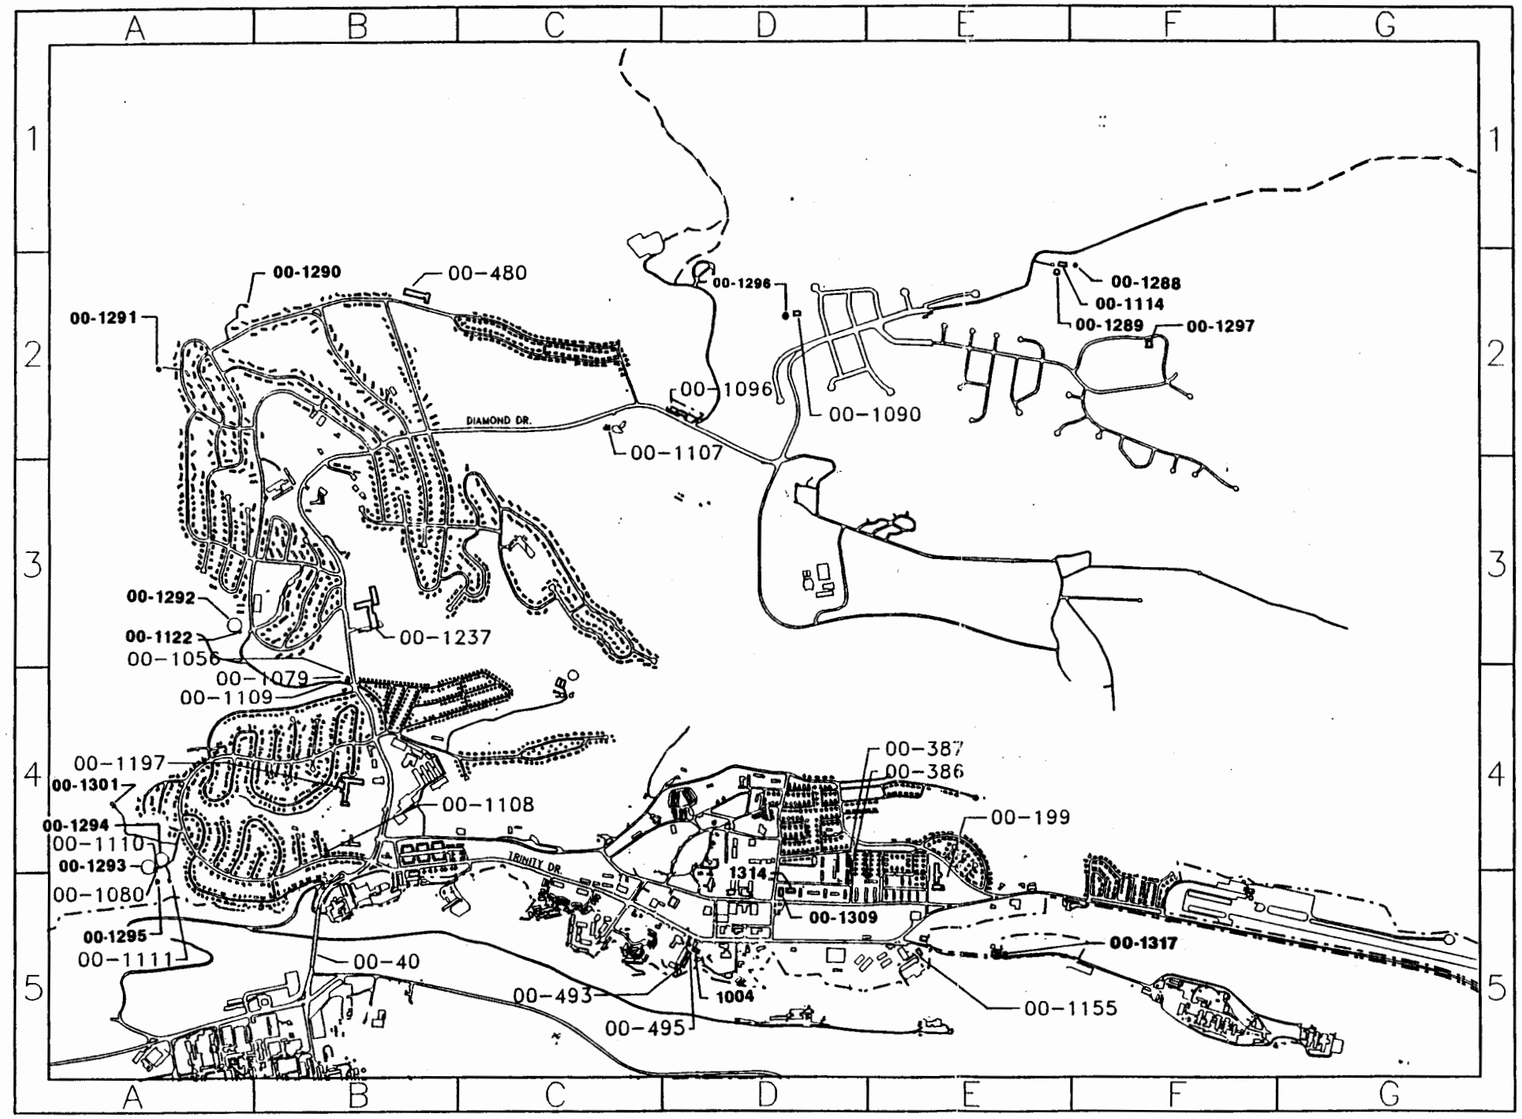

SCALE 1: 12000

1000 0 1000 2000 FEET

N

LATEST DISTRIBUTION
15JULY94
EMERGENCY RESPONSE MAP
UPDATED DRAWING

NO.	DATE	CLASS REV.	REVISIONS	DWN	DES	CKD	REL	SUB	REC	APP

FACILITIES ENGINEERING DIVISION

STRUCTURE LOCATION MAP
TA-00

DRAWN	C.SANDOVAL
DESIGN	
CHECKED	B. COMER
RELEASED	B. COMER
DATE	03-06-91

BLDG.

SUBMITTED | RECOMMENDED Bryan Comer | APPROVED

LOS ALAMOS — LOS ALAMOS NATIONAL LABORATORY, LOS ALAMOS, NEW MEXICO 87545

SHEET 3 OF 3

CLASSIFICATION U REVIEWER | DATE 4-15-91

LAB JOB NO. | DRAWING NO. ENG-R 5101 | REV. 13

AUTOGIS

STRUCTURE NUMBER INDEX

STRUCTURE TA-NUMBER	STRUCTURE DESIGNATION	STRUCTURE NOMENCLATURE	STRUCTURE LOCATOR SHEET NO.	STRUCTURE LOCATOR MAP KEY
00-199	ULR-199	LEASED SPACE CANYON SCHOOL	3	E-5
00-386	ULR-386	APARTMENT BLDG. 1027 9TH ST.	3	D-4
00-387	ULR-387	APARTMENT BLDG. 1203 9TH ST.	3	D-4
00-480	ULR-480	LEASED SPACE PAJARITO SCHOOL	3	B-2
00-493	ULR-493	LEASED SPACE SUITE "O" TRINITY	3	D-5
00-495	ULR-495	LEASED SPACE SUITE "Q" TRINITY	3	D-5
00-1004	ULR-1004	LEASED SPACE SUITE "L" TRINITY	3	D-5
00-1054	ULR-1054	WELL HOUSE 1A, GUAJE CANYON	2	F-1
00-1055	ULR-1055	WELL HOUSE	2	G-2
00-1056	ULR-1056	METERING STATION 1805 DIAMOND DR	3	B-4
00-1058	ULR-1058	WELL HOUSE #6, RENDIJA CANYON	2	E-1
00-1079	ULR-1079	VALVE HOUSE 1805 DIAMOND DR.	3	B-4
00-1080	ULR-1080	PUMP HOUSE 600 48TH STREET	3	A-5
00-1090	ULR-1090	PUMP STATION 99 GANCHO	3	D-2
00-1094	ULR-1094	FIRE STATION #3 WHITE ROCK	2	F-4
00-1096	ULR-1096	FIRE STATION #4 4401 DIAMOND DR.	3	D-2
00-1100	ULR-1100	PUMP STATION STATE ROAD 4	2	G-2
00-1102	ULR-1102	WELL HOUSE STATE ROAD 4	2	G-2
00-1107	ULR-1107	FILTER BUILDING 4040 DIAMOND DR.	3	C-2
00-1108	ULR-1108	PUMP STATION 4084 TRINITY DR.	3	B-4
00-1109	ULR-1109	BOOSTER STATION 1801 DIAMOND DR.	3	B-4
00-1110	ULR-1110	VALVE HOUSE 601 48TH STREET	3	A-4
00-1111	ULR-1111	PUMP STATION 600 48TH STREET	3	A-5
00-1112	ULR-1112	BOOSTER STATION GUAJE CANYON	2	E-1
00-1113	ULR-1113	BOOSTER STATION RENDIJA CANYON	2	D-1
00-1114	ULR-1114	BOOSTER STATION RENDIJA CANYON	3	F-2
00-1117	ULR-1117	WELL HOUSE GUAJE CANYON	2	F-1
00-1118	ULR-1118	WELL HOUSE GAUJE CANYON	2	F-1
00-1119	ULR-1119	WELL HOUSE GUAJE CANYON	2	F-1
00-1120	ULR-1120	WELL HOUSE GUAJE CANYON	2	E-1
00-1121	ULR-1121	WELL HOUSE GUAJE CANYON	2	E-1
00-1122	ULR-1122	SYCAMORE VALVE HOUSE	3	A-3
00-1155	ULR-1155	LEASED SPACE 101 DP ROAD	3	E-5
00-1197	ULR-1197	LEASED SPACE MESA SCHOOL	3	A-4
00-1237	ULR-1237	LEASED SPACE PUEBLO SCHOOL	3	B-3
00-1285	ULR-1285	WATER TANK	2	E-1
00-1286	ULR-1286	WATER TANK	2	D-1
00-1287	ULR-1287	WATER TANK	2	D-1
00-1288	ULR-1288	WATER TANK	3	F-2
00-1289	ULR-1289	WATER TANK	3	F-2
00-1290	ULR-1290	GROUP 12 WATER TANK	3	B-2
00-1291	ULR-1291	GROUP 11 WATER TANK	3	A-2
00-1292	ULR-1292	SYCAMORE WATER TANK	3	A-4
00-1293	ULR-1293	TWIN WATER TANK SOUTH	3	A-4
00-1294	ULR-1294	TWIN WATER TANK NORTH	3	A-4
00-1295	ULR-1295	COMMUNITY TANK	3	A-5
00-1296	ULR-1296	BARRANCA MESA TOWER #1	3	D-2
00-1297	ULR-1297	BARRANCA MESA WATER TOWER	3	F-2
00-1301	ULR-1301	WESTERN WATER TANK	3	A-4
00-1308	ULR-1308	HS TRAINING CENTER	2	F-4
00-1309	ULR-1309	BRADBURY SCIENCE MUSEUM	3	D-5
00-1313	ULR-1313	PTLA TRAINING CENTER	2	F-4
00-1314	ULR-1314	LEASED OFFICE SPACE	3	D-5
00-1317	ULR-1317	LEASED SPACE 200 DP ROAD	3	E-5
00-1320	ULR-1320	R.W. TRAINING CENTER	2	F-4

LATEST DISTRIBUTION
15 JULY 94
EMERGENCY RESPONSE MAP
UPDATED DRAWING

NO.	DATE	CLASS REV.	REVISIONS	DRN	DES	CHKD	REL	SUB	REC	APP

FACILITIES ENGINEERING DIVISION

STRUCTURE LOCATION MAP
TA-00

BLDG.

DRAWN	C.SANDOVAL
DESIGN	
CHECKED	B. COMER
RELEASED	B. COMER
DATE	03-06-91

SUBMITTED [signature] RECOMMENDED [signature] APPROVED [signature]

Los Alamos — Los Alamos National Laboratory, Los Alamos, New Mexico 87545

SHEET 1 OF 3

CLASSIFICATION U REVIEWER [signature] DATE 4-15-91

LAB JOB NO.

DRAWING NO. ENG-R 5101

REV. 13

STRUCTURE LOCATION MAPS

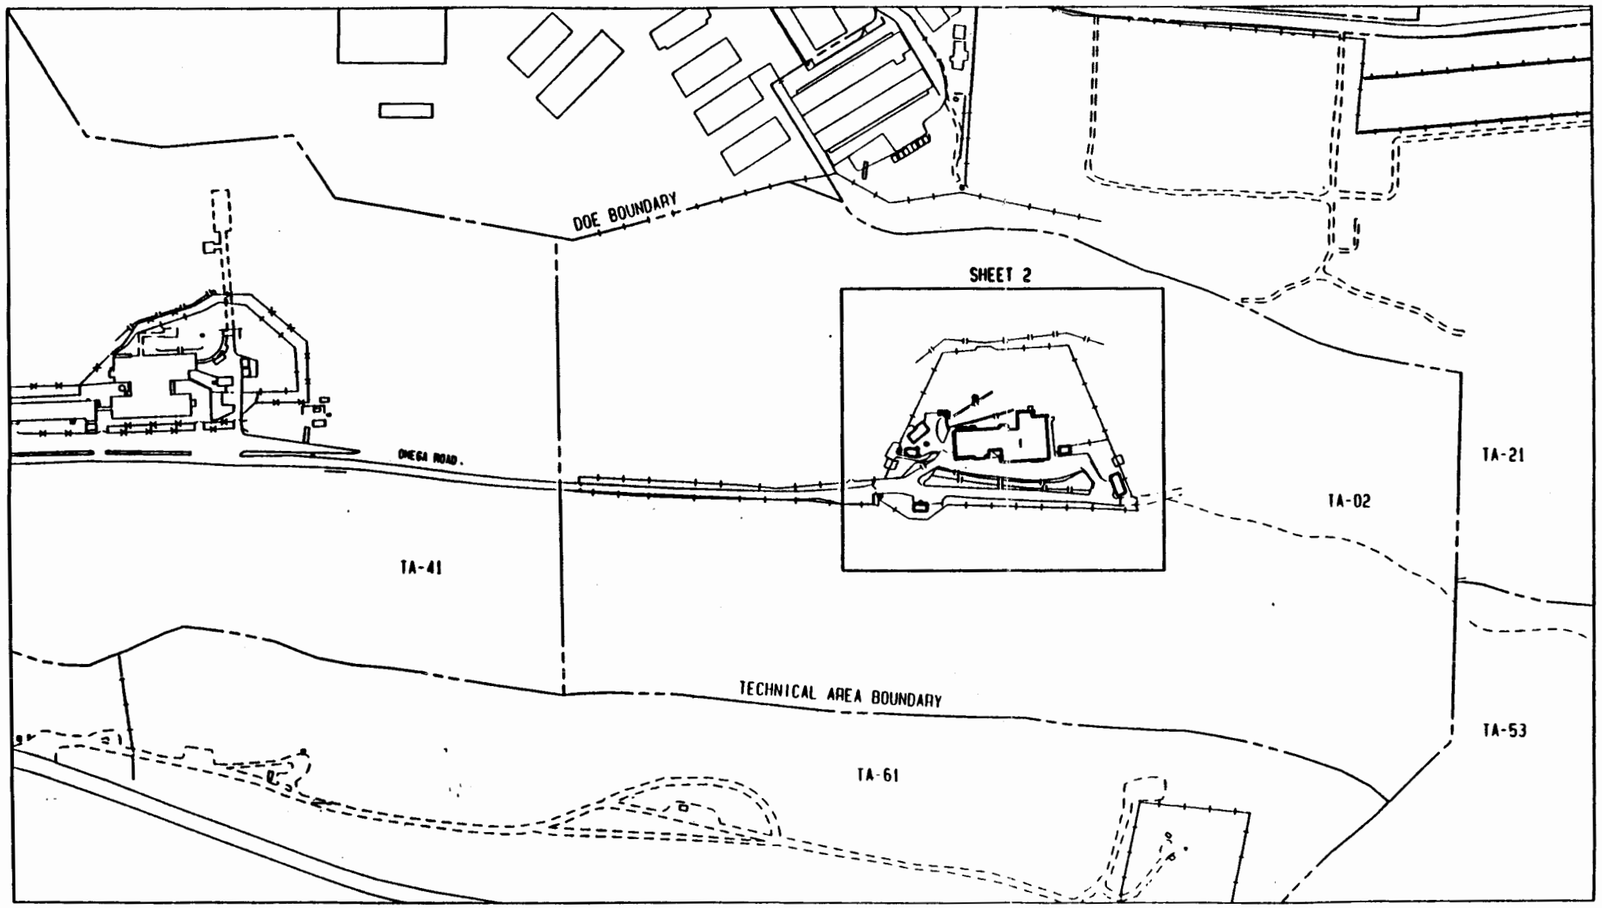

TA-02 KEY MAP

SCALE: 1:1800

150 0 150 300

FEET

N

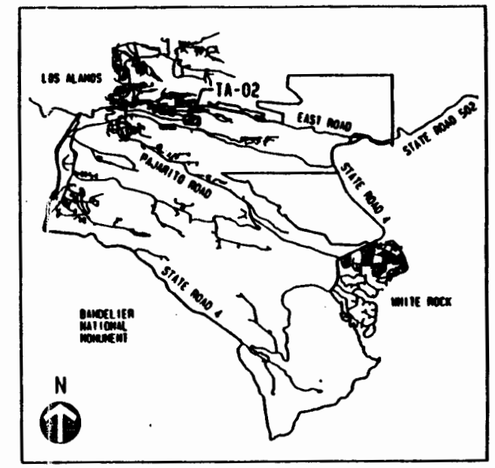

LOCATION PLAN

SCALE: NONE

NO	DATE	CLASS REV	REVISIONS	DWN	VER	CHKD	REL	SUB	REC	APP
1	05-16-94		REVISED TO NEW STANDARDS	HMS	JPH	JPH	HMS	DAF	BEC	RAP

JOHNSON CONTROLS WORLD SERVICES INC.

AS-BUILT STRUCTURE LOCATION MAPS

TA-02

OMEGA SITE

DRAWN J. MORK
VERIFIED M. SENA, J. MORK
CHECKED H. SALAZAR
RELEASED H. SALAZAR
DATE 11-08-93

SUBMITTED JERRY FORTE
RECOMMENDED BRYAN COHEN
APPROVED ROBERT PRIMMEL

Los Alamos — Los Alamos National Laboratory, Los Alamos, New Mexico 87545

SHEET 1 of 2

CLASSIFICATION U — REVIEWER H. SALAZAR — DATE 5-17-94

PROJECT ID 11952 — DRAWING NO AB12 — REV 1

020-16 ON 17

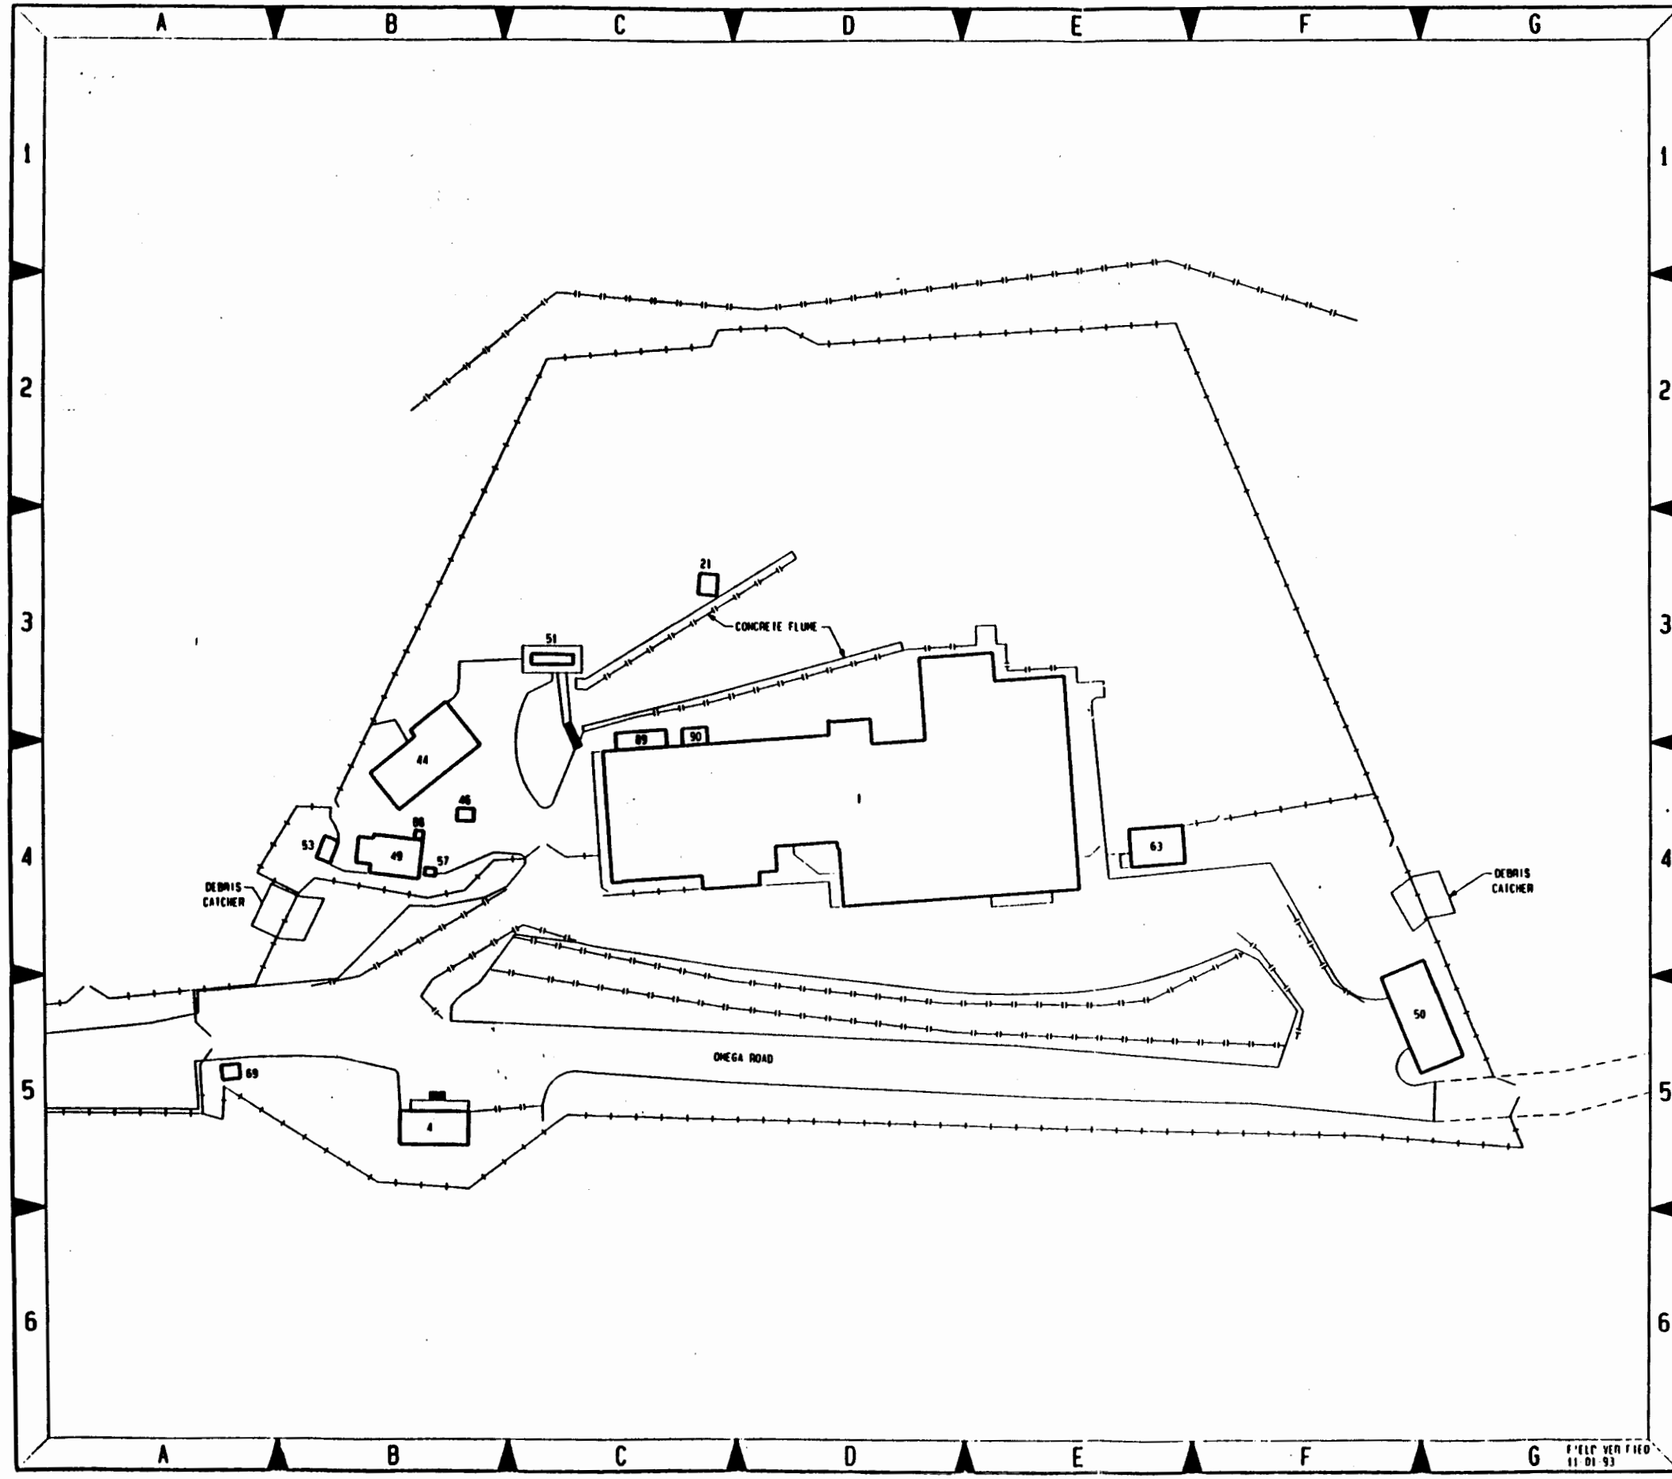

STRUCTURE LOCATION INDEX

STRUCTURE TA-NUMBER	STRUCTURE DESIGNATION	STRUCTURE NOMENCLATURE	STRUCTURE LOCATOR SHEET NO.	STRUCTURE LOCATOR MAP KEY
02-1	OMEGA-1	OMEGA WEST REACTOR	2	B-4
02-4	OMEGA-4	STORAGE BUILDING	2	B-5
02-21	OMEGA-21	WATERLINE VALVE HOUSE	2	C-3
02-44	OMEGA-44	COOLING SYSTEM BUILDING	2	B-4
02-46	2-46	SURGE TANK	2	B-4
02-49	2-49	COOLING TOWER	2	B-4
02-50	OMEGA-50	STORAGE BUILDING	2	F-5
02-51	OMEGA-51	SUBSTATION	2	C-3
02-53	OMEGA-53	TRANSFER PIT	2	B-4
02-57	OMEGA-57	VALVE HOUSE	2	B-4
02-63	OMEGA-63	BOILER HOUSE	2	E-4
02-69	2-69	GUARD STATION #316	2	A-5
02-88	2-88	STORAGE BUILDING	2	B-4
02-89	2-89	STORAGE BUILDING	2	C-3
02-90	2-90	STORAGE SHED	2	C-3

N

SCALE: 1:360

30 0 30 60

FEET

NO	DATE	CLASS REV	REVISIONS	DWN	VER	CHK'D	REL	SUB	REC	APP
1	05-16-94		REVISED TO NEW STANDARDS	HMS	JPN	JPN	HMS	OAF	BEC	RAP

JOHNSON CONTROLS WORLD SERVICES INC.

AS-BUILT STRUCTURE LOCATION MAPS

TA-02

OMEGA SITE

DRAWN J. HORK
VERIFIED H. SENA, J. HORK
CHECKED H. SALAZAR
RELEASED H. SALAZAR
DATE 11-08-93

SUBMITTED JERRY FORTE
RECOMMENDED BRYAN COHEN
APPROVED ROBERT PRIMMEL

Los Alamos — Los Alamos National Laboratory, Los Alamos, New Mexico 87545

SHEET 2 — 2 of 2

CLASSIFICATION U REVIEWER H. SALAZAR DATE 5-17-94

PROJECT ID 11952 — DRAWING NO AB12 — REV. 1

FIELD VERIFIED 11-01-93

STRUCTURE LOCATION MAPS

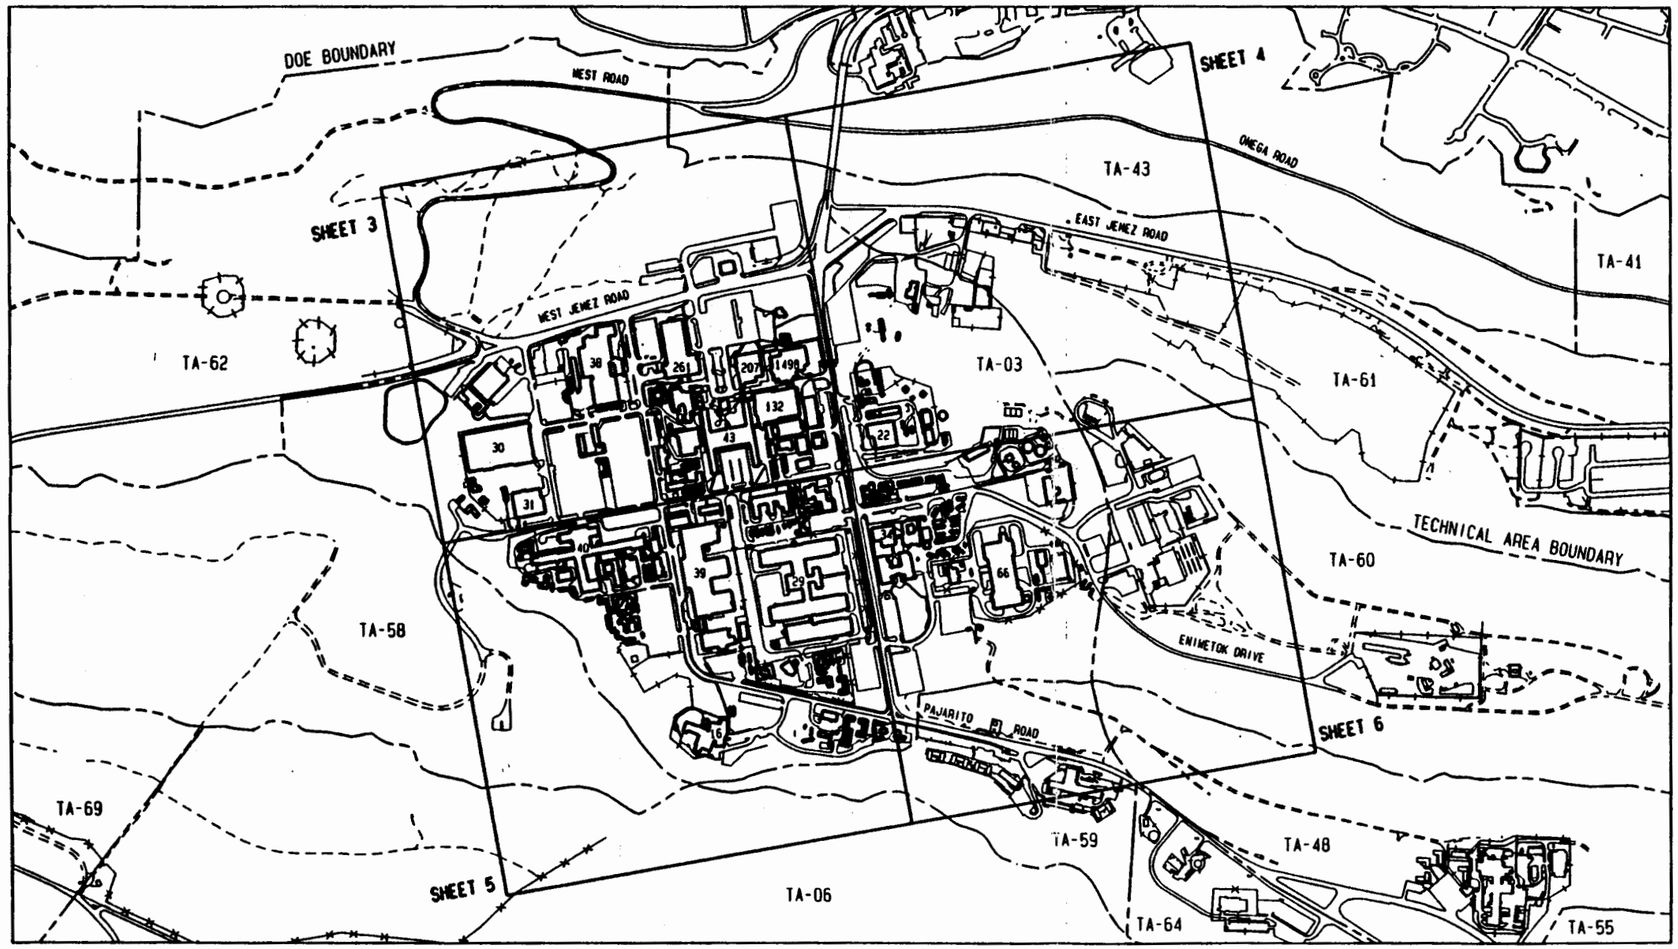

TA-03 KEY MAP

SCALE: 1:5400

450 0 450 900

FEET

N

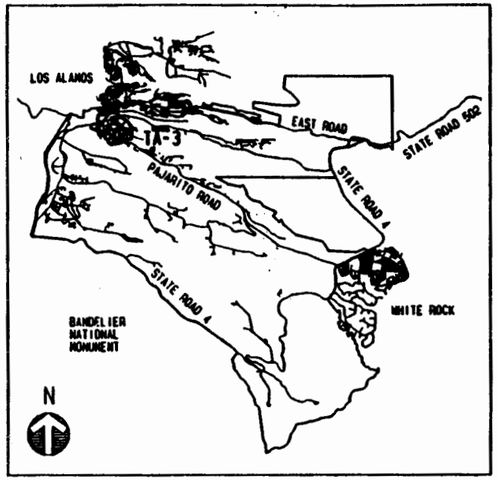

LOCATION PLAN

SCALE: NONE

NO	DATE	CLASS REV	REVISIONS	DWN	VER	CHKD	REL	SUB	REC	APP
1	06-30-94		REVISED TO NEW STANDARDS AND TO STATUS OF 06-09-94	JPM	JPM	HMS	HMS	JAF	BEC	RAP

JOHNSON CONTROLS WORLD SERVICES INC.

AS-BUILT STRUCTURE LOCATION MAPS

TA-03

SOUTH MESA SITE

DRAWN	J. NORK
VERIFIED	J. NORK
CHECKED	H. SALAZAR
RELEASED	H. SALAZAR
DATE	11-19-92

SUBMITTED JERRY FORTE — RECOMMENDED BRYAN COWER — APPROVED ROBERT PROMMEL

Los Alamos — Los Alamos National Laboratory, Los Alamos, New Mexico 87545

SHEET 1 of 6

CLASSIFICATION U — REVIEWER H. SALAZAR — DATE 6-30-94

PROJECT ID 11952 — DRAWING NO AB13 — REV 1

JCI NO 91-020

STRUCTURE LOCATION INDEX

STRUCTURE TA-NUMBER	STRUCTURE DESIGNATION	STRUCTURE NOMENCLATURE	STRUCTURE LOCATOR SHEET NO.	STRUCTURE LOCATOR MAP KEY
03-16	SM-16	ION BEAM FACILITY	5	D-4
03-22	SM-22	STEAM PLANT	4	A-6
03-23	SM-23	CANOPY	4	A-6
03-24	SM-24	WATER TREATMENT HOUSE	4	B-6
03-25	SM-25	COOLING TOWER	4	B-6
03-26	SM-26	FUEL TANK	4	B-5
03-27	SM-27	FUEL TANK	4	B-5
03-28	SM-28	OFFICE BUILDING	3	E-6
03-29	SM-29	CMR LABORATORY	5	F-2
03-30	SM-30	GENERAL WAREHOUSE	3	B-5
03-31	SM-31	CHEMICAL WAREHOUSE	3	B-6
03-32	SM-32	CNTR FOR MATERIAL SCIENCE	6	A-2
03-34	SM-34	CRYOGENICS BLDG. "B"	6	A-2
03-35	SM-35	PRESS BUILDING	6	B-3
03-36	SM-36	SERVICE STATION	3	C-5
03-37	SM-37	LAB MAINT./SHOPS/STOCK	3	C-4
03-38	SM-38	J.C.I. FACILITIES	3	D-4
03-39	SM-39	TECH SHOPS	5	E-2
03-40	SM-40	PHYSICS BUILDING	5	C-1
03-41	SM-41	FIRE STATION #1	3	F-3
03-42	SM-42	GUARD STATION #328	5	E-1
03-43	SM-43	ADMINISTRATION BUILDING	3	F-6
03-46	SM-46	FINAL SETTLING TANK	6	D-1
03-47	SM-47	TRICKLING FILTER	6	D-1
03-49	SM-49	IMHOFF TANK	6	C-1
03-55	SM-55	GAS HOUSE	4	B-6
03-57	SM-57	OIL PUMP HOUSE	4	B-5
03-58	SM-58	COOLING TOWER	4	B-6
03-65	SM-65	SOURCE STORAGE BUILDING	5	G-5
03-66	SM-66	SIGMA BUILDING	6	C-3
03-67	SM-67	GUARD STATION #317	6	B-3
03-70	SM-70	PARKS & REFUSE OFFICE	4	B-4
03-71	3-71	STORAGE BUILDING	4	A-4
03-73	3-73	ASPHALTIC CONCRETE PLANT	4	A-4
03-97	SM-97	GUARD STATION #329	3	E-6
03-100	SM-100	OFFICE BUILDING	3	D-6
03-102	SM-102	TECH SHOPS ADDITION	5	E-3
03-105	3-105	SHERWOOD BUILDING	3	E-5
03-123	SM-123	OFFICE BUILDING	3	G-5
03-127	SM-127	COOLING TOWER	6	C-3
03-130	SM-130	CALIBRATION BUILDING	6	A-5
03-132	SM-132	COMPUTER BUILDING	3	F-5
03-141	SM-141	ROLLING MILL BUILDING	6	D-3
03-142	SM-142	WAREHOUSE	3	B-4
03-144	SM-144	SUBSTATION	4	A-5
03-145	SM-145	SWITCHGEAR STATION	6	B-3
03-147	SM-147	AIR PLENUM & FAN BUILDING	6	D-3
03-149	SM-149	SWITCHGEAR STATION	5	E-1
03-154	SM-154	HOT WASTE PUMP HOUSE	5	F-3
03-156	3-156	COOLING TOWER	3	E-5
03-159	SM-159	FORMING BUILDING	6	D-3
03-161	SM-161	MAGAZINE	6	D-3
03-163	SM-163	PUMP HOUSE	3	E-5
03-164	3-164	SHOP STORAGE BUILDING	5	E-3
03-169	SM-169	WAREHOUSE	6	C-3
03-170	SM-170	LIQUID & COMPRESSED GAS FACILITY	6	D-1
03-179	SM-179	STORAGE SHED	4	B-4
03-187	SM-187	COOLING TOWER	6	B-2
03-192	SM-192	IMHOFF TANK	6	C-1
03-194	SM-194	TRICKLING FILTER	6	D-1
03-195	SM-195	SECONDARY CLARIFIER	6	D-1
03-200	SM-200	OFFICE BUILDING	3	G-6
03-206	SM-206	EQUIPMENT BUILDING	5	D-1
03-207	SM-207	OPPENHEIMER STUDY CENTER	3	F-5
03-208	SM-208	EQUIPMENT BUILDING	5	D-4
03-215	SM-215	PHYSICS ANALYTICAL CENTER	5	C-1
03-216	SM-216	WEAPONS TEST SUPPORT FAC.	5	F-1
03-218	SM-218	MAG. ENERGY & STORAGE FAC.	5	D-1
03-223	SM-223	UTILITIES CONTROL CENTER	6	C-1
03-224	SM-224	STORAGE SHED	3	C-5
03-225	SM-225	STORAGE SHED	4	B-4
03-228	SM-228	SERVICE SUPPORT BUILDING	5	D-1
03-230	SM-230	RELAY BUILDING	4	A-5
03-231	SM-231	RADIO TOWER	4	A-5
03-232	SM-232	SUBSTATION	4	A-5
03-233	SM-233	SUBSTATION	4	A-5
03-246	3-246	CABLE CONTROL BUILDING	3	C-4
03-247	SM-247	CABLE STRESSER BLDG.	3	C-4
03-251	SM-251	VALVE HOUSE, WATER	4	B-6
03-253	SM-253	ELECTRON PROTOTYPE LAB	5	D-2
03-261	SM-261	OTOWI BUILDING	3	E-4
03-271	SM-271	OFFICE BUILDING	4	C-4
03-285	SM-285	COOLING TOWER	4	B-6
03-287	SM-287	SYLLAC LAB/OFFICE BLDG.	3	E-6
03-316	SM-316	HIGH VOLTAGE TEST FACILITY	5	F-4
03-317	SM-317	GRAPHITE FLOUR STOR. BLDG.	6	D-2
03-322	SM-322	SUPPLY BUILDING	5	D-1
03-332	SM-332	OFFICE BUILDING	3	F-6
03-334	SM-334	EQUIPMENT SHELTER	6	D-1
03-336	SM-336	STORAGE TANK, EFFLUENT	4	B-6
03-373	SM-373	GUARD STATION	5	E-1
03-374	SM-374	DRUM STORAGE SHED	3	B-6
03-379	SM-379	LEAD & PAINT STORAGE FAC.	3	C-4
03-390	SM-390	MODULAR OFFICE BUILDING	5	G-1
03-391	SM-391	MODULAR OFFICE BUILDING	5	G-1
03-400	SM-400	MODULAR OFFICE BUILDING	3	D-5
03-401	SM-401	MODULAR OFFICE BUILDING	3	D-5
03-402	SM-402	MODULAR OFFICE BUILDING	3	E-5
03-403	SM-403	MODULAR OFFICE BUILDING	3	E-5
03-406	SM-406	MODULAR OFFICE BUILDING	5	D-1
03-409	SM-409	OCCUPATIONAL MEDICAL FAC.	5	E-1
03-410	SM-410	OFFICE FACILITY	5	G-1
03-422	SM-422	OFFICE BUILDING	5	E-1
03-425	SM-425	OFFICE BUILDING	3	D-5
03-440	SM-440	CENTRAL ALARM STATION	5	F-4
03-443	SM-443	UNIVERSITY HOUSE	3	G-4
03-447	3-447	NTS TOWER	3	C-3
03-451	SM-451	MICRO MACHINING FACILITY	6	C-3
03-452	SM-452	OFFICE BLDG.	3	E-5
03-456	SM-456	TRANSPORTABLE OFFICE BLDG.	5	G-1
03-460	SM-460	TRANSPORTABLE OFFICE BLDG.	5	C-2
03-461	3-461	TRANSPORTABLE OFFICE BLDG.	5	C-2
03-462	3-462	TRANSPORTABLE OFFICE BLDG.	5	C-2
03-463	SM-463	TRANSPORTABLE OFFICE BLDG.	3	A-6
03-467	SM-467	TRANSPORTABLE OFFICE BLDG.	5	C-2
03-468	SM-468	TRANSPORTABLE OFFICE BLDG.	5	F-4
03-469	SM-469	TRANSPORTABLE OFFICE BLDG.	3	F-6
03-470	SM-470	TRANSPORTABLE OFFICE BLDG.	5	E-4
03-471	3-471	TRANSPORTABLE OFFICE BLDG.	3	F-6
03-472	SM-472	TRANSPORTABLE OFFICE BLDG.	5	C-2
03-473	SM-473	TRANSPORTABLE OFFICE BLDG.	5	C-2
03-474	SM-474	TRANSPORTABLE OFFICE BLDG.	5	G-4
03-476	3-476	STORAGE SHED	6	D-1
03-477	SM-477	STORAGE SHED	5	F-5
03-478	SM-478	STORAGE SHED	4	B-4
03-479	SM-479	STORAGE SHED	4	B-4
03-480	SM-480	TRANSPORTABLE OFFICE BLDG.	6	A-1
03-481	SM-481	TRANSPORTABLE OFFICE BLDG.	6	A-1
03-482	SM-482	TRANSPORTABLE OFFICE BLDG.	6	A-1
03-483	SM-483	TRANSPORTABLE OFFICE BLDG.	6	A-1
03-484	SM-484	TRANSPORTAINER	3	F-6
03-490	SM-490	RECEPTION CENTER	3	F-5
03-494	SM-494	GEOCHEM. ANALYTICAL FAC.	5	B-1
03-495	SM-495	TRANSPORTABLE OFFICE BLDG.	5	F-4
03-496	SM-496	TRANSPORTABLE OFFICE BLDG.	5	G-4
03-497	SM-497	TRANSPORTABLE OFFICE BLDG.	5	D-3
03-500	3-500	TRAILER, OFFICE	6	B-1
03-502	3-502	SPACE SCIENCE LABORATORY	5	D-1
03-503	3-503	GUARD STATION #321	5	G-3
03-508	3-508	COMPUTATIONAL PHYSICS BLDG.	3	G-6
03-510	3-510	PHOTO LAB	3	E-6
03-512	3-512	TRANSPORTABLE	5	G-4
03-513	3-513	TRANSPORTABLE	5	G-4
03-514	3-514	TRANSPORTABLE	5	G-4
03-516	3-516	TRANSPORTABLE	3	A-6
03-517	3-517	TRANSPORTABLE	3	A-6
03-521	3-521	STORAGE SHED	3	C-4
03-522	3-522	GAS REGULATING STATION	3	B-3
03-524	3-524	TECHNICAL SUPPORT BUILDING	3	G-6
03-525	3-525	GAS METERING STATION	3	B-3
03-530	3-530	SHED	3	C-4
03-531	3-531	SHED	5	E-1
03-532	3-532	TRANSPORTAINER	6	D-1
03-533	3-533	TRANSPORTAINER	6	D-1
03-536	3-536	TRAILER, STORAGE	5	E-1
03-537	3-537	TRAILER, STORAGE	5	E-1
03-539	3-539	CHEMICAL STORAGE LOCKER	5	F-5
03-541	3-541	TRANSPORTAINER	6	C-3
03-545	3-545	OFFICE TRAILER	5	B-2
03-546	3-546	OFFICE TRAILER	5	C-2
03-548	3-548	STORAGE TRAILER	3	A-6
03-549	3-549	TRANSPORTAINER	5	C-3
03-550	3-550	OIL CONTAINMENT TANK	5	F-5
03-551	3-551	STORAGE BLDG.	5	E-1
03-553	3-553	STORAGE TRAILER	3	B-4
03-555	3-555	TRANSPORTAINER	5	B-1
03-556	3-556	OIL CONTAINMENT TANK	5	F-5
03-558	3-558	TRANSPORTAINER	5	F-3
03-559	3-559	TRANSPORTAINER	5	F-3
03-563	3-563	PALM READER STATION	5	B-1
03-564	3-564	EQUIPMENT SHELTER	5	F-2
03-565	3-565	TRANSPORTAINER	4	C-6
03-1188	SM-1188	CAPACITOR STATION	4	A-5
03-1196	3-1196	SWITCHGEAR STATION	5	F-2
03-1228	SM-1228	STORAGE SHED	5	F-5
03-1229	SM-1229	STORAGE SHED	5	G-5
03-1233	3-1233	STORAGE SHED	3	C-5
03-1264	3-1264	UNLOADING STATION	6	B-3
03-1269	SM-1269	STORAGE SHED	5	C-1
03-1353	3-1353	TRANSPORTABLE OFFICE BLDG.	5	F-3
03-1483	3-1483	TEST TOWER	3	C-3
03-1494	3-1494	STORAGE BUILDING	4	B-4
03-1495	1495	TRANSPORTABLE OFFICE BLDG.	3	C-6
03-1496	SM-1496	TRANSPORTABLE OFFICE BLDG.	3	C-6
03-1498	3-1498	LAB DATA COMM. CENTER	3	G-5
03-1500	SM-1500	TRAILER, OFFICE	3	C-4
03-1501	SM-1501	TRAILER, STORAGE	4	B-4
03-1504	3-1504	TRAILER, OFFICE	6	D-3
03-1505	3-1505	TRAILER, OFFICE	6	D-3
03-1514	3-1514	TRAILER, OFFICE	6	D-3
03-1516	SM-1516	TRAILER, OFFICE	5	C-1
03-1518	SM-1518	TRAILER, OFFICE	3	D-5
03-1520	3-1520	TRAILER, OFFICE	5	E-3
03-1522	SM-1522	TRAILER, OFFICE	5	F-5
03-1524	SM-1524	TRAILER, OFFICE	6	C-3
03-1525	SM-1525	TRAILER, OFFICE	6	C-3
03-1526	3-1526	TRAILER, CRAFTS	3	C-4
03-1527	SM-1527	TRAILER, OFFICE	5	G-4
03-1530	SM-1530	TRAILER, OFFICE	5	C-2
03-1532	SM-1532	TRAILER, OFFICE	6	D-2
03-1533	SM-1533	TRAILER, OFFICE	5	D-2
03-1534	SM-1534	TRAILER, OFFICE	5	C-2
03-1535	3-1535	TRAILER, OFFICE	4	B-6
03-1538	3-1538	TRAILER, OFFICE	5	F-5
03-1539	3-1539	TRAILER, OFFICE	5	F-4
03-1540	3-1540	TRAILER, OFFICE	5	B-1
03-1541	SM-1541	TRAILER, OFFICE	5	B-1
03-1543	SM-1543	TRAILER, OFFICE	6	B-1
03-1544	SM-1544	TRAILER, OFFICE	6	B-1
03-1545	SM-1545	TRAILER, OFFICE	6	B-1
03-1546	SM-1546	TRAILER, OFFICE	5	F-1
03-1549	SM-1549	TRAILER, OFFICE	5	G-1
03-1550	SM-1550	TRAILER, OFFICE	5	G-1
03-1552	SM-1552	TRAILER, OFFICE	6	B-1
03-1553	3-1553	TRAILER, OFFICE	6	B-2
03-1554	SM-1554	TRAILER, OFFICE	6	B-2
03-1559	3-1559	TRANSPORTABLE OFFICE BLDG.	3	E-6
03-1561	SM-1561	GUARD STATION #330	5	F-1
03-1565	3-1565	TRAILER, OFFICE	6	B-2
03-1566	3-1566	TRANSPORTABLE OFFICE BLDG.	3	E-6
03-1567	3-1567	TRAILER, OFFICE	6	B-2
03-1568	SM-1568	TRAILER, OFFICE	3	C-4
03-1569	SM-1569	TRAILER, OFFICE	3	D-5
03-1570	SM-1570	TRAILER, OFFICE	6	B-1
03-1571	SM-1571	TRAILER, OFFICE	6	B-1
03-1572	3-1572	TRAILER, OFFICE	5	C-2
03-1573	SM-1573	TRAILER, OFFICE	3	E-6
03-1574	SM-1574	TRAILER, OFFICE	3	E-6
03-1575	SM-1575	TRANSPORTABLE OFFICE BLDG.	6	B-2
03-1578	3-1578	TRAILER, OFFICE	5	C-3
03-1579	SM-1579	TRAILER, OFFICE	5	F-1
03-1586	SM-1586	TRAILER, OFFICE	6	B-1
03-1588	SM-1588	TRAILER, OFFICE	3	E-6
03-1589	SM-1589	TRAILER, OFFICE	3	E-6
03-1593	SM-1593	TRAILER, OFFICE	5	E-3
03-1596	3-1596	TRAILER, OFFICE	5	C-2
03-1597	SM-1597	TRAILER, OFFICE	3	D-5
03-1599	3-1599	TRAILER, OFFICE	6	B-2
03-1610	3-1610	GUARD STATION #331	5	F-1
03-1612	SM-1612	TRANSPORTABLE OFFICE BLDG.	5	F-5
03-1613	SM-1613	TRANSPORTABLE OFFICE BLDG.	3	C-6
03-1614	SM-1614	GUARD STATION #332	5	G-1
03-1615	SM-1615	GUARD STATION #323	5	E-3
03-1616	SM-1616	TRANSPORTABLE OFFICE BLDG.	3	G-4
03-1617	SM-1617	TRANSPORTABLE OFFICE BLDG.	3	G-4
03-1635	SM-1635	TRANSPORTABLE OFFICE BLDG.	5	D-1
03-1636	3-1636	TRANSPORTABLE OFFICE BLDG.	5	E-1
03-1648	3-1648	MORGAN STORAGE SHED	5	F-1
03-1650	3-1650	STORAGE SHED	6	D-1
03-1651	3-1651	OFFICE TRAILER	4	A-5
03-1663	SM-1663	WELLNESS CENTER	3	A-4
03-1664	3-1664	STORAGE SHED	3	E-6
03-1673	3-1673	STORAGE SHED	3	C-4
03-1675	SM-1675	MORGAN SHED	3	A-6
03-1682	3-1682	SWITCHGEAR, 13.2 KV	4	A-6
03-1688	3-1688	TRANSPORTAINER	6	B-1
03-1690	3-1690	CNLS TECH RESEARCH BLDG.	3	G-6
03-1698	3-1698	MATERIAL SCIENCE LABORATORY	6	A-2
03-1701	3-1701	TRAILER, ELECTRONICS	5	C-3
03-1702	3-1702	TRAILER, OFFICE	5	B-2
03-1706	SM-1706	TRAILER, OFFICE	6	B-1
03-1712	3-1712	TRAILER, OFFICE	6	B-2
03-1714	SM-1714	TRAILER, OFFICE	5	C-1
03-1725	SM-1725	TRAILER, OFFICE	3	E-6
03-1730	3-1730	TRAILER, OFFICE	5	E-4
03-1731	3-1731	TRAILER, OFFICE	5	E-4
03-1732	3-1732	TRAILER, OFFICE	6	B-2
03-1734	3-1734	TRAILER, OFFICE	5	G-5
03-1736	3-1736	TRAILER, OFFICE	5	D-2
03-1737	3-1737	TRAILER, OFFICE	5	D-2
03-1738	3-1738	TRAILER, OFFICE	5	D-2
03-1739	3-1739	TRAILER, OFFICE	6	B-1
03-1741	3-1741	TRAILER, OFFICE	6	B-1
03-1745	3-1745	TRAILER, OFFICE	6	B-2
03-1746	3-1746	TRAILER, OFFICE	6	B-2
03-1747	3-1747	TRAILER, OFFICE	6	B-2
03-1749	3-1749	TRAILER, OFFICE	6	B-2
03-1750	3-1750	TRAILER, OFFICE	6	B-1
03-1760	3-1760	TRAILER, OFFICE	6	B-1
03-1761	SM-1761	TRAILER, OFFICE	6	B-2
03-1762	3-1762	TRAILER, OFFICE	5	G-5
03-1763	3-1763	TRAILER, OFFICE	5	E-3
03-1764	3-1764	TRAILER, OFFICE	5	E-3
03-1766	3-1766	SHED	4	B-4
03-1767	3-1767	TRAILER, STORAGE	5	F-1
03-1769	3-1769	TRAILER, STORAGE	5	G-3
03-1770	3-1770	TRAILER, STORAGE	5	G-4
03-1771	3-1771	TRAILER, STORAGE	6	B-2
03-1776	3-1776	TRAILER, STORAGE	5	F-1
03-1778	3-1778	TRAILER, STORAGE	5	F-1
03-1781	3-1781	TRAILER, STORAGE	5	C-3
03-1782	3-1782	TRAILER, STORAGE	5	F-1
03-1784	3-1784	TRAILER, STORAGE	5	F-1
03-1786	3-1786	TRAILER, OFFICE	6	B-2
03-1787	SM-1787	TRAILER, OFFICE	6	B-2
03-1789	SM-1789	TRAILER, OFFICE	5	D-3
03-1790	3-1790	TRANSPORTABLE	4	A-5
03-1806	3-1806	GUARD STATION #338	3	G-5
03-1812	SM-1812	STORAGE SHED	5	G-3
03-1813	SM-1813	STORAGE SHED	5	G-4
03-1814	3-1814	GUARD TOWER	5	E-2
03-1819	SM-1819	EXP. MATERIAL SCI. LAB	6	B-2
03-1837	3-1837	COOLING TOWER	3	G-4
03-1855	SM-1855	TRANSPORTAINER	5	F-1
03-1865	3-1865	TRANSPORTAINER	5	C-3
03-1868	3-1868	TRANSPORTAINER	5	B-1
03-1874	3-1874	PEDESTRIAN TUNNEL	4	A-5
03-1887	3-1887	TRANSPORTABLE OFFICE BLDG.	5	B-1
03-1888	3-1888	TRANSPORTABLE OFFICE BLDG.	5	B-1
03-1898	3-1898	TRAILER, OFFICE	5	G-5
03-1903	3-1903	TRAILER, OFFICE	5	D-2
03-1908	3-1908	SHED	3	B-4
03-1911	SM-1911	TRANSPORTABLE OFFICE BLDG.	5	B-1
03-1912	SM-1912	TRANSPORTABLE OFFICE BLDG.	5	B-1
03-1913	3-1913	MORGAN SHED	5	G-4
03-1930	3-1930	TRANSPORTAINER	5	F-1
03-1931	3-1931	TRANSPORTAINER	6	B-2
03-1932	3-1932	TRANSPORTAINER	5	F-1
03-1933	3-1933	TRANSPORTAINER	5	B-1
03-1934	3-1934	TRANSPORTAINER	5	C-2
03-1935	3-1935	TRANSPORTAINER	5	C-3
03-1936	3-1936	TRANSPORTAINER	5	C-2
03-1937	3-1937	TRANSPORTAINER	5	F-1
03-1938	3-1938	TRANSPORTAINER	5	F-1
03-1939	3-1939	TRANSPORTAINER	5	F-1
03-1940	3-1940	TRANSPORTAINER	5	F-1
03-1941	3-1941	TRANSPORTAINER	5	F-1
03-1942	3-1942	TRANSPORTAINER	6	D-1
03-1943	3-1943	TRANSPORTAINER	5	F-1
03-1944	3-1944	TRANSPORTAINER	5	D-5
03-1945	3-1945	TRANSPORTAINER	5	D-5
03-1946	3-1946	TRANSPORTAINER	5	D-5
03-1948	3-1948	TRANSPORTAINER	5	F-1
03-1949	3-1949	TRANSPORTAINER	5	E-4
03-1950	3-1950	TRANSPORTAINER	5	D-2
03-1951	3-1951	TRANSPORTAINER	5	C-2
03-1956	3-1956	TRANSPORTAINER	5	C-2
03-1957	3-1957	TRANSPORTAINER	5	E-3
03-1960	3-1960	TRANSPORTAINER	5	F-5
03-1966	3-1966	HEAVY EQUIPMENT SHELTER	4	B-4
03-1967	3-1967	STORAGE SHED	6	C-1
03-1968	3-1968	STORAGE TANK	4	A-4
03-1969	3-1969	STORAGE TANK	4	A-4
03-1976	3-1976	MORGAN SHED	4	B-4
03-1977	3-1977	STORAGE SHED	4	B-4
03-1978	3-1978	STORAGE SHED	4	B-4
03-1985	3-1985	STORAGE SHED	3	C-3
03-1986	3-1986	STORAGE SHED	5	D-1
03-1989	3-1989	STORAGE SHED	4	B-4
03-1990	3-1990	MORGAN SHED	4	B-4
03-1994	3-1994	STORAGE SHED	5	E-3
03-1995	3-1995	STORAGE SHED	5	E-3
03-1997	3-1997	SALVAGE FIELD OFFICE	4	C-4
03-2002	3-2002	X-RAY MACHINE LABORATORY	6	B-2
03-2003	3-2003	TRANSPORTABLE	5	G-5
03-2004	3-2004	TRANSPORTABLE	5	G-5
03-2005	3-2005	TRANSPORTABLE	5	G-5
03-2006	3-2006	TRANSPORTABLE	5	G-5
03-2007	3-2007	TRANSPORTABLE	5	G-5
03-2008	3-2008	TRANSPORTABLE	5	G-5
03-2009	3-2009	TRANSPORTABLE	5	G-5
03-2010	3-2010	TRANSPORTABLE	5	G-5
03-2011	3-2011	ADVANCED COMPUTER LAB.	3	G-6
03-2012	3-2012	SHED	5	E-1
03-2018	3-2018	SHOP TRAILER	5	C-2
03-2025	3-2025	TRANSPORTABLE OFFICE BLDG.	3	A-6
03-2028	3-2028	TRANSPORTAINER	5	D-1
03-2029	3-2029	TRANSPORTAINER	5	E-1
03-2030	3-2030	SHED	5	F-1
03-2031	3-2031	TRANSPORTAINER	5	F-1
03-2033	3-2033	TRANSPORTAINER	4	C-6
03-2034	3-2034	TRANSPORTAINER	4	C-6
03-2039	3-2039	SHED	6	C-1
03-2040	3-2040	TRANSPORTAINER	6	C-1
03-2041	3-2041	TRANSPORTAINER	6	C-1
03-2042	3-2042	ACCESS BOOTH	4	A-6
03-2043	3-2043	TRAILER, INSTRUMENT	5	D-1
03-2055	3-2055	TRAILER, OFFICE	3	D-5
03-2056	3-2056	STORAGE SHED	5	F-1
03-2058	3-2058	CHEMICAL STORAGE	5	F-1
03-2062	3-2062	MORGAN SHED	5	G-5
03-2063	3-2063	TRAILER, DIAGNOSTIC	5	F-1
03-2065	3-2065	TRAILER, DIAGNOSTIC	5	F-1
03-2091	3-2091	TRAILER, OFFICE	3	D-5
03-2120	3-2120	TRANSPORTAINER	3	A-6
03-2121	3-2121	TRANSPORTAINER	3	A-6
03-2130	3-2130	WASTE STORAGE CONTAINER	5	D-5
03-2131	3-2131	SHED	4	C-6
03-2132	3-2132	WASTE STORAGE CONTAINER	6	C-3
03-2133	3-2133	WASTE STORAGE CONTAINER	5	D-1
03-2137	3-2137	TRAILER, STORAGE	4	C-4
03-2138	3-2138	SHED	4	A-4
03-2139	3-2139	TRANSPORTAINER	5	D-1
03-2141	3-2141	WASTE STORAGE CONTAINER	5	E-3
03-2146	3-2146	GUARD STATION	5	E-3
03-2147	3-2147	BADGE/PALM READER STATION	5	F-4
03-2148	3-2148	TRAILER, STORAGE	6	D-3
03-2158	3-2158	WASTE STORAGE BLDG.	5	B-1
03-2164	3-2164	BACK-UP GENERATOR	5	D-4
03-2165	3-2165	SHED	6	B-3
03-2168	3-2168	TRAILER, STORAGE	3	A-6
03-2169	3-2169	TRAILER, OFFICE	3	C-5
03-2182	3-2182	SHED	4	B-4
03-2192	3-2192	SHED	4	B-6
03-2197	3-2197	TRANSPORTAINER	5	F-1
03-2199	3-2199	TRALIER, STORAGE	3	A-6
03-2202	3-2202	CHEM-STOR SHED	5	E-3
03-2203	3-2203	CHEM-STOR SHED	5	E-3
03-2204	3-2204	CHEM-STOR SHED	5	E-3
03-2207	3-2207	TRANSPORTAINER	5	B-1
03-2209	3-2209	EFFLUENT PUMP BUILDING	4	D-6
03-2232	3-2232	TRANSPORTAINER	3	B-4
03-2234	3-2234	TRANSPORTAINER	5	C-2
03-2236	3-2236	CHEM-STOR SHED	6	A-2
03-2237	3-2237	TRAILER, OFFICE	4	C-4
03-2239	3-2239	TRAILER, OFFICE	4	A-6
03-2240	3-2240	TRAILER, OFFICE	4	A-6
03-2241	3-2241	TRANSPORTAINER	4	C-6
03-2242	3-2242	TRANSPORTAINER	4	B-6

NO	DATE	CLASS REV	REVISIONS	DWN	VER	CHKD	REL	SUB	REC	APP
3	06-30-94		REVISED TO NEW STANDARDS AND TO STATUS OF 06-09-94	JPN	JPN	HMS	HMS	JAF	BEC	RAP
2	09-30-93		REVISED TO STATUS OF 08-15-93	JPN	JPN	HMS	HMS	JAF	BEC	RAP
1	07-01-93		REVISED TO STATUS OF 06-21-93	JPN	JPN	HMS	HMS	JAF	BEC	RAP

JOHNSON CONTROLS WORLD SERVICES INC.

AS-BUILT STRUCTURE LOCATION MAPS

TA-03

SOUTH MESA SITE

DRAWN: J. WORK
VERIFIED: J. WORK
CHECKED: H. SALAZAR
RELEASED: H. SALAZAR
DATE: 11-19-92

SUBMITTED: JERRY FORTE
RECOMMENDED: BRYAN COMER
APPROVED: ROBERT PROWWEL

Los Alamos — Los Alamos National Laboratory, Los Alamos, New Mexico 87545

SHEET 2 — 2 OF 6

CLASSIFICATION: U — REVIEWER: H. SALAZAR — DATE: 6-30-94

PROJECT ID: 11952 — DRAWING NO: AB13 — REV: 3

JCI NO 91-020

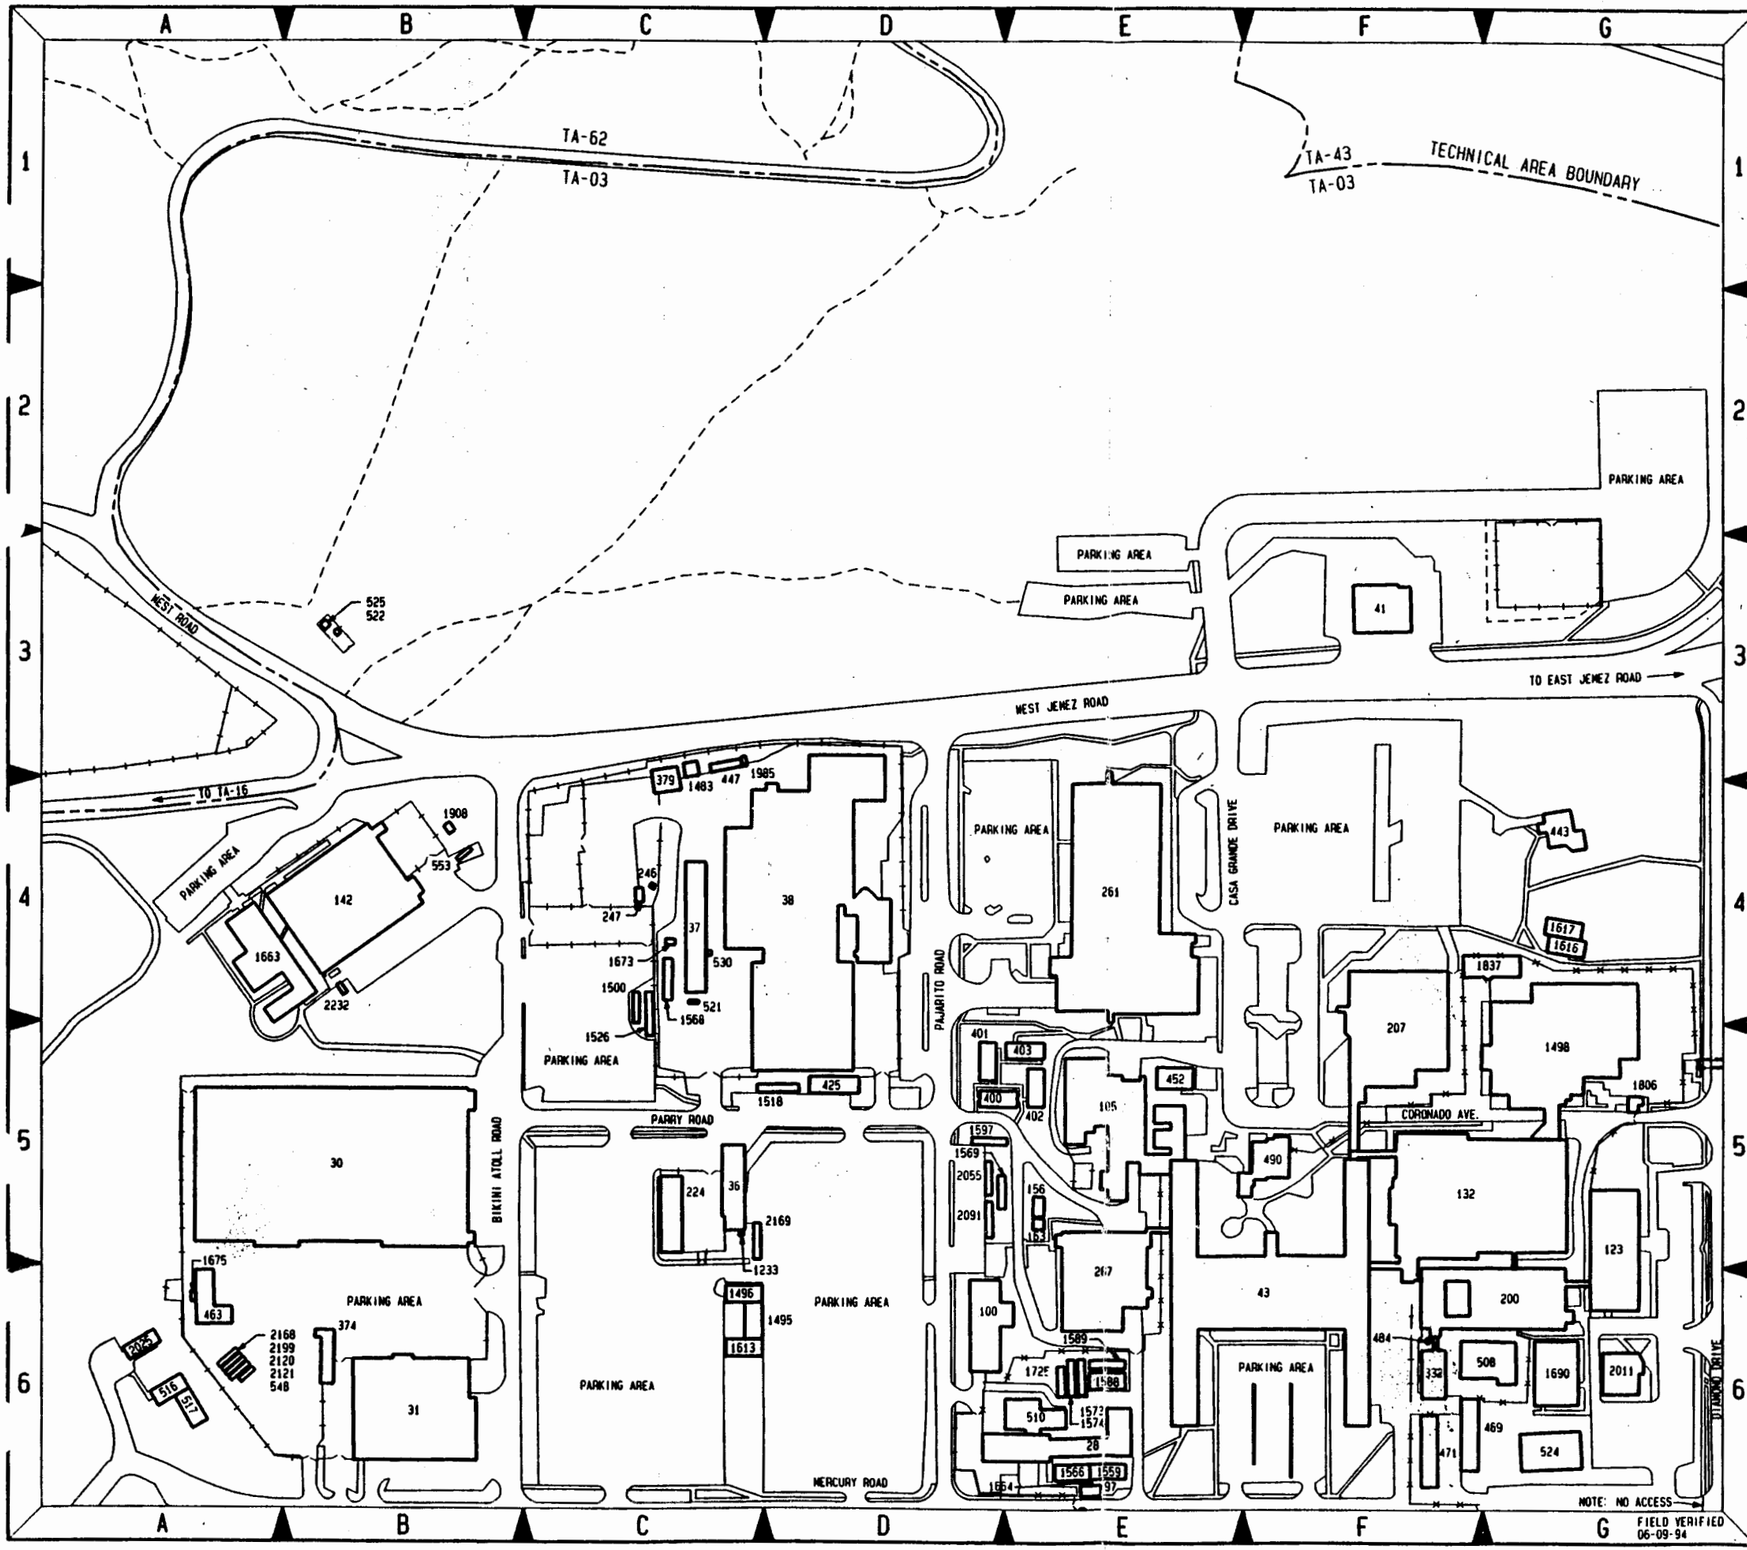

KEY MAP

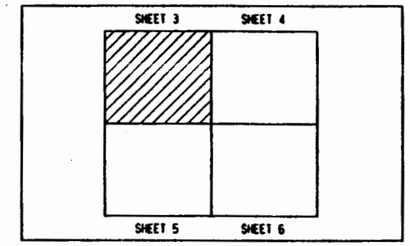

N

SCALE: 1:1320

110 0 110 220

FEET

NO	DATE	CLASS REV	REVISIONS	DWN	VER	CHKD	REL	SUB	REC	APP
3	06-30-94		REVISED TO NEW STANDARDS AND TO STATUS OF 06-09-94	JPN	JPN	HMS	HMS	JAF	BEC	RAP
2	09-30-93		REVISED TO STATUS OF 08-15-93	JPN	JPN	HMS	HMS	JAF	BEC	RAP
1	07-01-93		REVISED TO STATUS OF 06-21-93	JPN	JPN	HMS	HMS	JAF	BEC	RAP

JOHNSON CONTROLS WORLD SERVICES INC.

AS-BUILT STRUCTURE LOCATION MAPS

TA-03

SOUTH MESA SITE

DRAWN	J. HORN
VERIFIED	J. HORN
CHECKED	H. SALAZAR
RELEASED	H. SALAZAR
DATE	11-22-92

SUBMITTED JERRY FORTE — RECOMMENDED BRYAN COWER — APPROVED ROBERT PRUDHEL

Los Alamos — Los Alamos National Laboratory, Los Alamos, New Mexico 87545

SHEET 3 OF 6

CLASSIFICATION U — REVIEWER H. SALAZAR — DATE 6-30-94

PROJECT ID 11952 — DRAWING NO AB13 — REV 3

JCI NO 91-020

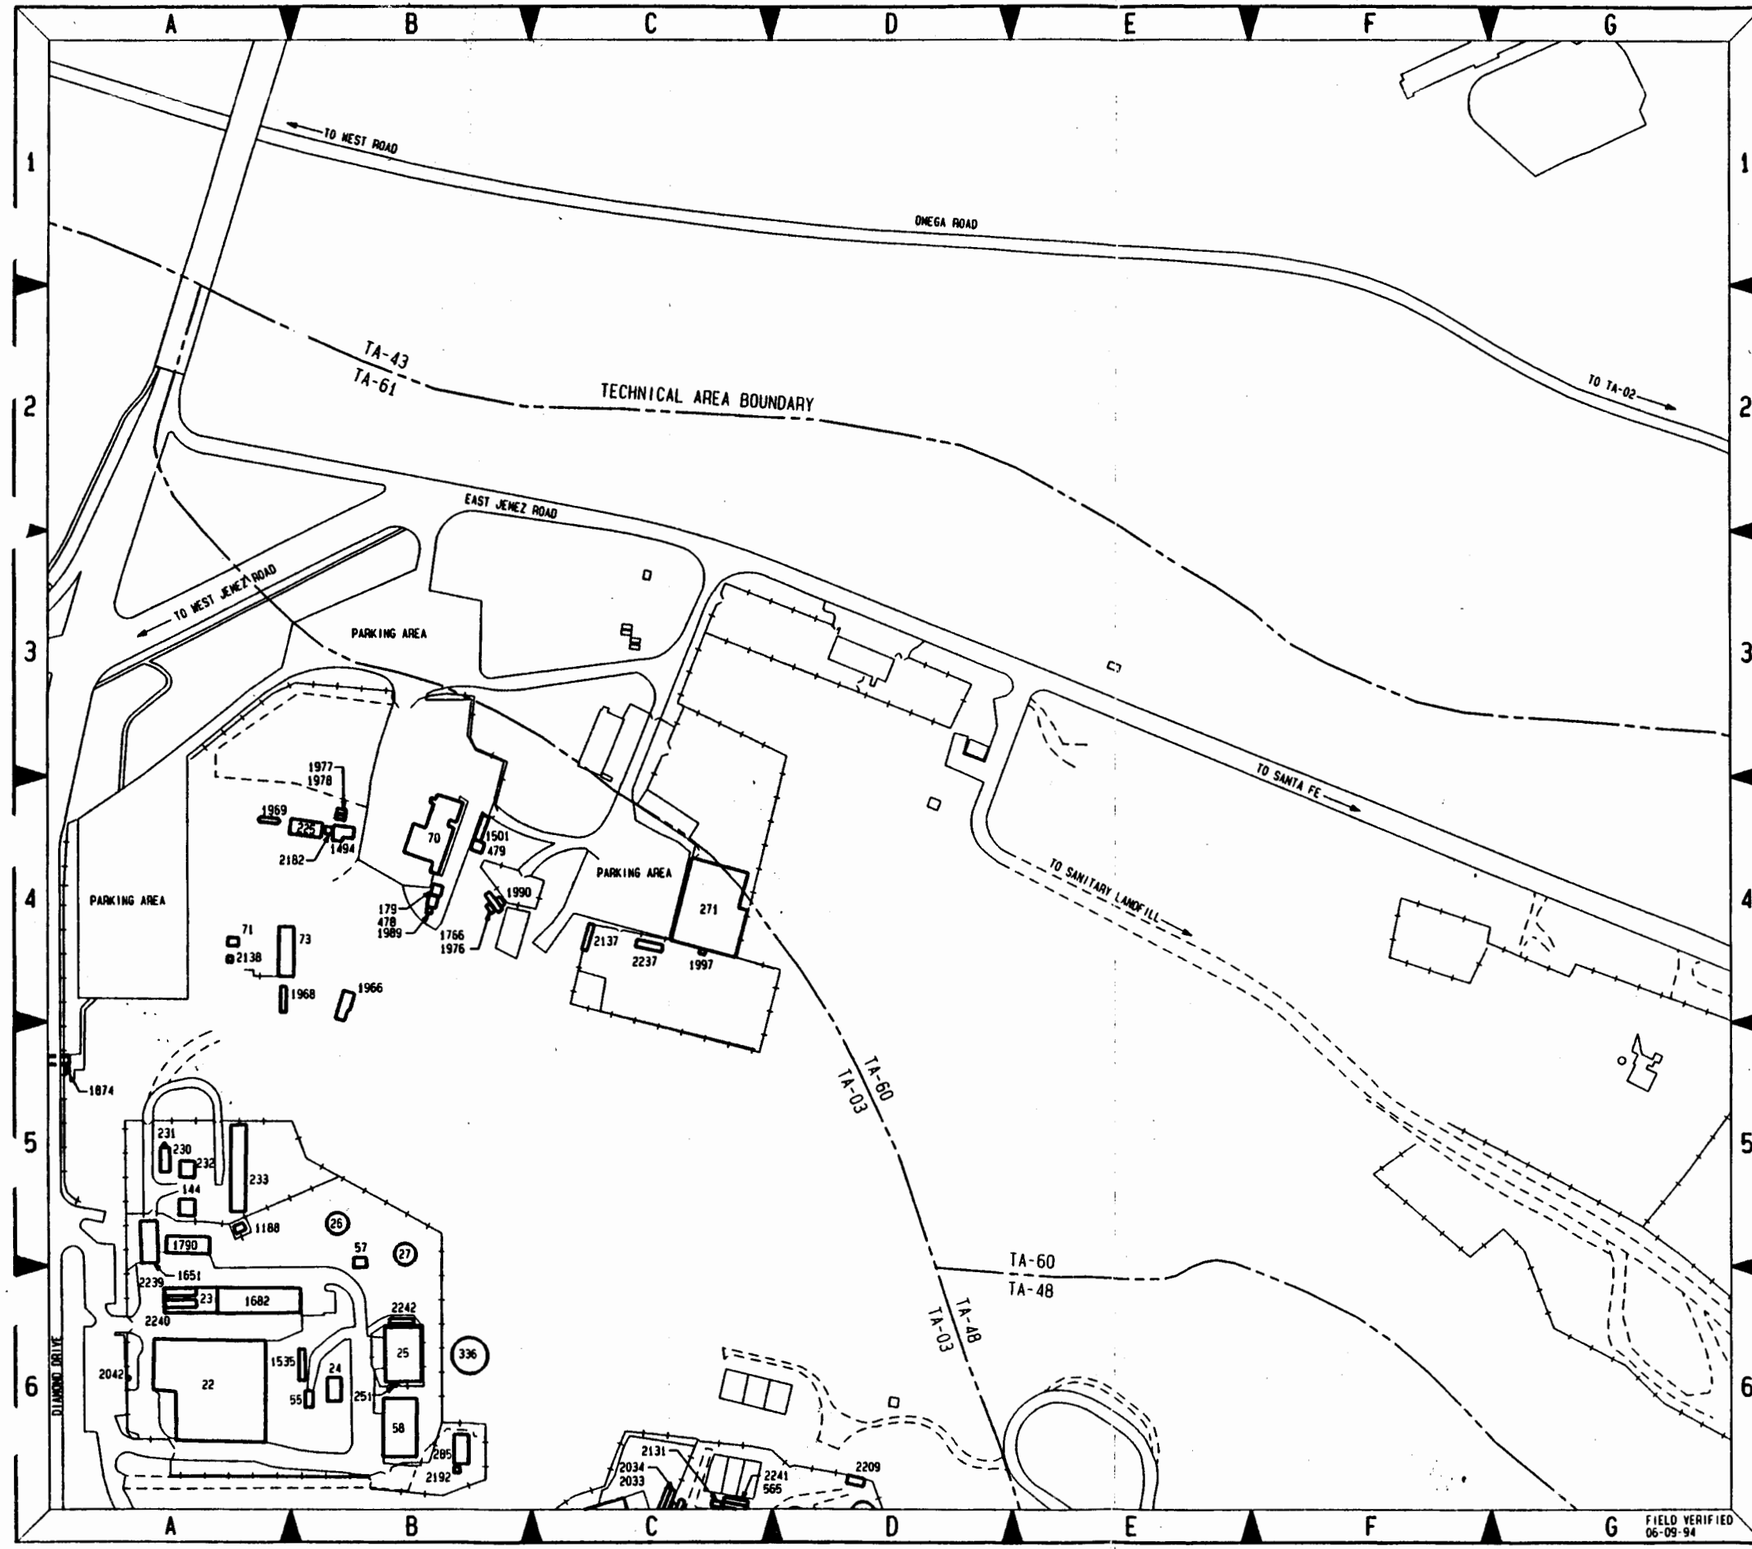

KEY MAP

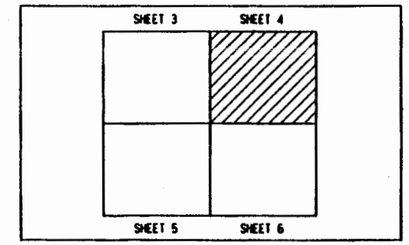

N

SCALE: 1:1320

110 0 110 220

FEET

NO	DATE	CLASS REV	REVISIONS	DWN	VER	CHKD	REL	SUB	REC	APP
3	06-30-94		REVISED TO NEW STANDARDS AND TO STATUS OF 06-09-94	JPM	JPM	HWS	HWS	JAF	BEC	RAP
2	09-30-93		REVISED TO STATUS OF 08-15-93	JPM	JPM	HWS	HWS	JAF	BEC	RAP
1	07-01-93		REVISED TO STATUS OF 06-21-93	JPM	JPM	HWS	HWS	JAF	BEC	RAP

JOHNSON CONTROLS WORLD SERVICES INC.

AS-BUILT STRUCTURE LOCATION MAPS

TA-03

SOUTH MESA SITE

DRAWN J. HORK
VERIFIED J. HORK
CHECKED H. SALAZAR
RELEASED H. SALAZAR
DATE 11-22-92

SUBMITTED JERRY FORIE
RECOMMENDED BRYAN COMER
APPROVED ROBERT PROMEL

Los Alamos

Los Alamos National Laboratory
Los Alamos, New Mexico 87545

SHEET 4 OF 6

CLASSIFICATION U REVIEWER H. SALAZAR DATE 6-30-94

PROJECT ID 11952

DRAWING NO AB13

REV 3

JCI NO 91-020

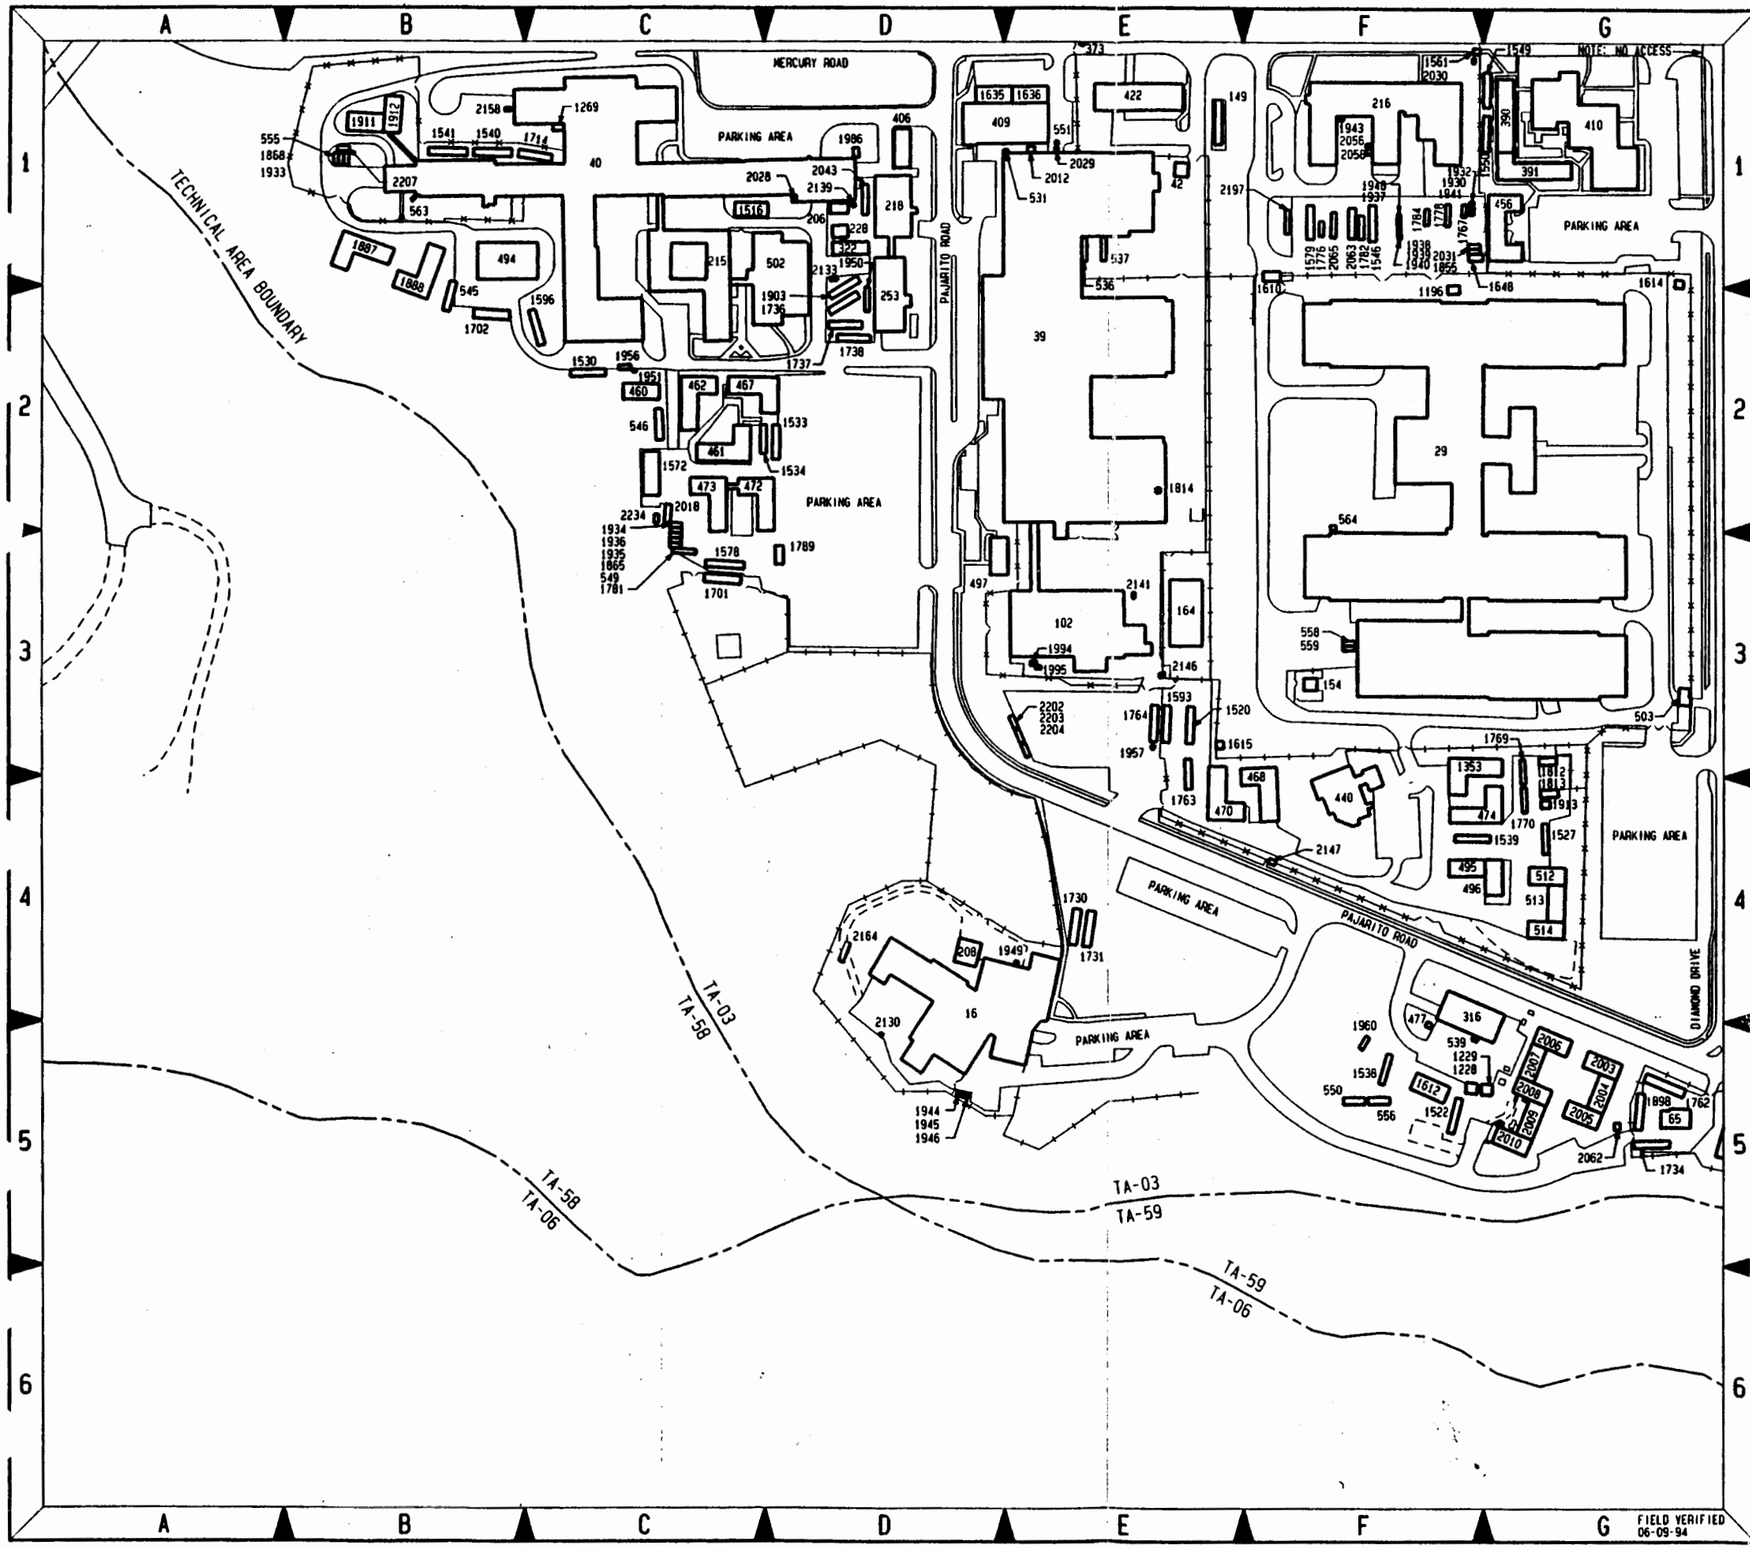

KEY MAP

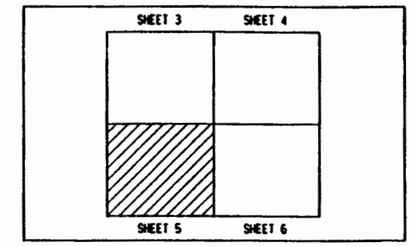

N

SCALE: 1:1320

110 0 110 220

FEET

NO	DATE	CLASS REV	REVISIONS	DWN	VER	CHKD	REL	SUB	REC	APP
3	06-30-94		REVISED TO NEW STANDARDS AND TO STATUS OF 06-09-94	JPM	JPM	HMS	HMS	JAF	BEC	RAP
2	09-30-93		REVISED TO STATUS OF 08-15-93	JPM	JPM	HMS	HMS	JAF	BEC	RAP
1	07-01-93		REVISED TO STATUS OF 06-21-93	JPM	JPM	HMS	HMS	JAF	BEC	RAP

JOHNSON CONTROLS WORLD SERVICES INC.

AS-BUILT STRUCTURE LOCATION MAPS

TA-03

SOUTH MESA SITE

DRAWN J. MORAN
VERIFIED J. MORAN
CHECKED K. SALAZAR
RELEASED K. SALAZAR
DATE 11-22-92

SUBMITTED JERRY FORTE
RECOMMENDED BRYAN COMER
APPROVED ROBERT PROMEL

Los Alamos — Los Alamos National Laboratory, Los Alamos, New Mexico 87545

SHEET 5 OF 6

CLASSIFICATION U REVIEWER K. SALAZAR DATE 6-30-94

PROJECT ID 11952 | DRAWING NO AB13 | REV 3

JCI NO 91-020

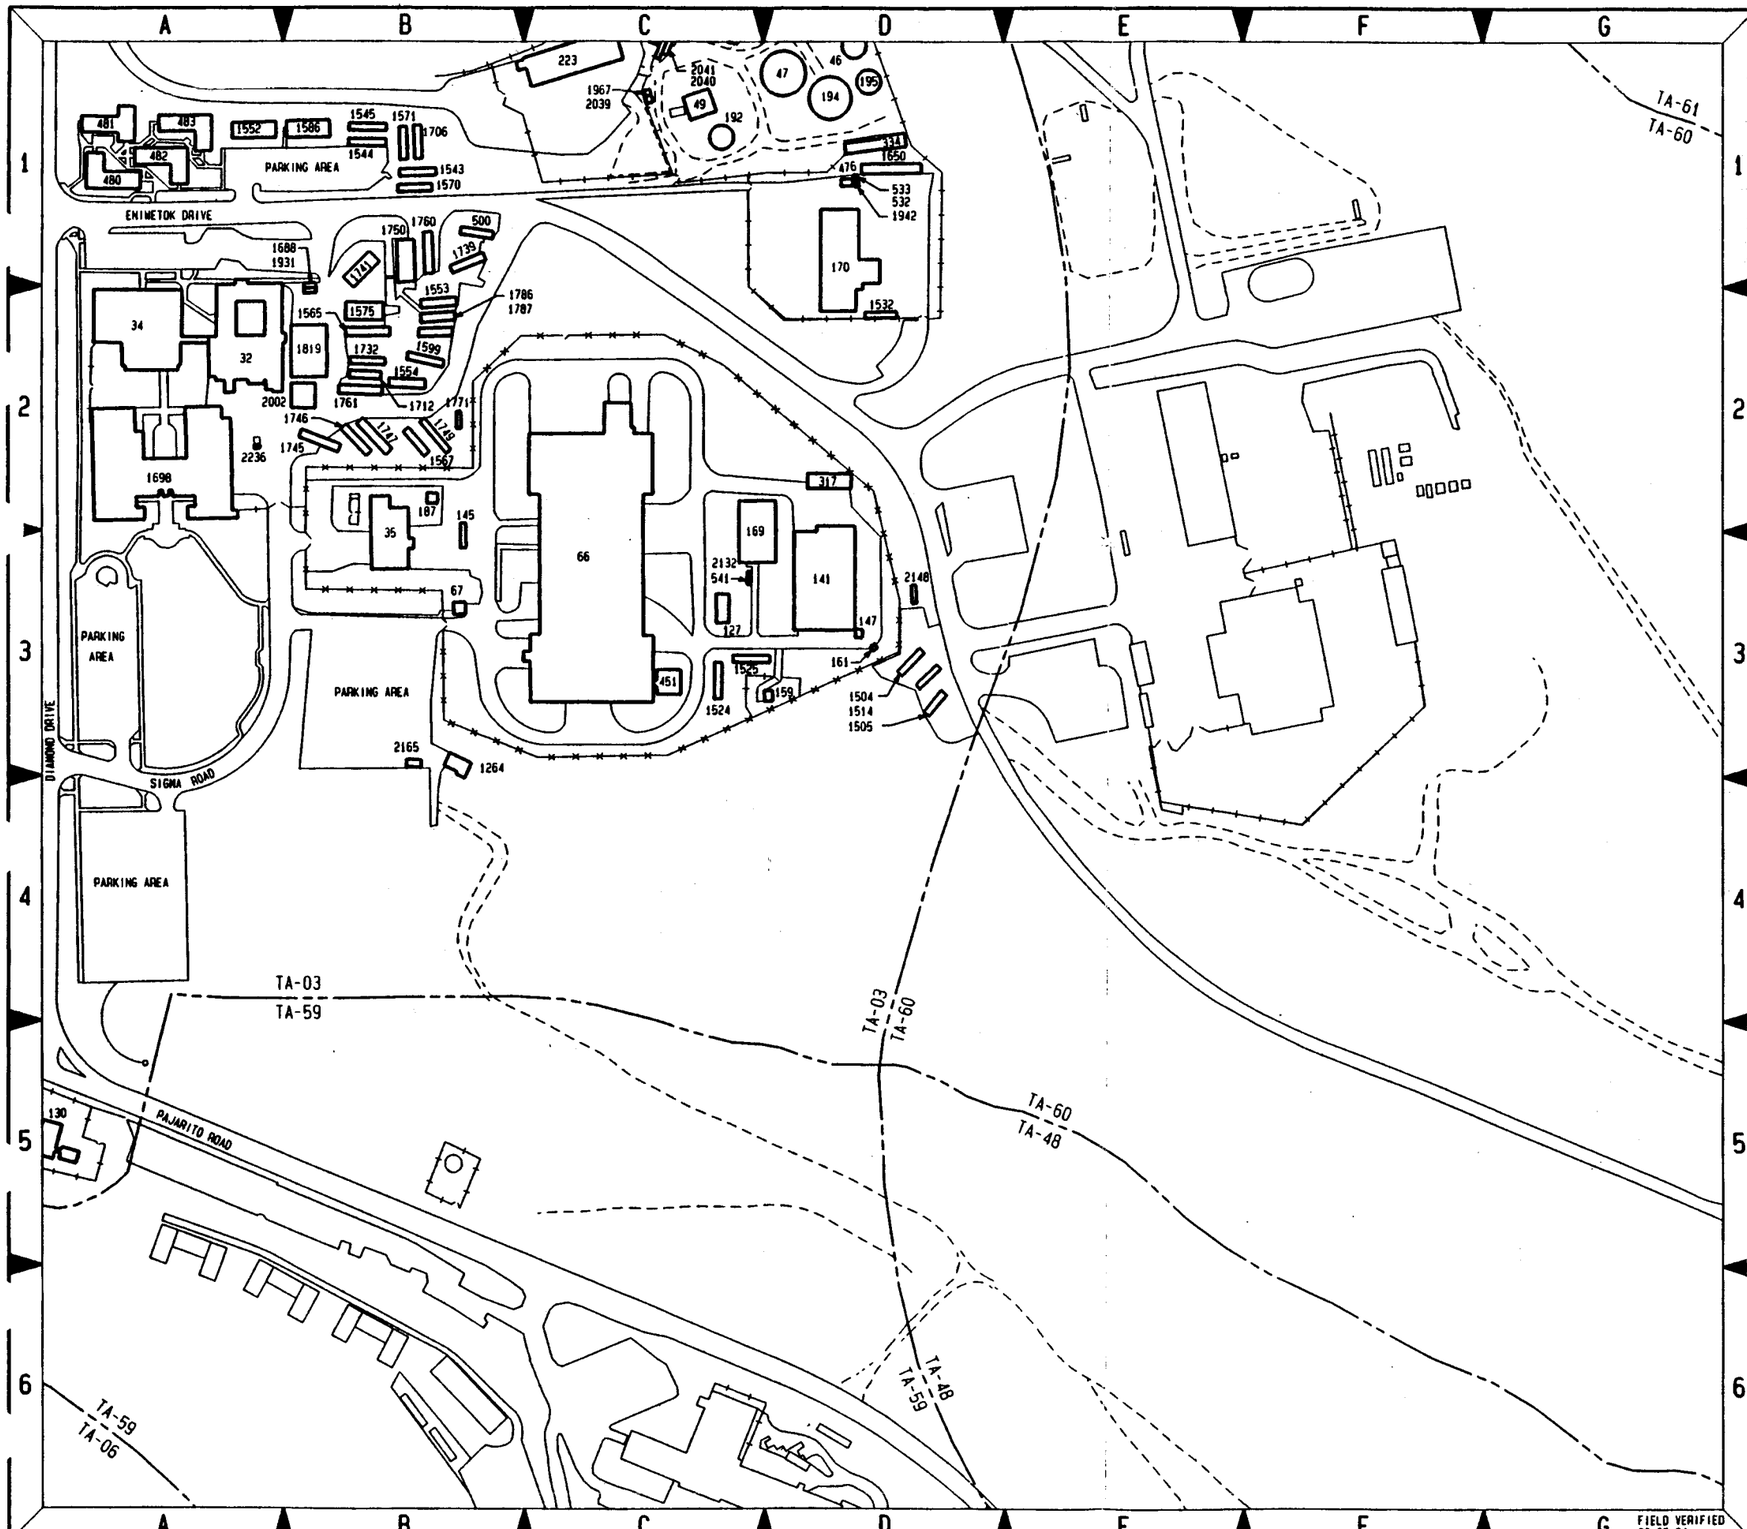

NO	DATE	CLASS REV	REVISIONS	DWN	VER	CHKD	REL	SUB	REC	APP
3	06-30-94		REVISED TO NEW STANDARDS AND TO STATUS OF 06-09-94	JPM	JPM	HMS	HMS	JAF	BEC	RAP
2	09-30-93		REVISED TO STATUS OF 08-15-93	JPM	JPM	HMS	HMS	JAF	BEC	RAP
1	07-01-93		REVISED TO STATUS OF 06-21-93	JPM	JPM	HMS	HMS	JAF	BEC	RAP

JOHNSON CONTROLS WORLD SERVICES INC.

AS-BUILT STRUCTURE LOCATION MAPS

TA-03

SOUTH MESA SITE

DRAWN J. HORN
VERIFIED J. HORN
CHECKED H. SALAZAR
RELEASED H. SALAZAR
DATE 11-22-92

SUBMITTED JERRY FORTE
RECOMMENDED BRYAN COHEN
APPROVED ROBERT PROMMEL

Los Alamos

Los Alamos National Laboratory
Los Alamos, New Mexico 87545

SHEET 6 OF 6

CLASSIFICATION U REVIEWER H. SALAZAR DATE 6-20-94

PROJECT ID 11952

DRAWING NO AB13

REV 3

JCI NO 91-020

TA-05

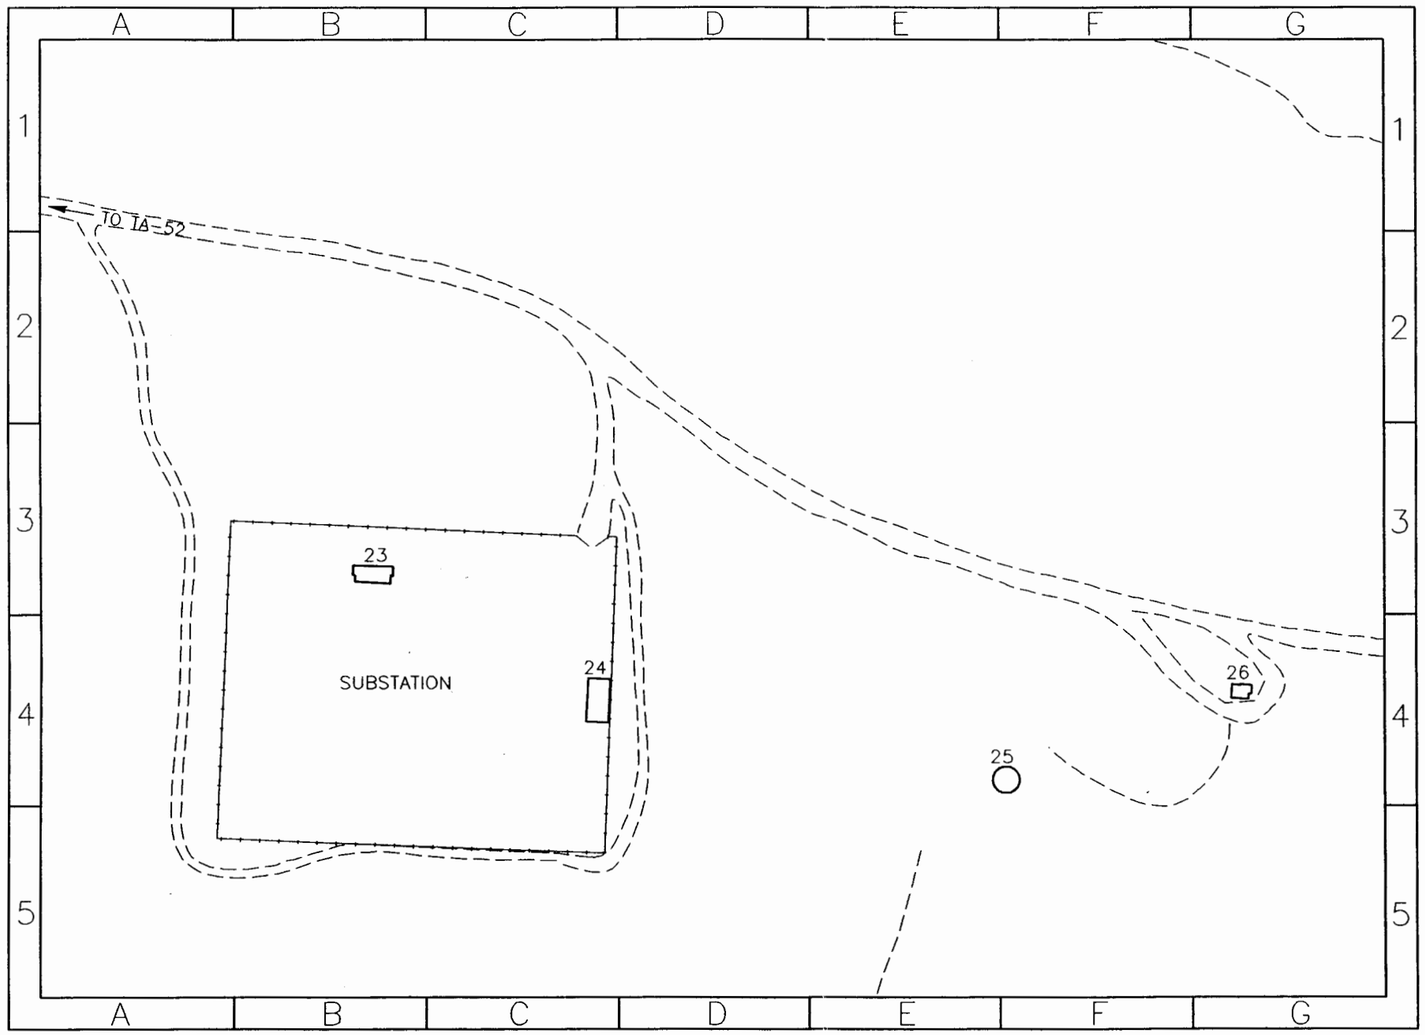

SCALE 1: 720

60 0 60 120 FEET

N

STRUCTURE NUMBER INDEX

STRUCTURE TA-NUMBER	STRUCTURE DESIGNATION	STRUCTURE NOMENCLATURE	STRUCTURE LOCATOR SHEET NO.	STRUCTURE LOCATOR MAP KEY
5- 23	5- 23	SWITCHGEAR VAULT	1	B-3
5- 24	5- 24	RELAY BUILDING	1	C-4
5- 25	5- 25	WATER TANK	1	F-4
5- 26	5- 26	PUMP HOUSE	1	G-4

NO.	DATE	CLASS REV.	REVISIONS	DWN	DES	CKD	REL	SUB	REC	APP

FACILITIES ENGINEERING DIVISION

STRUCTURE LOCATION MAP
TA-05
BETA SITE

BLDG.

DRAWN	C.SANDOVAL
DESIGN	
CHECKED	B. COMER
RELEASED	B. COMER
DATE	03-06-91

SUBMITTED | RECOMMENDED | APPROVED

LOS ALAMOS — LOS ALAMOS NATIONAL LABORATORY, LOS ALAMOS, NEW MEXICO 87545

SHEET 1 OF 1

CLASSIFICATION U REVIEWER DATE 4-15-91

LAB JOB NO.

DRAWING NO. ENG-R 7117

REV. 1

AUTOGIS

TA-06

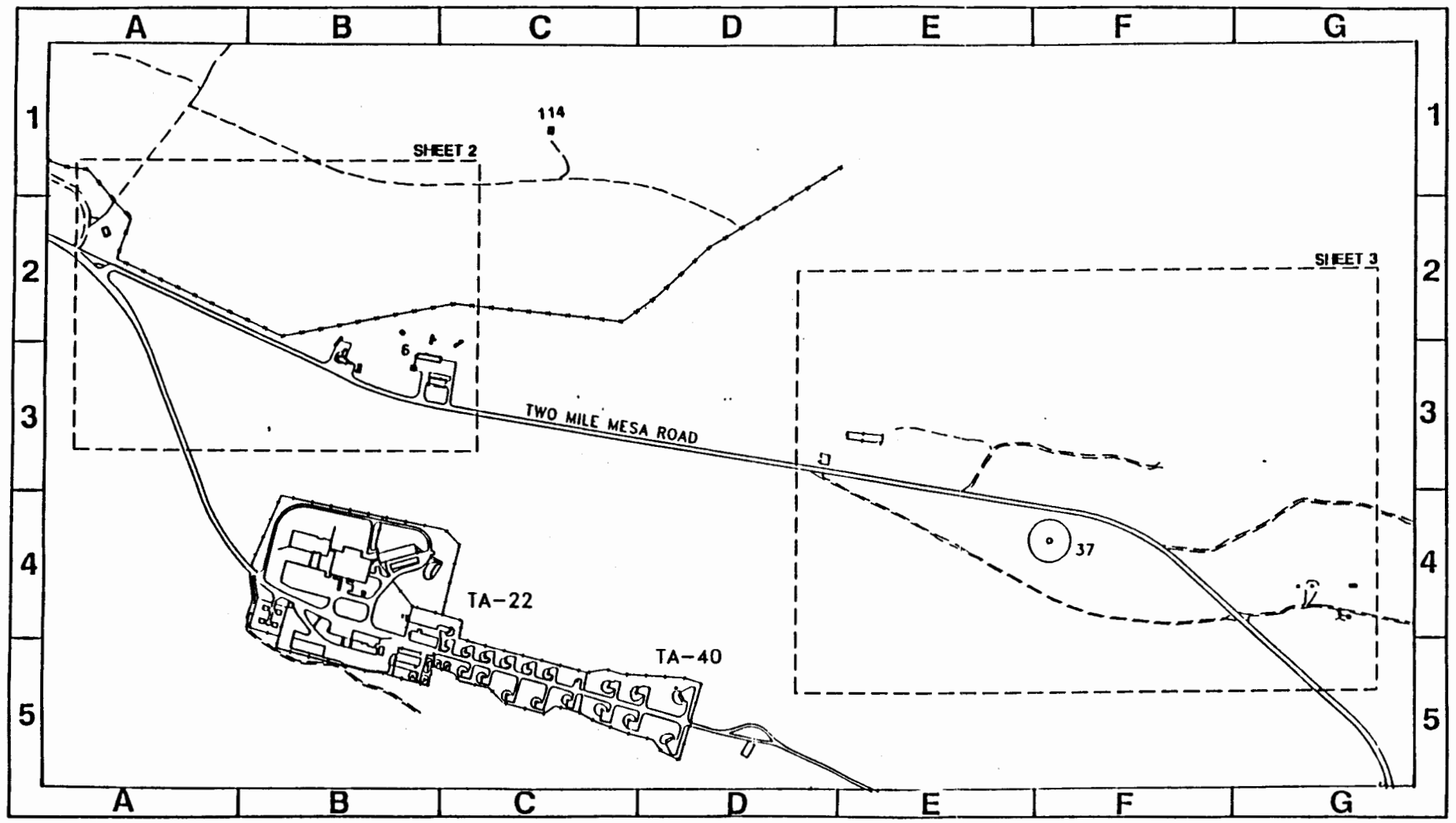

STRUCTURE NUMBER INDEX

STRUCTURE TA-NUMBER	STRUCTURE DESIGNATION	STRUCTURE NOMENCLATURE	STRUCTURE LOCATOR SHEET NO.	STRUCTURE LOCATOR MAP KEY
6- 1	TH- 1	CARPENTER SHOP	2	E-4
6- 2	TH- 2	COMPRESSOR BUILDING	2	E-4
6- 3	TH- 3	FABRICATION BUILDING	2	E-4
6- 5	TH- 5	INSPECTION BLDG.	2	F-4
6- 6	TH- 6	LAB OFFICE & SHOP BUILDING	2	G-4
6- 7	TH- 7	CHEMICAL STORAGE BUILDING	2	F-3
6- 8	TH- 8	LABORATORY BUILDING	2	G-4
6- 9	TH- 9	FIRING CHAMBER	2	G-4
6- 37	6- 37	CONCRETE BOWL	3	D-3
6- 63	6- 63	PUMP STATION #2	2	A-2
6- 78	6- 78	METEOROLOGICAL TOWER	3	G-4
6- 80	6- 80	SHED	3	G-5
6- 90	6- 90	TRAILER	2	E-3
6- 91	6- 91	INSTRUMENT SHED	3	G-4
6-100	6-100	ANTENNA	3	G-4
6-114	6-114	SHED	1	C-1

N

SCALE 1: 3600

300 0 300 600 FEET

LATEST DISTRIBUTION
30APRIL92
EMERGENCY RESPONSE MAP
UPDATED DRAWING

AUTOGIS

NO.	DATE	LAST REV.	REVISIONS	DWN	DES	CKD	REL	SUB	REC	APP

FACILITIES ENGINEERING DIVISION

STRUCTURE LOCATION MAP
TA-06
TWO MILE MESA SITE

DRAWN	C.SANDOVAL
DESIGN	
CHECKED	B. COMER
RELEASED	B. COMER
DATE	03-06-91

BLDG.
SUBMITTED
RECOMMENDED
APPROVED

LOS ALAMOS — LOS ALAMOS NATIONAL LABORATORY, LOS ALAMOS, NEW MEXICO 87545

SHEET 1 OF 3

CLASSIFICATION U REVIEWER DATE 4-15-91

LAB JOB NO.

DRAWING NO. ENG-R 5105

REV. 18

TA-06

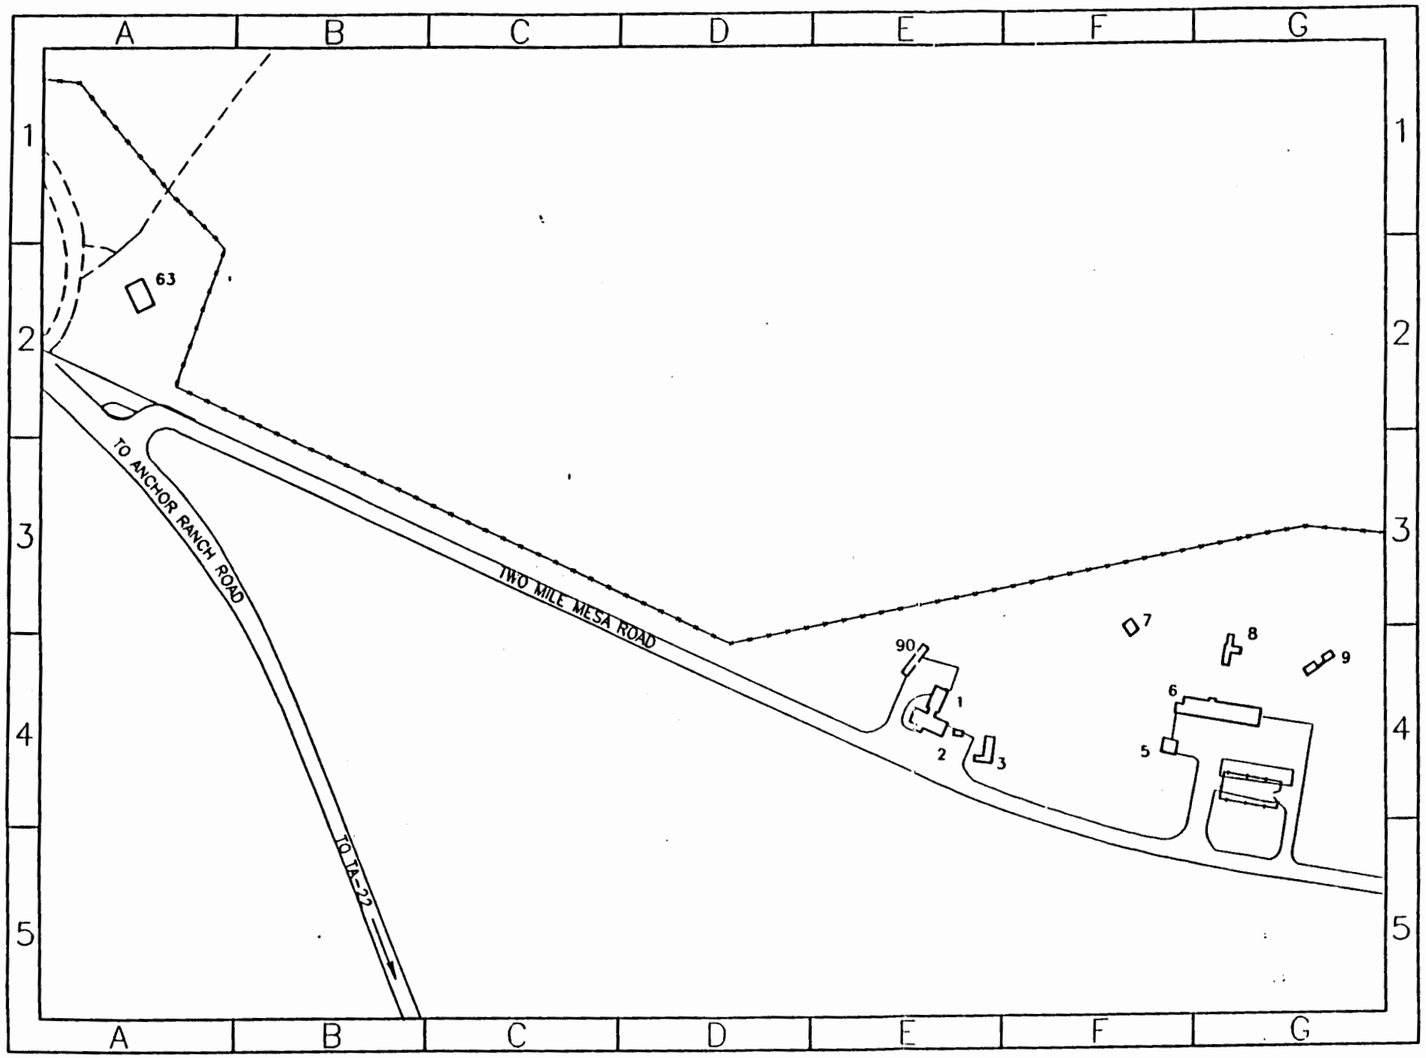

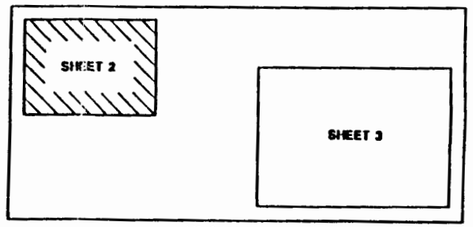

TA-6 MAP GUIDE

N

SCALE 1: 1080

90 0 90 180 FEET

LATEST DISTRIBUTION
30APRIL92
EMERGENCY RESPONSE MAP
UPDATED DRAWING

NO.	DATE	CLASS REV.	REVISIONS	DWN	DES	CKD	REL	SUB	REC	APP

FACILITIES ENGINEERING DIVISION

STRUCTURE LOCATION MAP
TA-06
TWO MILE MESA SITE

DRAWN	C. SANDOVAL
DESIGN	
CHECKED	B. COMER
RELEASED	B. COMER
DATE	03-06-91

BLDG.
SUBMITTED
RECOMMENDED
APPROVED

LOS ALAMOS LOS ALAMOS NATIONAL LABORATORY LOS ALAMOS, NEW MEXICO 87545

SHEET 2 OF 3

CLASSIFICATION UC REVIEWER DATE

LAB JOB NO.

DRAWING NO. ENG-R 5105

REV. 18

AUTOGIS

TA-06

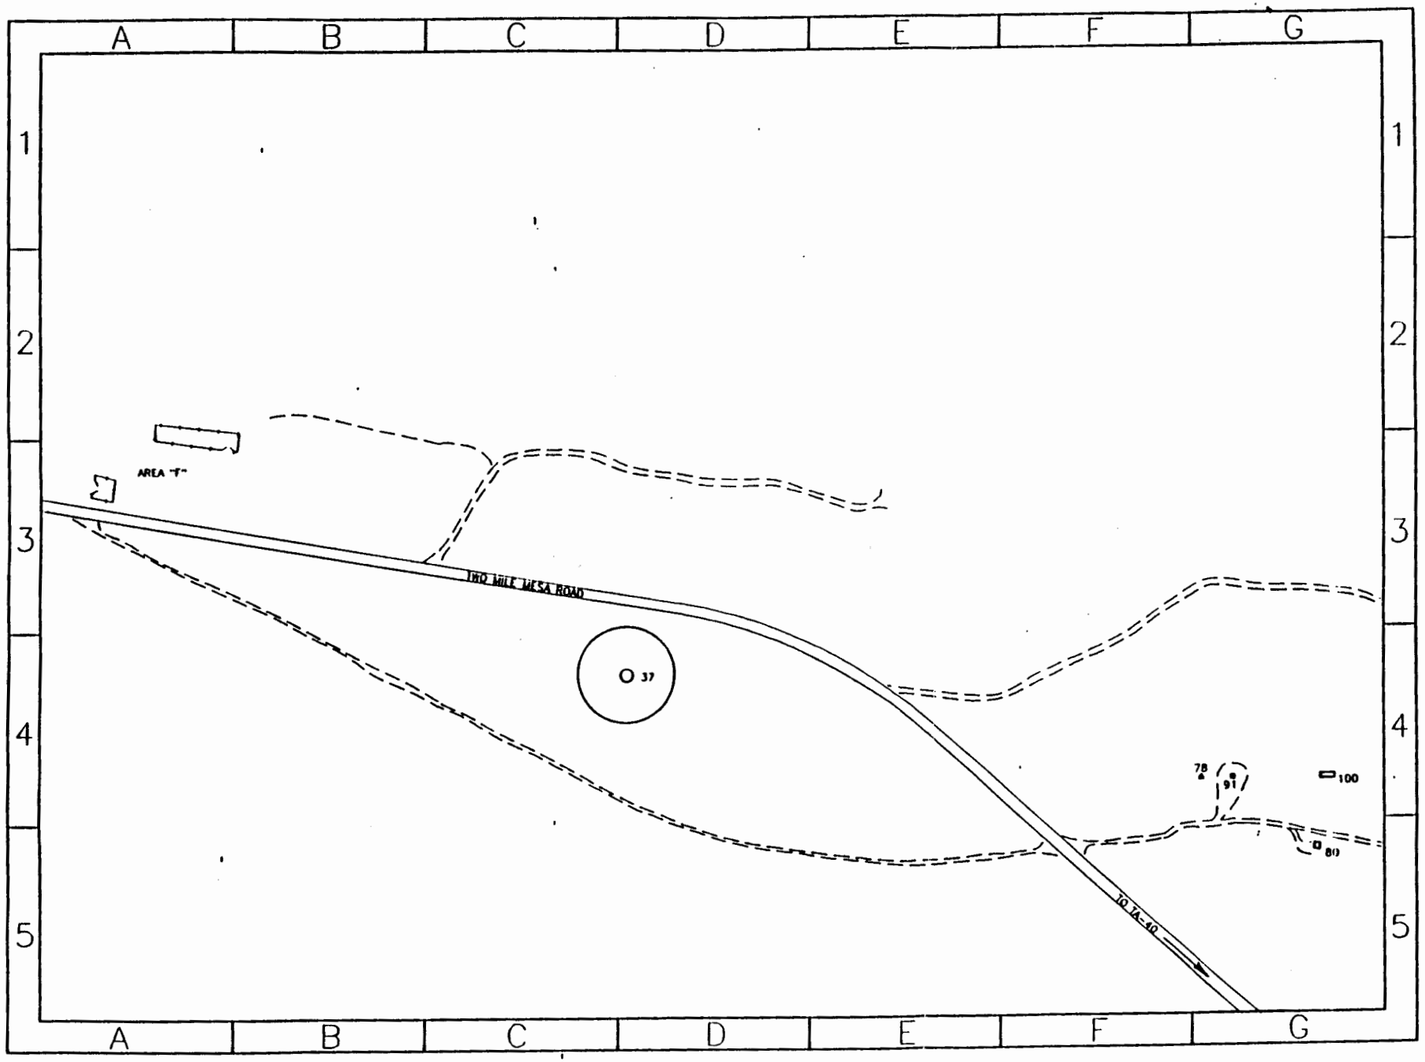

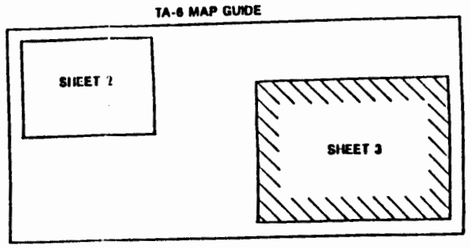

SCALE 1: 1560

130 0 130 260 FEET

N

LATEST DISTRIBUTION
30APRIL92
EMERGENCY RESPONSE MAP
UPDATED DRAWING

NO.	DATE	CLASS REV.	REVISIONS	DWN	DES	CKD	REL	SUB	REC	APP

FACILITIES ENGINEERING DIVISION

STRUCTURE LOCATION MAP
TA-06
TWO MILE MESA SITE

DRAWN	C.SANDOVAL
DESIGN	
CHECKED	B. COMER
RELEASED	B. COMER
DATE	03-06-91

BLDG.
SUBMITTED | RECOMMENDED | APPROVED

LOS ALAMOS — LOS ALAMOS NATIONAL LABORATORY, LOS ALAMOS, NEW MEXICO 87545

SHEET 3 OF 3

CLASSIFICATION U REVIEWER DATE 4-15-91

LAB JOB NO.

DRAWING NO. ENG-R 5105

REV. 18

AUTOGIS

TA-08

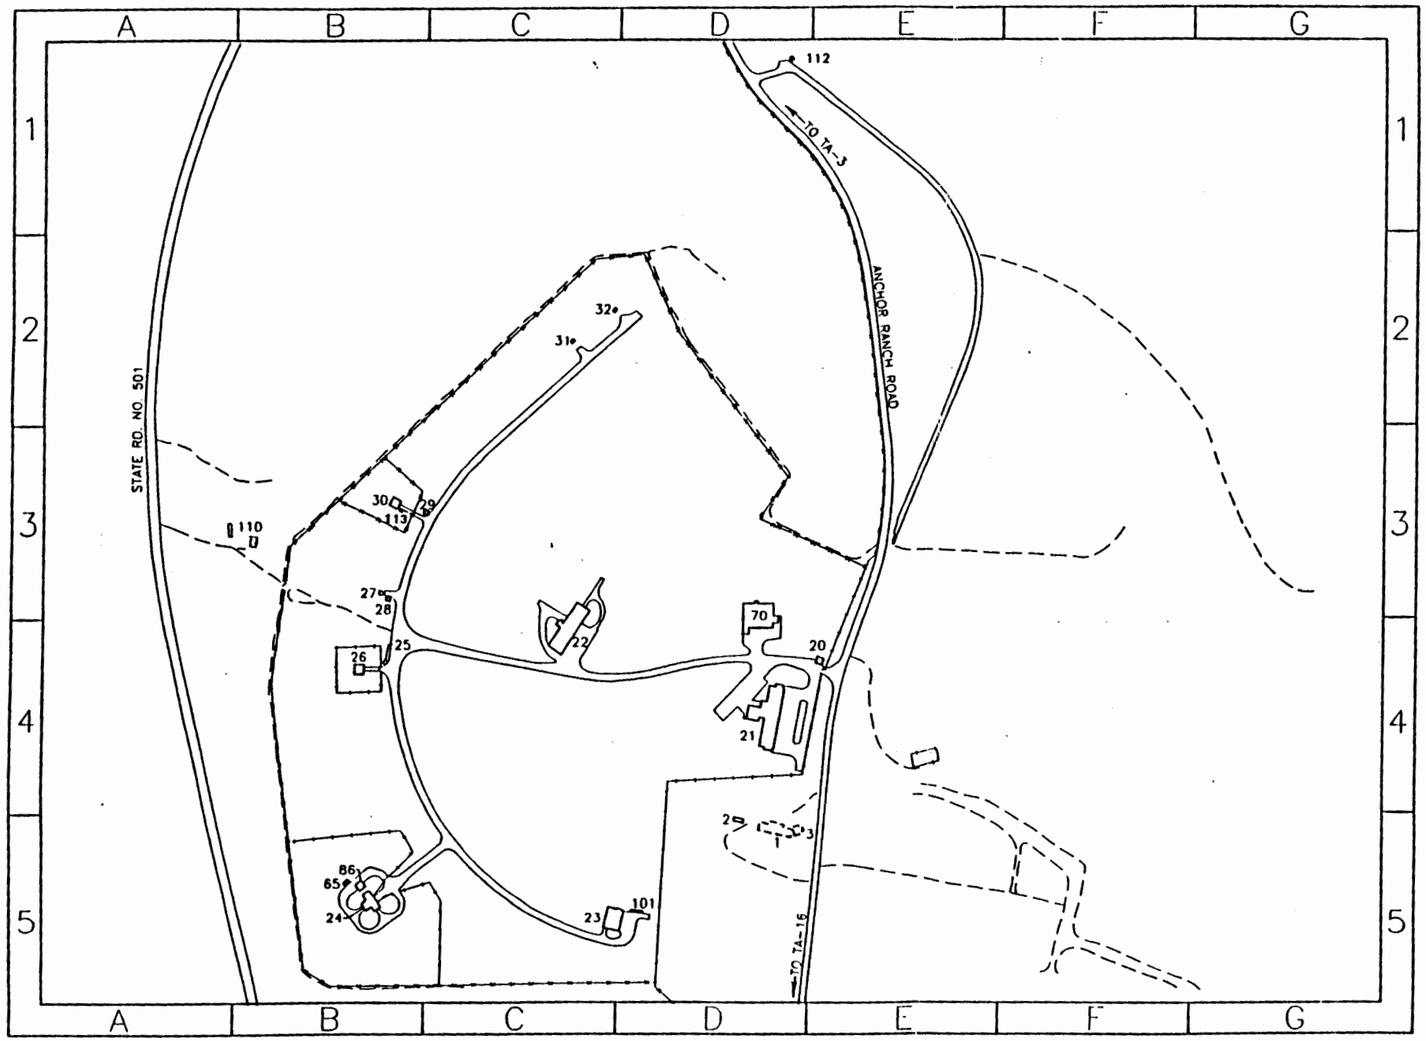

SCALE 1: 2580

215 0 215 430 FEET

N

STRUCTURE NUMBER INDEX

STRUCTURE TA-NUMBER	STRUCTURE DESIGNATION	STRUCTURE NOMENCLATURE	STRUCTURE LOCATOR SHEET NO.	STRUCTURE LOCATOR MAP KEY
8- 1	AW- 1	LABORATORY & SHOP BUILDING	1	D-5
8- 2	AW- 2	SHOP & STORAGE BUILDING	1	D-5
8- 3	AW- 3	LABORATORY BUILDING	1	D-5
8- 20	AW- 20	GUARD HOUSE	1	D-4
8- 21	8- 21	LABORATORY & OFFICE BLDG.	1	D-4
8- 22	AW- 22	X-RAY BUILDING	1	C-3
8- 23	AW- 23	BETATRON BUILDING	1	C-5
8- 24	AW- 24	ISOTOPE BUILDING	1	B-5
8- 25	AW- 25	UTILITY BUILDING	1	B-4
8- 26	AW- 26	RADIATION LABORATORY	1	B-4
8- 27	AW- 27	VAULT	1	B-3
8- 28	AW- 28	UTILITY BUILDING	1	B-3
8- 29	AW- 29	UTILITY BUILDING	1	B-3
8- 30	AW- 30	M.A.S.H RESEARCH LAB	1	B-3
8- 31	AW- 31	MAGAZINE	1	C-2
8- 32	AW- 32	MAGAZINE	1	C-2
8- 65	AW- 65	SOURCE STORAGE BUILDING	1	B-5
8- 70	AW- 70	NON-DESTRUCTIVE TEST FAC.	1	D-3
8- 86	8- 86	STORAGE BUILDING	1	B-5
8-101	AW-101	TRANSPORTAINER	1	D-5
8-110	8-110	WATER TANK	1	A-3
8-112	8-112	MORGAN SHED	1	D-1
8-113	8-113	CHEM. STORAGE SHED	1	B-3

NO.	DATE	CLASS REV.	REVISIONS	DWN	DES	CKD	REL	SUB	REC	APP
			DISTRIBUTION 30APRIL92 EMERGENCY RESPONSE MAP UPDATED DRAWING							

FACILITIES ENGINEERING DIVISION

STRUCTURE LOCATION MAP
TA-08
ANCHOR SITE WEST

DRAWN	C.SANDOVAL
DESIGN	
CHECKED	B. COMER
RELEASED	B. COMER
DATE	03 06 91

BLDG.
SUBMITTED
RECOMMENDED
APPROVED

LOS ALAMOS — LOS ALAMOS NATIONAL LABORATORY, LOS ALAMOS, NEW MEXICO 87545

SHEET 1 OF 1

CLASSIFICATION U REVIEWER DATE 4-15-91

LAB JOB NO. 120

DRAWING NO. ENG-R 5106

REV. 18

AUTOCIS

TA-09

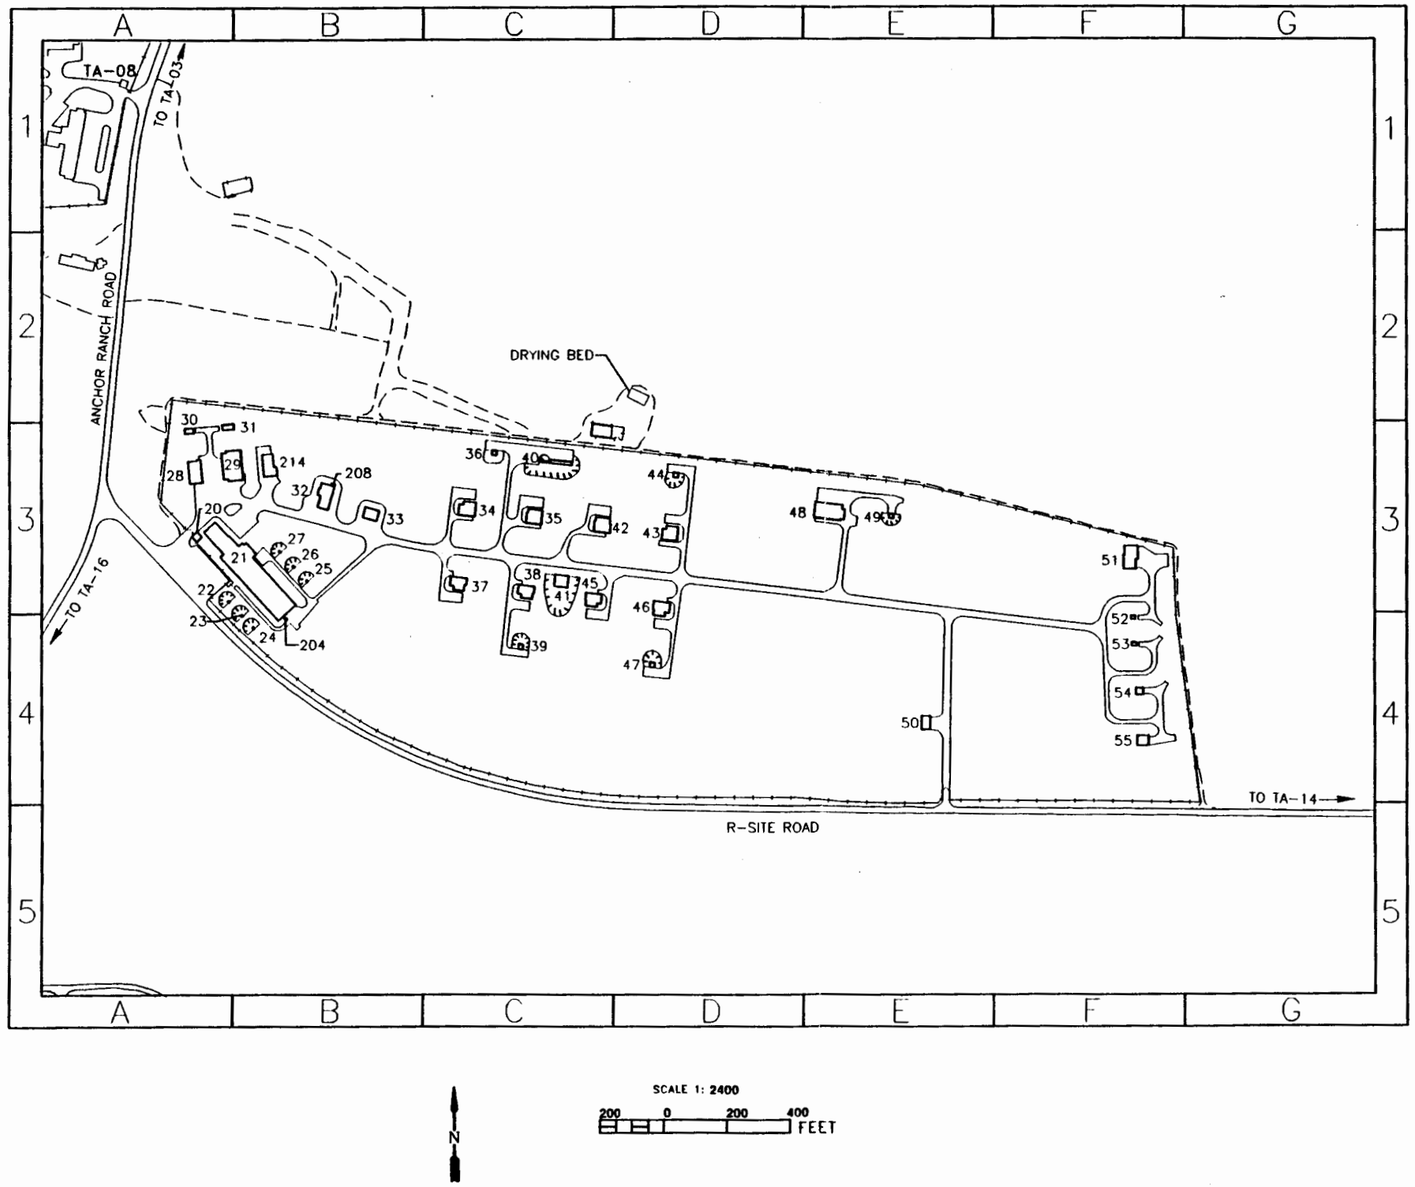

STRUCTURE NUMBER INDEX

STRUCTURE TA-NUMBER	STRUCTURE DESIGNATION	STRUCTURE NOMENCLATURE	STRUCTURE LOCATOR SHEET NO.	STRUCTURE LOCATOR MAP KEY
9- 20	AE- 20	GUARD STATION	1	A-3
9- 21	AE- 21	LABORATORY & OFFICE BLDG.	1	B-3
9- 22	AE- 22	MAGAZETTE	1	A-3
9- 23	AE- 23	MAGAZETTE	1	B-3
9- 24	AE- 24	MAGAZETTE	1	B-4
9- 25	AE- 25	MAGAZETTE	1	B-3
9- 26	AE- 26	MAGAZETTE	1	B-3
9- 27	AE- 27	MAGAZETTE	1	B-3
9- 28	AE- 28	SHOP BUILDING	1	A-3
9- 29	AE- 29	STOCK & EQUIPMENT BUILDING	1	B-3
9- 30	AE- 30	GAS STORAGE	1	A-3
9- 31	AE- 31	GAS STORAGE	1	A-3
9- 32	AE- 32	LABORATORY BUILDING	1	B-3
9- 33	AE- 33	LABORATORY BUILDING	1	B-3
9- 34	AE- 34	PROCESS LABORATORY	1	C-3
9- 35	AE- 35	PROCESS LABORATORY	1	C-3
9- 36	AE- 36	MAGAZINE	1	C-3
9- 37	AE- 37	PROCESS LABORATORY	1	C-3
9- 38	AE- 38	PROCESS LABORATORY	1	C-3
9- 39	AE- 39	MAGAZINE	1	C-4
9- 40	AE- 40	DRY HOUSE BUILDING	1	C-3
9- 41	AE- 41	COMFORT STATION BUILDING	1	C-3
9- 42	AE- 42	PROCESS LABORATORY	1	C-3
9- 43	AE- 43	PROCESS LABORATORY	1	D-3
9- 44	AE- 44	MAGAZINE	1	D-3
9- 45	AE- 45	PROCESS LABORATORY	1	C-3
9- 46	AE- 46	PROCESS LABORATORY	1	D-3
9- 47	AE- 47	MAGAZINE	1	D-4
9- 48	AE- 48	MACHINING BUILDING	1	E-3
9- 49	AE- 49	MAGAZINE	1	E-3
9- 50	AE- 50	RECEIVING & SHIPPING BLDG.	1	E-4
9- 51	AE- 51	ENVIRONMENTAL TEST CHAMBER	1	F-3
9- 52	AE- 52	MAGAZINE	1	F-4
9- 53	AE- 53	MAGAZINE	1	F-4
9- 54	AE- 54	MAGAZINE	1	F-4
9- 55	AE- 55	MAGAZINE	1	F-4
9-204	AE-204	REFRIGERATOR SHELTER	1	B-4
9-208	AE-208	DAY MAGAZINE	1	B-3
9-214	AE-214	STORAGE BUILDING	1	B-3

NO.	DATE	CLASS REV.	REVISIONS	DWN	DES	CKD	REL	SUB	REC	APP

FACILITIES ENGINEERING DIVISION

STRUCTURE LOCATION MAP

TA-09

ANCHOR SITE EAST

DRAWN	C.SANDOVAL
DESIGN	
CHECKED	B. COMER
RELEASED	B. COMER
DATE	03-06-91

BLDG.

SUBMITTED | RECOMMENDED | APPROVED

LOS ALAMOS — LOS ALAMOS NATIONAL LABORATORY, LOS ALAMOS, NEW MEXICO 87545

SHEET 1 OF 1

CLASSIFICATION U — REVIEWER — DATE 4-15-91

LAB JOB NO.

DRAWING NO. ENG-R 5107

REV. 19

AUTOGIS

STRUCTURE LOCATION MAPS

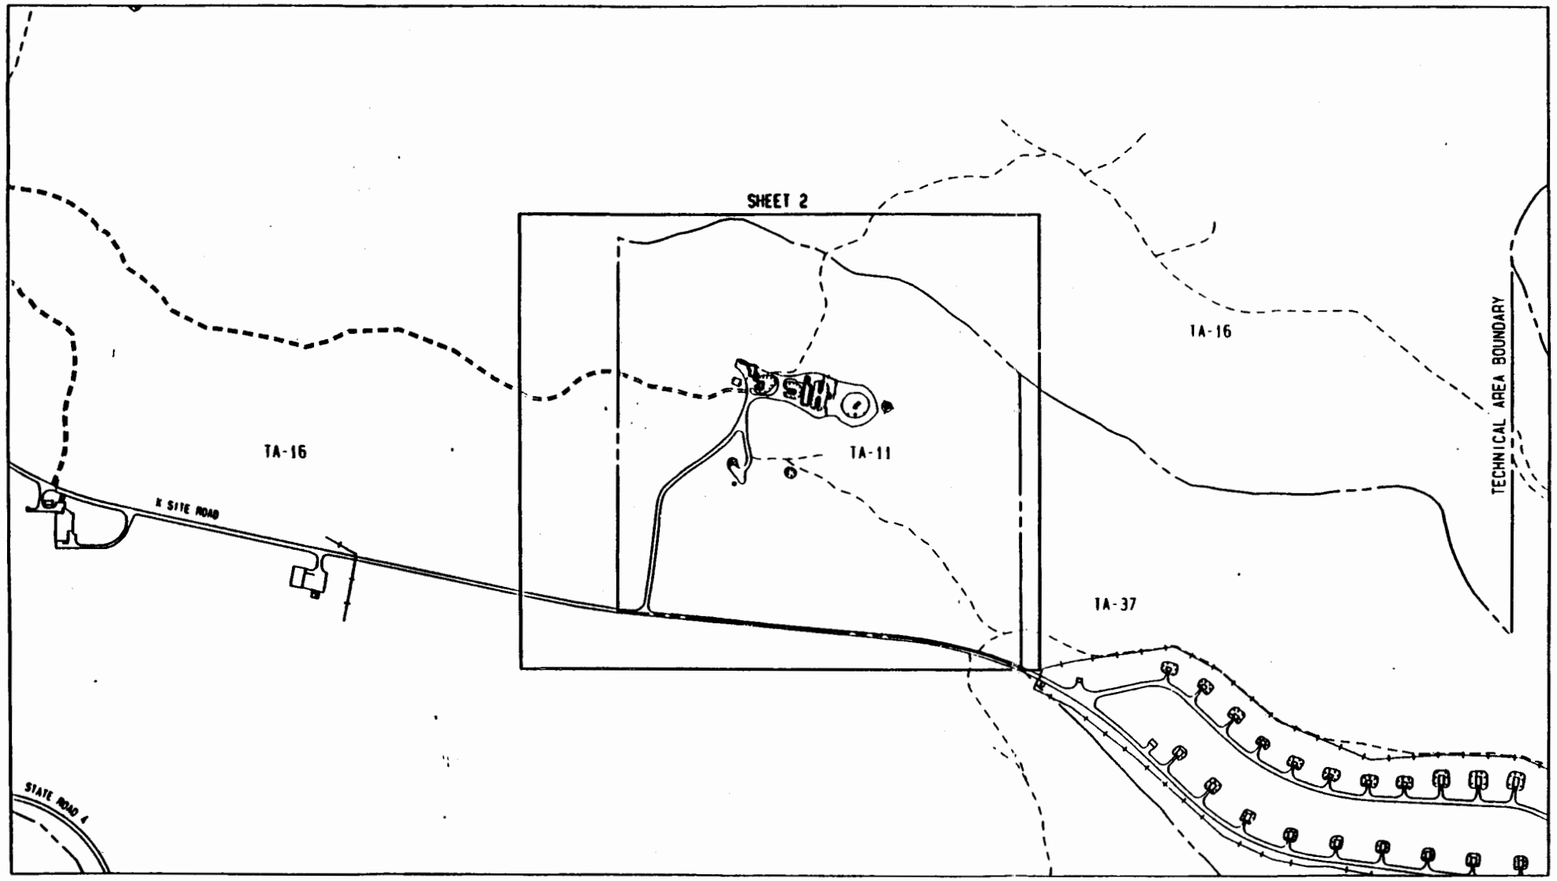

TA-11 KEY MAP

SCALE: 1:3600

300 0 300 600

FEET

N

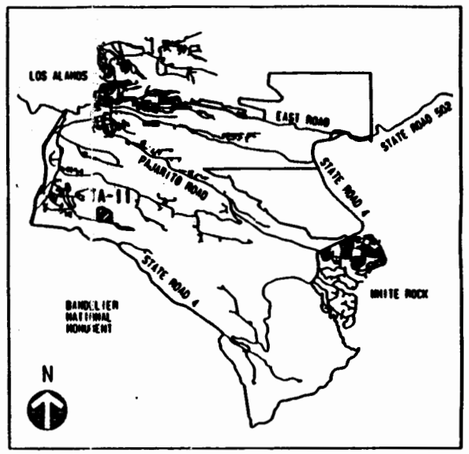

LOCATION PLAN

SCALE: NONE

NO	DATE	CLASS REV	REVISIONS	DWN	VER	CHKD	REL	SVD	REC	APP

JOHNSON CONTROLS WORLD SERVICES INC.

AS-BUILT STRUCTURE LOCATION MAPS

TA-11

K SITE

DRAWN J. HORN
VERIFIED J. HORN
CHECKED
RELEASED
DATE 05 16 94

SUBMITTED JERRY FORTE
RECOMMENDED DRAW COMER
APPROVED ROBERT PROMEL

Los Alamos — Los Alamos National Laboratory, Los Alamos, New Mexico 87545

SHEET 1 1/2

CLASSIFICATION U REVIEWER R. SALAZAR DATE 5 17-94

PROJECT ID 11952

DRAWING NO AB18

REV

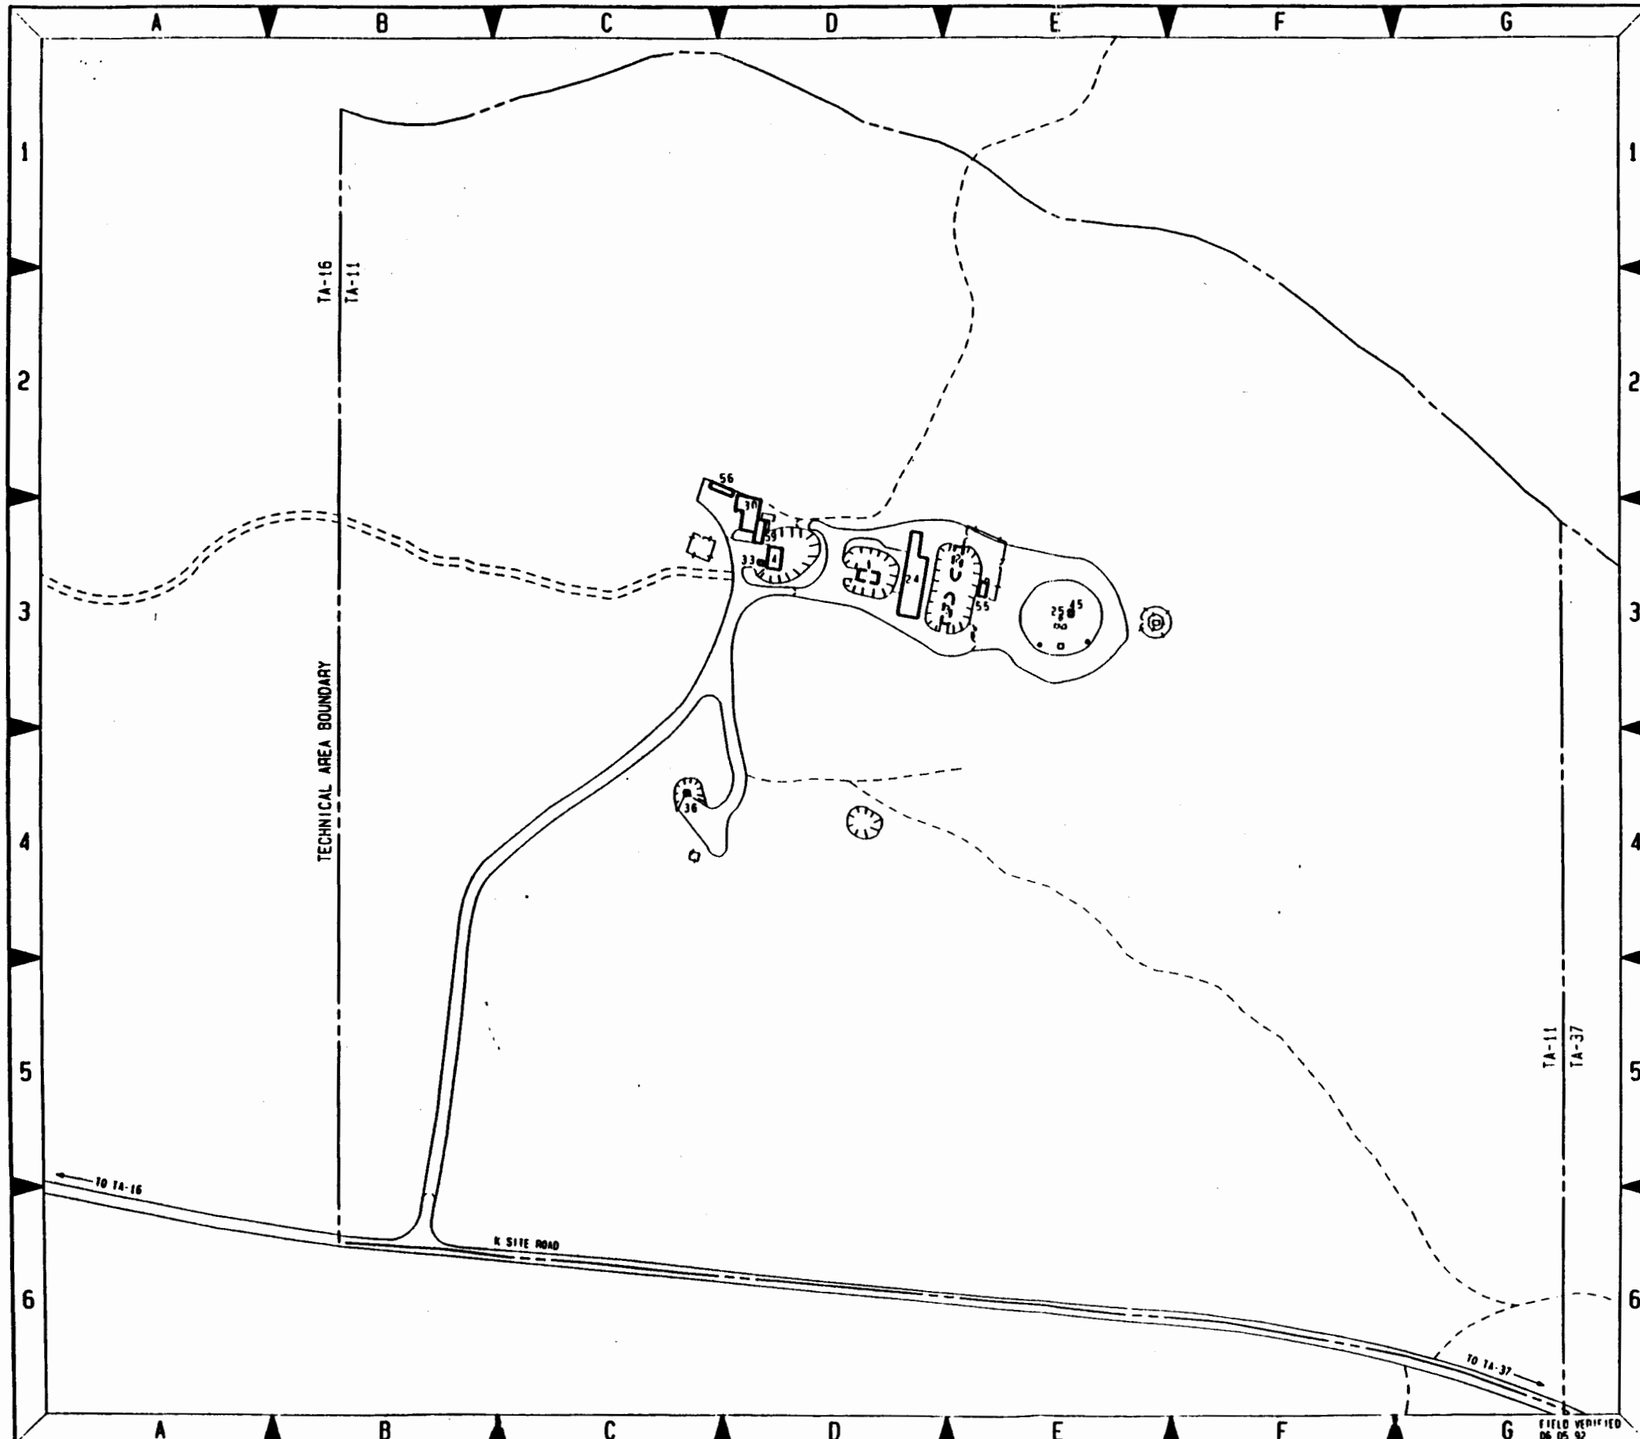

STRUCTURE LOCATION INDEX

STRUCTURE TA NUMBER	STRUCTURE DESIGNATION	STRUCTURE NOMENCLATURE	STRUCTURE LOCATOR SHEET NO.	STRUCTURE LOCATOR MAP KEY
11-1	K-1	STORAGE BUILDING	1	D-3
11-2	K-2	CONTROL BUILDING	1	E-3
11-3	K-3	CONTROL BUILDING	1	E-3
11-4	K-4	CONTROL BUILDING	1	D-3
11-24	K-24	AIR-GUN BUILDING	1	D-3
11-25	11-25	DROP TOWER	1	E-3
11-30	11-30	VIBRATION TEST BUILDING	1	D-3
11-33	K-33	EQUIPMENT SHELTER	1	D-3
11-36	K-36	MAGAZINE	1	C-4
11-45	11-45	INSTRUMENTATION BLDG.	1	E-3
11-55	K-55	SHED	1	E-3
11-56	11-56	TRANSPORTAINER	1	D-2
11-59	11-59	AMPLIFIER BUILDING	1	D-3

N

SCALE: 1:1200

100 0 100 200

FEET

NO	DATE	CLASS REV	REVISIONS	DWN	VER	CHKD	REL	SUB	REC	APP
1	05-16-94		REVISED PER NEW STANDARDS	HMS	JPH	JPH	HMS	JAF	DEC	RAP

JOHNSON CONTROLS WORLD SERVICES INC.

AS-BUILT STRUCTURE LOCATION MAPS

TA-11

K SITE

DRAWN J. HORN
VERIFIED J. HORN
CHECKED H. SALAZAR
RELEASED H. SALAZAR
DATE 06-05-92

SUBMITTED JERRY FOHTE
RECOMMENDED BRIAN COWEN
APPROVED ROBERT PROMMEL

Los Alamos — Los Alamos National Laboratory, Los Alamos, New Mexico 87545

SHEET 2 of 2

CLASSIFICATION U REVIEWER H. SALAZAR DATE 6-17-94

PROJECT ID 11952 DRAWING NO AB18 REV 1

020-16 ON 13

TA-14

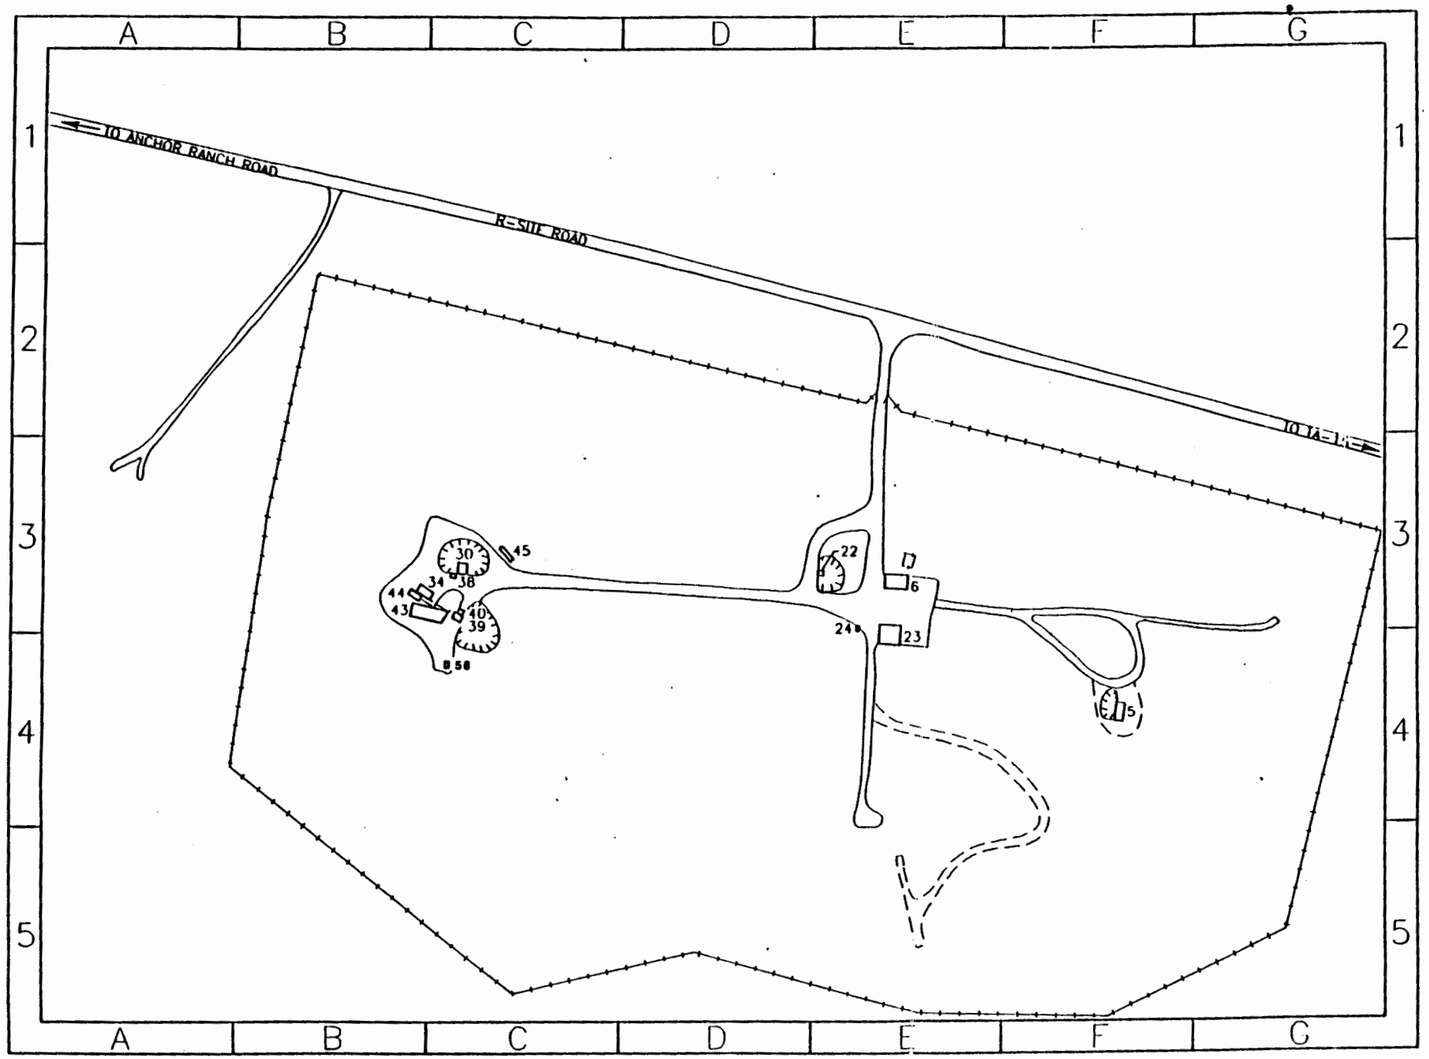

STRUCTURE NUMBER INDEX

STRUCTURE TA-NUMBER	STRUCTURE DESIGNATION	STRUCTURE NOMENCLATURE	STRUCTURE LOCATOR SHEET NO.	STRUCTURE LOCATOR MAP KEY
14- 5	Q- 5	TOXIC GAS STORAGE BLDG.	1	F-4
14- 6	Q- 6	STORAGE BUILDING	1	E-3
14- 22	Q- 22	MAGAZINE	1	E-3
14- 23	Q- 23	CONTROL BUILDING	1	E-3
14- 24	Q- 24	MAGAZINE	1	E-3
14- 30	Q- 30	EXPLOSIVES PREP. BUILDING	1	C-3
14- 34	Q- 34	BULLET TEST FACILITY	1	B-3
14- 38	Q- 38	CAMERA BUILDING	1	C-3
14- 39	Q- 39	HIGH EXPLOSIVE TEST FAC.	1	C-3
14- 40	Q- 40	INSTRUMENTATION BUILDING	1	C-3
14- 43	14- 43	ASSEMBLY & STORAGE BLDG.	1	B-3
14- 44	14- 44	TRANSPORTAINER	1	B-3
14- 45	14- 45	TRANSPORTAINER	1	C-3
14- 58	14- 58	TRANSPORTAINER	1	C-4

N

SCALE 1: 1200

100 0 100 200 FEET

LATEST DISTRIBUTION
30APRIL92
EMERGENCY RESPONSE MAP
UPDATED DRAWING

NO.	DATE	CLASS REV.	REVISIONS	DWN	DES	CKD	REL	SUB	REC	APP

FACILITIES ENGINEERING DIVISION

STRUCTURE LOCATION MAP
TA-14
Q-SITE

DRAWN	C. SANDOVAL
DESIGN	
CHECKED	B. COMER
RELEASED	B. COMER
DATE	03-06-91

BLDG.

SUBMITTED | RECOMMENDED | APPROVED

LOS ALAMOS LOS ALAMOS NATIONAL LABORATORY LOS ALAMOS, NEW MEXICO 87545

SHEET 1 OF 1

CLASSIFICATION | REVIEWER | DATE

LAB JOB NO. | DRAWING NO. ENG-R 5109 | REV. 19

AUTOGIS

STRUCTURE NUMBER INDEX

STRUCTURE TA-NUMBER	STRUCTURE DESIGNATION	STRUCTURE NOMENCLATURE	STRUCTURE LOCATOR SHEET NO.	STRUCTURE LOCATOR MAP KEY
15-8	R-8	SHOP BUILDING	3	C-1
15-9	R-9	CONTROL CHAMBER	5	B-2
15-20	R-20	BRANCH SHOP & LAB BLDG.	3	C-3
15-22	R-22	EXPLOSIVES PREP BUILDING	3	B-2
15-23	R-23	LABORATORY BUILDING	3	D-3
15-27	R-27	CONTROL BUILDING	4	A-5
15-30	R-30	GUARD STATION	3	C-3
15-37	15-37	AIR COMPRESSOR BUILDING	3	C-1
15-40	R-40	LAB & OFFICE BUILDING	3	D-2
15-41	R-41	STORAGE BUILDING	3	G-3
15-42	R-42	MAGAZINE	4	D-3
15-43	R-43	MAGAZINE	4	D-3
15-44	R-44	CONTROL BUILDING	4	F-3
15-45	R-45	CONTROL BUILDING	4	B-1
15-46	R-46	EXERCISE FACILITY	3	D-2
15-50	R-50	SHOP & LABORATORY BLDG.	3	C-3
15-92	R-92	CAMERA CHAMBER	5	E-4
15-119	15-119	TRANSPORTAINER	5	B-2
15-138	R-138	ELECTRONIC BUNKER	4	E-3
15-140	R-140	STORAGE BUILDING	3	D-2
15-141	15-141	PULSER SHELTER BUILDING	4	B-1
15-182	R-182	SOLVENT STORAGE SHED	3	D-2
15-183	R-183	LABORATORY & OFFICE BLDG.	3	C-5
15-184	R-184	PHERMEX CHAMBER	5	F-4
15-185	15-185	POWER CONTROL BUILDING	5	E-4
15-186	R-186	DETECTION CHAMBER	5	F-5
15-187	R-187	MOSAIC MANHOLE, ELECTRICAL	5	F-4
15-188	R-188	MOSAIC MANHOLE, ELECTRICAL	5	F-5
15-189	R-189	FIRING POINT SUBSTATION	5	F-5
15-194	R-194	ELECTRON GUN BUILDING	3	C-3
15-199	15199	TUNNEL	5	F-4
15-200	15-200	TUNNEL	5	F-4
15-201	15-201	TUNNEL	5	F-5
15-202	R-202	COOLING TOWER	5	E-4
15-203	R-203	PHERMEX CAVITY SHELTER	3	C-3
15-204	R-204	CDU CHAMBER	4	E-3
15-213	R-213	PLATFORM	3	C-2
15-232	R-232	GAS CHAMBER	5	F-5
15-233	R-233	BETATRON BUILDING	5	B-3
15-239	R-239	PASSAGEWAY	3	C-3
15-241	R-241	READY MAGAZINE	3	D-5
15-242	R-242	MAKE UP BUILDING	3	D-5
15-243	R-243	MAIN MAGAZINE	3	D-5
15-245	R-245	PASSAGEWAY	3	C-3
15-261	R-261	TANK, OIL STORAGE	3	C-3
15-263	R-263	LABORATORY BUILDING	4	B-1
15-276	15-276	BLAST PROTECTION BLDG.	4	C-3
15-280	R-280	CONTROL BUILDING	4	C-3
15-285	R-285	CONFINEMENT & TEST FAC.	3	C-5
15-289	R-289	CAMERA BUNKER	5	F-4
15-290	15-290	SIGNAL CHAMBER	5	F-4
15-297	R-297	TRAILER, SHOP	3	C-5
15-305	R-305	TRANSPORTABLE OFFICE BLDG.	3	D-2
15-306	15-306	MULTIDIAG HYDROTEST BUILD.	4	C-3
15-307	15-307	TRANSPORTAINER	4	B-1
15-310	15-310	MULTIDIAG OPERATIONS BLDG.	5	F-4
15-312	15-312	DARHT FACILITY	5	B-3
15-313	15-313	RADIOGRAPHIC SUPPORT LAB.	3	B-5
15-314	15-314	OPTICS LAB BUILDING	3	B-5
15-319	15-319	CDU BUNKER	4	C-3
15-320	15-320	PORTABLE SHELTER	4	C-3
15-321	15-321	MARX TANK	4	C-3
15-322	15-322	MINERAL OIL TANK	4	C-3
15-323	15-323	MINERAL OIL TANK	4	C-3
15-324	15-324	MINERAL OIL TANK	4	C-3
15-325	15-325	MINERAL OIL TANK	4	C-3
15-326	15-326	VALVE HOUSE	4	C-3
15-327	15-327	MORGAN SHED	4	B-1
15-328	15-328	TRANSPORTAINER	4	B-1
15-329	15-329	TRANSPORTAINER	3	C-3
15-330	15-330	TARGET	4	B-1
15-331	15-331	ELECTRICAL POWER SHELTER	4	B-1
15-332	15-332	TRANSPORTAINER	4	C-4
15-333	15-333	TRANSPORTAINER	4	C-4
15-334	15-334	TRANSPORTAINER	4	C-4
15-335	15-335	TRANSPORTAINER	4	C-4
15-336	15-336	TRANSPORTAINER	4	C-4
15-337	15-337	TRANSPORTAINER	4	C-4
15-338	15-338	PORTABLE SHELTER	3	B-5
15-339	15-339	PORTABLE SHELTER	3	B-5
15-340	15-340	PORTABLE SHELTER	5	B-2
15-341	15-341	TRANSPORTAINER	5	E-4
15-342	15-342	TRANSPORTAINER	5	E-4
15-343	15-343	TRANSPORTAINER	5	E-4
15-344	15-344	TRAILER, STORAGE	5	E-4
15-345	15-345	TRANSPORTAINER	5	E-4
15-346	15-346	TRANSPORTAINER	5	E-4
15-347	15-347	TRANSPORTAINER	5	E-4
15-348	15-348	TRANSPORTAINER	5	F-5
15-349	15-349	BLAST PROTECTION BLDG.	5	F-4
15-350	15-350	TRANSPORTAINER	3	B-5
15-351	15-351	TRANSPORTAINER	5	E-4
15-352	15-352	TRANSPORTAINER	5	E-4
15-353	15-353	TRANSPORTAINER	3	B-5
15-354	15-354	TRANSPORTAINER	3	B-5
15-355	15-355	TRANSPORTAINER	4	F-3
15-356	15-356	TRANSPORTAINER	4	F-3
15-357	15-357	TRANSPORTAINER	3	E-2
15-358	15-358	TRANSPORTAINER	3	B-5
15-359	15-359	TRANSPORTAINER	3	B-5
15-360	15-360	TRANSPORTAINER	3	E-2
15-361	15-361	TRANSPORTAINER	3	E-2
15-362	15-362	TRANSPORTAINER	3	E-2
15-363	15-363	TRANSPORTAINER	3	E-2
15-364	15-364	TRANSPORTAINER	3	E-2
15-365	15-365	TRANSPORTAINER	4	F-3
15-366	15-366	TRANSPORTAINER	4	F-3
15-367	15-367	TRANSPORTAINER	3	C-5
15-368	15-368	TRANSPORTAINER	4	F-3
15-369	15-369	TRANSPORTAINER	4	B-1
15-370	15-370	TRANSPORTAINER	4	B-1
15-371	15-371	PASSAGEWAY	3	C-3
15-372	15-372	TRANSPORTAINER	3	C-3
15-373	15-373	TRANSPORTAINER	3	C-3
15-374	15-374	SOLVENT STORAGE SHED	3	C-3
15-375	15-375	TRANSPORTAINER	3	B-5
15-376	15-376	PORTABLE SHELTER	3	C-5
15-377	15-377	STORAGE SHED	3	C-5
15-382	15-382	TRANSPORTAINER	5	E-4
15-383	15-383	TRANSPORTAINER	5	E-4
15-424	15-424	TRANSPORTAINER	3	D-2
15-435	15-435	MINERAL OIL TANK	3	B-5
15-436	15-436	MINERAL OIL TANK	3	B-5
15-447	15-447	TRAILER	3	C-5
15-448	15-448	TRAILER	3	C-5
15-453	15-453	TRANSPORTAINER	3	D-4
15-454	15-454	TRANSPORTAINER	4	C-4
15-455	15-455	TRANSPORTAINER	5	B-2

LATEST DISTRIBUTION

31AUG94

EMERGENCY RESPONSE MAP

UPDATED DRAWING

NO.	DATE	CLASS REV.	REVISIONS	DRN	DES	CHKD	REL	SUB	REC	APP

FACILITIES ENGINEERING DIVISION

STRUCTURE LOCATION MAP

TA-15

R-SITE

BLDG.

DRAWN	C.SANDOVAL
DESIGN	
CHECKED	B. COMER
RELEASED	B. COMER
DATE	03-14-91

SUBMITTED RECOMMENDED APPROVED

Los Alamos — Los Alamos National Laboratory, Los Alamos, New Mexico 87545

SHEET 1 OF 5

CLASSIFICATION U REVIEWER DATE 4-15-91

LAB JOB NO.

DRAWING NO. ENG-R 5110

REV. 26

TA-15

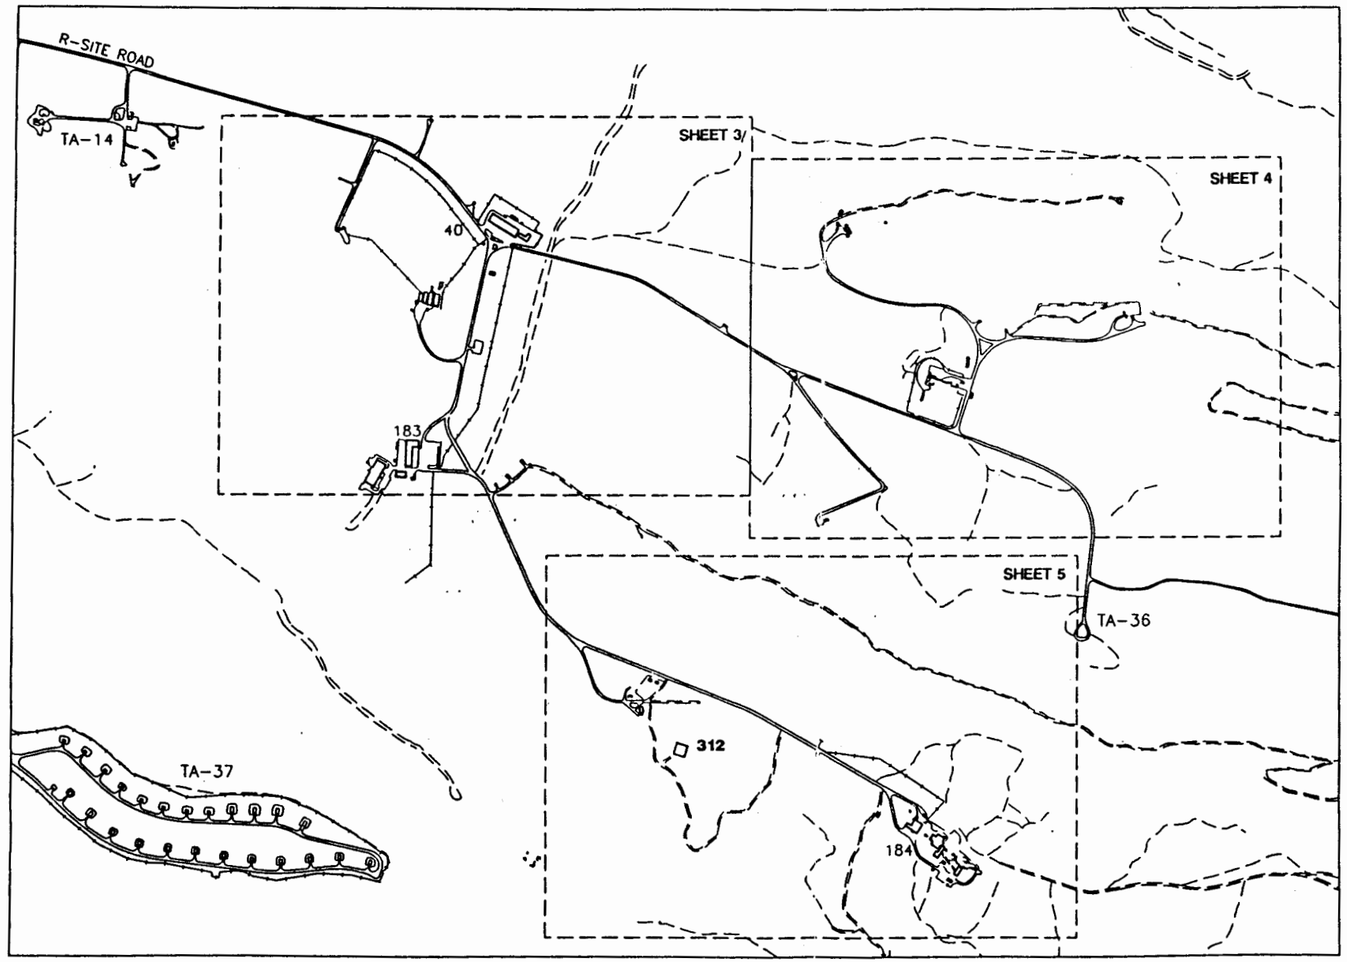

SCALE 1: 6000

500 0 500 1000 FEET

N

LATEST DISTRIBUTION
31AUG94
EMERGENCY RESPONSE MAP
UPDATED DRAWING

AUTOGIS

NO.	DATE	CLASS. REV.	REVISIONS	DWN	DES	CKD	REL	SUB	REC	APP

FACILITIES ENGINEERING DIVISION

STRUCTURE LOCATION MAP
TA-15
R-SITE

DRAWN	C.SANDOVAL
DESIGN	
CHECKED	B. COMER
RELEASED	B. COMER
DATE	03-14-91

BLDG.

SUBMITTED RECOMMENDED APPROVED

LOS ALAMOS — LOS ALAMOS NATIONAL LABORATORY, LOS ALAMOS, NEW MEXICO 87545

SHEET 2 OF 5

CLASSIFICATION U REVIEWER DATE 4-15-91

LAB JOB NO. DRAWING NO. ENG-R 5110 REV. 26

TA-15

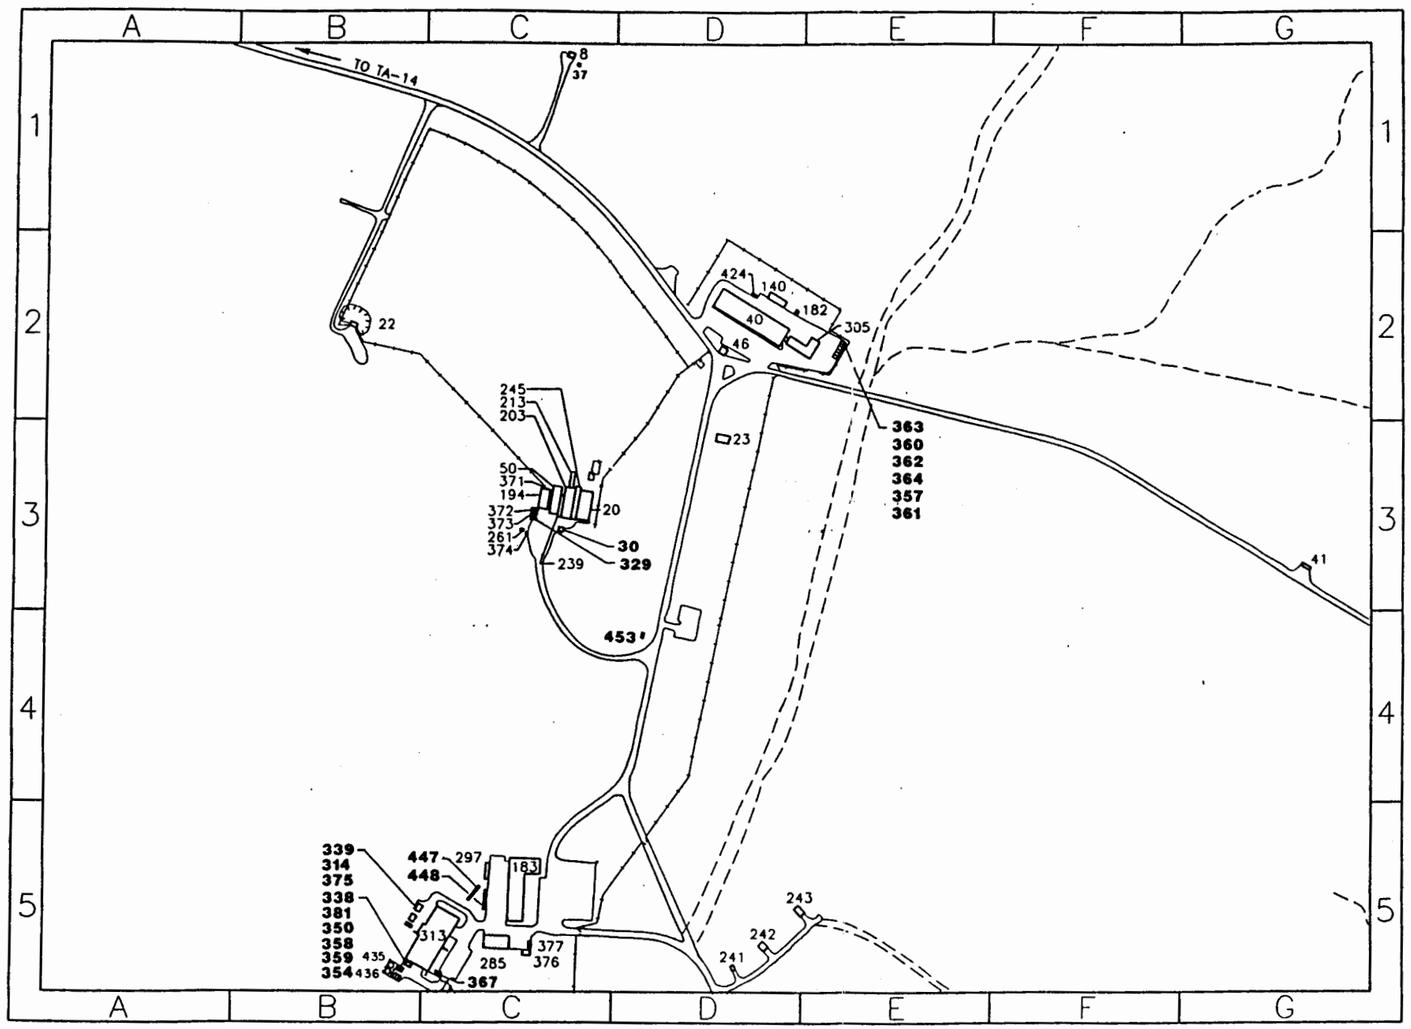

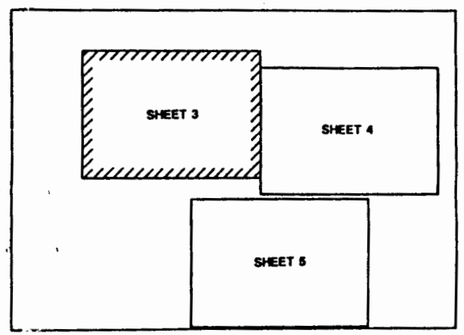

TA-15 MAP GUIDE

SCALE 1: 2400

200 0 200 400 FEET

N

LATEST DISTRIBUTION
31AUG94
EMERGENCY RESPONSE MAP
UPDATED DRAWING

AUTOCIS

NO.	DATE	CLASS REV.	REVISIONS	DWN	DES	CKD	REL	SUB	REC	APP

FACILITIES ENGINEERING DIVISION

STRUCTURE LOCATION MAP
TA-15
R-SITE

BLDG.

DRAWN	C.SANDOVAL
DESIGN	
CHECKED	B. COMER
RELEASED	B. COMER
DATE	03-14-91

SUBMITTED | RECOMMENDED | APPROVED

LOS ALAMOS — LOS ALAMOS NATIONAL LABORATORY, LOS ALAMOS, NEW MEXICO 87545

SHEET 3 OF 5

CLASSIFICATION U REVIEWER DATE 7-11-91

LAB JOB NO. | DRAWING NO. ENG-R 5110 | REV. 26

TA-15

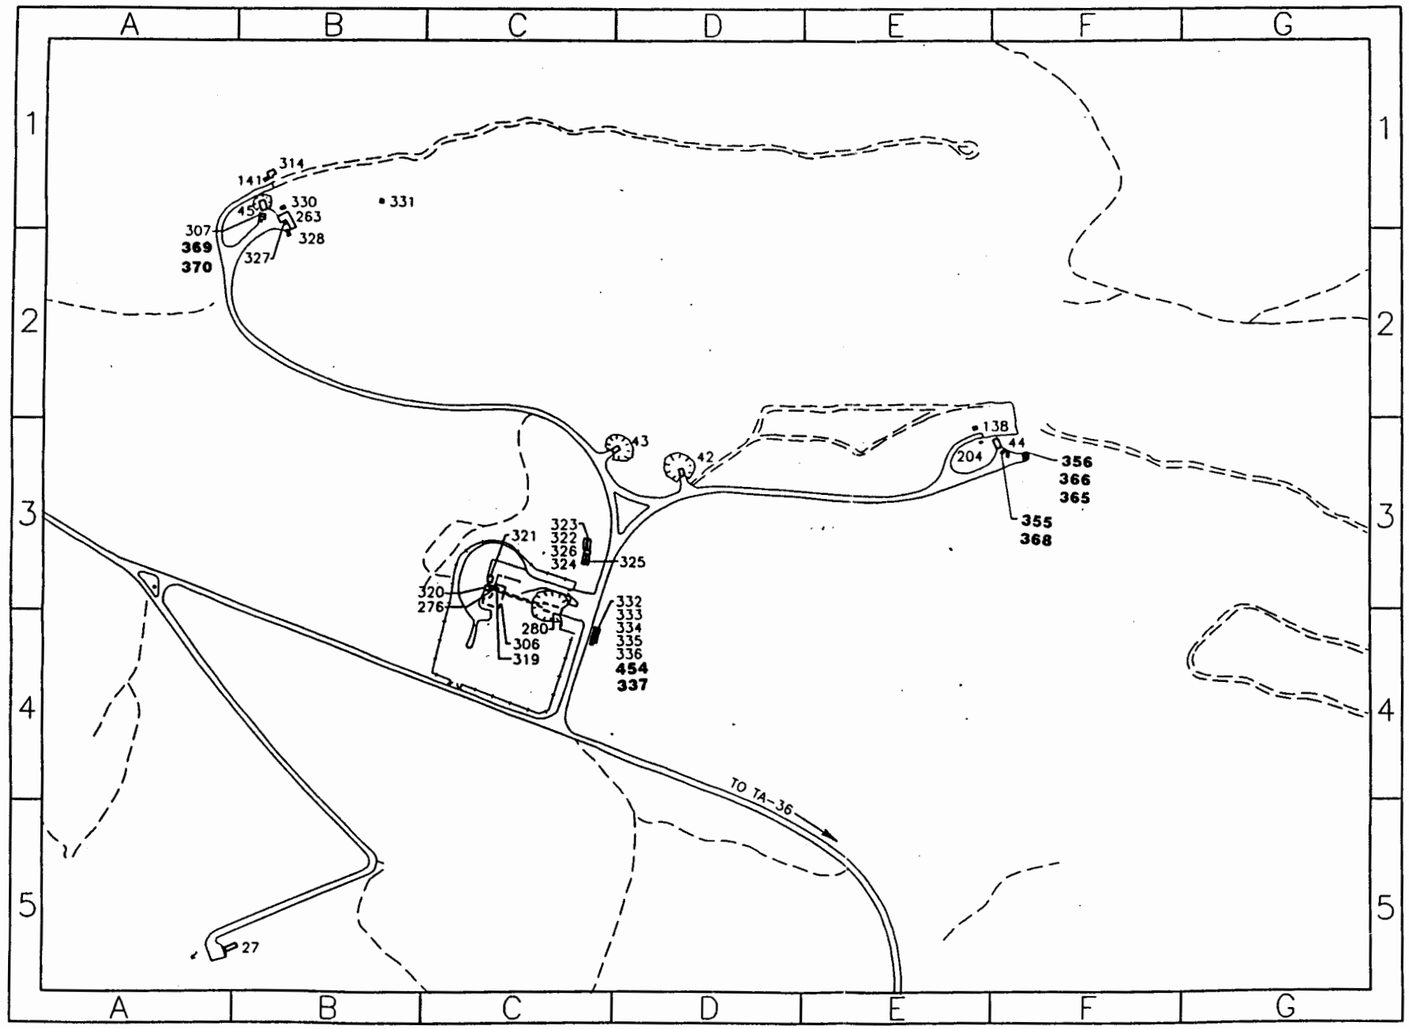

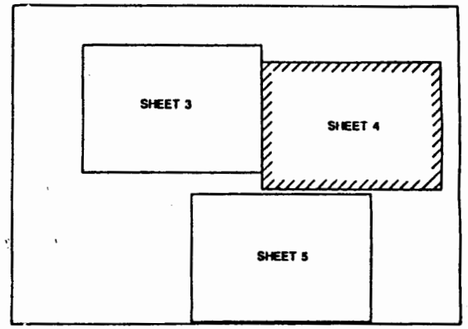

TA-15 MAP GUIDE

SCALE 1: 2400

200 0 200 400 FEET

N

LATEST DISTRIBUTION

31AUG94

EMERGENCY RESPONSE MAP

UPDATED DRAWING

NO.	DATE	CLASS REV.	REVISIONS	DWN	DES	CKD	REL	SUB	REC	APP

FACILITIES ENGINEERING DIVISION

STRUCTURE LOCATION MAP

TA-15

R-SITE

DRAWN	C.SANDOVAL
DESIGN	
CHECKED	B. COMER
RELEASED	B. COMER
DATE	03-14-91

BLDG.

SUBMITTED RECOMMENDED APPROVED

LOS ALAMOS — LOS ALAMOS NATIONAL LABORATORY, LOS ALAMOS, NEW MEXICO 87545

SHEET 4 OF 5

CLASSIFICATION A REVIEWER DATE 4-17-91

LAB JOB NO.

DRAWING NO. ENG-R 5110

REV. 26

AUTOCIS

TA-15

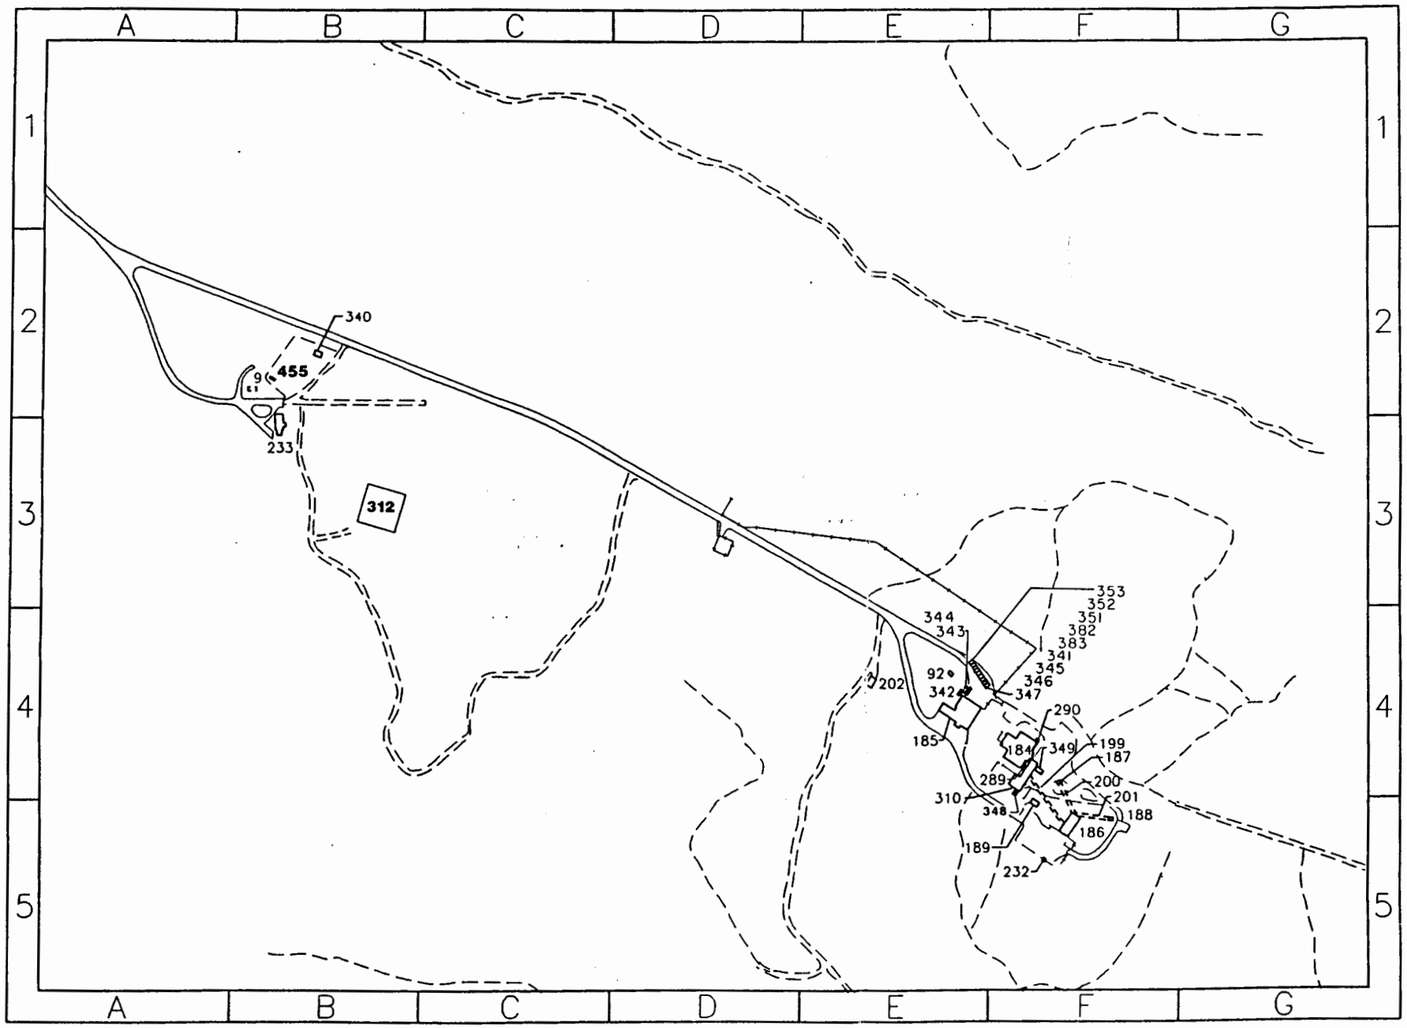

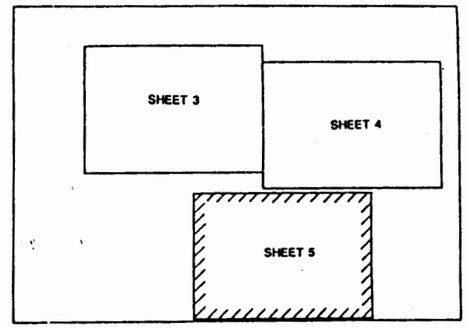

TA-15 MAP GUIDE

SCALE 1: 2400

200 0 200 400 FEET

N

LATEST DISTRIBUTION

31AUG94

EMERGENCY RESPONSE MAP

UPDATED DRAWING

NO.	DATE	CLASS REV.	REVISIONS	DWN	DES	CKD	REL	SUB	REC	APP

FACILITIES ENGINEERING DIVISION

STRUCTURE LOCATION MAP

TA-15

R-SITE

BLDG.

DRAWN	C.SANDOVAL
DESIGN	
CHECKED	B. COWER
RELEASED	B. COWER
DATE	03-14-91

SUBMITTED | RECOMMENDED | APPROVED

LOS ALAMOS — LOS ALAMOS NATIONAL LABORATORY, LOS ALAMOS, NEW MEXICO 87545

SHEET 5 of 5

CLASSIFICATION U REVIEWER DATE 4-11-91

LAB JOB NO.

DRAWING NO. ENG-R 5110

REV. 26

AUTOGIS

STRUCTURE LOCATION MAPS

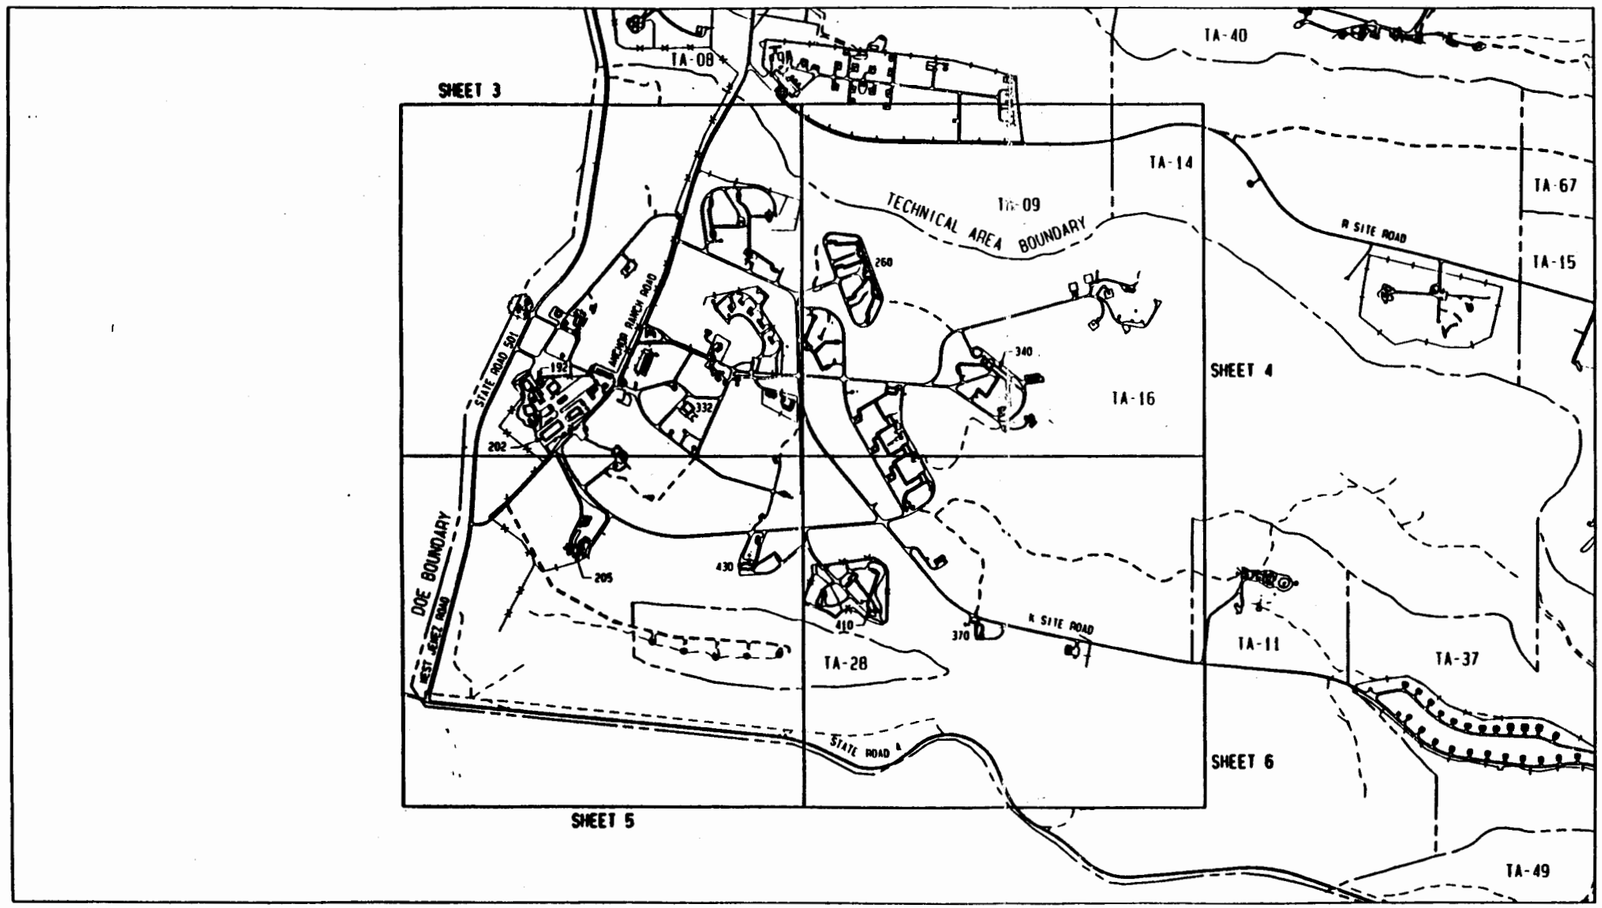

TA-16 KEY MAP

SCALE: 1:9600

800 0 800 1600

FEET

N

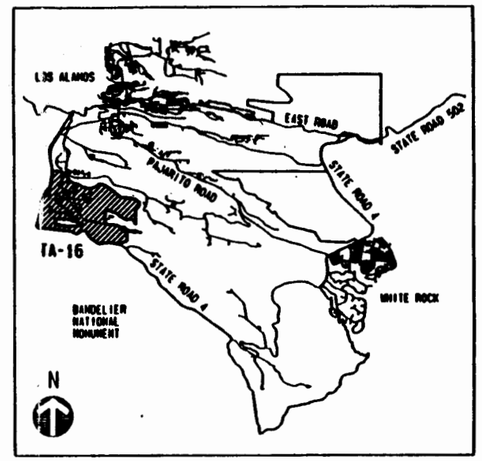

LOCATION PLAN

SCALE: NONE

NO	DATE	CLASS REV	REVISIONS	DWN	VER	CHKD	REL	SUB	REC	APP
1	05-16-94		REVISED PER NEW STANDARDS AND TO STATUS OF 05-05-94	JPH	JPH	HMS	HMS	JAF	BEC	RAP

JOHNSON CONTROLS WORLD SERVICES INC.

AS-BUILT STRUCTURE LOCATION MAPS

TA-16

S SITE

DRAWN J. HORN

VERIFIED J. HORN

CHECKED H. SALAZAR

RELEASED H. SALAZAR

DATE 08-04-93

SUBMITTED JERRY FORTE

RECOMMENDED BRIAN COHEN

APPROVED ROBERT PRONNEL

Los Alamos — Los Alamos National Laboratory, Los Alamos, New Mexico 87545

SHEET 1 of 6

CLASSIFICATION U — REVIEWER H. SALAZAR — DATE 5-18-94

PROJECT ID 11952 — DRAWING NO AB21 — REV 1

08-16 01 17

STRUCTURE LOCATION INDEX

TA NUMBER	STRUCTURE DESIGNATION	STRUCTURE NOMENCLATURE	STRUCTURE LOCATION SHEET NO.	STRUCTURE LOCATION MAP KEY
16-7	16-7	MACHINE SHOP	3	B-5
16-10	16-10	WAREHOUSE	3	E-5
16-13	16-13	DOCK	3	E-5
16-16	16-16	OFFICE BLDG	3	B-5
16-27	16-27	STORAGE BLDG	3	F-5
16-54	16-54	INSTRUMENTATION/TESTING BLDG.	3	E-4
16-58	16-58	MAGAZINE	6	G-1
16-59	16-59	MAGAZINE	5	G-2
16-61	16-61	MAGAZINE	5	G-1
16-63	16-63	MAGAZINE	3	C-5
16-73	16-73	MAGAZINE	3	F-5
16-75	16-75	MAGAZINE	5	E-1
16-76	16-76	MAGAZINE	3	F-6
16-77	16-77	MAGAZINE	3	E-6
16-78	16-78	MAGAZINE	3	E-5
16-79	16-79	MAGAZINE	3	F-5
16-80	16-80	STORAGE BLDG	3	F-5
16-88	16-88	CASTING REST HOUSE	3	F-5
16-89	16-89	STORAGE BLDG	3	G-5
16-90	16-90	STORAGE BLDG	3	G-4
16-91	16-91	STORAGE BLDG	3	G-4
16-92	16-92	STORAGE BLDG.	3	F-4
16-93	16-93	STORAGE BLDG	3	F-4
16-99	16-99	STORAGE BLDG.	3	F-4
16-101	16-101	GUARD HOUSE	6	A-2
16-164	16-164	STORAGE BLDG.	3	F-4
16-171	16-171	WATER TANK	3	C-4
16-180	16-180	FIRE STATION #5	3	C-4
16-192	16-192	CAFETERIA	3	C-5
16-193	16-193	CHANGE HOUSE	3	C-5
16-195	16-195	SERVICE STATION	4	C-6
16-200	16-200	ADMINISTRATION BLDG.	3	C-5
16-201	16-201	GUARD STATION #560	3	C-5
16-202	16-202	SHOPS BLDG.	3	C-6
16-203	16-203	LUMBER STORAGE	3	C-6
16-204	16-204	PROGRAM SUPPORT FACILITY	3	C-6
16-205	16-205	TRITIUM PROCESSING FACILITY	5	B-2
16-206	16-206	PAINT & BOTTLE STORAGE	3	B-6
16-207	16-207	WAREHOUSE	3	B-6
16-208	16-208	SOLVENT STORAGE BLDG.	3	B-6
16-209	16-209	SAFETY OFFICE	3	C-6
16-210	16-210	GUARD HOUSE	3	E-2
16-218	16-218	OFFICE/LAB BLDG.	3	C-5
16-220	16-220	X-RAY BLDG.	3	F-3
16-221	16-221	REST HOUSE	3	F-2
16-222	16-222	DARK ROOM BLDG.	3	F-3
16-223	16-223	REST HOUSE	3	F-2
16-224	16-224	X-RAY BLDG	3	G-3
16-225	16-225	REST HOUSE	3	G-3
16-226	16-226	X-RAY BLDG	3	G-2
16-242	16-242	TRANSPORTABLE OFFICE BLDG.	3	C-6
16-243	16-243	TRANSPORTABLE OFFICE BLDG.	3	B-5
16-244	16-244	TRANSPORTABLE OFFICE BLDG.	3	C-6
16-245	16-245	TRANSPORTABLE OFFICE BLDG.	3	B-5
16-246	16-246	TRANSPORTABLE OFFICE BLDG.	3	B-5
16-247	16-247	WATER TANK	3	C-4
16-248	16-248	TRAILER, OFFICE	5	C-2
16-251	16-251	MACHINE SHOP	6	B-3
16-252	16-252	TRANSPORTAINER	4	B-6
16-255	16-255	TRAILER, OFFICE	5	C-2
16-260	16-260	PROCESS BLDG.	4	B-3
16-261	16-261	REST HOUSE	4	A-3
16-263	16-263	REST HOUSE	4	A-3
16-265	16-265	HE ASSEMBLY/REST HOUSE	4	A-4
16-267	16-267	REST HOUSE	4	B-4
16-277	16-277	EQUIPMENT STORAGE BLDG.	4	B-4
16-278	16-278	EQUIPMENT STORAGE BLDG.	4	A-4
16-280	16-280	INSPECTION BLDG.	4	A-5
16-281	16-281	REST HOUSE	4	A-4
16-283	16-283	REST HOUSE	4	A-5
16-285	16-285	EQUIPMENT STORAGE BLDG.	4	A-5
16-286	16-286	COFFEE HOUSE	4	A-4
16-293	16-293	CHEM STORAGE SHED	3	B-5
16-294	16-294	CHEM STORAGE SHED	4	E-4
16-295	16-295	TOOL STORAGE SHED	4	E-4
16-296	16-296	TRAILER, OFFICE	5	B-2
16-297	16-297	TRAILER, OFFICE	5	B-2
16-298	16-298	TRAILER, OFFICE	5	B-2
16-300	16-300	TREAT PREP. BLDG.	4	B-5
16-301	16-301	REST HOUSE	4	B-6
16-302	16-302	PROCESS BLDG.	4	B-6
16-303	16-303	REST HOUSE	4	B-6
16-304	16-304	PLASTICS BLDG.	4	B-6
16-305	16-305	PLASTICS BLDG.	6	B-1
16-306	16-306	PROCESS BLDG.	6	C-1
16-307	16-307	PLASTICS BLDG.	6	B-1
16-308	16-308	PROCESS BLDG.	4	A-5
16-319	16-319	OFFICE BLDG	4	B-6
16-332	16-332	PROCESS EQUIP./STORAGE BLDG.	3	E-6
16-339	16-339	STORAGE BLDG.	4	B-5
16-340	16-340	EXPOSIVES SYNTHESYS BLDG.	4	B-5
16-341	16-341	REST HOUSE	4	C-5
16-342	16-342	BLENDING BLDG.	4	B-5
16-343	16-343	REST HOUSE	4	B-5
16-344	16-344	DRUM STORAGE	4	B-6
16-345	16-345	REST HOUSE	4	B-6
16-360	16-360	STORAGE BLDG.	6	C-2
16-362	16-362	TRANSPORTAINER	4	F-4
16-363	16-363	WATER TREATMENT SHED	4	F-4
16-370	16-370	METAL FORMING BLDG.	6	D-3
16-372	16-372	COOLING TOWER	6	C-3
16-380	16-380	HE INSPECTION BLDG.	6	E-4
16-386	16-386	BURNING AREA	4	E-4
16-387	16-387	BURNING AREA	4	E-3
16-388	16-388	BURNING AREA	4	F-4
16-389	16-389	CONTROL SHELTER	4	E-4
16-390	16-390	BASKET WASHING BLDG	4	F-4
16-392	16-392	FILTER BED	4	G-4
16-394	16-394	FILTER BED	4	F-4
16-399	16-399	BURNING AREA	4	F-4
16-400	16-400	TRUCK WASHING BLDG	3	D-6
16-401	16-401	PRESSURE TANK	4	F-4
16-402	16-402	AIR HEATER	4	F-4
16-404	16-404	MICROSTRAINER BLDG	3	C-4
16-406	16-406	PRESSURE TANK	4	F-4
16-410	16-410	ASSEMBLY BLDG.	6	B-3
16-411	16-411	REST HOUSE	6	A-3
16-412	16-412	INCINERATOR	3	E-6
16-413	16-413	REST HOUSE	6	A-3
16-414	16-414	STORAGE BLDG.	6	A-3
16-415	16-415	REST HOUSE	6	B-3
16-421	16-421	FIRE DEPT. TRAIN FACILITY	3	D-3
16-430	16-430	HE PRESSING BLDG.	5	G-2
16-435	16-435	REST HOUSE	5	G-2
16-437	16-437	REST HOUSE	5	G-2
16-439	16-439	TRANSPORTAINER	6	D-4
16-445	16-445	DIESEL TANK	3	C-4
16-450	16-450	PROCESS BLDG.	5	D-2
16-457	16-457	VALVE HOUSE	3	D-4
16-459	16-459	TRAILER, OFFICE	5	C-2
16-460	16-460	LABORATORY BLDG.	5	D-1
16-462	16-462	STORAGE BLDG	5	D-1
16-463	16-463	REST HOUSE	3	D-6
16-476	16-476	CONTROL BLDG	4	D-5
16-477	16-477	REST HOUSE	4	E-5
16-478	16-478	MACHINE SHOP	4	E-5
16-515	16-515	PROCESS BLDG	3	G-5
16-516	16-516	PROCESS BLDG	3	G-6
16-517	16-517	EQUIPMENT BLDG.	3	G-6
16-518	16-518	STORAGE BLDG	3	G-6
16-519	16-519	STORAGE BLDG	3	G-6
16-520	16-520	TEST BLDG	3	G-6
16-530	16-530	INHOFF TANK	4	D-6
16-531	16-531	TRICKLING FILTER	4	D-6
16-532	16-532	FINAL SETTLING TANK	4	E-6
16-533	16-533	DRYING BED	4	E-6
16-535	16-535	DRYING BED	4	D-6
16-540	16-540	STEAM PLANT	3	D-4
16-542	16-542	GAS REGULATOR BLDG.	3	B-4
16-560	16-560	CHLORINATION STATION	3	C-4
16-599	16-599	SWITCHGEAR STATION	3	B-4
16-1362	16-1362	TRANSPORTAINER	4	B-6
16-1363	16-1363	TRANSPORTAINER	6	B-1
16-1364	16-1364	TRANSPORTAINER	3	G-4
16-1365	16-1365	TRANSPORTAINER	4	F-4
16-1366	16-1366	TRANSPORTAINER	5	F-2
16-1367	16-1367	TRANSPORTAINER	6	C-2
16-1368	16-1368	TRANSPORTAINER	6	C-2
16-1371	16-1371	TRANSPORTAINER	3	E-4
16-1373	16-1373	SATELLITE DISH	3	C-5
16-1374	16-1374	COMMUNICATIONS BLDG.	3	D-5
16-1380	16-1380	TRANSPORTAINER	5	D-2
16-1381	16-1381	TRANSPORTAINER	5	D-2
16-1382	16-1382	TRANSPORTAINER	6	B-1
16-1384	16-1384	TRANSPORTAINER	5	G-2
16-1385	16-1385	TRANSPORTAINER	3	C-6
16-1407	16-1407	TRAILER, OFFICE	3	D-5
16-1408	16-1408	TRANSPORTAINER	3	G-4
16-1409	16-1409	INCINERATOR	4	F-4
16-1410	16-1410	SHED	4	B-5
16-1411	16-1411	FOOD COOLER	3	C-5
16-1413	16-1413	TRANSPORTAINER	3	C-5
16-1415	16-1415	TRANSPORTAINER	3	E-6
16-1416	16-1416	TRANSPORTAINER	3	C-6
16-1421	16-1421	TRANSPORTAINER	3	C-6
16-1451	16-1451	GUARD STATION	5	A-5
16-1459	16-1459	CHEM STORAGE SHED	5	D-2
16-1461	16-1461	SHED	5	G-2
16-1464	16-1464	TRANSPORTAINER	5	D-2

REV	DATE	CLASS REV	REVISIONS	DWN	VER	CHKD	REL	SUB	REC	APP
1	05-16-94		REVISED PER NEW STANDARDS AND TO STATUS OF 05-05-94	JPW	JPW	HNS	HNS	JAF	DEC	RAP

JOHNSON CONTROLS WORLD SERVICES INC.

AS-BUILT STRUCTURE LOCATION MAPS

TA-16

S SITE

DRAWN J. WEBB
VERIFIED J. WEBB
CHECKED H. SALAZAR
RELEASED H. SALAZAR
DATE 08-04-93

SUBMITTED JERRY FORTE
RECOMMENDED BRIAN COHEN
APPROVED ROBERT PRUNEL

Los Alamos — Los Alamos National Laboratory, Los Alamos, New Mexico 87545

SHEET 2 / 2 / 6

CLASSIFICATION U REVIEWER H. SALAZAR DATE 3-16-94

PROJECT ID 11952

DRAWING NO AB21

REV 1

JCI NO 91-020

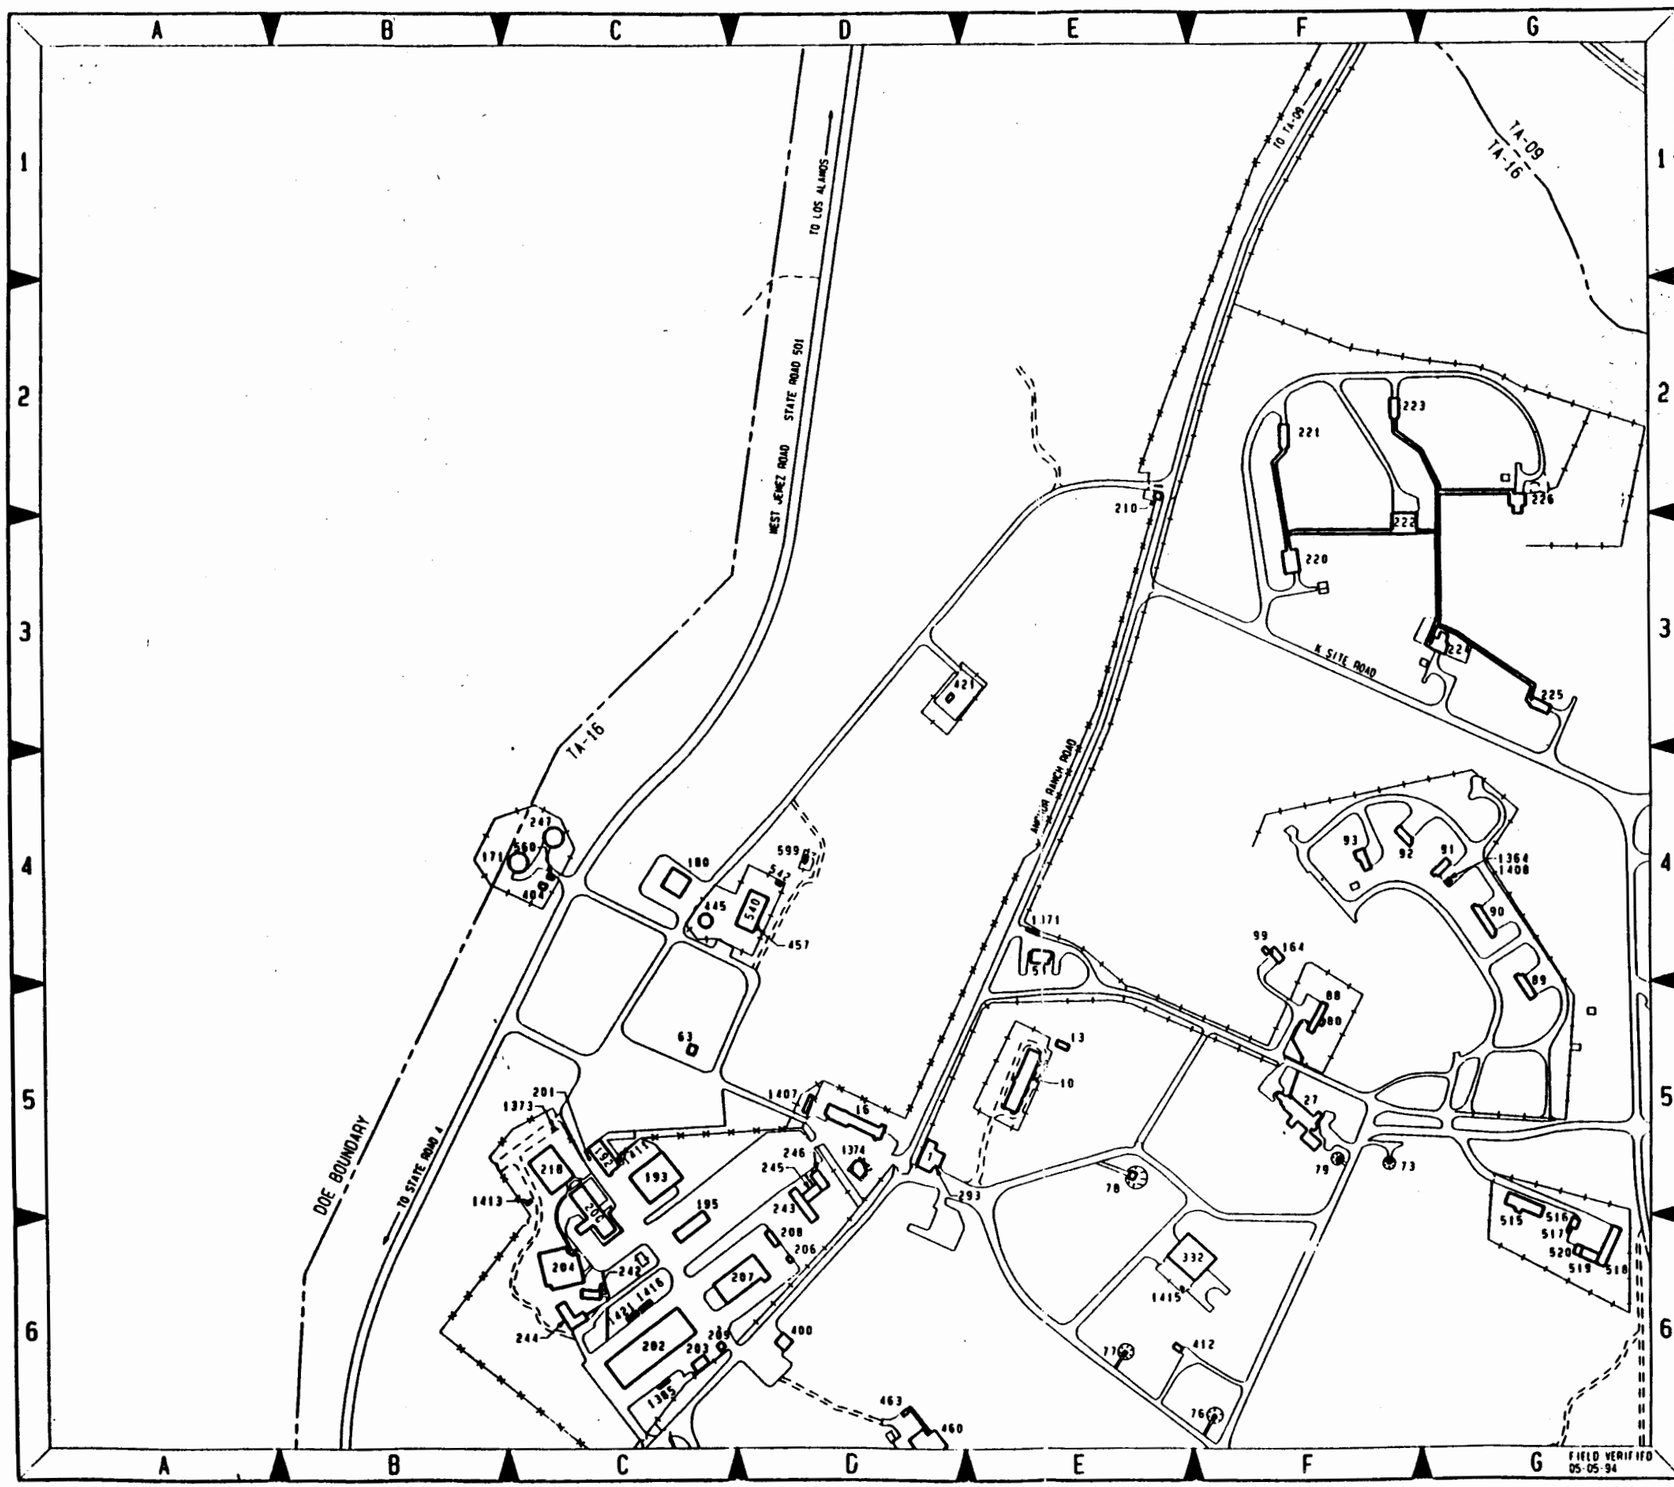

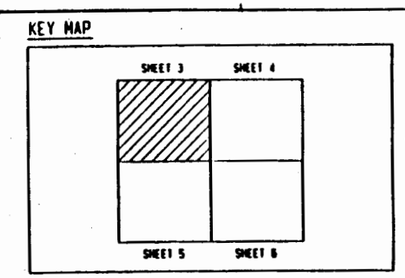

N

SCALE: 1:2400

200 0 200 400

FEET

NO	DATE	CLASS REV	REVISIONS	DWN	VER	CHKD	REL	SUB	REC	APP
1	05-16-94		REVISED PER NEW STANDARDS AND TO STATUS OF 05-05-94	JPH	JPH	HNS	HNS	JAF	DEC	RAP

JOHNSON CONTROLS WORLD SERVICES INC.

AS-BUILT STRUCTURE LOCATION MAPS

TA-16

S SITE

DRAWN J. HORN
VERIFIED J. HORN
CHECKED H. SALAZAR
RELEASED H. SALAZAR
DATE 08-04-93

SUBMITTED JERRY FORTE
RECOMMENDED BRIAN COHEN
APPROVED ROBERT PRONNEL

Los Alamos — Los Alamos National Laboratory, Los Alamos, New Mexico 87545

SHEET 3 — 3/6

CLASSIFICATION 11 REVIEWER H. SALAZAR DATE 5-18-94

PROJECT ID 11952 DRAWING NO AB21 REV 1

JCI NO 91-020

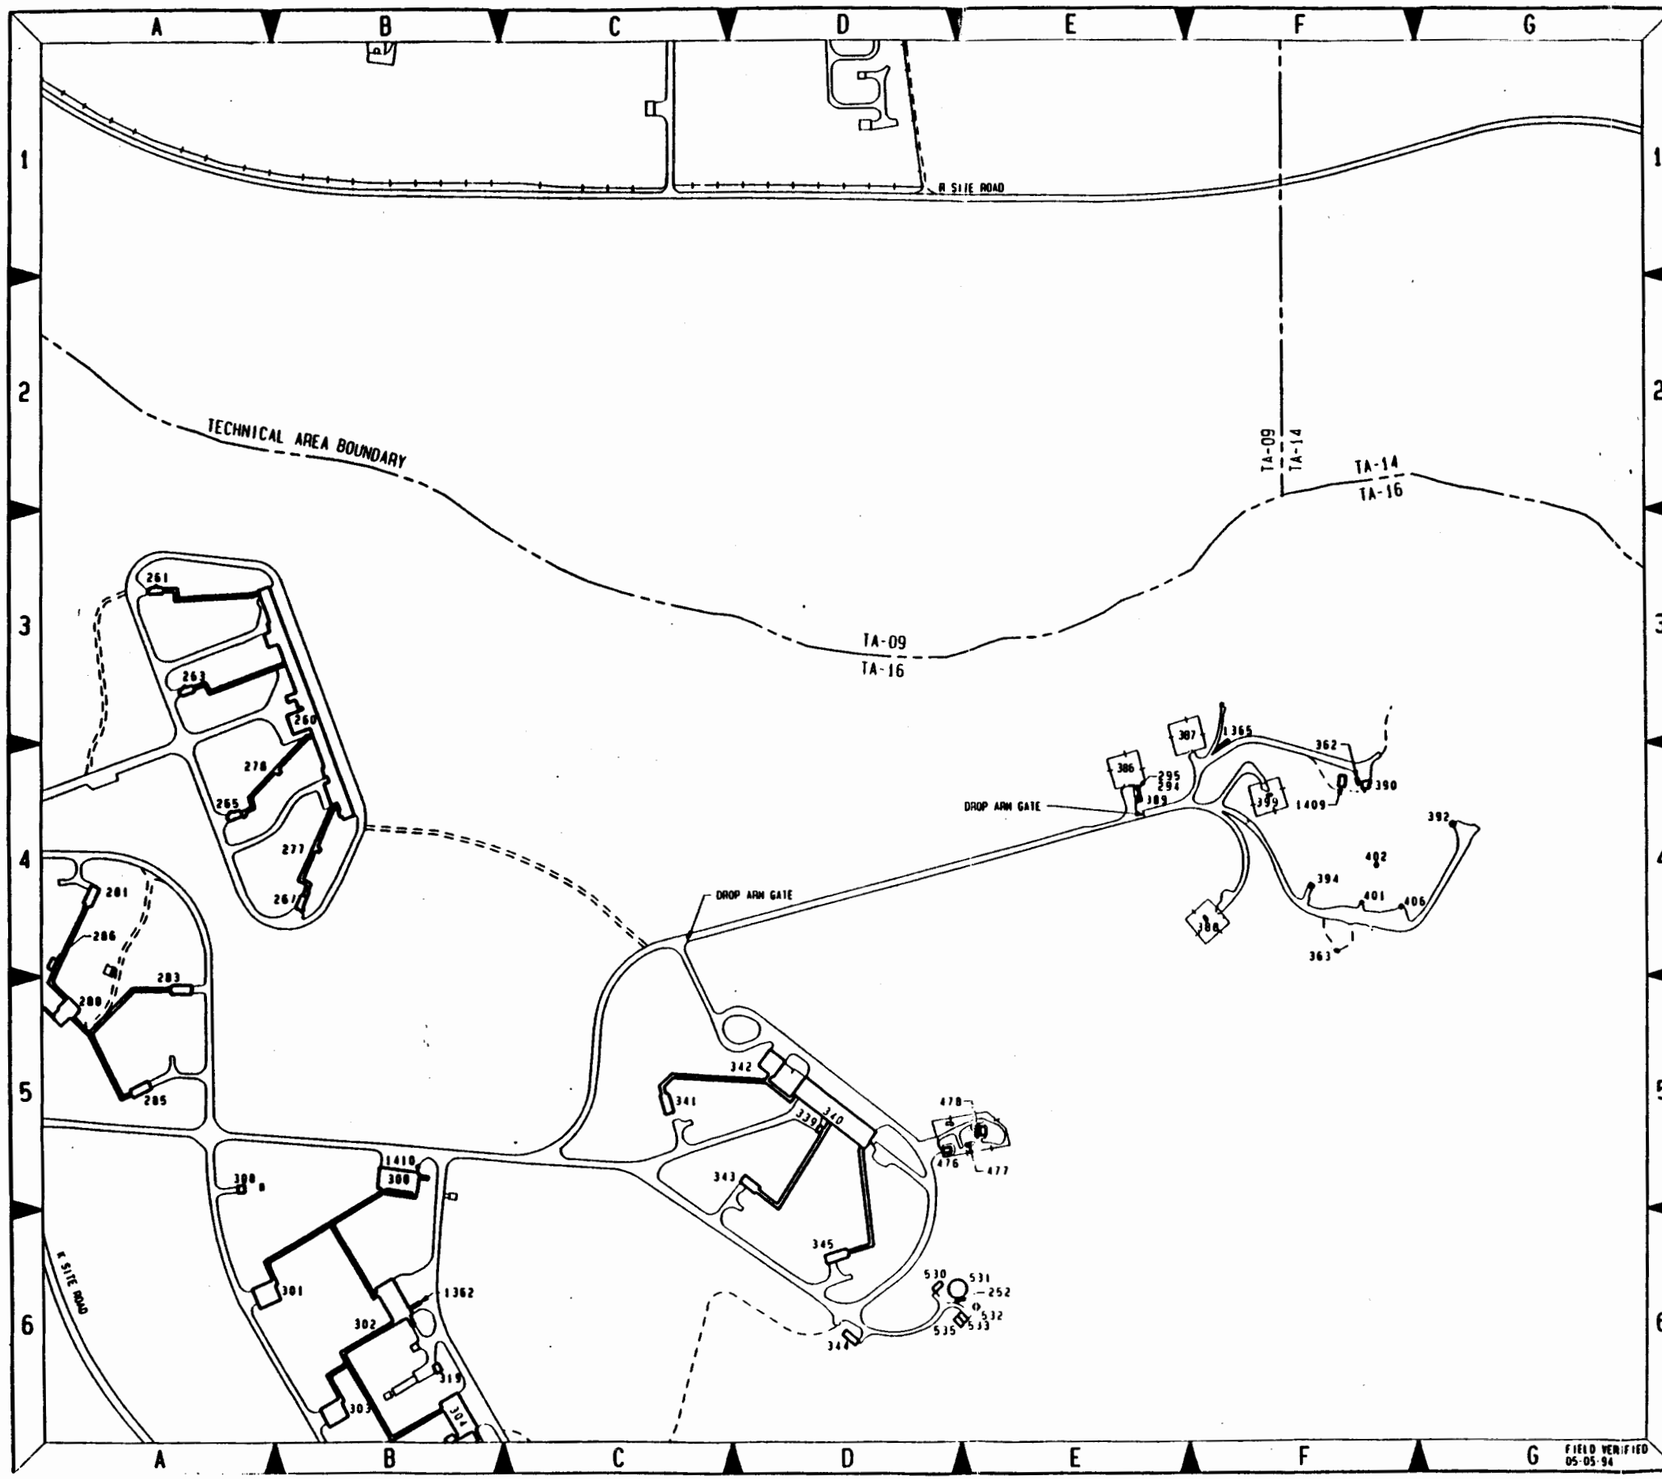

KEY MAP

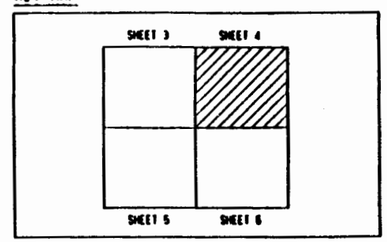

N

SCALE: 1:2400

200 0 200 400

FEET

NO	DATE	CLASS REV	REVISIONS	DWN	VER	CHKD	REL	SUB	REC	APP
1	05-16-94		REVISED PER NEW STANDARDS AND TO STATUS OF 05-05-94	JPM	JPM	HMS	HMS	OAF	BEC	RAP

JOHNSON CONTROLS WORLD SERVICES INC.

AS-BUILT STRUCTURE LOCATION MAPS

TA-16

S SITE

DRAWN J. HORK
VERIFIED J. HORK
CHECKED H. SALAZAR
RELEASED H. SALAZAR
DATE 08-04-93

SUBMITTED JERRY FORTE
RECOMMENDED BRIAN CONNER
APPROVED ROBERT PROWSE

Los Alamos — Los Alamos National Laboratory, Los Alamos, New Mexico 87545

SHEET 4 / 6

CLASSIFICATION U REVIEWER H. SALAZAR DATE 5-16-94

PROJECT ID 11952

DRAWING NO AB21

REV 1

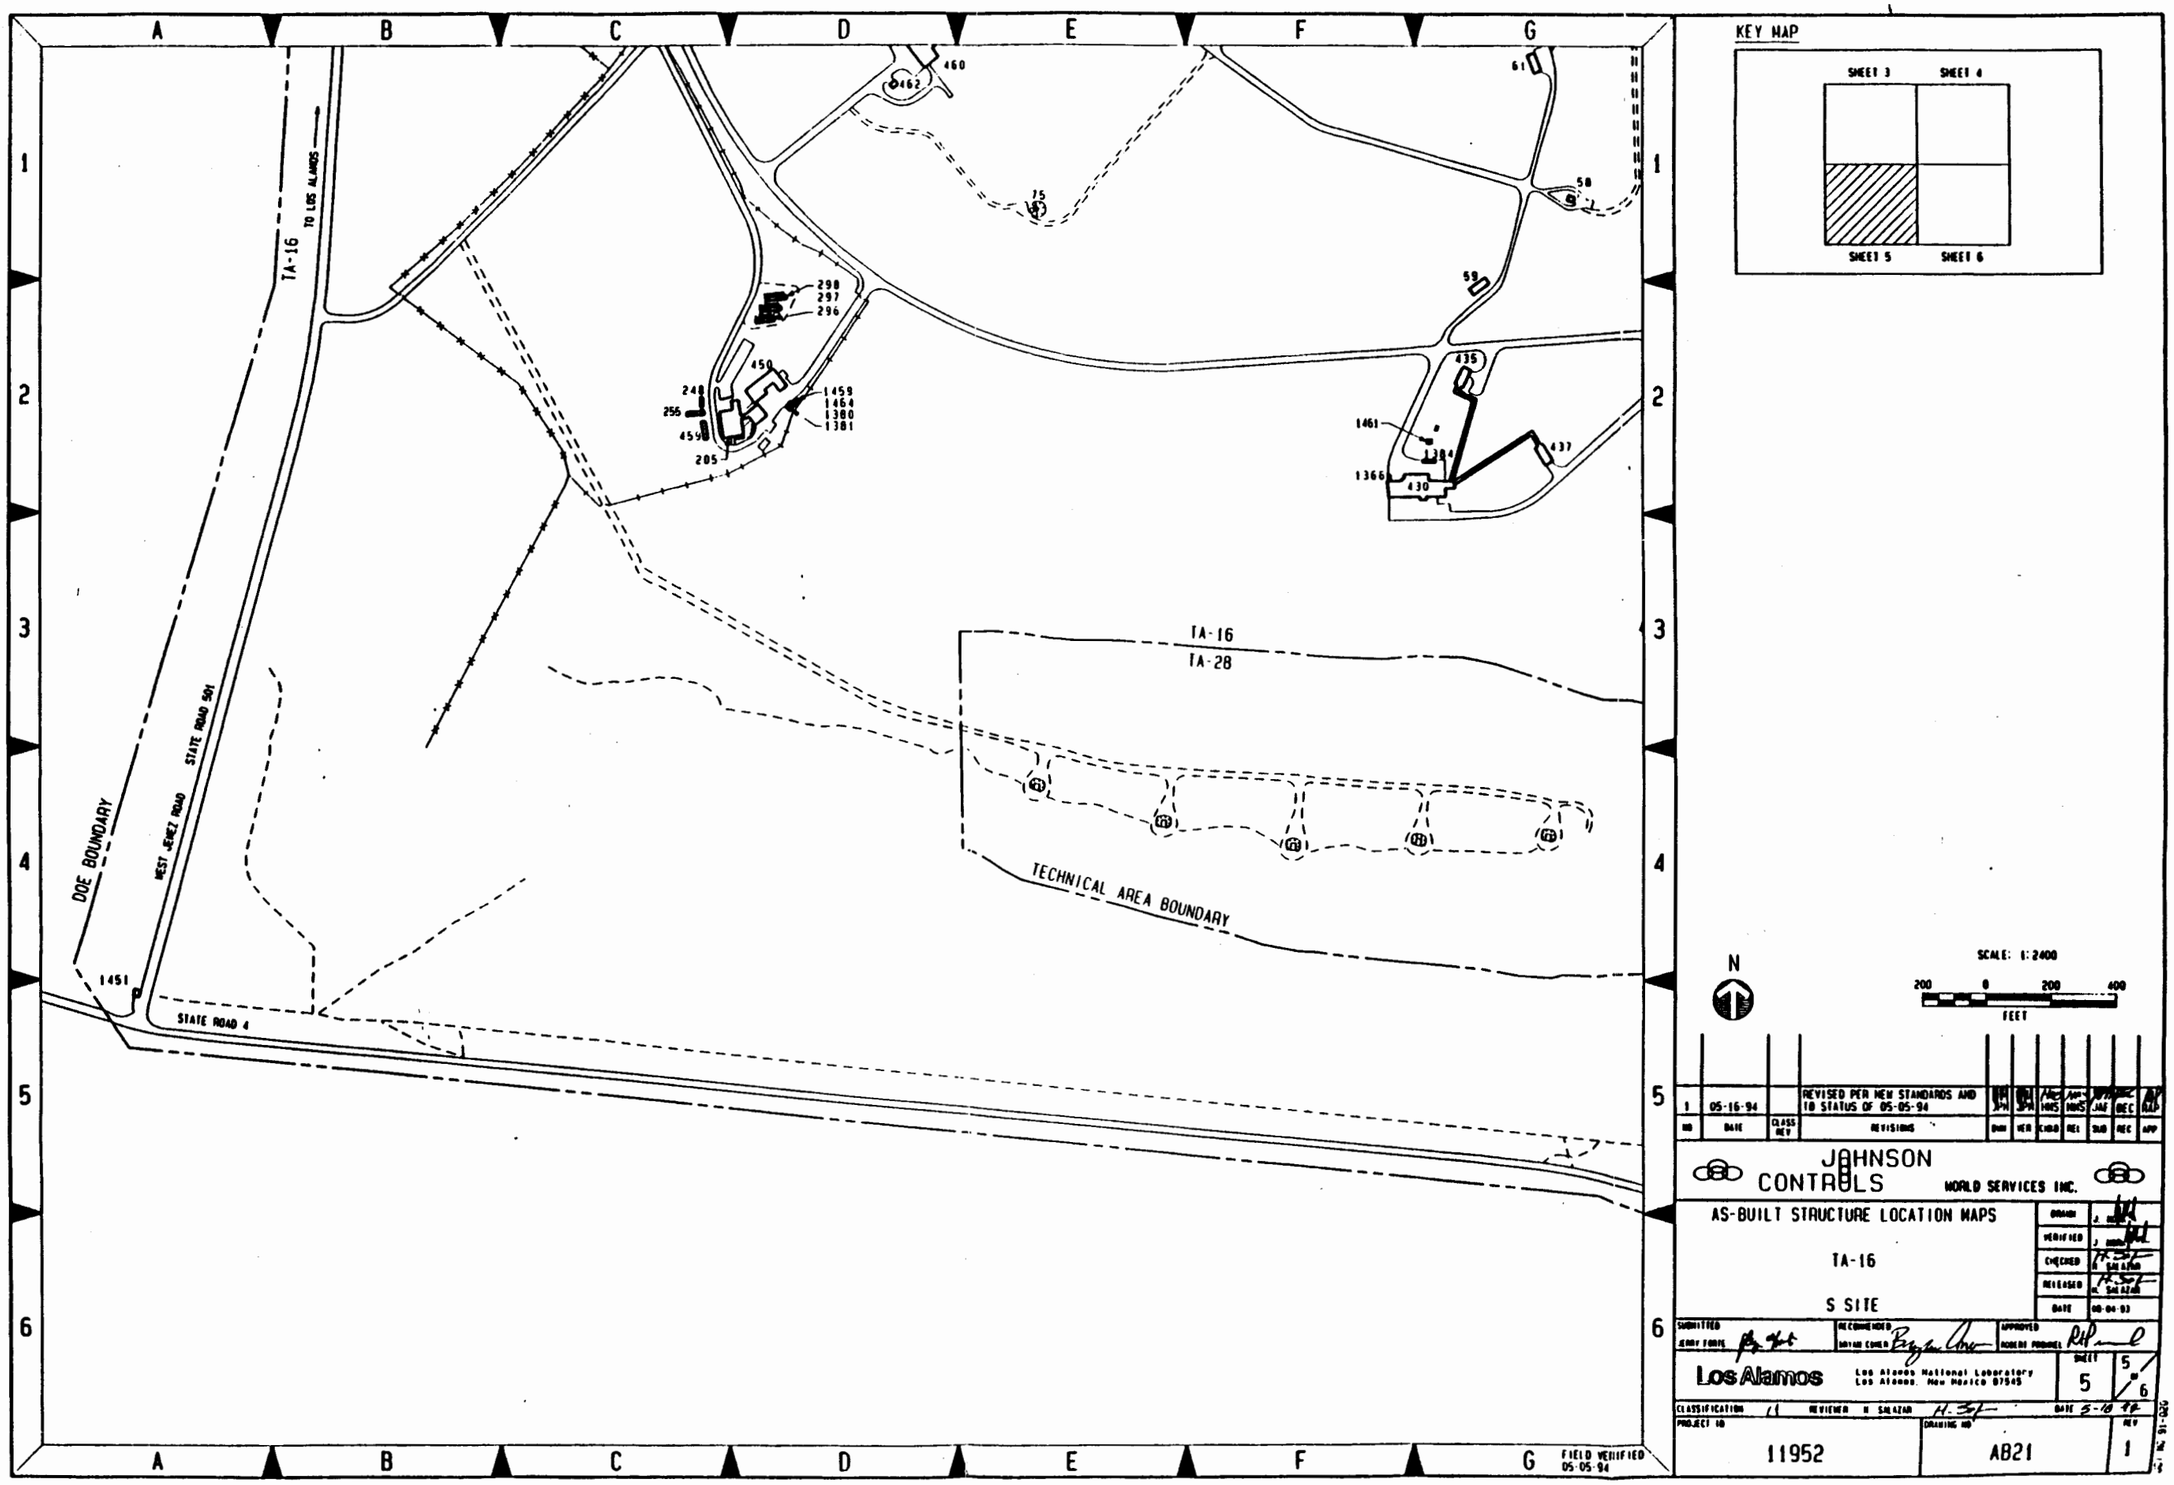

NO	DATE	CLASS REV	REVISIONS	DWN	VER	CHKD	REL	SUB	REC	APP
1	05-16-94		REVISED PER NEW STANDARDS AND TB STATUS OF 05-05-94	JPH	JPH	HMS	HMS	JAF	BEC	RAP

JOHNSON CONTROLS WORLD SERVICES INC.

AS-BUILT STRUCTURE LOCATION MAPS

TA-16

S SITE

DRAWN J. [illegible]
VERIFIED J. [illegible]
CHECKED H. SALAZAR
RELEASED H. SALAZAR
DATE 08-04-93

SUBMITTED JERRY FORTE
RECOMMENDED BRYAN COHEN
APPROVED ROBERT PRUNNEL

Los Alamos — Los Alamos National Laboratory, Los Alamos, New Mexico 87545

SHEET 5 of 6

CLASSIFICATION U REVIEWER H. SALAZAR DATE 5-18-94

PROJECT ID 11952

DRAWING NO AB21

REV 1

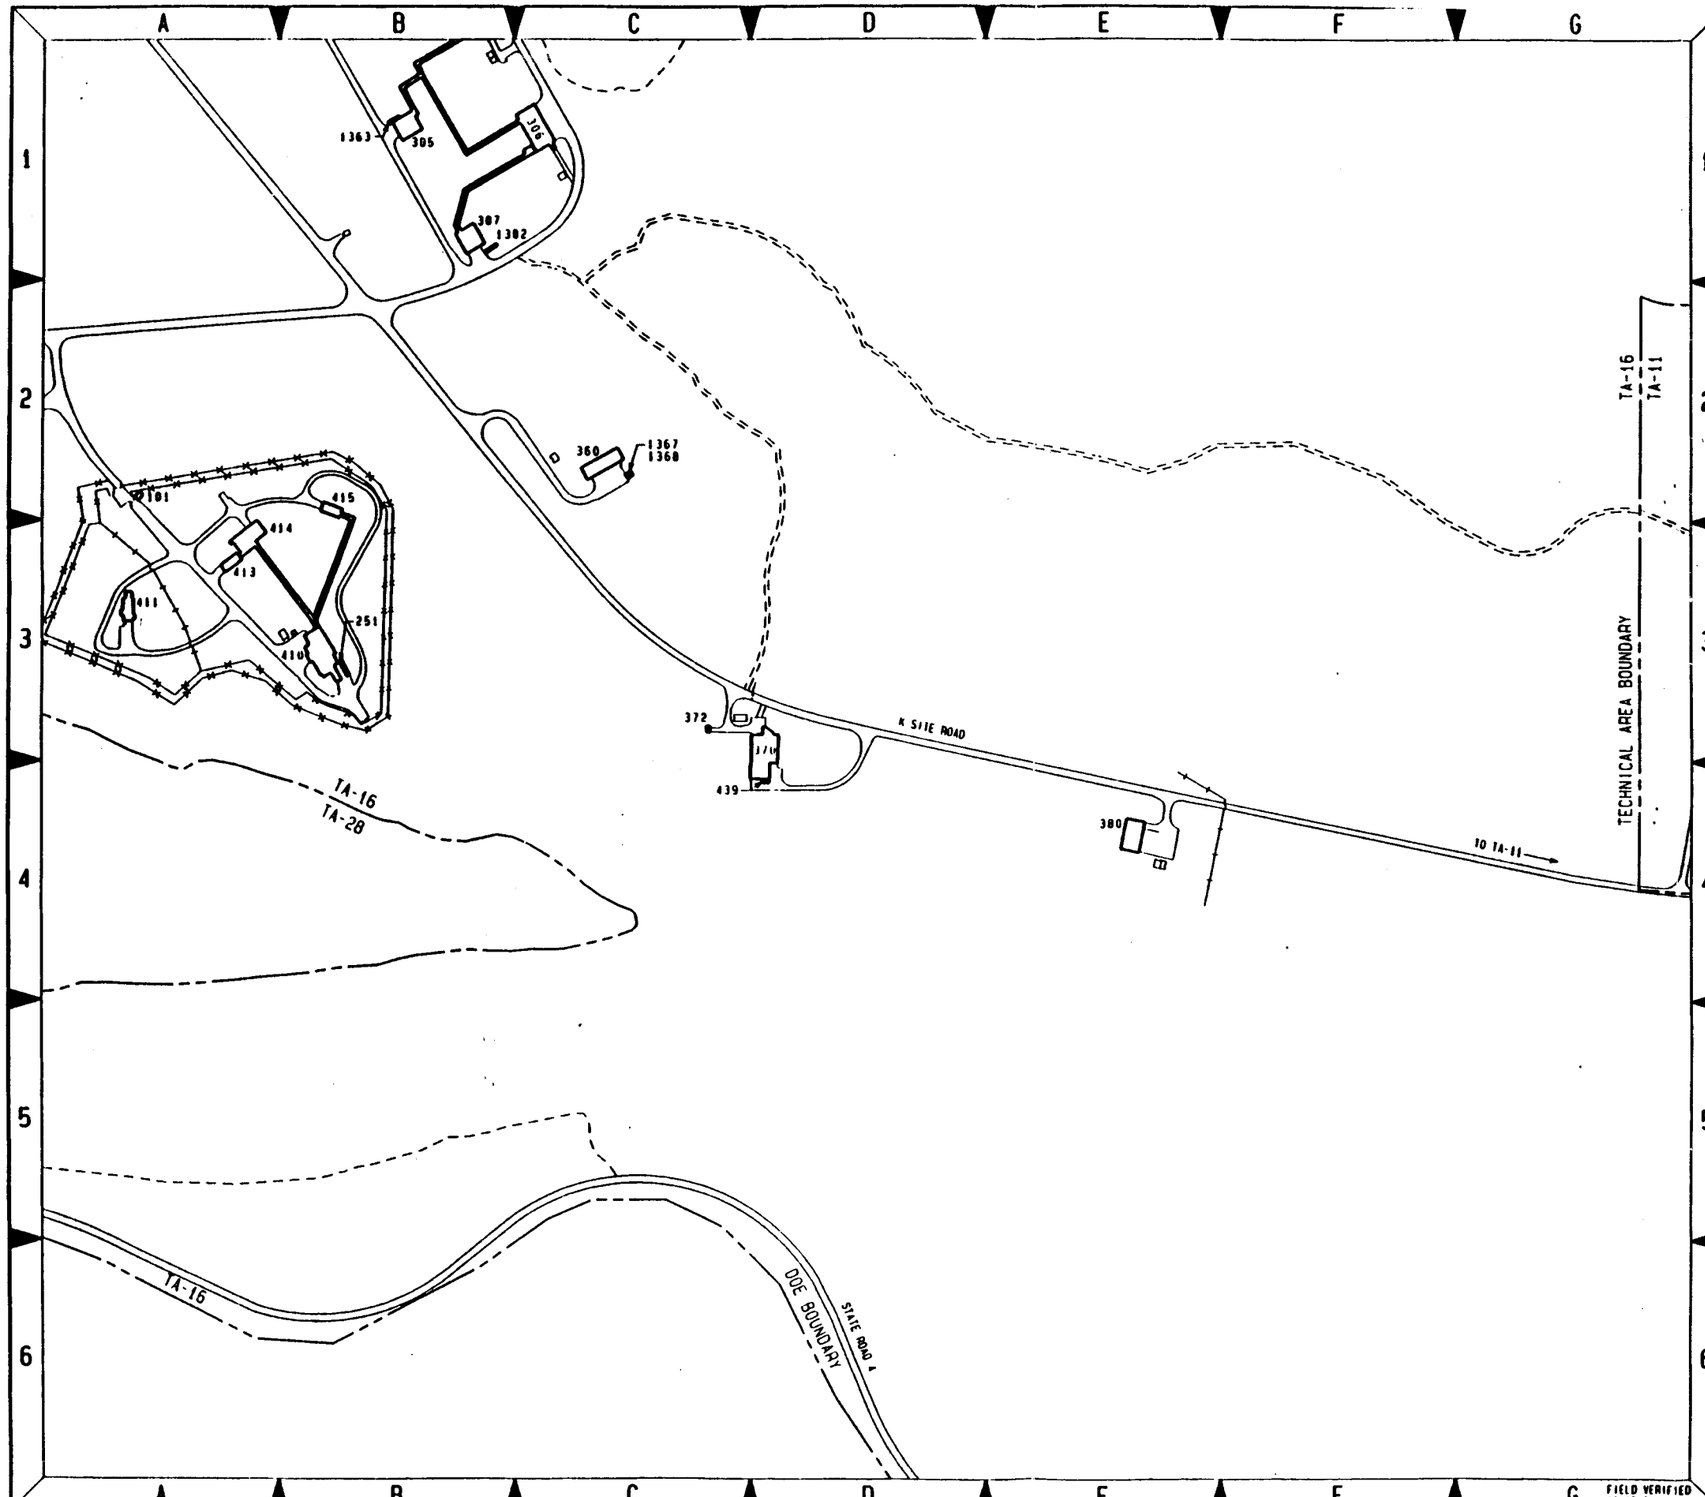

KEY MAP

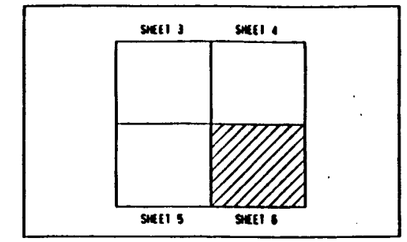

N

SCALE: 1:2400

200 0 200 400

FEET

NO	DATE	CLASS REV	REVISIONS	SUM	VER	CHKD	REL	SUB	REC	APP
1	05-16-94		REVISED PER NEW STANDARDS AND TO STATUS OF 05-05-94	JPH	JPH	HMS	HMS	JAF	BEC	RAP

JOHNSON CONTROLS WORLD SERVICES INC.

AS-BUILT STRUCTURE LOCATION MAPS

TA-16

S SITE

DRAWN J. NORA
VERIFIED J. NORA
CHECKED H. SALAZAR
RELEASED H. SALAZAR
DATE 08-04-93

SUBMITTED JERRY FORTE
RECOMMENDED DRYAN COHEN
APPROVED ROBERT PROMEL

Los Alamos — Los Alamos National Laboratory, Los Alamos, New Mexico 87545

SHEET 6 — 6 / 6

CLASSIFICATION U — REVIEWER H. SALAZAR — DATE 5-18-94

PROJECT ID 11952 — DRAWING NO AB21 — REV 1

STRUCTURE LOCATION MAPS

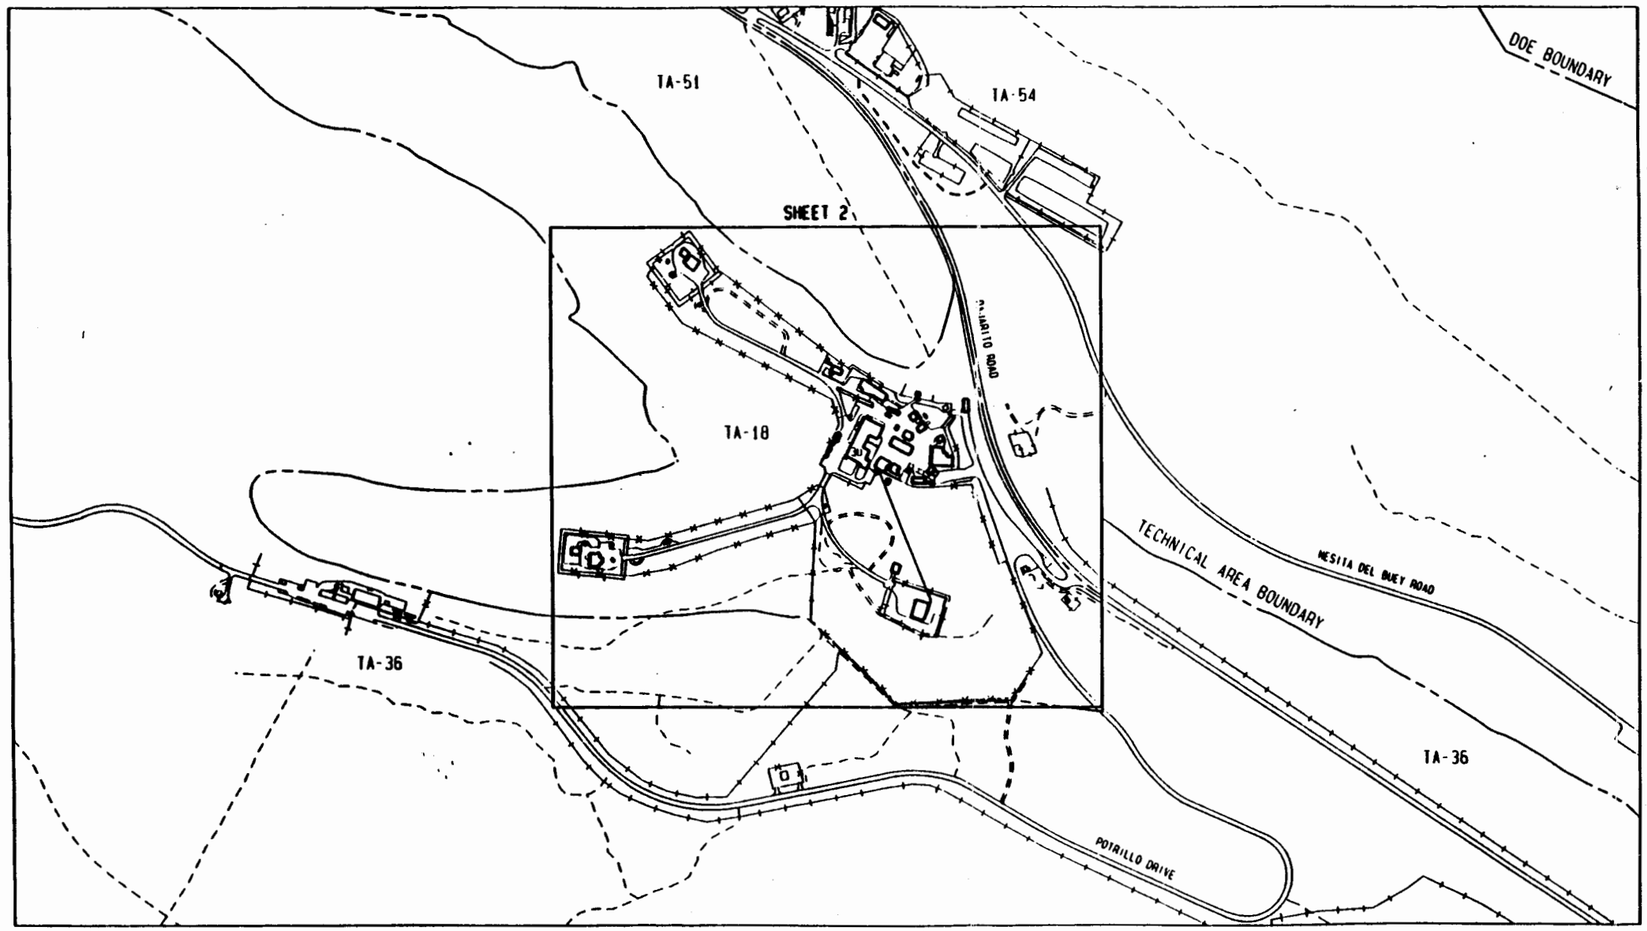

TA-18 KEY MAP

SCALE: 1:3600

300 0 300 600

FEET

N

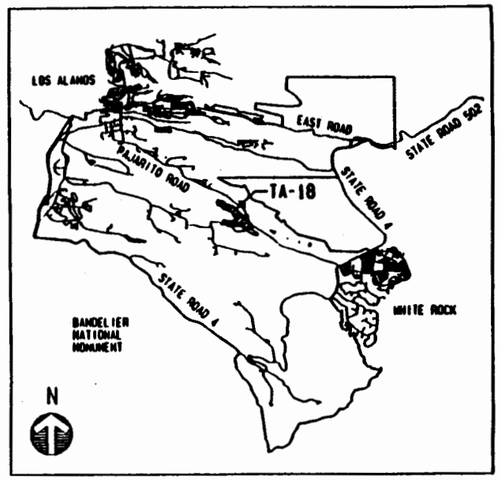

LOCATION PLAN

SCALE: NONE

NO	DATE	CLASS REV	REVISIONS	DWN	VER	CHKD	REL	SUB	REC	APP

JOHNSON CONTROLS WORLD SERVICES INC.

AS-BUILT STRUCTURE LOCATION MAPS

TA-18

PAJARITO LABORATORY

DRAWN H. SALAZAR
VERIFIED J. NORK
CHECKED J. NORK
RELEASED H. SALAZAR
DATE 05-16-94

SUBMITTED JERRY FORTE
RECOMMENDED BRIAN COWER
APPROVED ROBERT PROWSE

Los Alamos — Los Alamos National Laboratory, Los Alamos, New Mexico 87545

SHEET 1 of 2

CLASSIFICATION U — REVIEWER H. SALAZAR — DATE 5-17-94

PROJECT ID 11952 — DRAWING NO AB22 — REV

JCI NO. 91-020

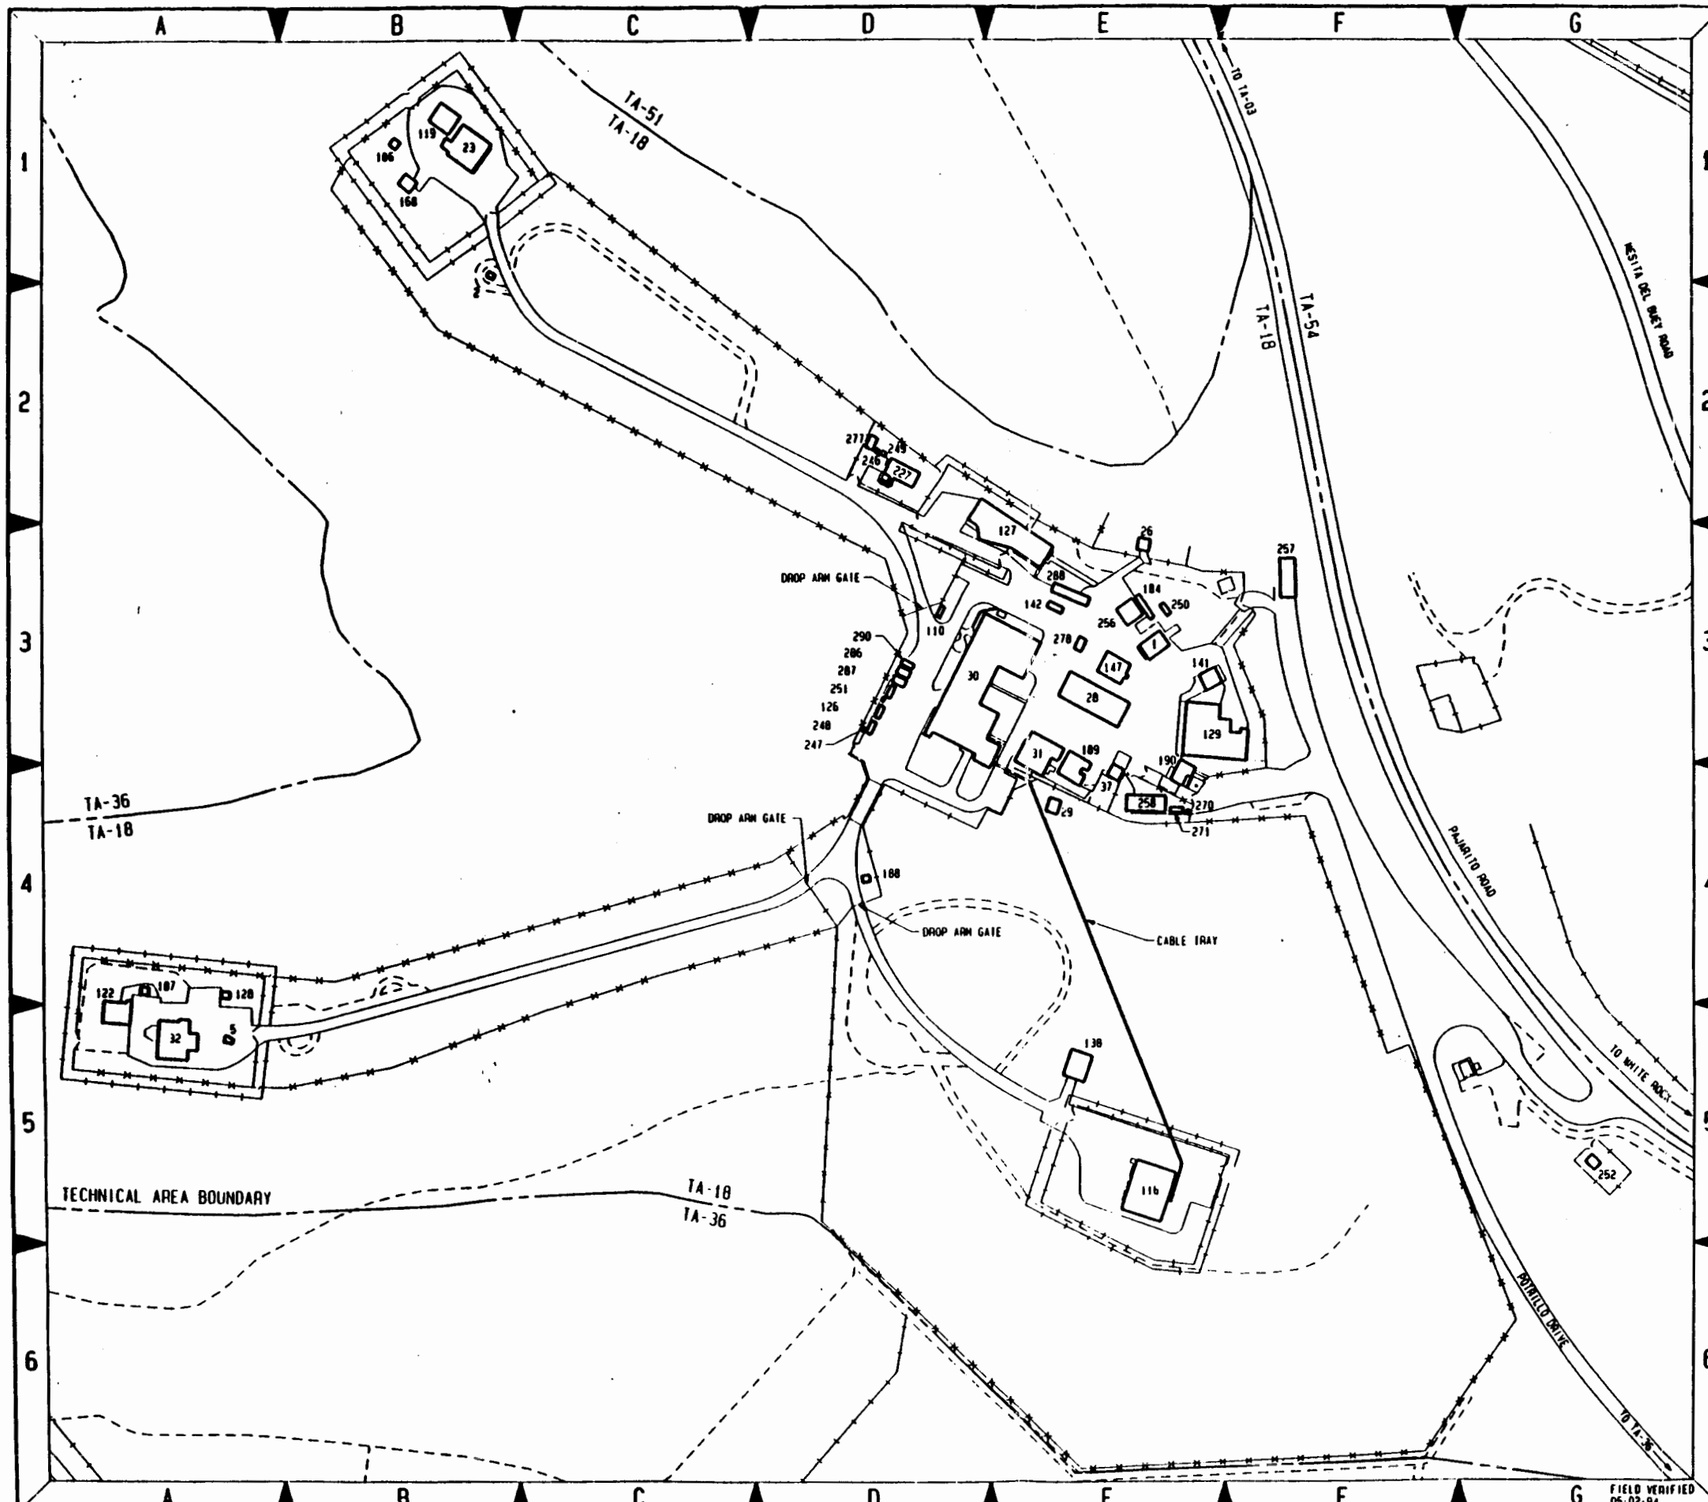

STRUCTURE LOCATION INDEX

TA-NUMBER	STRUCTURE DESIGNATION	STRUCTURE NOMENCLATURE	STRUCTURE LOCATOR SHEET NO.	STRUCTURE LOCATOR MAP KEY
18-1	PL-1	STAGING AREA	2	C-3
18-2	PL-2	METAL BUILDING	2	B-1
18-5	PL-5	METAL BUILDING	2	A-5
18-23	18-23	CRITICAL ASSEMBLY BLDG. KIVA #1	2	B-1
18-26	18-26	VAULT	2	E-3
18-28	PL-28	WAREHOUSE	2	E-3
18-29	18-29	POND CABIN	2	E-4
18-30	PL-30	MAIN BUILDING	2	D-3
18-31	PL-31	UTILITY BUILDING	2	E-3
18-32	PL-32	CRITICAL ASSEMBLY BLDG. KIVA #2	2	A-5
18-37	PL-37	GUARD STATION #205	2	E-4
18-110	PL-110	DRUM STORAGE PLATFORM	2	D-3
18-116	PL-116	CRITICAL ASSEMBLY BUILDING	2	E-5
18-119	18-119	STORAGE BUILDING	2	B-1
18-122	PL-122	STORAGE BUILDING	2	A-5
18-126	PL-126	POWER PEDESTAL	2	D-3
18-127	PL-127	PULSED ACCELERATOR BLDG.	2	E-3
18-128	18-128	ASSEMBLY COVER BUILDING	2	A-4
18-129	PL-129	REACTOR SUB-ASSEMBLY BLDG.	2	E-3
18-138	PL-138	WAREHOUSE	2	E-5
18-141	PL-141	ULTRA-SONIC CLEANING BLDG.	2	E-3
18-142	18-142	SUBSTATION	2	E-3
18-147	PL-147	OFFICE BUILDING	2	E-3
18-168	PL-168	SHEBA CRITICAL BUILDING	2	B-1
18-184	18-184	TRAILER	2	E-3
18-186	PL-186	GUARD TOWER	2	B-1
18-187	18-187	GUARD TOWER	2	A-4
18-188	PL-188	GUARD TOWER	2	D-4
18-189	18-189	SECURITY ASSESSMENT BLDG.	2	E-4
18-190	PL-190	GUARD STATION #450	2	E-4
18-227	18-227	ACCELERATOR DEV. LAB.	2	D-2
18-246	18-246	TRANSPORTAINER	2	D-2
18-247	18-247	TRANSPORTAINER	2	D-3
18-248	18-248	TRANSPORTAINER	2	D-3
18-249	18-249	TRANSPORTAINER	2	D-2
18-250	18-250	TRANSPORTAINER	2	E-3
18-251	18-251	TRANSPORTAINER	2	D-3
18-252	18-252	PAJARITO WELL #2	2	G-5
18-256	18-256	STORAGE BLDG.	2	E-3
18-257	18-257	OFFICE TRAILER	2	F-3
18-258	18-258	OFFICE TRAILER	2	E-4
18-270	18-270	TEMP. GUARD STATION	2	E-4
18-271	18-271	TRANSPORTAINER	2	E-4
18-277	18-277	STORAGE SHED	2	D-2
18-278	18-278	STORAGE SHED	2	E-3
18-286	18-286	STORAGE SHED	2	D-3
18-287	18-287	STORAGE SHED	2	D-3
18-288	18-288	TRAILER, OFFICE	2	E-3
18-290	18-290	TRANSPORTAINER	2	D-3

N

SCALE: 1:1200

100 0 100 200
FEET

NO	DATE	CLASS REV	REVISIONS	DRAWN	VER	LAND	REL	SHD	REC	APP
1	05-16-94		REVISED PER NEW STANDARDS AND TO STATUS OF 05 02-94	JAC	JAC	JWH	HWS	JAC	DEC	RAP

JOHNSON CONTROLS WORLD SERVICES INC.

AS-BUILT STRUCTURE LOCATION MAPS

TA-18

PAJARITO LABORATORY

DRAWN	J. HORN
VERIFIED	J. HORN
CHECKED	C. SANDOVAL
RELEASED	H. SALAZAR
DATE	07-21-93

SUBMITTED JERRY FORTE — RECOMMENDED BRYAN COWAN — APPROVED ROBERT PADILLA

Los Alamos — Los Alamos National Laboratory, Los Alamos, New Mexico 87545

SHEET 2 / 2

CLASSIFICATION U — REVIEWER H. SALAZAR — DATE 8-17-93

PROJECT ID 11952 — DRAWING NO AB22 — REV 1

LC NO 91-020

STRUCTURE LOCATION MAPS

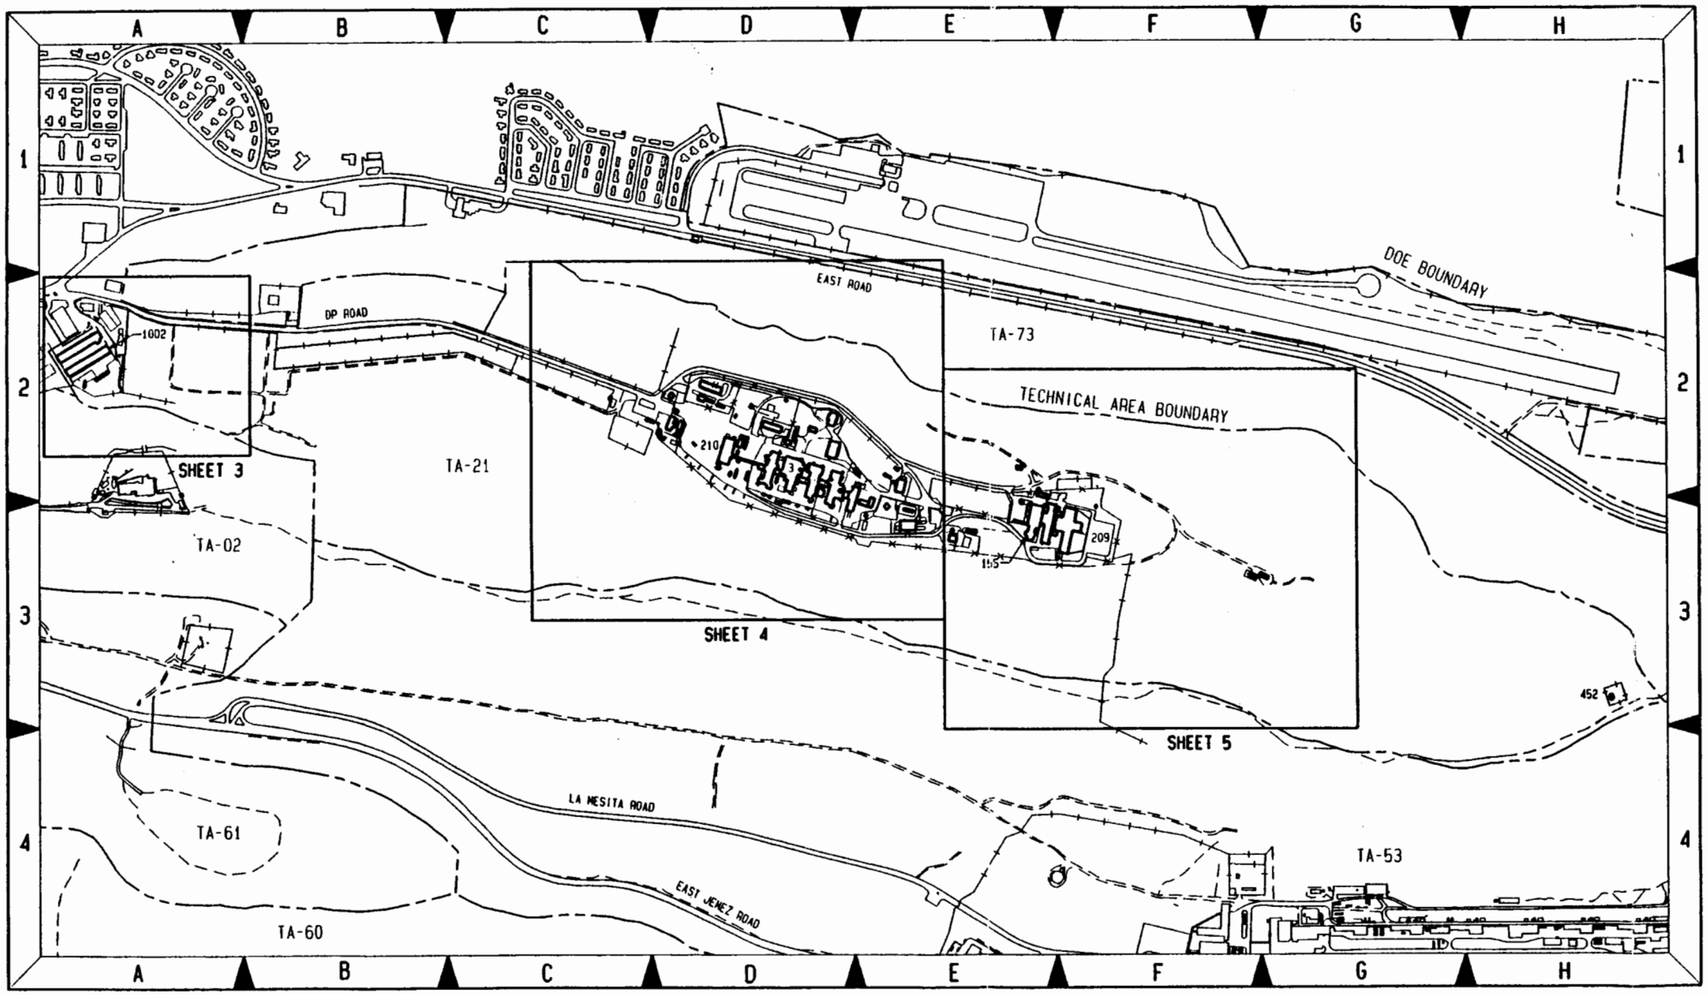

TA-21 KEY MAP

SCALE: 1:4800

400 0 400 800

FEET

N

FIELD VERIFIED 07-13-94

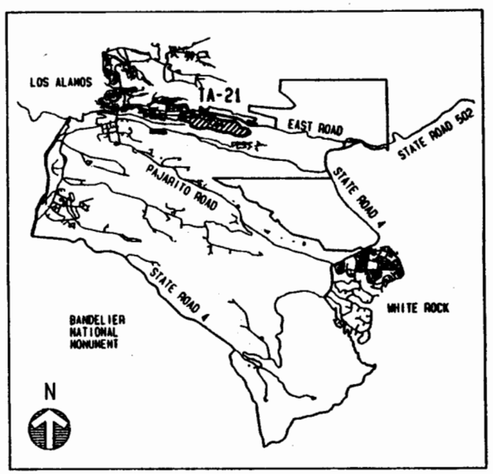

LOCATION PLAN

SCALE: NONE

NO	DATE	CLASS REV	REVISIONS	DWN	VER	CHKD	REL	SUB	REC	APP
1	07-29-94		REVISED TO NEW STANDARDS AND TO STATUS OF 07-13-94	CMB	JPM	JPM	HWS	HWS	JAE	BEC	RAP

JOHNSON CONTROLS WORLD SERVICES INC.

AS-BUILT STRUCTURE LOCATION MAPS

TA-21

DP SITE

DRAWN	J. HORK
VERIFIED	H. SENA, J. HORK
CHECKED	C. SANDOVAL
RELEASED	H. SALAZAR
DATE	08-23-93

SUBMITTED JERRY FORTE | RECOMMENDED BRIAN COMER | APPROVED ROBERT PROMMEL

Los Alamos — Los Alamos National Laboratory, Los Alamos, New Mexico 87545

SHEET 1 OF 5

CLASSIFICATION U | REVIEWER H. SALAZAR | DATE 8-2-94

PROJECT ID 11952 | DRAWING NO AB23 | REV 1

JCI NO 020-16

STRUCTURE LOCATION INDEX

STRUCTURE TA-NUMBER	STRUCTURE DESIGNATION	STRUCTURE NOMENCLATURE	STRUCTURE LOCATOR SHEET NO.	STRUCTURE LOCATOR MAP KEY
21-1	DP-1	OFFICE VAULT BLDG.	4	D-4
21-2	DP-2	LABORATORY BLDG.	4	E-4
21-3	DP-3	LABORATORY BLDG.	4	E-4
21-4	DP-4	LABORATORY BLDG.	4	E-4
21-5	DP-5	LABORATORY BLDG.	4	F-4
21-14	DP-14	INSTRUMENT BLDG.	4	C-3
21-21	DP-21	VAULT	4	E-3
21-30	DP-30	LABORATORY	4	C-3
21-31	DP-31	MAINT., WORKSHOP & CRAFTS BLDG.	4	D-3
21-42	DP-42	PUMP HOUSE	4	G-5
21-46	DP-46	WAREHOUSE	4	C-3
21-57	21-57	FUEL TANK	4	G-5
21-59	DP-59	STORAGE BLDG.	5	A-3
21-61	DP-61	MIXED WASTE STORAGE FACILITY	5	A-3
21-65	DP-65	STORAGE BLDG.	5	A-3
21-66	21-66	CYLINDER STORAGE	5	A-3
21-80	21-80	P.R.V. STATION SHED	4	E-4
21-83	21-83	P.R.V. STATION SHED	4	E-4
21-86	21-86	P.R.V. STATION SHED	4	E-4
21-89	21-89	P.R.V. STATION SHED	4	F-4
21-110	21-110	ACID TANK	4	G-4
21-111	21-111	ACID TANK	4	G-4
21-112	DP-112	ACID TANK	4	G-4
21-113	DP-113	ACID TANK	4	G-4
21-116	21-116	WAREHOUSE	4	E-4
21-143	21-143	COOLING TOWER	4	E-5
21-146	DP-146	FILTER BLDG.	4	E-4
21-149	21-149	CORRIDOR STRUCTURE	4	F-4
21-150	21-150	MOLECULAR CHEMISTRY BLDG.	4	F-4
21-152	DP-152	LABORATORY BLDG.	5	B-3
21-155	DP-155	TRITIUM SYS. TEST ASSESS. BLDG.	5	B-3
21-160	21-160	OPEN SHELTER	5	B-3
21-166	DP-166	EQUIPMENT BLDG.	5	B-3
21-167	DP-167	EQUIPMENT BLDG.	5	B-3
21-209	DP-209	TRITIUM SCIENCE & TECH. BLDG.	5	C-3
21-210	21-210	PLUT. RESEARCH SUPPORT BL.	4	D-4
21-212	DP-212	CALCIUM BUILDING	4	D-3
21-213	DP-213	LAB. SUPPLY WAREHOUSE	5	B-3
21-220	21-220	COOLING TOWER	5	B-3
21-223	21-223	MANHOLE ENCLOSURE	5	B-3
21-227	DP-227	SEWAGE TREATMENT PLANT	5	F-4
21-228	21-228	REPLACEMENT WAREHOUSE	4	F-4
21-229	21-229	CONTROL BLDG	5	F-4
21-230	21-230	SLUDGE DRYING BEDS	5	F-4
21-254	DP-254	GUARD STATION #315	4	C-3
21-257	DP-257	RAD. LIQ. WASTE DISPOSAL FAC.	4	G-4
21-258	21-258	WATER TANK	4	C-3
21-286	DP-286	WAREHOUSE	4	F-3
21-312	21-312	CORRIDOR STRUCTURE	4	D-4
21-313	21-313	CORRIDOR STRUCTURE	4	E-4
21-314	21-314	CORRIDOR STRUCTURE	4	E-4
21-315	21-315	CORRIDOR STRUCTURE	4	E-4
21-322	21-322	EXHAUST STACK	5	B-3
21-323	DP-323	EXHAUST STACK	5	B-3
21-324	DP-324	FILTER HOUSE	4	E-3
21-328	DP-328	MATERIALS RECEIVING BLDG.	4	D-4
21-334	21-334	UTILITY SHED	4	C-3
21-335	21-335	CONTAINMENT VESSEL	4	E-3
21-342	21-342	WATER TANK	4	G-5
21-346	21-346	CONDENSATE TANKS	5	B-2
21-350	DP-350	TRAILER, OFFICE	4	D-3
21-351	DP-351	TRAILER, OFFICE	4	D-4
21-352	DP-352	TRAILER, OFFICE	4	D-4
21-353	DP-353	TRAILER, CHANGE ROOM	4	D-4
21-354	DP-354	TRAILER, OFFICE	4	E-4
21-355	DP-355	TRAILER, OFFICE	4	G-4
21-356	DP-356	TRAILER, OFFICE	4	D-4
21-357	DP-357	STEAM PLANT	4	G-5
21-359	DP-359	TRAILER, OFFICE	4	D-3
21-361	DP-361	TRANSPORTABLE OFF. BLDG.	4	F-5
21-365	DP-365	TRANSPORTABLE OFF. BLDG.	4	F-5
21-367	DP-367	METAL SHED	5	C-3
21-369	DP-369	TRAILER, OFFICE	5	B-3
21-370	DP-370	MECHANICAL EQUIP. BLDG.	5	B-3
21-382	DP-382	TRAILER, OFFICE	4	F-4
21-384	DP-384	METAL SHED	4	B-3
21-387	DP-387	STORAGE SHED	5	F-4
21-388	21-388	EXHAUST STACK	5	B-3
21-396	DP-396	TRANSPORTAINER	4	D-4
21-397	DP-397	TRANSPORTAINER	4	D-4
21-399	21-399	TRANSPORTAINER	4	C-3
21-400	DP-400	TRANSPORTAINER	4	C-4
21-402	21-402	STORAGE BLDG.	4	E-3
21-403	21-403	TRANSPORTAINER	4	D-4
21-410	21-410	TRAILER, STORAGE	4	D-3
21-411	21-411	GREENHOUSE	4	F-5
21-414	21-414	TRAILER, STORAGE	4	E-4
21-427	21-427	HAZ. CHEMICAL STORAGE	4	C-3
21-428	21-428	MORGAN SHED	4	C-3
21-437	21-437	GREENHOUSE	4	F-5
21-442	21-442	LUNCH TRAILER	4	E-5
21-443	21-443	TRAILER, OFFICE	4	C-3
21-445	21-445	TRAILER, DECONTAMINATION	4	D-4
21-446	21-446	TRAILER, DECONTAMINATION	4	E-5
21-448	21-448	TRAILER, STORAGE	4	E-4
21-449	21-449	STORAGE SHED	4	C-3
21-450	21-450	TRAILER, STORAGE	4	C-3
21-451	21-451	STORAGE SHED	4	C-3
21-452	21-452	DIONI WELL #4	1	H-3
21-454	21-454	TRAILER, STORAGE	4	C-3
21-455	21-455	TRAILER, STORAGE	4	C-3
21-456	21-456	TRAILER, STORAGE	4	C-3
21-457	21-457	TRAILER, DIAGNOSTIC	4	G-5
21-458	21-458	STORAGE SHED	4	E-4
21-460	21-460	TRAILER, LABORATORY	4	D-3
21-462	21-462	TRANSPORTAINER	4	D-3
21-463	21-463	TRAILER, STORAGE	4	C-4
21-464	21-464	TRANSPORTAINER	4	D-4
21-465	21-465	TRANSPORTAINER	4	E-5
21-466	21-466	EXHAUST STACK	5	C-3
21-1001	21-1001	RECORDS CENTER	3	B-3
21-1002	21-1002	WAREHOUSE 120 6TH STREET	1	B-3
21-1003	21-1003	BACKFLOW PREVENTER	3	C-4
21-1004	21-1004	STORAGE SHED	3	C-4
21-1005	21-1005	STORAGE SHED	3	C-4
21-1006	21-1006	STORAGE SHED	3	B-4
21-1007	21-1007	STORAGE SHED	3	B-4
21-1008	21-1008	STORAGE SHED	3	B-4
21-1009	21-1009	STORAGE SHED	3	C-4
21-1010	21-1010	TRANSPORTAINER	3	B-4

NO	DATE	CLASS REV	REVISIONS	DWN	YER	CHKD	REL	SUB	REC	APP
1	07-29-94		REVISED TO NEW STANDARDS AND TO STATUS OF 07-13-94	DMB	JPM	HMS	HMS	KAF	BEC	RAP

JOHNSON CONTROLS WORLD SERVICES INC.

AS-BUILT STRUCTURE LOCATION MAPS

TA-21

DP SITE

DRAWN: J. MORK
VERIFIED: H. SENA, J. MORK
CHECKED: C. SANDOVAL
RELEASED: H. SALAZAR
DATE: 08-09-93

SUBMITTED: JERRY FORTE
RECOMMENDED: BRIAN COMER
APPROVED: ROBERT PROMMEL

Los Alamos National Laboratory, Los Alamos, New Mexico 87545

SHEET 2 OF 5

CLASSIFICATION: U REVIEWER: H. SALAZAR DATE: 8-2-94

PROJECT ID: 11952
DRAWING NO: AB23
REV: 1

JCI NO 91-020

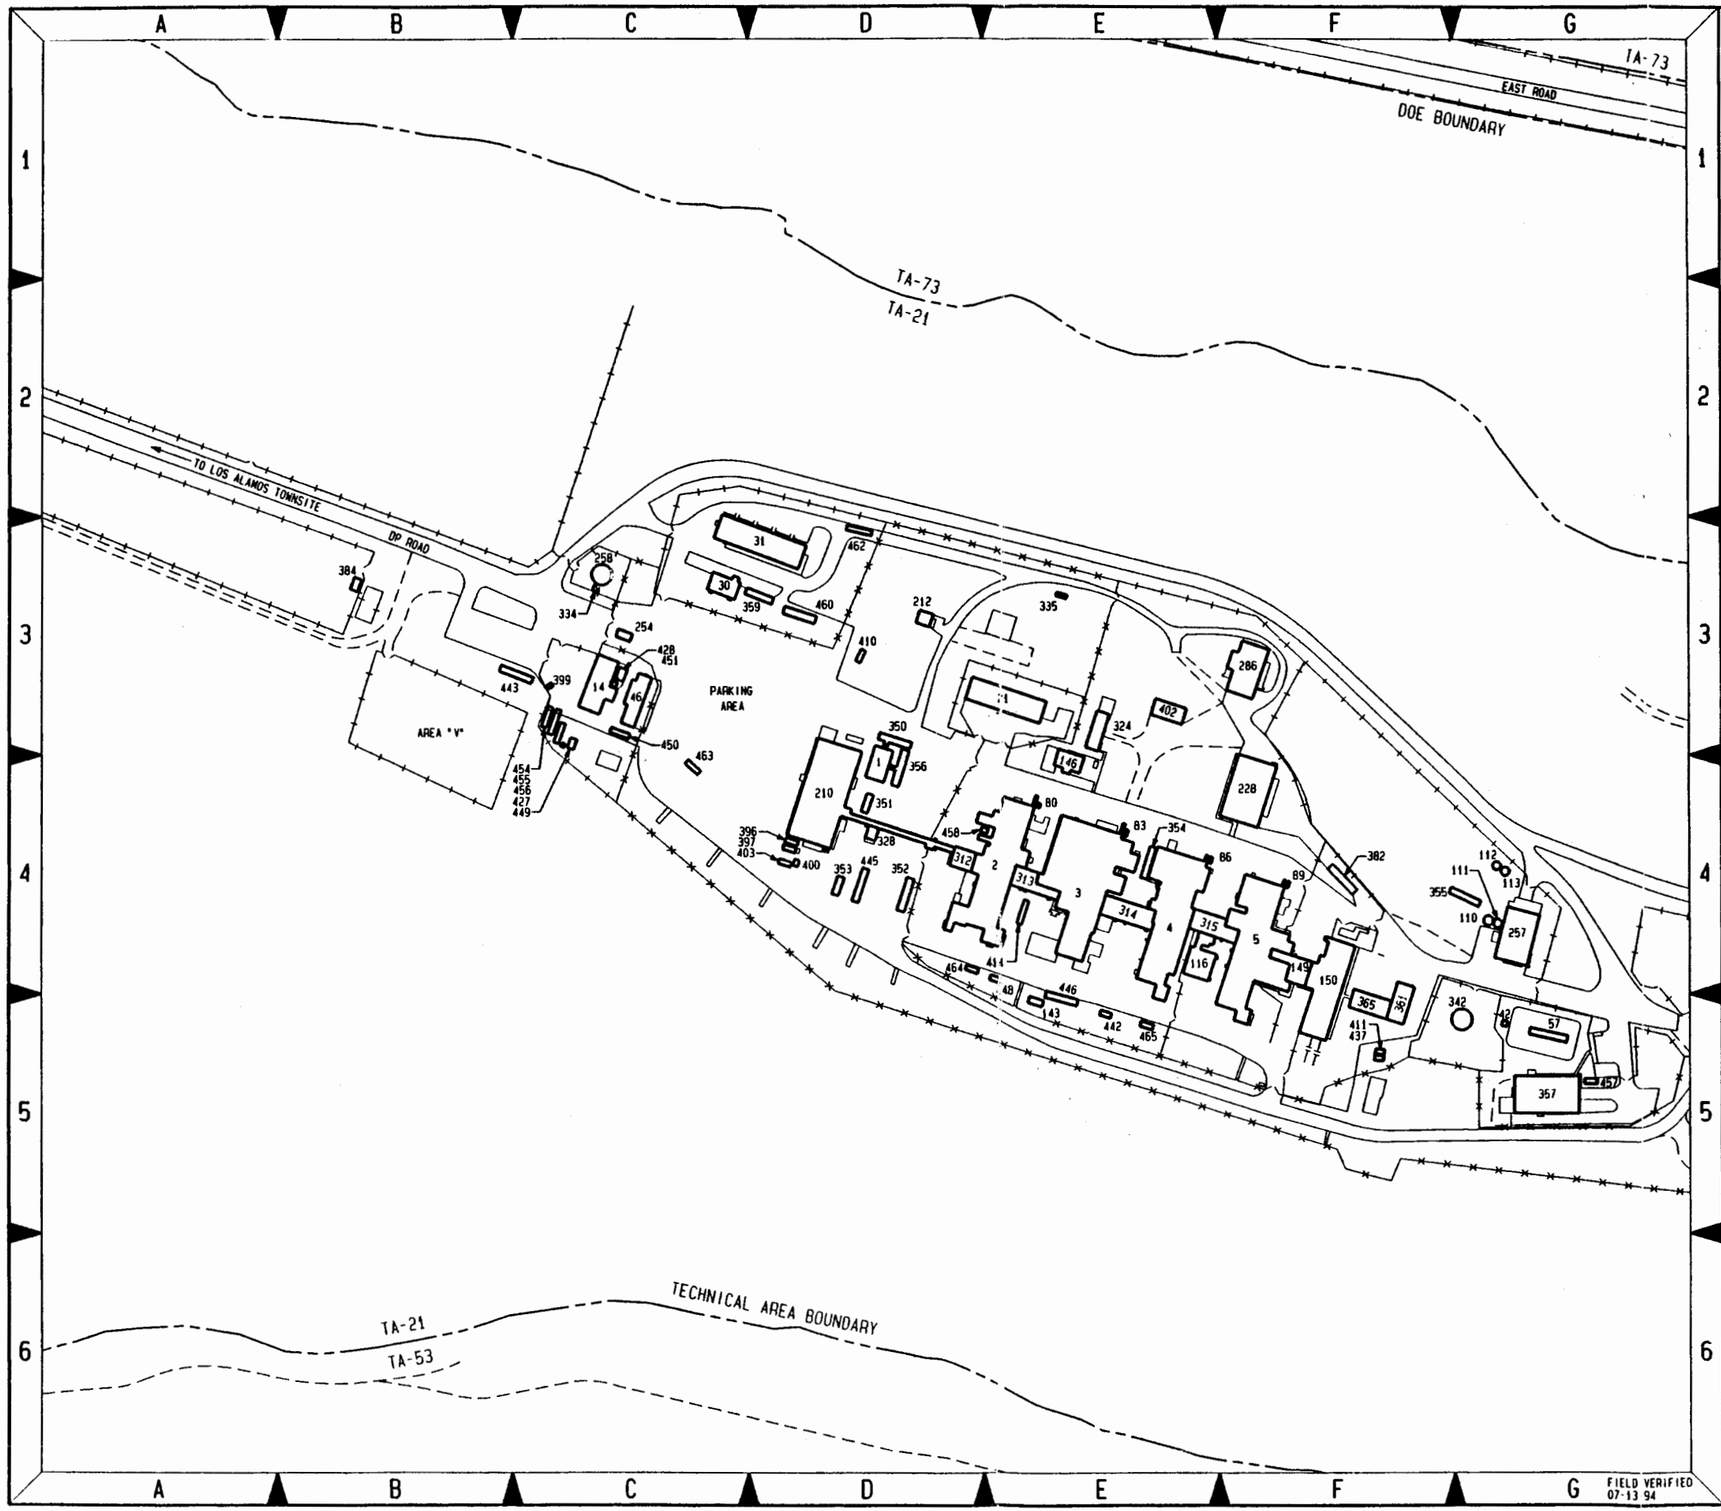

KEY MAP

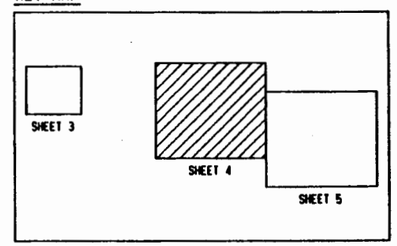

N

SCALE: 1:1200

100 0 100 200

FEET

NO	DATE	CLASS REV	REVISIONS	DWN	VER	CHKD	REL	SUB	REC	APP
1	07-29-94		REVISED TO NEW STANDARDS AND TO STATUS OF 07-13-94	DRB JPN	JPN	HMS	HMS	JAF	BEC	RAP

JOHNSON CONTROLS WORLD SERVICES INC.

AS-BUILT STRUCTURE LOCATION MAPS

TA-21

DP SITE

DRAWN	J. MORK
VERIFIED	N. SENA J. MORK
CHECKED	C. SANDOVAL
RELEASED	H. SALAZAR
DATE	08-23-93

SUBMITTED JERRY FORTE

RECOMMENDED BRYAN COMER

APPROVED ROBERT PROMMEL

Los Alamos — Los Alamos National Laboratory, Los Alamos, New Mexico 87545

SHEET 4 of 5

CLASSIFICATION U REVIEWER H. SALAZAR DATE 8-2-94

PROJECT ID 11952

DRAWING NO AB23

REV 1

JCI NO 91-020

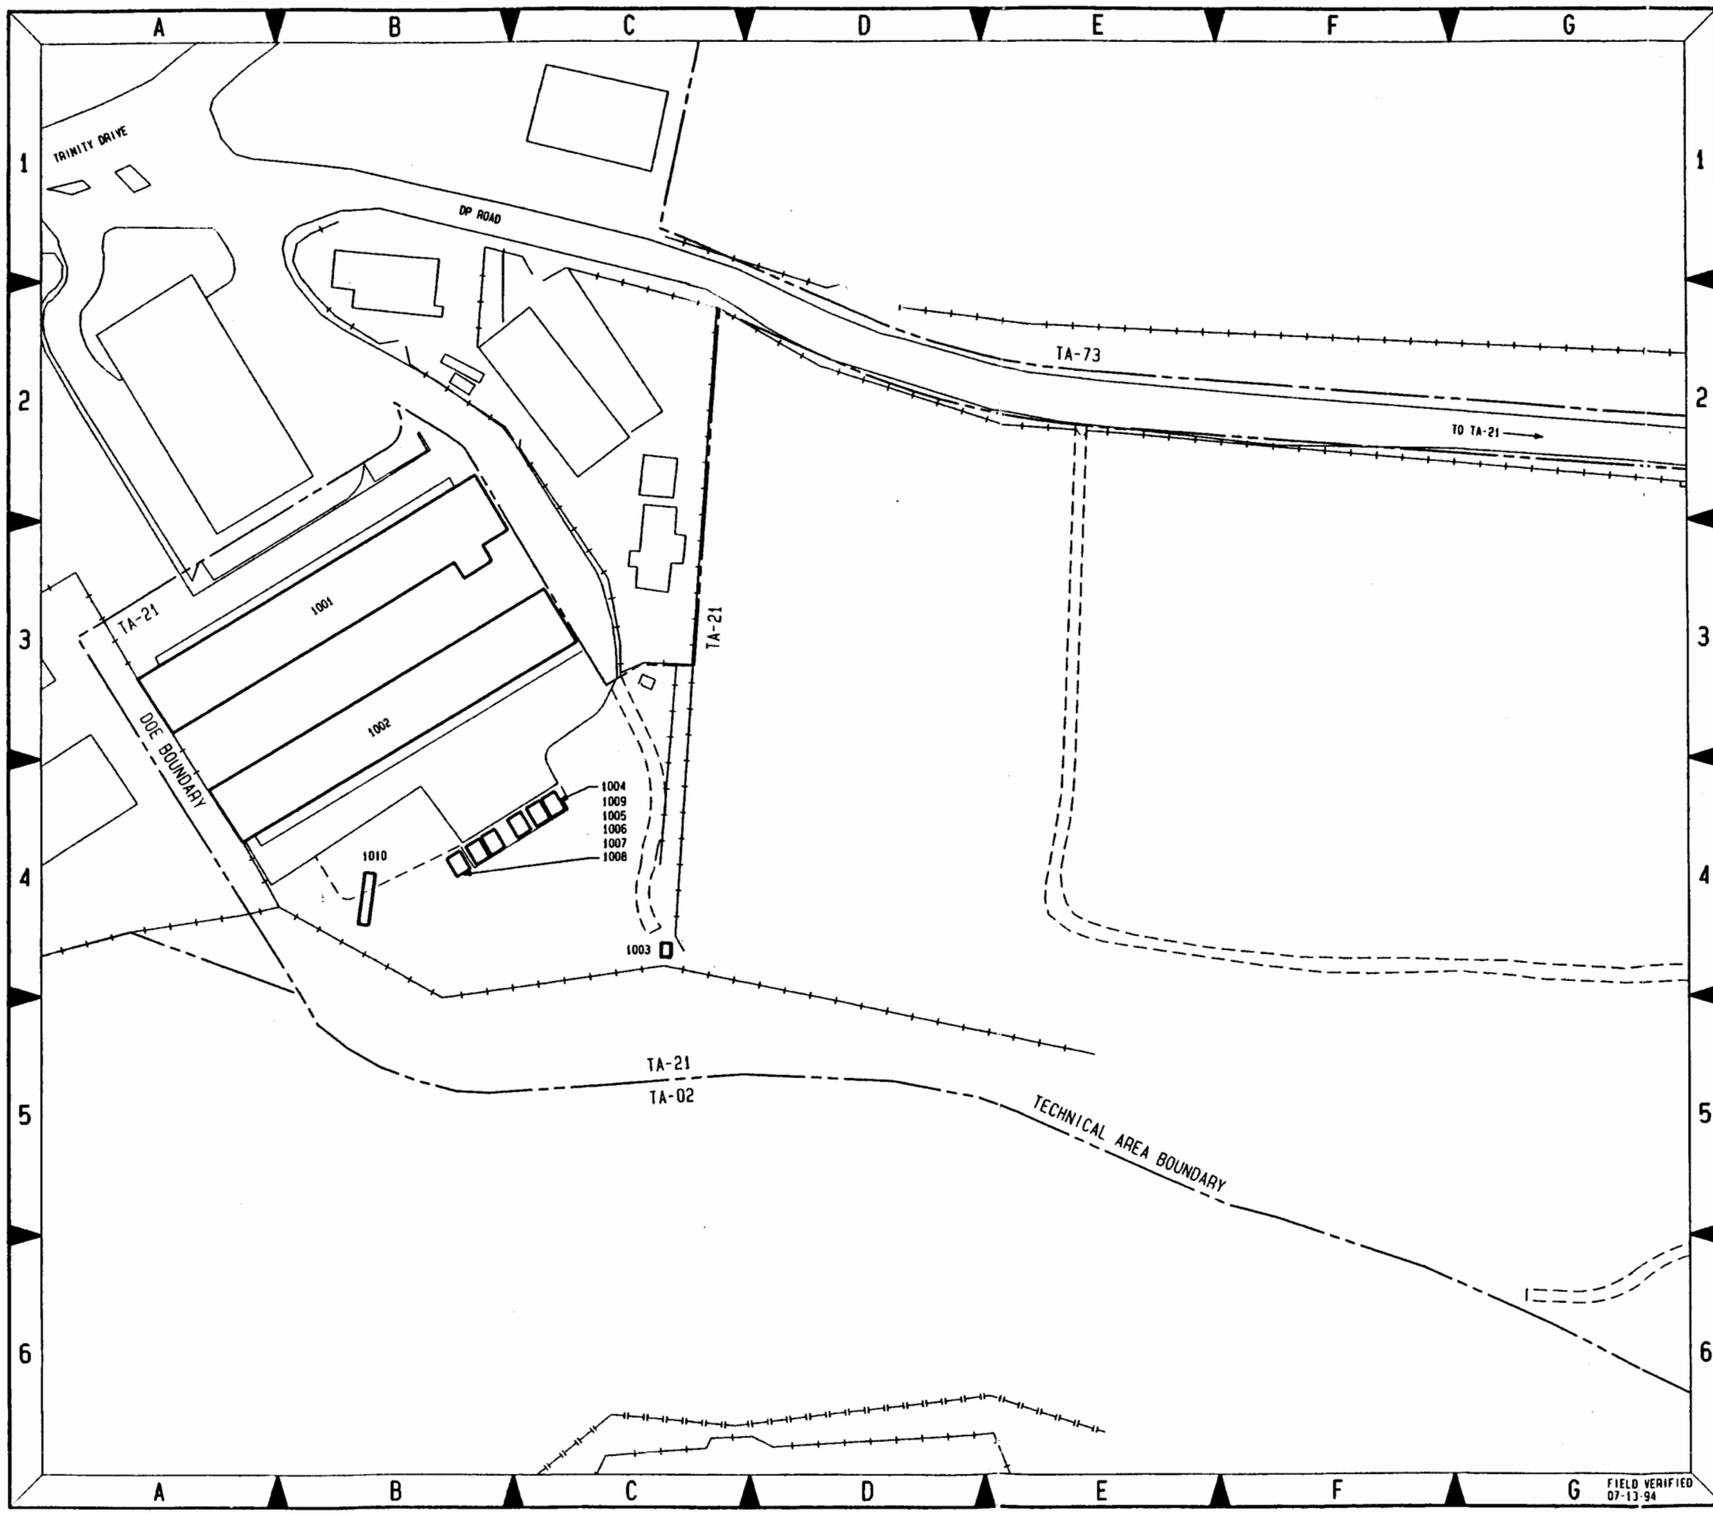

KEY MAP

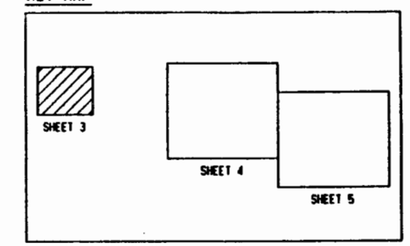

N

SCALE: 1:600

50 0 50 100

FEET

NO	DATE	CLASS REV	REVISIONS	DWN	VER	CHKD	REL	SUB	REC	APP
1	07-29-94		REVISED TO NEW STANDARDS AND TO STATUS OF 07-13-94	DMB JPM	JPM	HMS	HMS	JAF	BEC	RAP

JOHNSON CONTROLS WORLD SERVICES INC.

AS-BUILT STRUCTURE LOCATION MAPS

TA-21

DP SITE

DRAWN	J. NORK
VERIFIED	R. SENA J. NORK
CHECKED	HMS DWCS C. SANDOVAL
RELEASED	H. SALAZAR
DATE	08-23-93

SUBMITTED JERRY FORTE — RECOMMENDED BRYAN COWER — APPROVED ROBERT PROMMEL

Los Alamos — Los Alamos National Laboratory, Los Alamos, New Mexico 87545

SHEET 3 — 3 of 5

CLASSIFICATION U — REVIEWER H. SALAZAR — DATE 8-2-94

PROJECT ID 11952 — DRAWING NO AB23 — REV 1

JCI NO 91-020

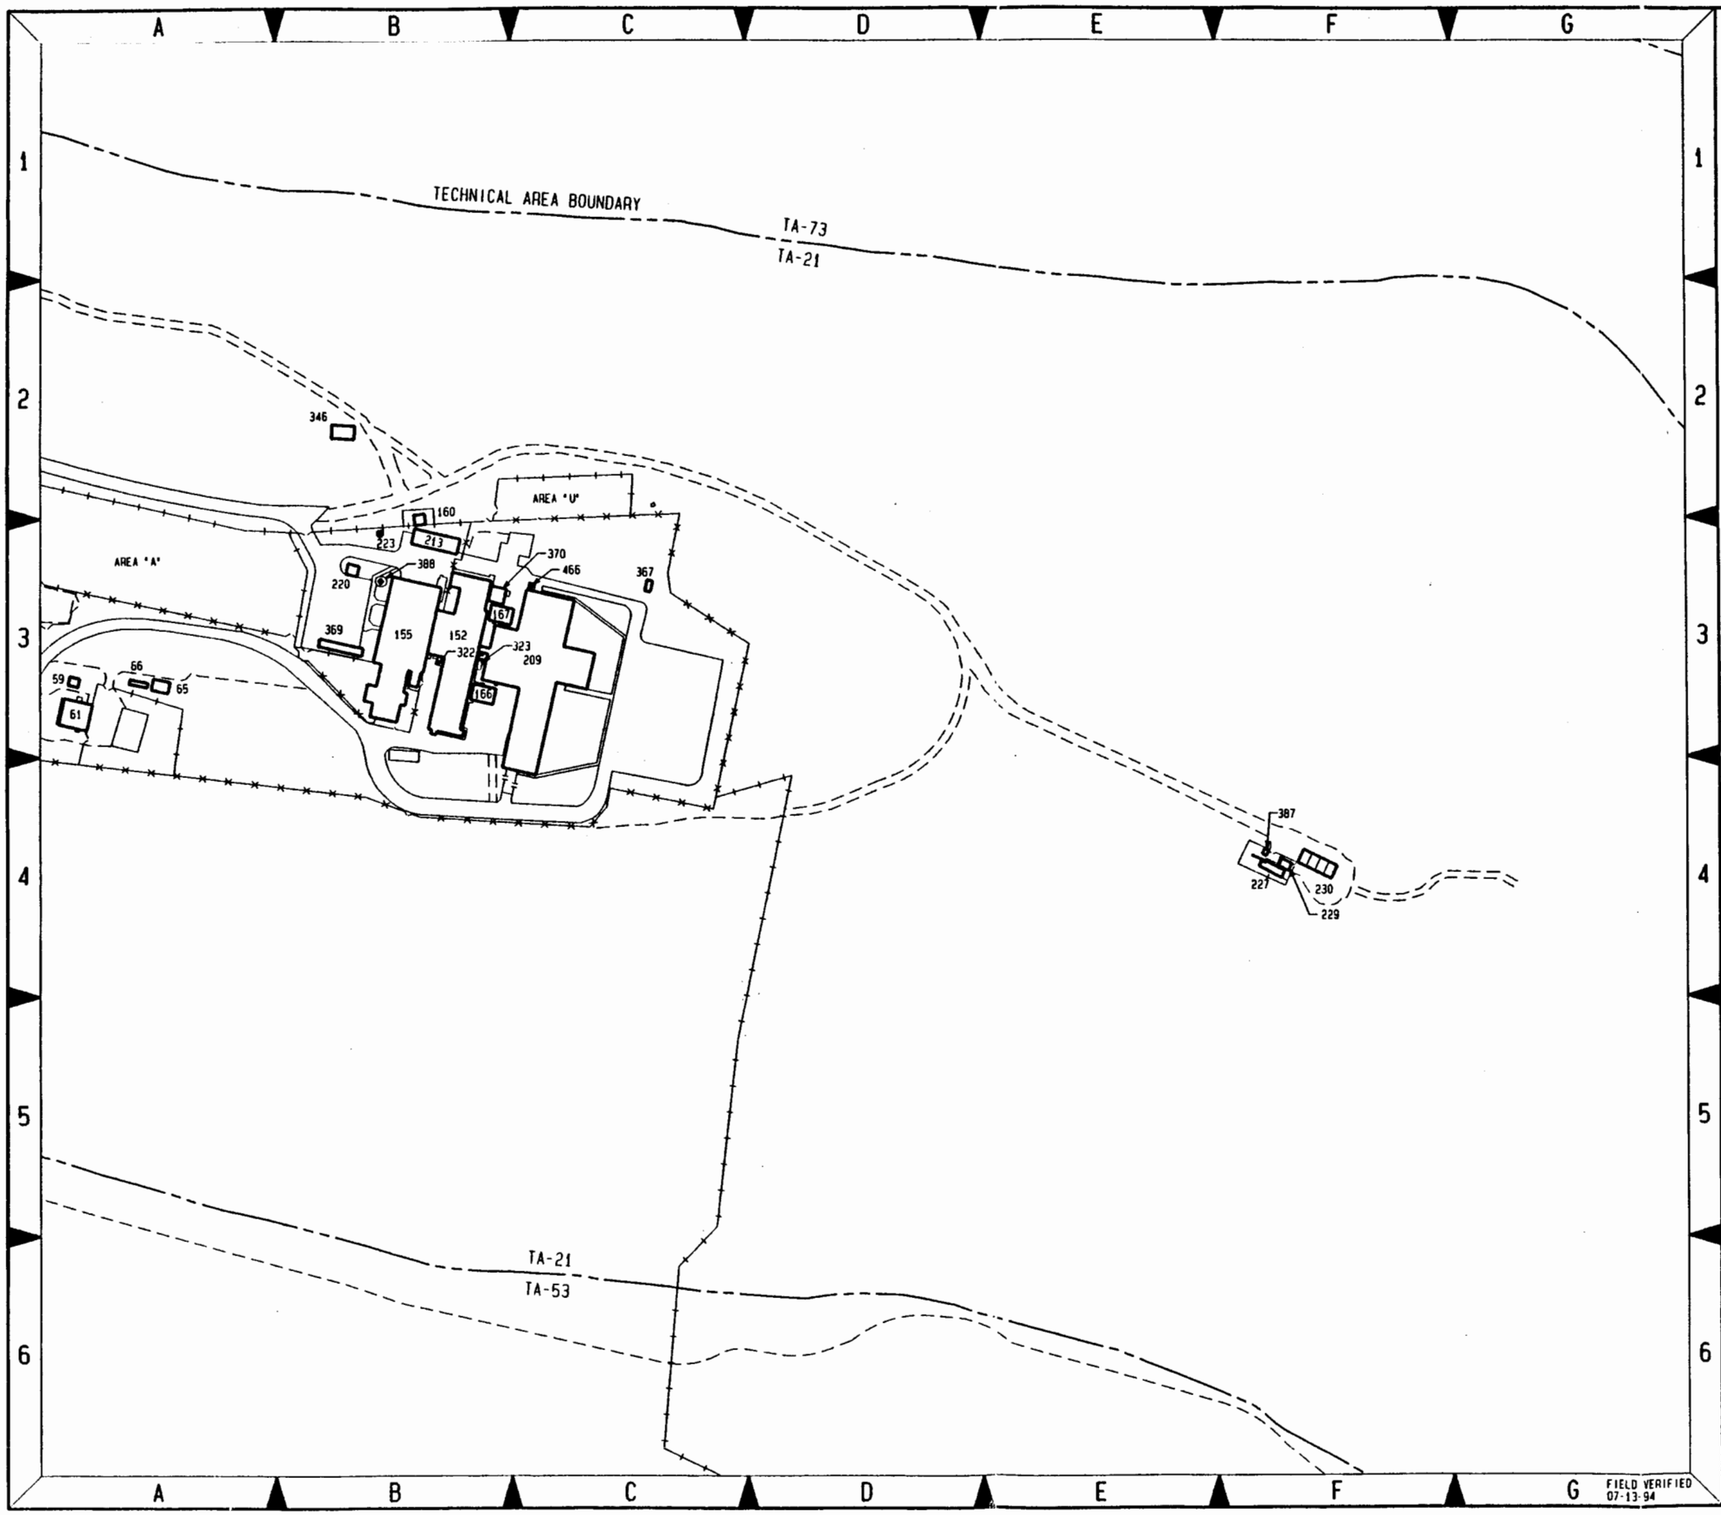

KEY MAP

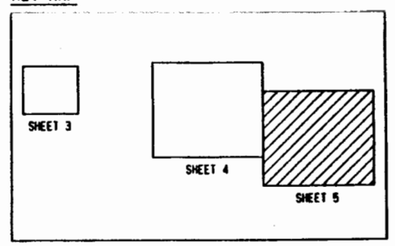

N

SCALE: 1:1200

100 0 100 200

FEET

NO	DATE	CLASS REV	REVISIONS	DWN	VER	CHKD	REL	SUB	REC	APP
1	07-29-94		REVISED TO NEW STANDARDS AND TO STATUS OF 07-13-94	DMB JPM	JPA	HNS	HNS	DAF	BEC	RAP

JOHNSON CONTROLS WORLD SERVICES INC.

AS-BUILT STRUCTURE LOCATION MAPS

TA-21

DP SITE

DRAWN	J. MORA
VERIFIED	H. SENA / J. MORA
CHECKED	C. SANDOVAL
RELEASED	H. SALAZAR
DATE	06-23-93

SUBMITTED JERRY FORTE | RECOMMENDED BRIAN COMER | APPROVED ROBERT PROMMEL

Los Alamos — Los Alamos National Laboratory, Los Alamos, New Mexico 87545

SHEET 5 OF 5

CLASSIFICATION U REVIEWER H. SALAZAR DATE 6-2-94

PROJECT ID	DRAWING NO	REV
11952	AB23	1

JCI NO 91-420

STRUCTURE LOCATION MAPS

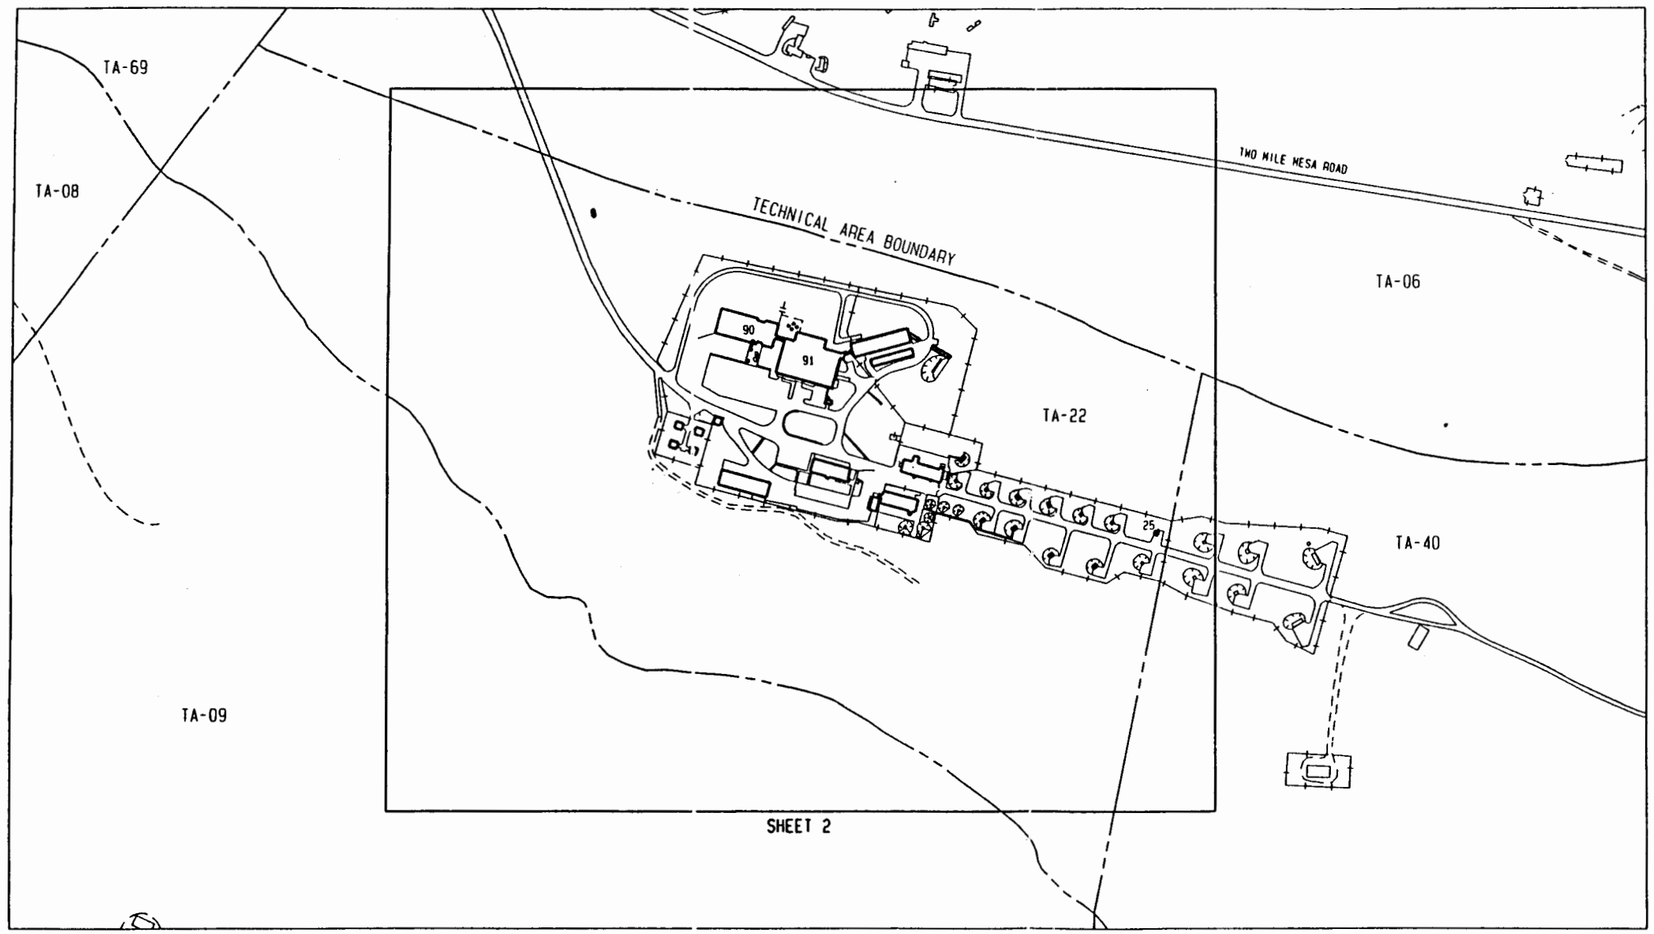

TA-22 KEY MAP

SCALE: 1:2400

200 0 200 400

FEET

N

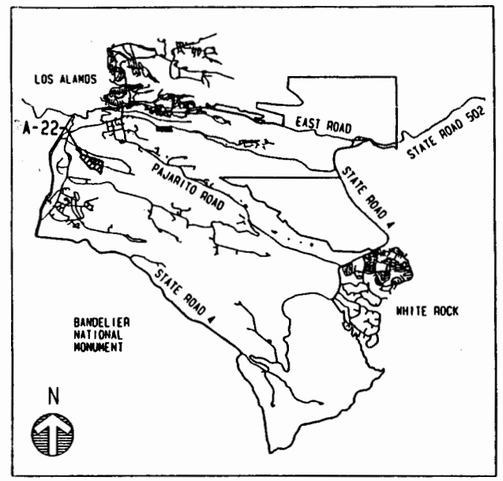

LOCATION PLAN

SCALE: NONE

NO	DATE	CLASS REV	REVISIONS	DWN	VER	CHKD	REL	SUB	REC	APP

JOHNSON CONTROLS WORLD SERVICES INC.

AS-BUILT STRUCTURE LOCATION MAPS

TA-22

TD SITE

DRAWN	J. NORK
VERIFIED	J. NORK
CHECKED	H. SALAZAR
RELEASED	H. SALAZAR
DATE	01-12-94

SUBMITTED JERRY FORTE — RECOMMENDED BRYAN COWEN — APPROVED ROBERT PROMMEL

Los Alamos — Los Alamos National Laboratory, Los Alamos, New Mexico 87545

SHEET 1 OF 2

CLASSIFICATION U — REVIEWER H. SALAZAR — DATE 1-11-94

PROJECT ID 11952 — DRAWING NO AB24 — REV

FIELD VERIFIED 12-15-93

JCI NO 91-020

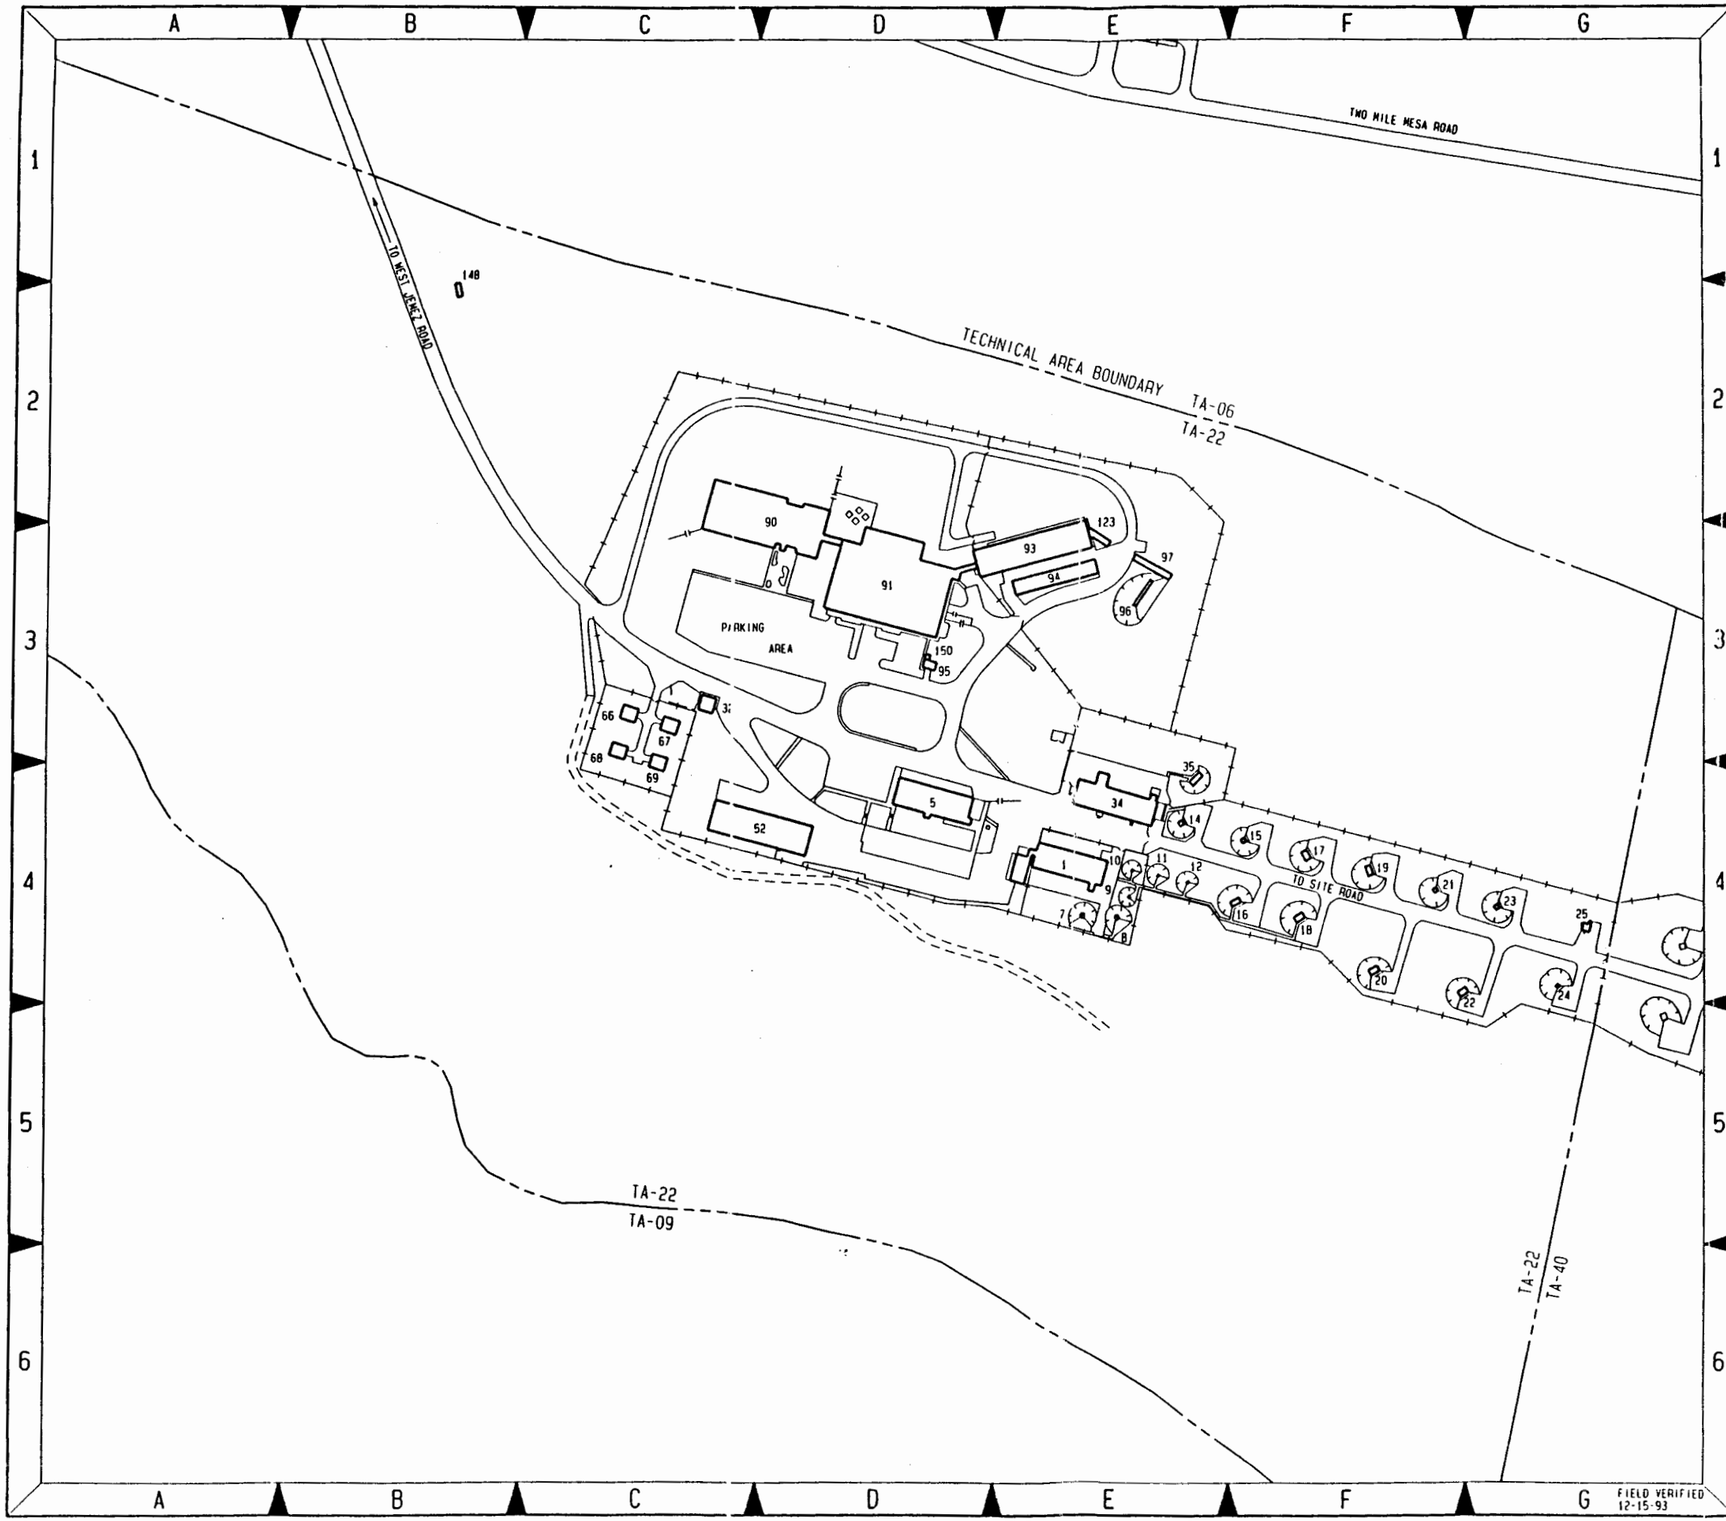

STRUCTURE LOCATION INDEX

STRUCTURE TA-NUMBER	STRUCTURE DESIGNATION	STRUCTURE NOMENCLATURE	STRUCTURE LOCATOR SHEET NO.	STRUCTURE LOCATOR MAP KEY
22-1	22-1	LOADING BUILDING	2	E-4
22-5	TD-5	WAREHOUSE & PLASTIC SHOP	2	D-4
22-7	TD-7	STORAGE MAGAZINE	2	E-4
22-8	TD-8	PROCESS BUILDING	2	E-4
22-9	TD-9	MAGAZINE	2	E-4
22-10	TD-10	MAGAZINE	2	E-4
22-11	TD-11	MAGAZINE	2	E-4
22-12	TD-12	MAGAZINE	2	E-4
22-14	TD-14	MAGAZINE	2	E-4
22-15	TD-15	STORAGE MAGAZINE	2	F-4
22-16	TD-16	MAGAZINE	2	F-4
22-17	TD-17	MAGAZINE	2	F-4
22-18	TD-18	MAGAZINE	2	F-4
22-19	TD-19	MAGAZINE	2	F-4
22-20	TD-20	MAGAZINE	2	F-4
22-21	TD-21	MAGAZINE	2	F-4
22-22	TD-22	MAGAZINE	2	F-4
22-23	TD-23	MAGAZINE	2	G-4
22-24	TD-24	MAGAZINE	2	G-4
22-25	TD-25	PROCESS BUILDING	2	G-4
22-32	TD-32	GUARD HOUSE	2	C-3
22-34	TD-34	LABORATORY BUILDING	2	E-4
22-35	TD-35	MAGAZINE	2	E-4
22-52	TD-52	SHOP BUILDING	2	D-4
22-66	TD-66	STORAGE BUILDING	2	C-3
22-67	TD-67	STORAGE BUILDING	2	C-3
22-68	TD-68	STORAGE BUILDING	2	C-3
22-69	TD-69	STORAGE BUILDING	2	C-4
22-90	TD-90	OFFICE BUILDING	2	D-3
22-91	TD-91	DETONATOR FACILITY	2	D-3
22-93	22-93	HIGH EXPLOSIVE WING	2	E-3
22-94	22-94	BUNKER	2	E-3
22-95	TD-95	SOLVENT STORAGE SHED	2	D-3
22-96	22-96	DAY MAGAZINE	2	E-3
22-97	22-97	COVERED WALKWAY	2	E-3
22-123	22-123	COVERED WALKWAY	2	E-3
22-148	22-148	TRANSPORTAINER	2	B-2
22-150	22-150	CHEMICAL STORAGE	2	D-3

N

SCALE: 1:1200

100 0 100 200

FEET

NO	DATE	CLASS REV	REVISIONS	DWN	VER	CHKD	REL	SUB	REC	APP

JOHNSON CONTROLS WORLD SERVICES INC.

AS-BUILT STRUCTURE LOCATION MAPS

TA-22

TD SITE

DRAWN	J. WORK
VERIFIED	J. WORK
CHECKED	H. SALAZAR
RELEASED	H. SALAZAR
DATE	01-12-94

SUBMITTED JERRY FORTE — RECOMMENDED BRYAN COMER — APPROVED ROBERT PROMMEL

Los Alamos — Los Alamos National Laboratory, Los Alamos, New Mexico 87545

SHEET 2 OF 2

CLASSIFICATION U — REVIEWER H. SALAZAR — DATE 1-11-94

PROJECT ID 11952 — DRAWING NO AB24 — REV

TA-28

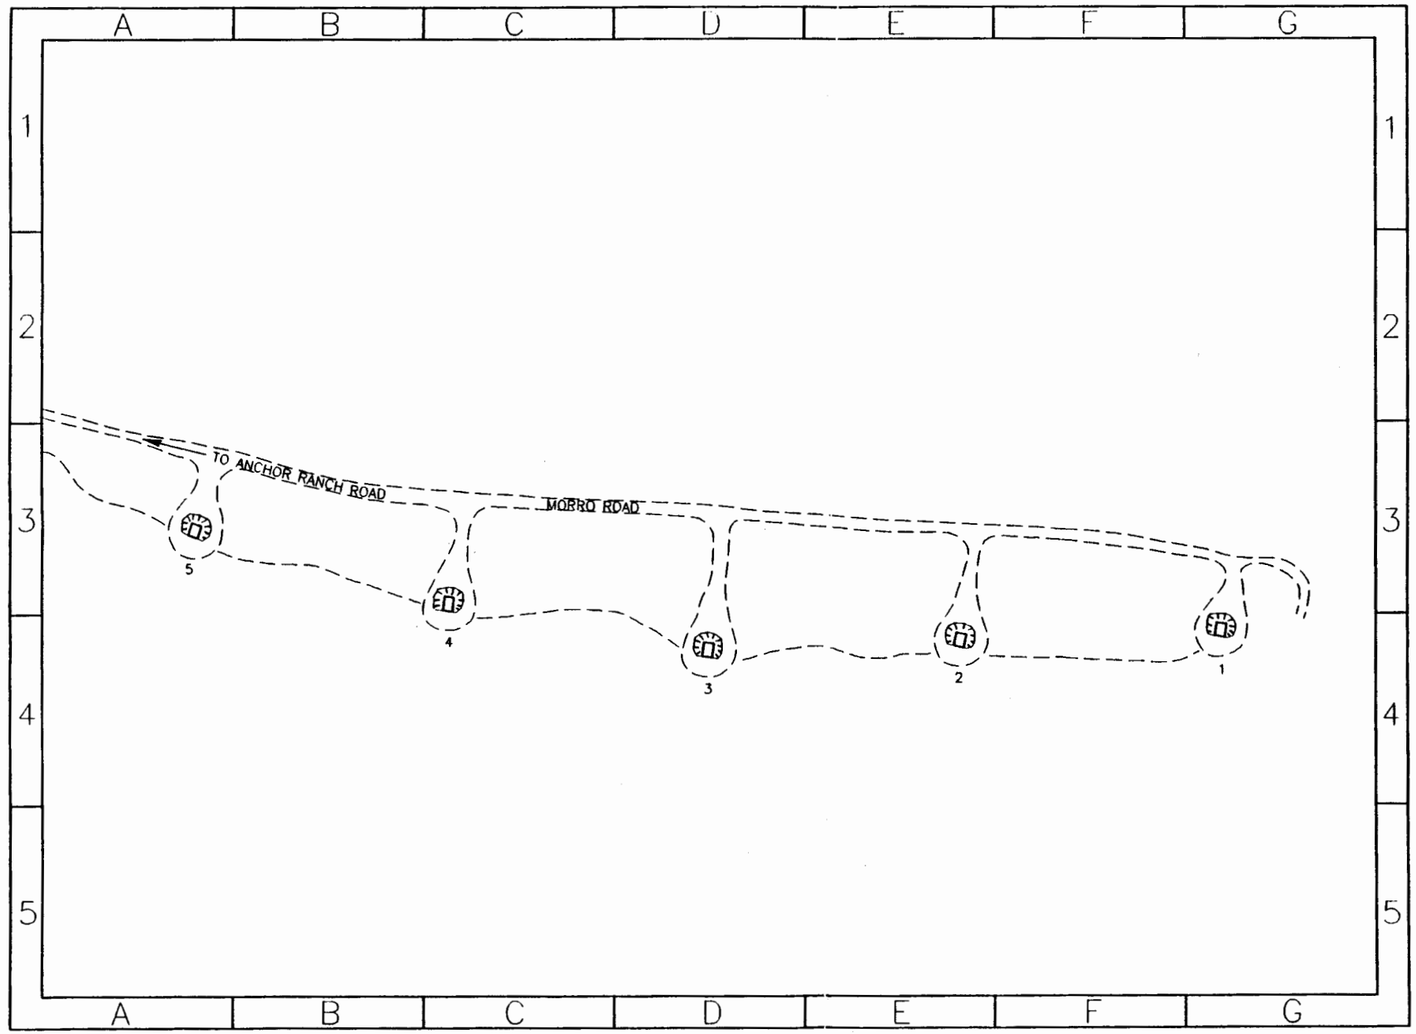

STRUCTURE NUMBER INDEX

STRUCTURE TA-NUMBER	STRUCTURE DESIGNATION	STRUCTURE NOMENCLATURE	STRUCTURE LOCATOR SHEET NO.	STRUCTURE LOCATOR MAP KEY
28- 1	MAA -1	MAGAZINE	1	G-4
28- 2	MAA -2	MAGAZINE	1	E-4
28- 3	MAA -3	MAGAZINE	1	D-4
28- 4	MAA -4	MAGAZINE	1	C-3
28- 5	MAA -5	MAGAZINE	1	A-3

N

SCALE 1: 1200

100 0 100 200 FEET

NO.	DATE	CLASS REV.	REVISIONS	DWN	DES	CKD	REL	SUB	REC	APP

FACILITIES ENGINEERING DIVISION

STRUCTURE LOCATION MAP
TA-28
MAGAZINE AREA-A

BLDG.

DRAWN	C.SANDOVAL
DESIGN	
CHECKED	B. COMER
RELEASED	B. COMER
DATE	03-06-91

SUBMITTED RECOMMENDED APPROVED

LOS ALAMOS — LOS ALAMOS NATIONAL LABORATORY, LOS ALAMOS, NEW MEXICO 87545

SHEET 1 OF 1

CLASSIFICATION U REVIEWER DATE 4-15-91

LAB JOB NO.

DRAWING NO. ENG-R 5115

REV. 15

AUTOGIS

TA-33

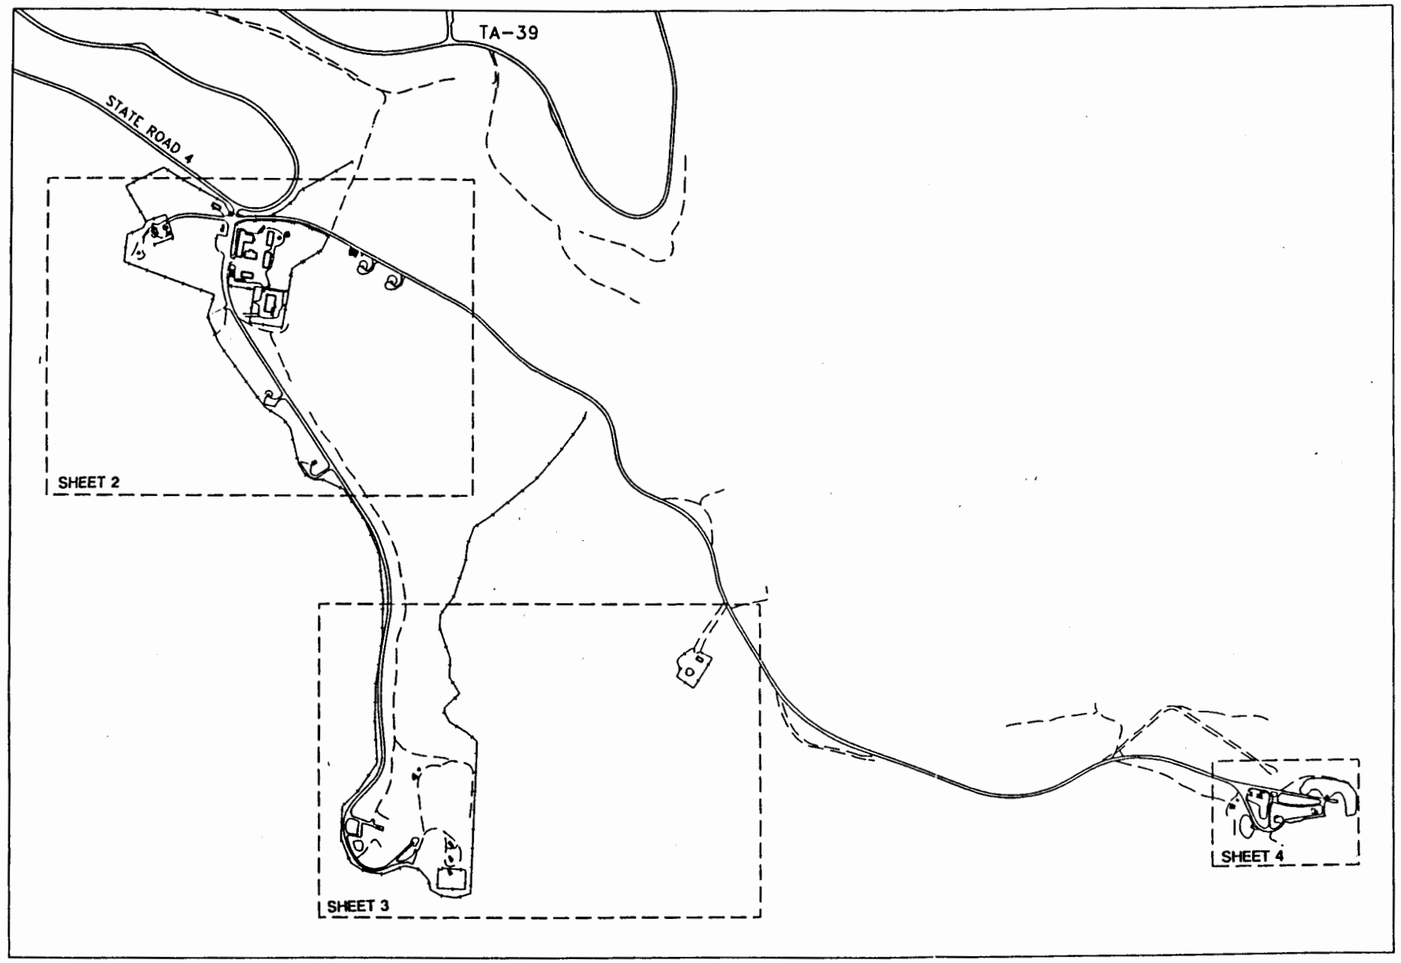

STRUCTURE NUMBER INDEX

STRUCTURE TA-NUMBER	STRUCTURE DESIGNATION	STRUCTURE NOMENCLATURE	STRUCTURE LOCATOR SHEET NO.	STRUCTURE LOCATOR MAP KEY
33-1	HP-1	LABORATORY	2	B-1
33-2	HP-2	WAREHOUSE	2	B-1
33-16	HP-16	GHE BUILDING	2	B-2
33-19	HP-19	LABORATORY & OFFICE BLDG.	2	B-2
33-20	HP-20	WAREHOUSE	2	B-4
33-22	HP-22	MAGAZINE	2	E-5
33-23	HP-23	TRIM BUILDING	3	A-4
33-24	HP-24	CONTROL BUILDING	3	A-4
33-25	HP-25	GHE BUILDING	3	B-4
33-26	HP-26	X-DIFT CHAMBER	2	C-1
33-27	HP-27	GUARD STATION	2	C-1
33-28	HP-28	WATER TANK	3	C-5
33-29	HP-29	U.G. CHAMBER #3	2	E-2
33-36	HP-36	MAGAZINE	2	F-2
33-37	HP-37	MACHINE SHOP	2	D-2
33-39	HP-39	SAW BUILDING	2	D-1
33-40	HP-40	U.G. CHAMBER #4	3	C-4
33-70	HP-70	U.G. CHAMBER #5	3	C-4
33-71	HP-71	LABORATORY BUILDING	2	D-2
33-86	HP-86	CONTROL BUILDING	4	B-2
33-87	HP-87	CABLE BUILDING	4	F-2
33-88	HP-88	X-DIFT VAULT	4	B-4
33-89	HP-89	GUARD HOUSE	2	D-2
33-90	HP-90	HOSE HOUSE	2	D-2
33-91	HP-91	TRANSFORMER VAULT	4	C-2
33-95	HP-95	HOT MACHINE SHOP	2	D-1
33-111	HP-111	LABORATORY & OFFICE BLDG.	2	D-1
33-114	HP-114	TEST CELL	2	D-2
33-129	HP-129	BUNKER	4	E-3
33-151	HP-151	TRANSPORTABLE OFFICE BLDG.	2	C-1
33-168	HP-168	TRAILER, OFFICE	3	B-3
33-173	HP-173	VLBA ANTENNA	3	F-2
33-175	HP-175	TRAILER, LABORATORY	4	E-2
33-177	33-177	CONTROL BUILDING	1	G-1
33-178	HP-178	TRANSMITTER ANTENNA BLDG.	2	B-2
33-192	33-192	TRAILER, LABORATORY	4	C-2
33-196	33-196	TRANSPORTAINER	2	B-2
33-199	33-199	PUMP HOUSE	2	C-1
33-200	33-200	TRANSPORTAINER	3	B-3
33-201	33-201	ANTENNA	1	B-3
33-203	33-203	GUARD HOUSE	2	C-2
33-204	33-204	CONCRETE BLOCK BLDG.	4	A-3
33-208	33-208	TRAILER	4	A-3
33-209	33-209	TRAILER, STORAGE	2	E-2
33-211	33-211	TRAILER, STORAGE	2	E-2
33-212	33-212	TRAILER, STORAGE	2	E-2
33-213	33-213	TRAILER, STORAGE	2	E-2
33-214	33-214	TRAILER, STORAGE	2	E-2
33-215	33-215	TRAILER, STORAGE	2	D-2
33-216	33-216	TRANSPORTAINER	2	C-1
33-217	33-217	SHED	2	D-1
33-228	33-228	TRAILER, STORAGE	3	B-1
33-229	33-229	TRAILER, STORAGE	2	D-2
33-231	33-231	TRANSPORTAINER	2	D-2
33-232	33-232	TRANSPORTAINER	2	D-2
33-233	33-233	TRANSPORTAINER	2	D-2
33-234	33-234	TRANSPORTAINER	2	D-2
33-255	33-255	STORAGE	4	B-1
33-266	33-266	TRAILER, STORAGE	2	D-1
33-267	33-267	TRANSPORTAINER	1	G-1
33-268	33-268	TRANSPORTAINER		

SCALE 1: 5420

450 0 450 900 FEET

N

LATEST DISTRIBUTION
31AUG94
EMERGENCY RESPONSE MAP
UPDATED DRAWING

NO.	DATE	CLASS REV.	REVISIONS	DWN	DES	CKD	REL	SUB	REC	APP

FACILITIES ENGINEERING DIVISION

STRUCTURE LOCATION MAP
TA-33
HP-SITE

BLDG.

DRAWN	C.SANDOVAL
DESIGN	
CHECKED	B. COMER
RELEASED	B. COMER
DATE	03-12-91

SUBMITTED RECOMMENDED APPROVED

LOS ALAMOS LOS ALAMOS NATIONAL LABORATORY LOS ALAMOS, NEW MEXICO 87545

SHEET 1 OF 4

CLASSIFICATION U REVIEWER DATE 4-15-91

LAB JOB NO. DRAWING NO. ENG-R 5116 REV. 24

AUTOGIS

TA-33

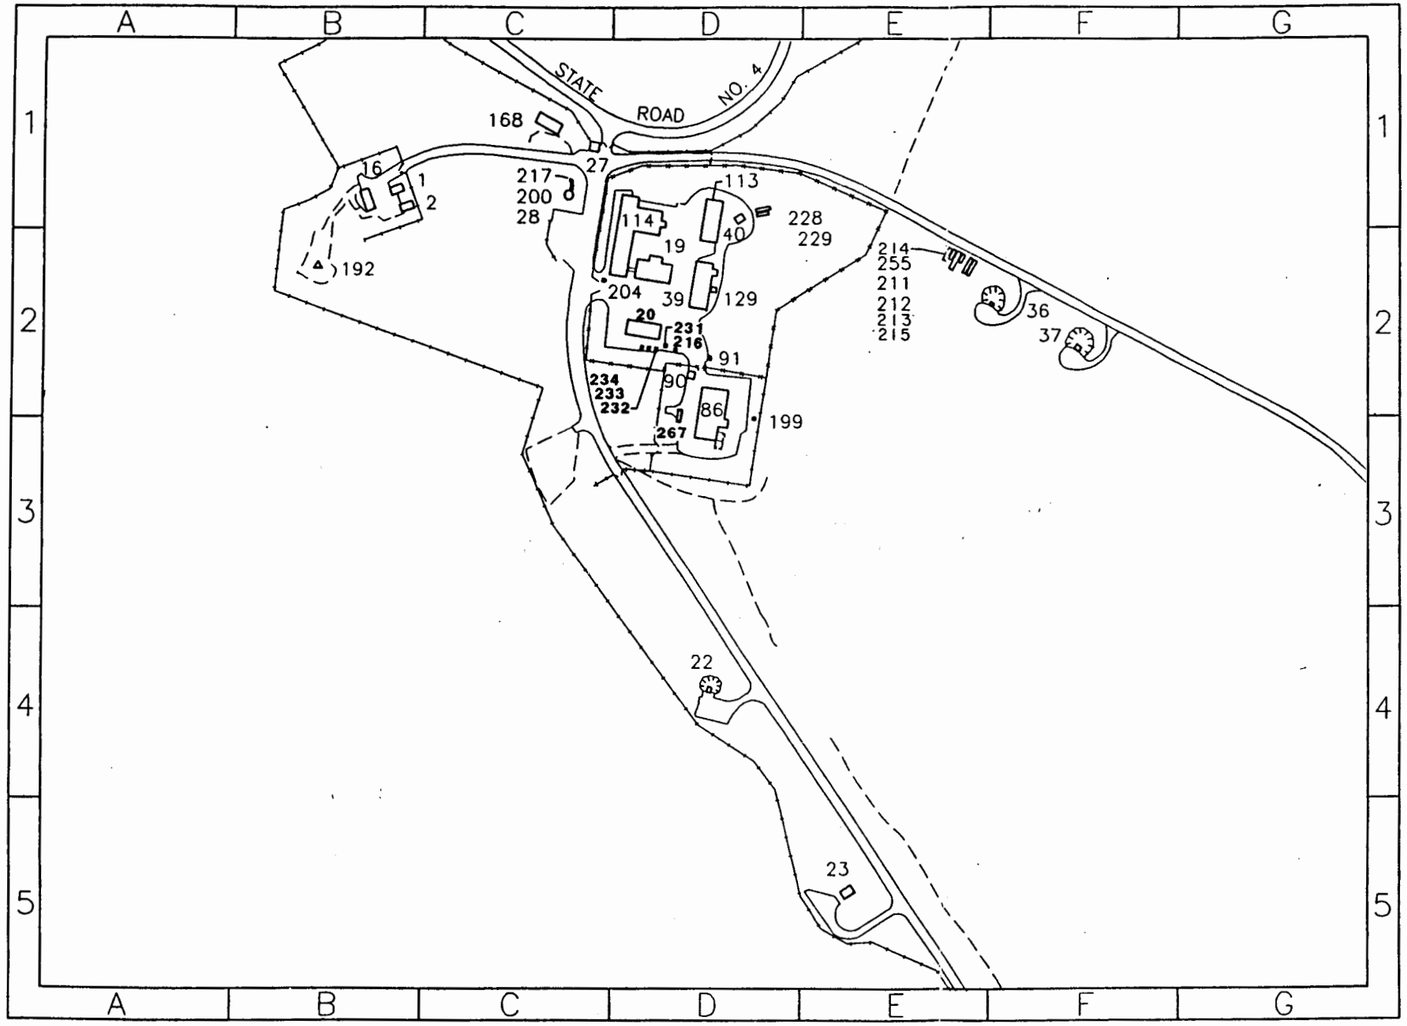

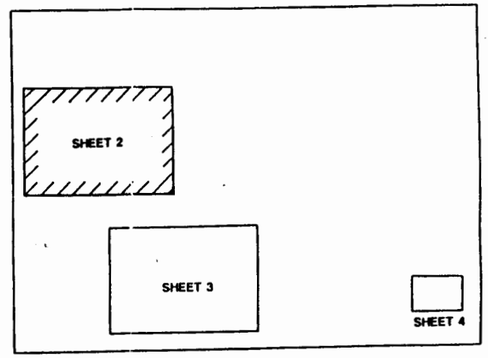

TA-33 MAP GUIDE

SCALE 1: 1800

150 0 150 300 FEET

N

LATEST DISTRIBUTION
31AUG94
EMERGENCY RESPONSE MAP
UPDATED DRAWING

NO.	DATE	CLASS REV.	REVISIONS	DWN	DES	CKD	REL	SUB	REC	APP

FACILITIES ENGINEERING DIVISION

STRUCTURE LOCATION MAP
TA-33
HP-SITE

DRAWN	C.SANDOVAL
DESIGN	
CHECKED	B. COMER
RELEASED	B. COMER
DATE	03-12-91

BLDG.

SUBMITTED RECOMMENDED APPROVED

LOS ALAMOS — LOS ALAMOS NATIONAL LABORATORY, LOS ALAMOS, NEW MEXICO 87545

SHEET 2 OF 4

CLASSIFICATION U REVIEWER DATE

LAB JOB NO.

DRAWING NO. ENG-R 5116

REV. 24

AUTOGIS

TA-33

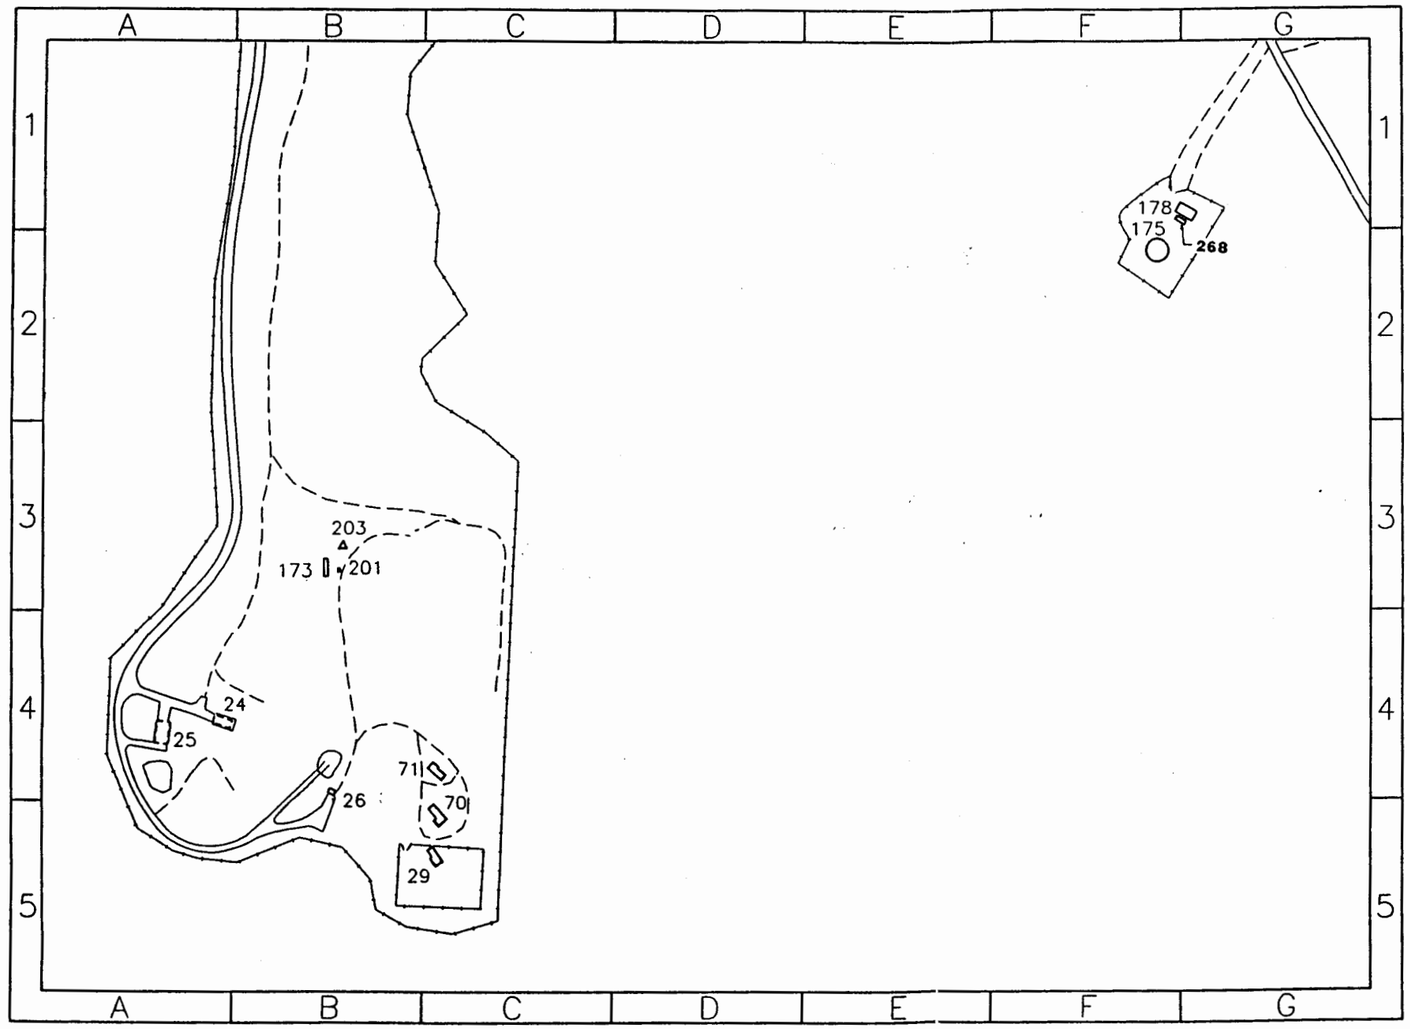

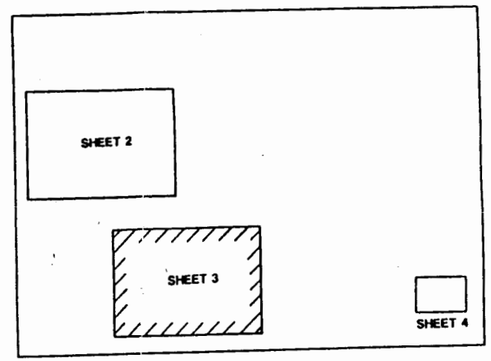

TA-33 MAP GUIDE

SCALE 1: 1800

150 0 150 300 FEET

N

LATEST DISTRIBUTION
31AUG94

EMERGENCY RESPONSE MAP
UPDATED DRAWING

NO.	DATE	CLASS REV.	REVISIONS	DWN	DES	CKD	REL	SUB	REC	APP

FACILITIES ENGINEERING DIVISION

STRUCTURE LOCATION MAP
TA-33
HP-SITE

DRAWN	C.SANDOVAL
DESIGN	
CHECKED	B. COMER
RELEASED	B. COMER
DATE	03-12-91

BLDG.

SUBMITTED: RECOMMENDED: APPROVED:

LOS ALAMOS — LOS ALAMOS NATIONAL LABORATORY, LOS ALAMOS, NEW MEXICO 87545

SHEET 3 OF 4

CLASSIFICATION U REVIEWER DATE

LAB JOB NO.

DRAWING NO. ENG-R 5116

REV. 24

AUTOGIS

TA-33

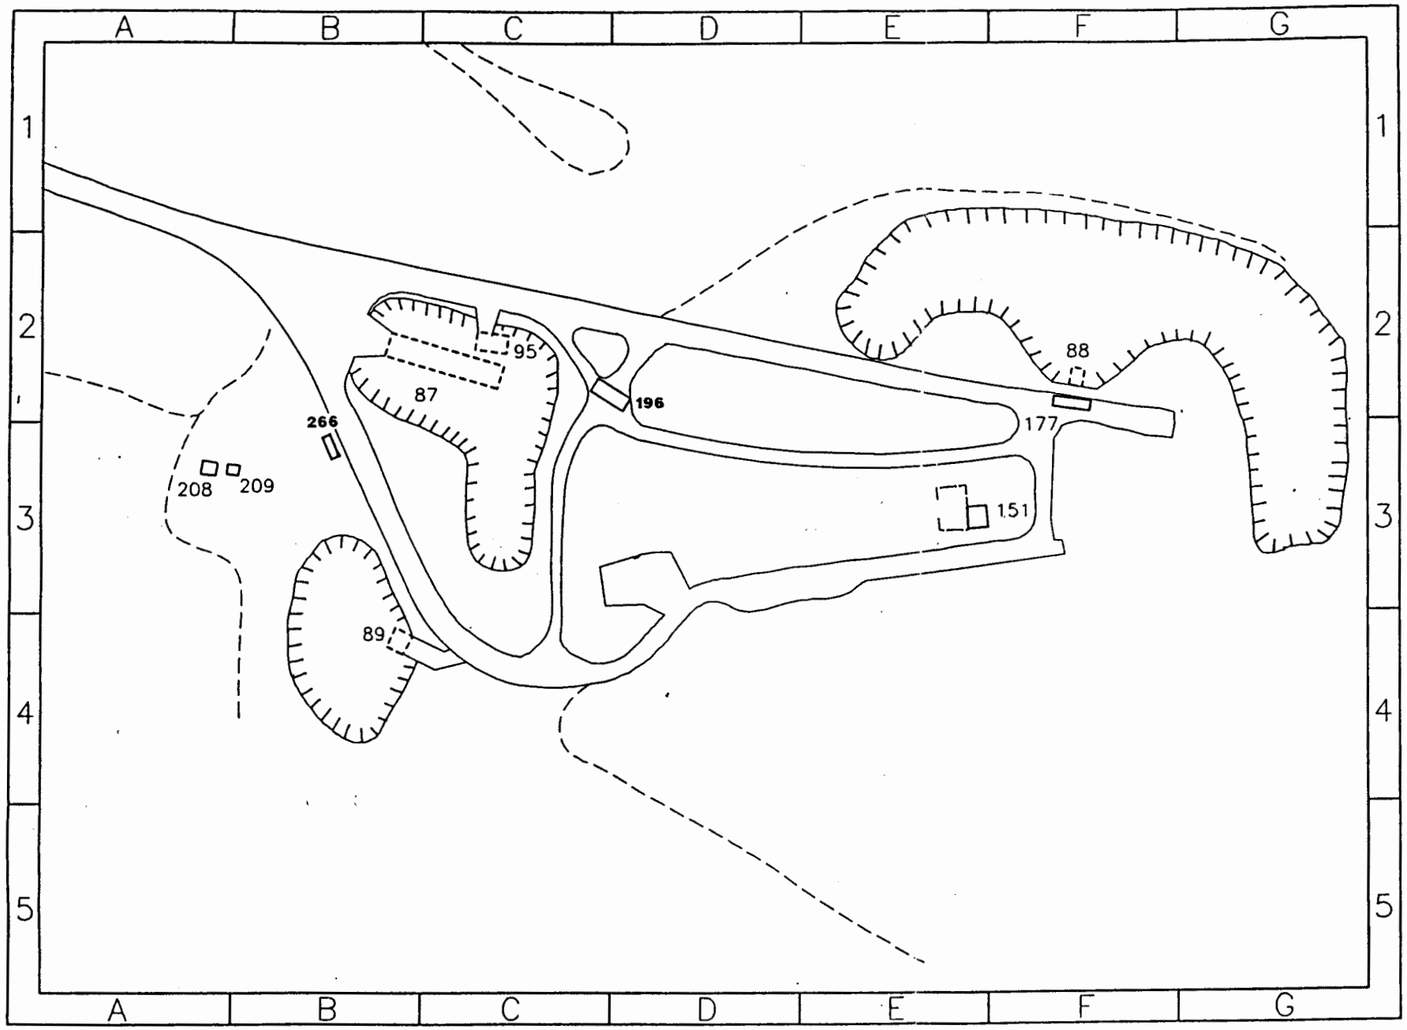

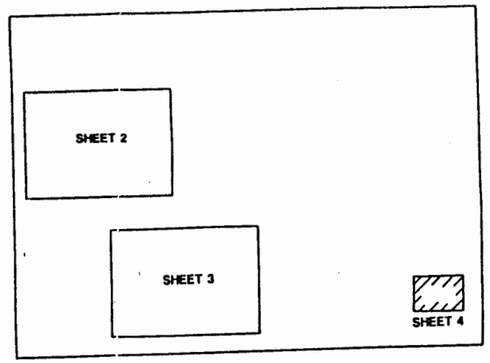

TA-33 MAP GUIDE

SCALE 1: 600

50 0 50 100 FEET

N

LATEST DISTRIBUTION
31AUG94
EMERGENCY RESPONSE MAP
UPDATED DRAWING

AUTOGIS

NO.	DATE	CLASS REV.	REVISIONS	DWN	DES	CKD	REL	SUB	REC	APP

FACILITIES ENGINEERING DIVISION

STRUCTURE LOCATION MAP
TA-33
HP-SITE

DRAWN	C.SANDOVAL
DESIGN	
CHECKED	B. COMER
RELEASED	B. COMER
DATE	03-12-91

BLDG

SUBMITTED RECOMMENDED APPROVED

LOS ALAMOS — LOS ALAMOS NATIONAL LABORATORY, LOS ALAMOS, NEW MEXICO 87545

SHEET 4 OF 4

CLASSIFICATION REVIEWER DATE

LAB JOB NO.

DRAWING NO. ENG-R 5116

REV 24

STRUCTURE LOCATION MAPS

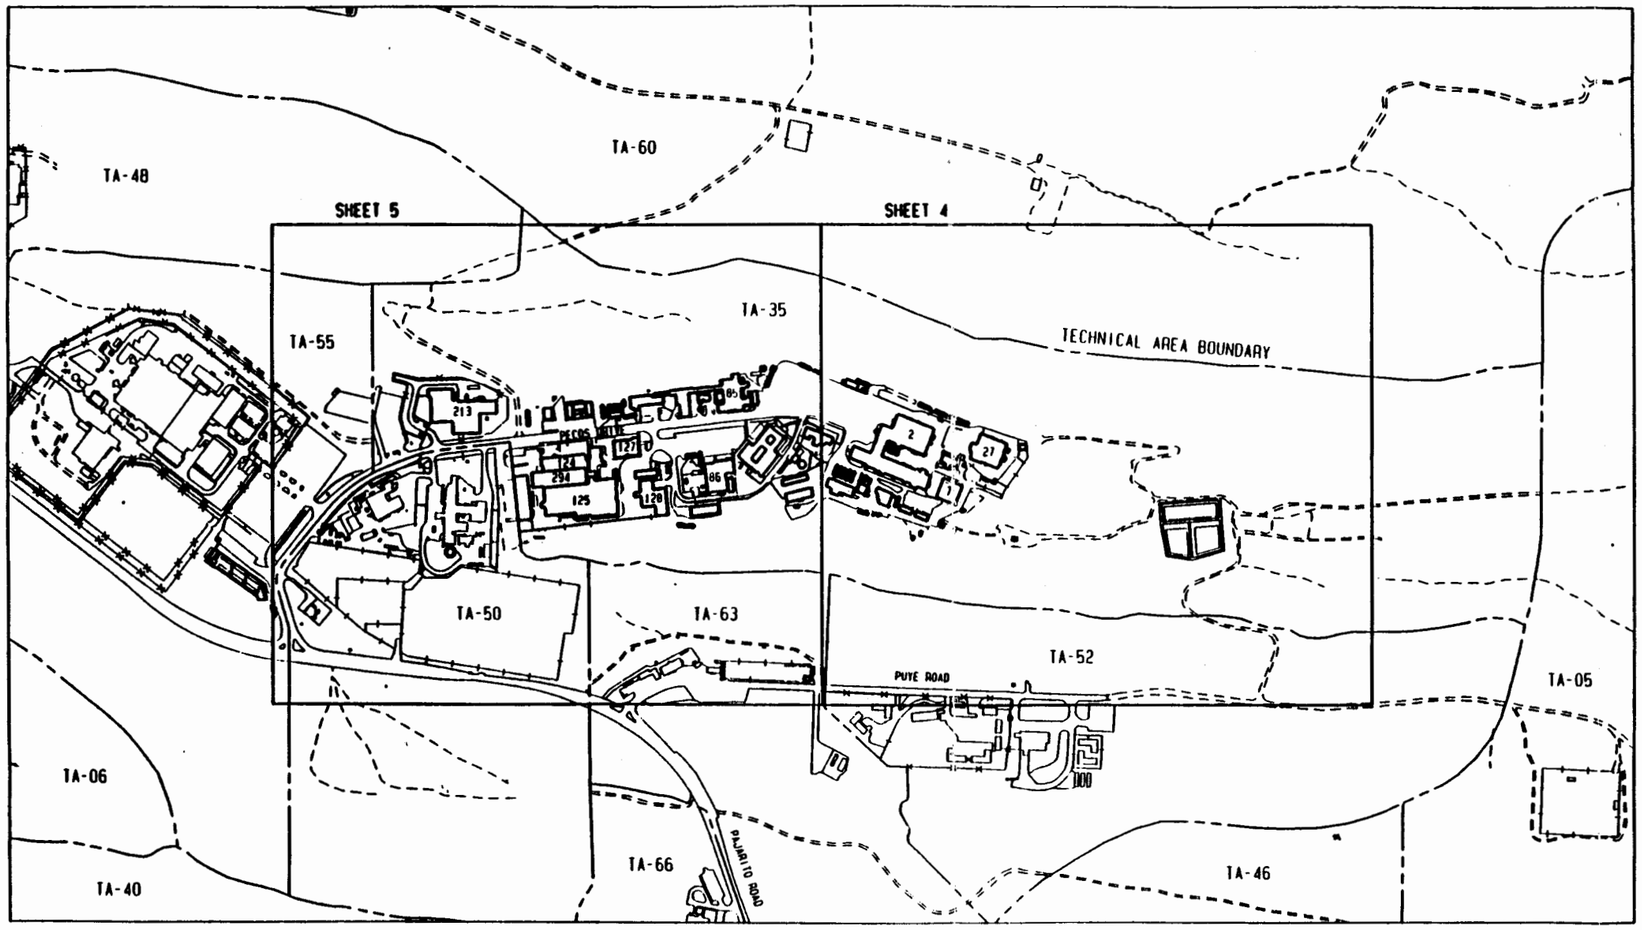

TA-35 KEY MAP

SCALE 1:3600

300 0 300 600

FEET

N

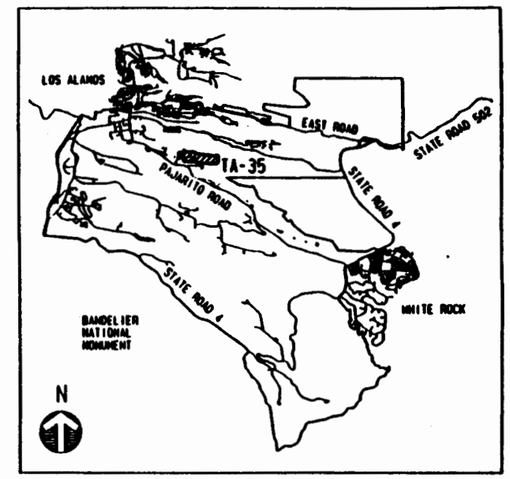

LOCATION PLAN

SCALE: NONE

NO	DATE	CLASS REV	REVISIONS	DWN	VER	CHKD	REL	SUB	REC	APP
1	05-16-94		REVISED TO NEW STANDARDS	HNS	DPM	JPM	HNS	JAF	MEC	RAP

JOHNSON CONTROLS WORLD SERVICES INC.

AS-BUILT STRUCTURE LOCATION MAPS

TA-35

TEN SITE

DRAWN	J. [illegible]
VERIFIED	J. [illegible]
CHECKED	H. SALAZAR
RELEASED	H. SALAZAR
DATE	06-03-93

SUBMITTED JERRY FORTE

RECOMMENDED BRIAN COHEN

APPROVED PUBENT PROBEL

Los Alamos — Los Alamos National Laboratory, Los Alamos, New Mexico 87545

SHEET 1 of 4

CLASSIFICATION U — REVIEWER H. SALAZAR — DATE 6-11-94

PROJECT ID 11952 — DRAWING NO AB27 — REV 1

STRUCTURE LOCATION INDEX

TA-NUMBER	STRUCTURE DESIGNATION	STRUCTURE NOMENCLATURE	STRUCTURE LOCATOR SHEET NO.	STRUCTURE LOCATOR MAP KEY
35-1	TSL-1	GUARD HOUSE	4	A-3
35-2	TSL-2	LABORATORY & OFFICE BLDG.	4	A-3
35-7	TSL-7	AIR FILTER BUILDING	4	B-4
35-25	TSL-25	MACHINE SHOP	4	A-4
35-27	TSL-27	NUCLEAR SAFEGUARDS LAB	4	C-3
35-29	TSL-29	ZEBRA BUILDING	4	B-3
35-33	TSL-33	COOLING TOWER	4	C-3
35-34	TSL-34	BETA DECAY BUILDING	4	A-4
35-46	TSL-46	LABORATORY & OFFICE BLDG.	4	A-4
35-53	TSL-53	SUBSTATION	4	C-4
35-66	TSL-66	SWITCHGEAR STATION	4	A-3
35-67	TSL-67	SUPPORT BUILDING	3	G-4
35-68	TSL-68	OFFICE BUILDING	3	G-3
35-85	TSL-85	MERCURY LASER FACILITY	3	F-3
35-86	TSL-86	LABORATORY & OFFICE BLDG.	3	F-4
35-87	TSL-87	LABORATORY & OFFICE BLDG.	3	G-3
35-88	TSL-88	PUMP HOUSE	3	G-3
35-100	TSL-100	SUBSTATION	3	F-4
35-110	TSL-110	TRANSPORTABLE OFFICE BLDG.	4	B-4
35-114	TSL-114	TRANSPORTABLE OFFICE BLDG.	4	B-4
35-115	TSL-115	SOLVENT STORAGE SHED	4	B-3
35-124	TSL-124	ANTERES TARGET HALL	3	D-3
35-125	TSL-125	LASER BUILDING	3	D-4
35-126	TSL-126	MECHANICAL BLDG.	3	E-3
35-127	TSL-127	OFFICE BUILDING	3	E-3
35-128	TSL-128	PHYSICS/LASER LAB	3	E-4
35-129	TSL-129	WATER STORAGE TANK	3	G-3
35-170	35-170	LIQUID NITROGEN TANK	3	D-4
35-186	TSL-186	MODULAR OFFICE BUILDING	3	G-4
35-188	TSL-188	HIGH VOLTAGE DEV. LAB.	3	F-3
35-189	TSL-189	OPTICS EVALUATION LAB	3	E-3
35-205	TSL-205	SUBSTATION	3	E-4
35-207	TSL-207	EXPERIMENTAL SUPPORT LAB	3	F-4
35-213	TSL-213	TARGET FABRICATION BLDG.	3	C-3
35-218	TSL-218	GUARD STATION #413	3	B-3
35-223	TSL-223	TRAILER, OFFICE	4	A-4
35-224	TSL-224	TRAILER, OFFICE	4	A-4
35-225	TSL-225	TRAILER, OFFICE	3	E-3
35-226	TSL-226	TRAILER, OFFICE	4	A-4
35-227	TSL-227	TRAILER, OFFICE	4	A-4
35-228	TSL-228	TRAILER, OFFICE	4	A-4
35-229	TSL-229	TRAILER, OFFICE	4	A-4
35-232	TSL-232	TRAILER, OFFICE	4	A-4
35-233	TSL-233	TRAILER, OFFICE	4	A-3
35-234	TSL-234	TRAILER, OFFICE	4	A-3
35-236	TSL-236	TRAILER, OFFICE	4	A-4
35-238	TSL-238	TRAILER, DIAGNOSTIC	4	B-3
35-239	TSL-239	TRAILER, OFFICE	4	A-4
35-240	TSL-240	TRAILER, LABORATORY	4	A-4
35-241	TSL-241	TRAILER, OFFICE	3	G-2
35-242	TSL-242	TRAILER, OFFICE	3	F-3
35-248	TSL-248	TRAILER, OFFICE	3	E-3
35-249	TSL-249	TRAILER, OFFICE	3	G-2
35-250	TSL-250	TRAILER, OFFICE	3	G-4
35-251	TSL-251	TRAILER, OFFICE	3	E-3
35-253	TSL-253	TRANSPORTABLE OFFICE BLDG.	4	A-2
35-254	TSL-254	TRANSPORTABLE OFFICE BLDG.	3	G-3
35-255	TSL-255	TRANSPORTABLE OFFICE BLDG.	3	E-3
35-256	TSL-256	TRANSPORTABLE OFFICE BLDG.	3	F-4
35-257	TSL-257	GUARD STATION #410	3	G-3
35-258	TSL-258	TRAILER, OFFICE	3	E-4
35-261	TSL-261	TRAILER, OFFICE	4	B-3
35-262	TSL-262	TRAILER, OFFICE	4	B-3
35-263	TSL-263	TRAILER, OFFICE	4	B-3
35-268	TSL-268	TRANSPORTABLE OFFICE BLDG.	3	E-3
35-269	TSL-269	TRANSPORTABLE OFFICE BLDG.	3	D-3
35-270	TSL-270	TRANSPORTABLE OFFICE BLDG.	3	D-3
35-278	TSL-278	SIEGE TANKS	3	F-4
35-279	TSL-279	SIEGE TANKS	3	F-4
35-292	35-292	OIL STORAGE TANK	3	G-3
35-294	35-294	POWER SUPPLY BUILDING	3	D-4
35-301	35-301	CPRF GENERATOR BUILDING	3	D-4
35-309	35-309	TRANSPORTAINER	4	A-4
35-310	35-310	TRANSPORTAINER	4	A-4
35-325	35-325	SHED	3	F-4
35-326	35-326	TRANSPORTAINER	3	C-3
35-330	35-330	TRANSPORTAINER	3	G-2
35-331	35-331	TRANSPORTAINER	3	G-2
35-332	35-332	TRANSPORTAINER	3	G-2
35-333	35-333	TRANSPORTAINER	3	F-3
35-336	35-336	OFFICE TRAILER	3	E-3
35-337	TSL-337	TRAILER, OFFICE	3	G-2
35-344	35-344	TRANSPORTAINER	4	A-2
35-345	35-345	TRANSPORTAINER	4	B-3
35-346	35-346	TRANSPORTAINER	4	C-3
35-347	35-347	STORAGE GARAGE	4	C-4
35-349	35-349	MILITARY SHELTER	4	A-4
35-352	35-352	MILITARY SHELTER	4	B-4
35-353	35-353	TRANSPORTAINER	4	B-4
35-354	35-354	TRANSPORTAINER	4	B-4
35-355	35-355	TRANSPORTAINER	3	G-3
35-356	35-356	TRANSPORTAINER	4	C-3
35-358	35-358	SEMI-TRAILER, STORAGE	4	B-4
35-359	35-359	TRANSPORTAINER	3	F-4
35-360	35-360	TRANSPORTAINER	3	F-4
35-361	35-361	TRANSPORTAINER	3	F-4
35-365	35-365	STORAGE SHED	4	B-4
35-366	35-366	TRANSPORTAINER	3	C-3
35-368	35-368	TRANSPORTAINER	3	F-3
35-369	35-369	TRANSPORTAINER	3	F-4
35-370	35-370	TRANSPORTAINER	3	F-4
35-371	35-371	TRANSPORTAINER	3	F-3
35-372	35-372	TRANSPORTAINER	3	F-3
35-373	35-373	TRANSPORTAINER	3	F-3
35-374	35-374	STORAGE SHED	3	F-3
35-375	35-375	STORAGE SHED	3	F-3
35-376	35-376	STORAGE SHED	3	D-4
35-382	35-382	TRAILER	4	A-2
35-384	35-384	TRANSPORTAINER	3	G-3
35-385	35-385	CHEM-STOR SHED	3	F-3
35-386	35-386	STORAGE, HAZARDOUS MAT'L	4	A-4
35-389	35-389	TRANSPORTAINER	4	B-4
35-390	35-390	TRANSPORTAINER	3	G-4
35-392	35-392	MILITARY SHELTER	4	A-4
35-393	35-393	TRANSPORTAINER	4	A-4
35-394	35-394	TRANSPORTAINER	4	A-4
35-402	35-402	LIFT STATION	4	C-4
35-406	35-406	STORAGE TANK	4	B-4
35-407	35-407	TRANSPORTAINER	4	A-3
35-408	35-408	MILITARY SHELTER	4	A-3
35-409	35-409	MORGAN SHED	4	B-3
35-410	35-410	MORGAN SHED	4	B-3
35-411	35-411	MILITARY SHELTER	4	B-3
35-412	35-412	MORGAN SHED	4	G-2
35-421	35-421	PULSED POWER RESEARCH FACILITY	3	E-4
35-423	35-423	CHEM-STOR SHED	3	F-3
35-424	35-424	MORGAN SHED	3	D-3
35-425	35-425	MORGAN SHED	3	D-3
35-451	35-451	TRANSPORTAINER	3	F-4
35-455	35-455	POLYMER & COATING LABORATORY	3	D-3
35-457	35-457	CHEM-STOR SHED	3	F-4
35-458	35-458	CHEM-STOR SHED	3	C-3
35-466	35-466	TRAILER	3	D-4
35-470	35-470	DIAGNOSTIC TRAILER	3	F-3
35-471	35-471	SPILL CONTAINMENT AREA	3	F-4
35-472	35-472	SPILL CONTAINMENT AREA	3	G-2
35-473	35-473	SHED	3	F-4

NO	DATE	CLASS REV	REVISIONS	DWN	VER	CHKD	REL	SUB	REC	APP
3	07-29-94		REVISED TO STATUS OF 07-27-94	JPH	JPH	HMS	HMS	JAF	BEC	RAP
2	05-16-94		REVISED TO NEW STANDARDS	HMS	JPH	JPH	HMS	JAF	BEC	RAP
1	01-31-94		REVISED TO STATUS OF 01-21-94	JPH	JPH	HMS	HMS	JAF	BEC	RAP

JOHNSON CONTROLS WORLD SERVICES INC.

AS-BUILT STRUCTURE LOCATION MAPS

TA-35

TEN SITE

DRAWN J. HORN
VERIFIED J. HORN
CHECKED H. SALAZAR
RELEASED H. SALAZAR
DATE 06-03-93

SUBMITTED JERRY FORTE
RECOMMENDED BRYAN COMER
APPROVED ROBERT PROMMEL

Los Alamos — Los Alamos National Laboratory, Los Alamos, New Mexico 87545

SHEET 2 OF 4

CLASSIFICATION U REVIEWER H. SALAZAR DATE 8-2-94

PROJECT ID 11952 DRAWING NO AB27 REV 3

JCI NO 91-020

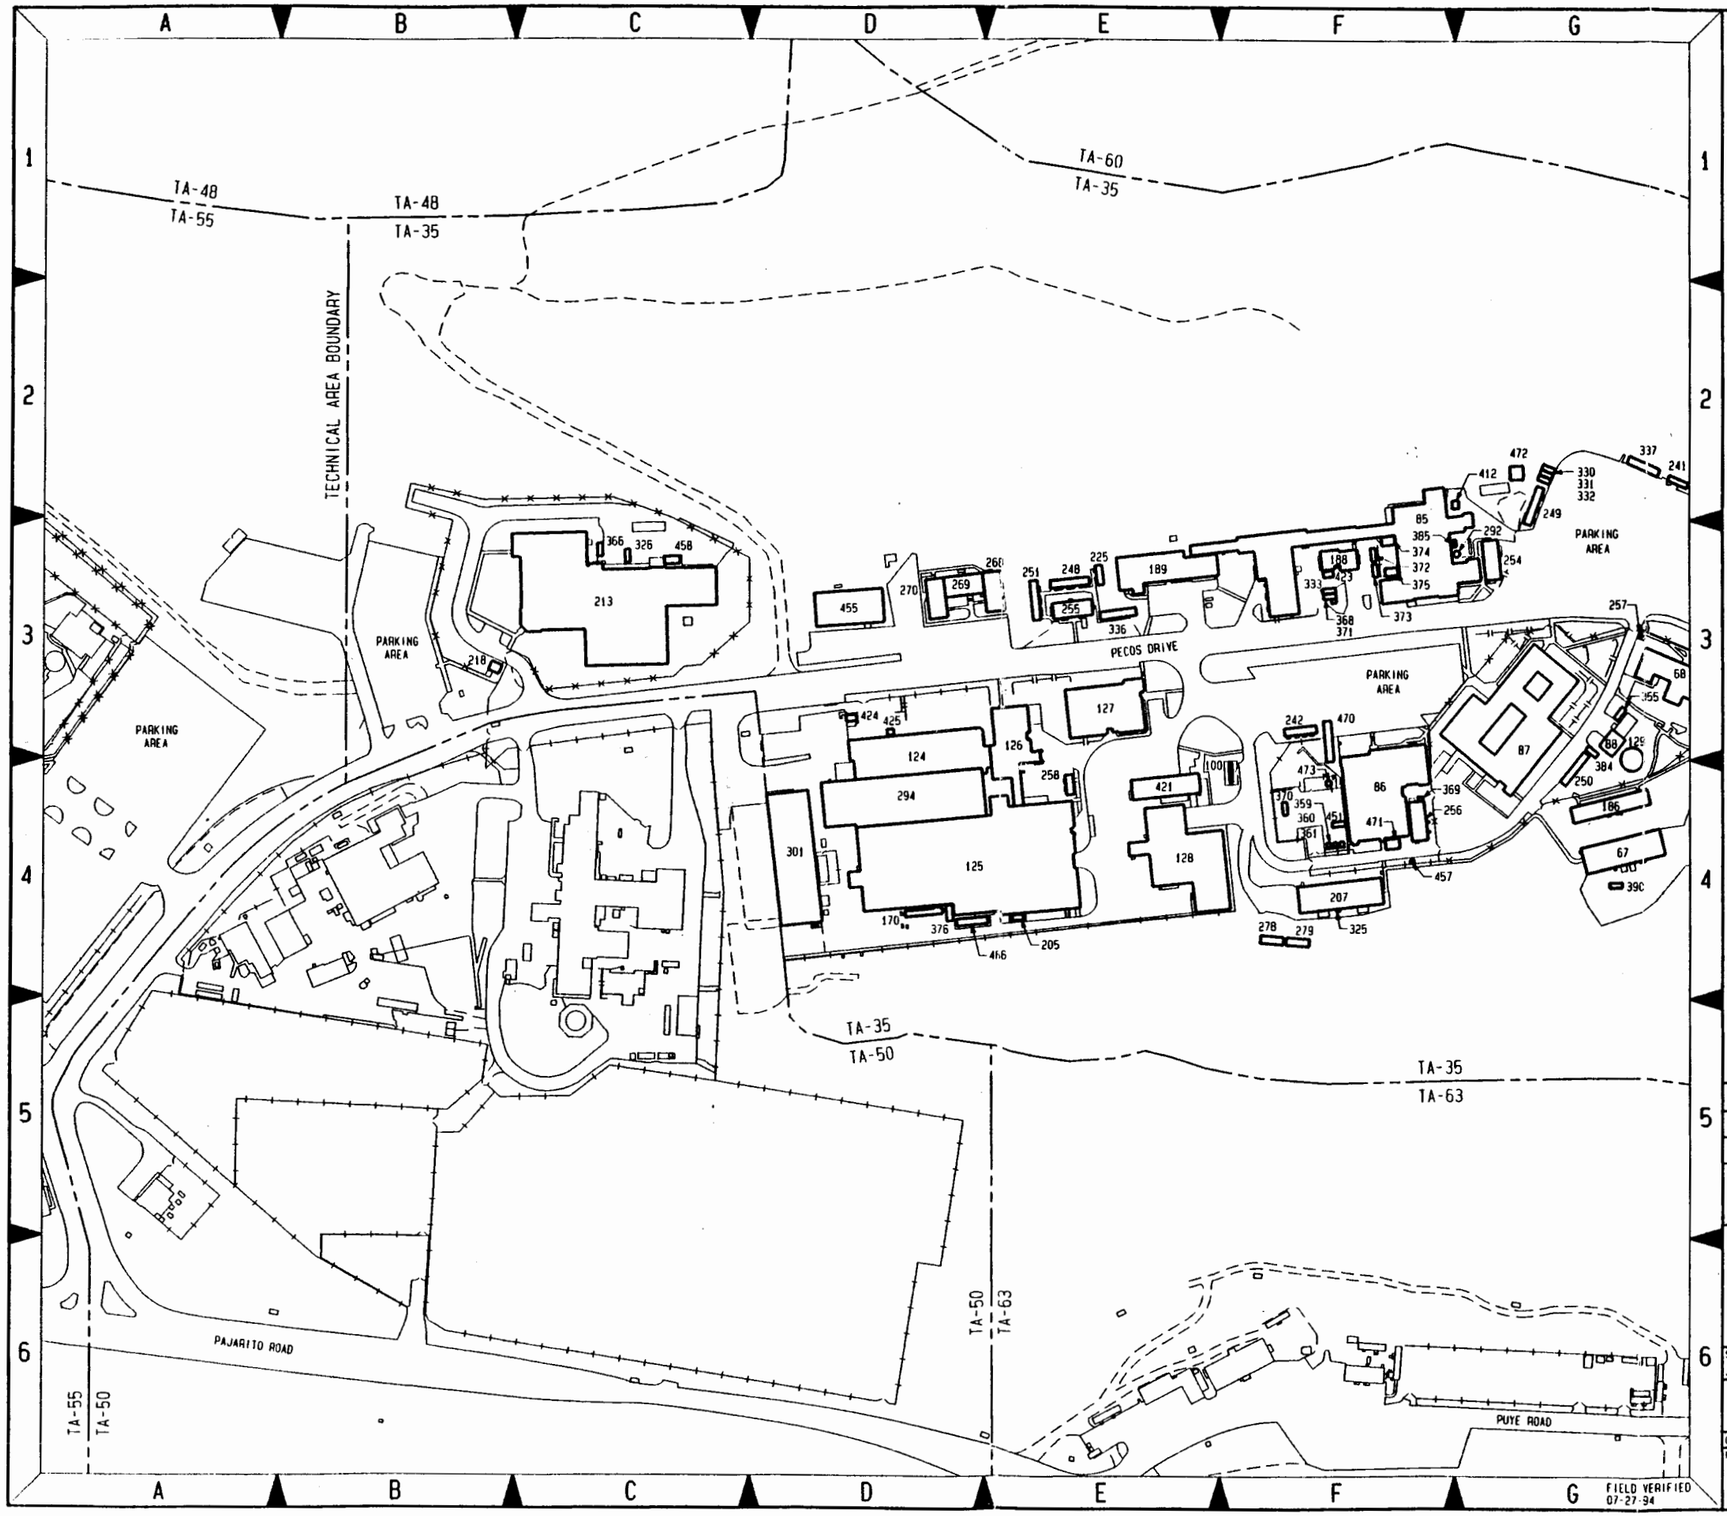

KEY MAP

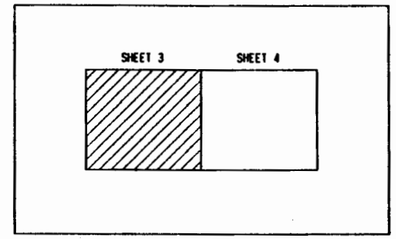

N

SCALE: 1:1200

100 0 100 200

FEET

NO	DATE	CLASS REV	REVISIONS	DWN	VER	CHKD	REL	SUB	REC	APP
3	07-29-94		REVISED TO STATUS OF 07-27-94	JPM	JPM	HMS	HMS	JAF	BEC	RAP
2	05-16-94		REVISED TO NEW STANDARDS	HMS	JPM	JPM	HMS	JAF	BEC	RAP
1	01-31-94		REVISED TO STATUS OF 01-21-94	JPM	JPM	HMS	HMS	JAF	BEC	RAP

JOHNSON CONTROLS WORLD SERVICES INC.

AS-BUILT STRUCTURE LOCATION MAPS

TA-35

TEN SITE

DRAWN	J. MORA
VERIFIED	J. MORA
CHECKED	H. SALAZAR
RELEASED	H. SALAZAR
DATE	06-03-93

SUBMITTED JERRY FORTE — RECOMMENDED BRYAN COMER — APPROVED ROBERT PROMMEL

Los Alamos — Los Alamos National Laboratory, Los Alamos, New Mexico 87545

SHEET 3 of 4

CLASSIFICATION U — REVIEWER H. SALAZAR — DATE 8-2-94

PROJECT ID	DRAWING NO	REV
11952	AB27	3

JC. NO 91-120

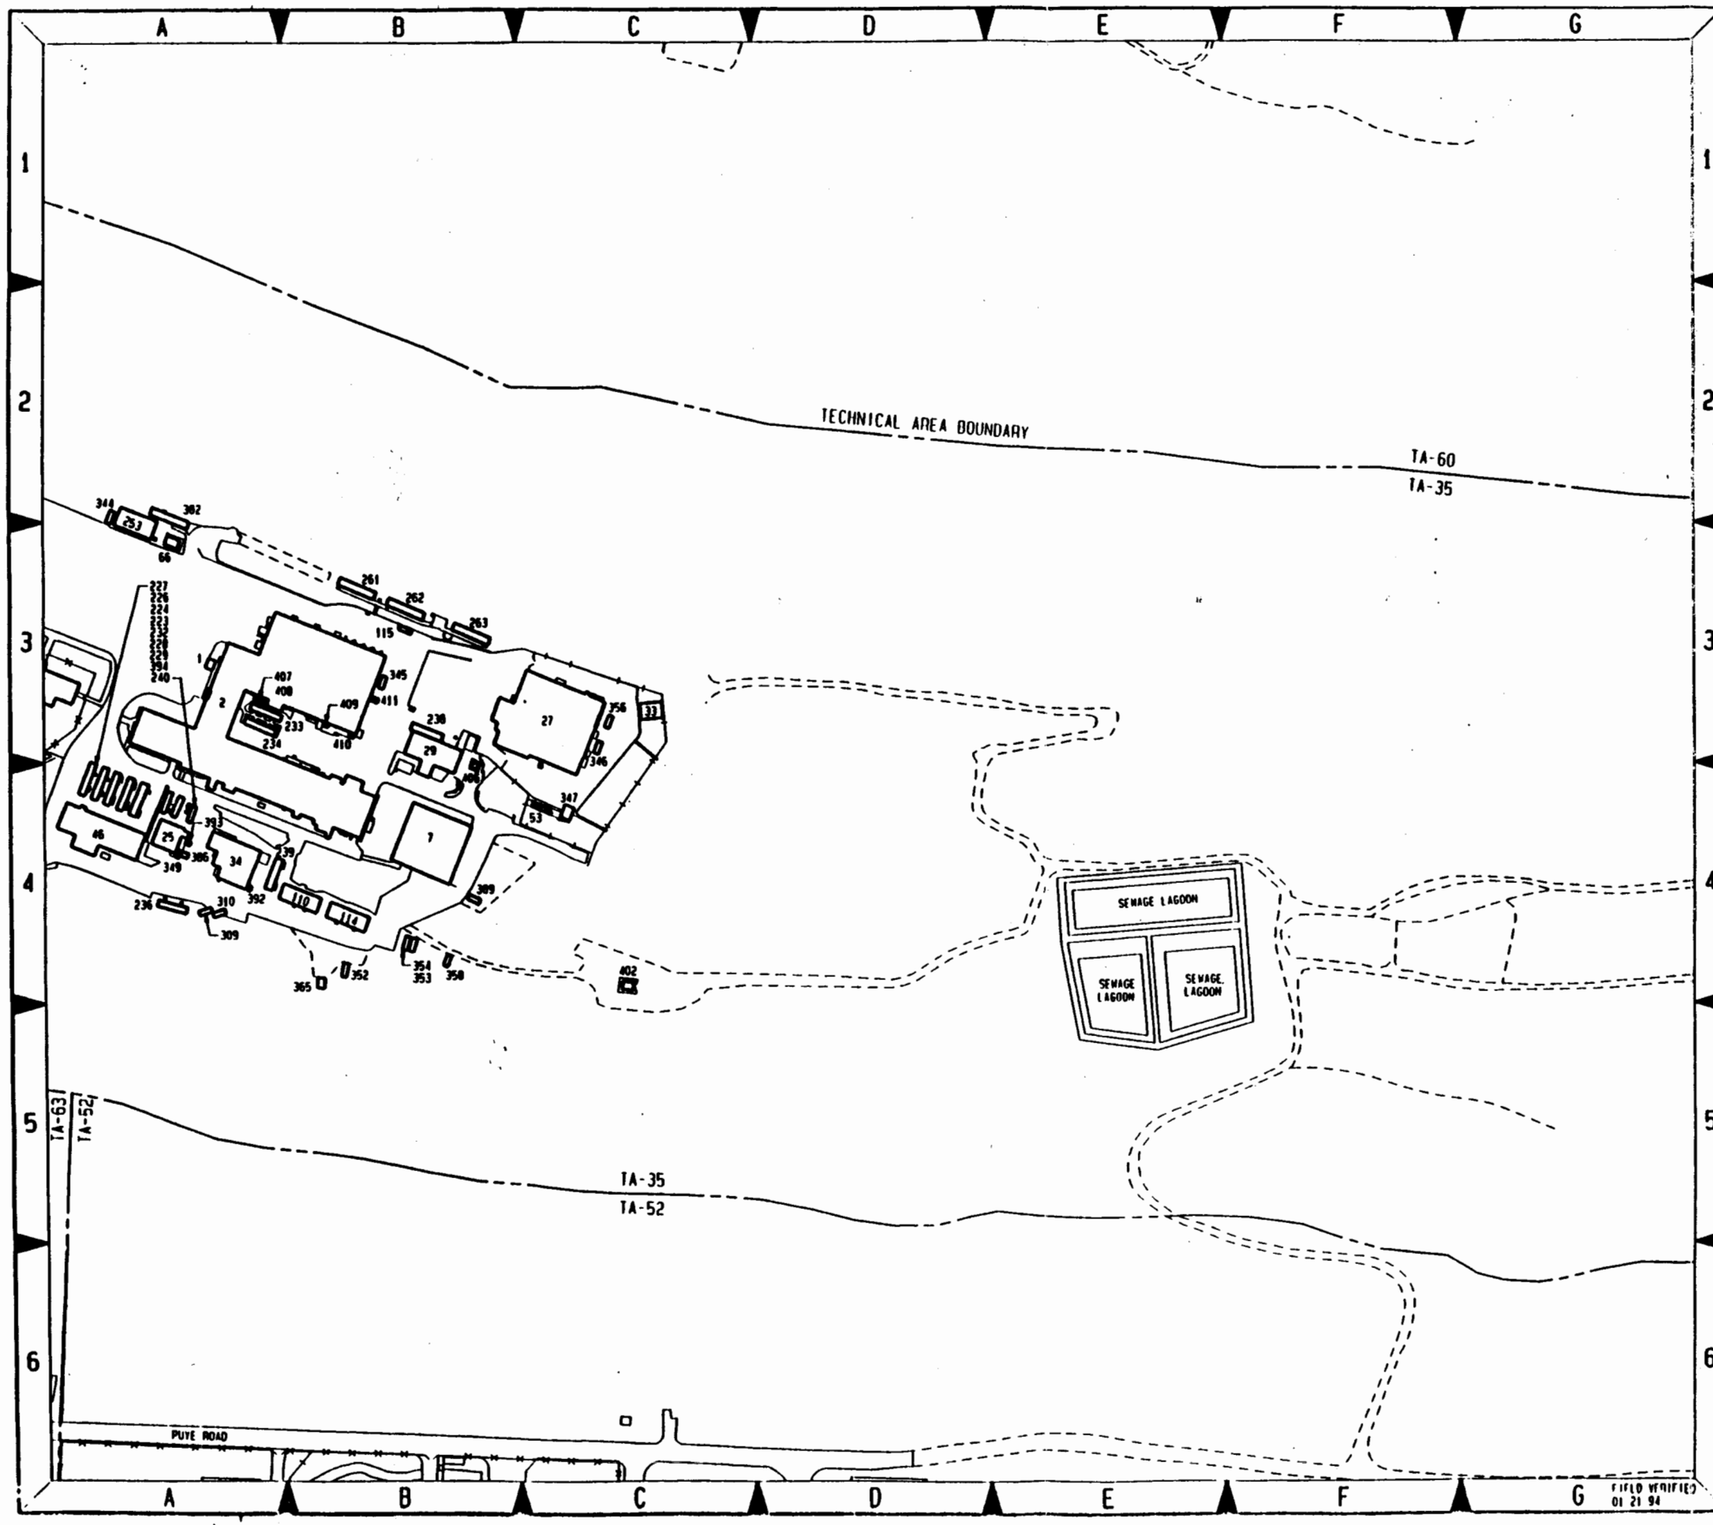

KEY MAP

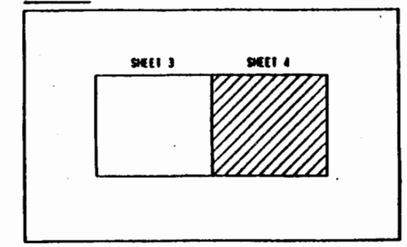

N

SCALE: 1:1200

100 0 100 200

FEET

NO	DATE	CLASS REV	REVISIONS	DWN	VER	CHKD	REL	SUB	REC	APP
2	05-16-94		REVISED TO NEW STANDARDS	HNS	JPH	JPH	HNS	JAF	BEC	RAP
1	01-31-94		REVISED TO STATUS OF 01-21-94	JPH	JPH	HNS	HNS	JAF	BEC	RAP

JOHNSON CONTROLS WORLD SERVICES INC.

AS-BUILT STRUCTURE LOCATION MAPS

TA-35

TEN SITE

DRAWN J. NORK
VERIFIED J. NORK
CHECKED H. SALAZAR
RELEASED H. SALAZAR
DATE 05-03-93

SUBMITTED JERRY FORTE
RECOMMENDED BRIAN COHEN
APPROVED ROBERT PROMPEL

Los Alamos — Los Alamos National Laboratory, Los Alamos, New Mexico 87545

SHEET 4 of 4

CLASSIFICATION U REVIEWED H. SALAZAR DATE 5-12-94

PROJECT ID 11952 DRAWING NO AB27 REV 2

STRUCTURE LOCATION MAPS

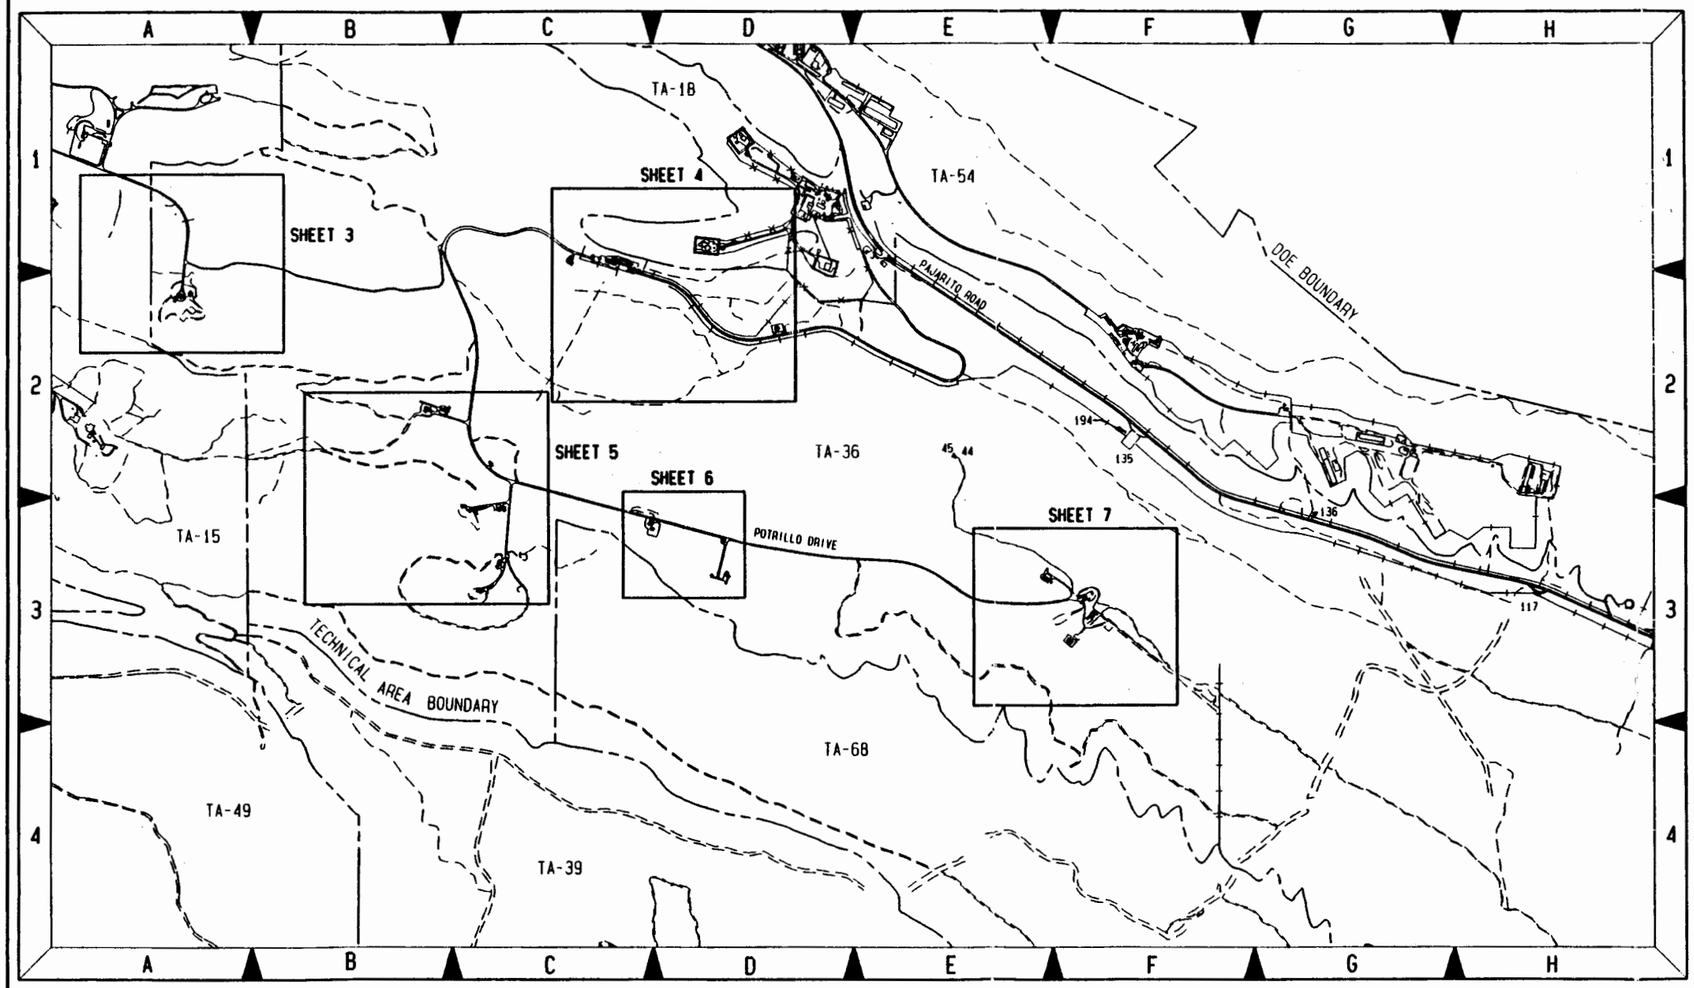

TA-36 KEY MAP

SCALE: 1:9600

800 0 800 1600

FEET

N

FIELD VERIFIED 09-02-94

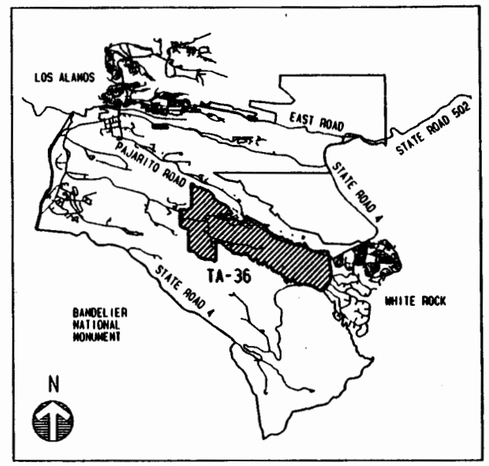

LOCATION PLAN

SCALE: NONE

NO	DATE	CLASS REV	REVISIONS	DWN	VER	CHKD	REL	SUB	REC	APP
2	09-08-94		REVISED TO STATUS OF 09-02-94	JPM	BRM	HNS	HNS	JAF	BEC	HAP
1	05-16-94		REVISED PER NEW STANDARDS	HNS	JPM	JPM	HNS	JAF	BEC	HAP

JOHNSON CONTROLS WORLD SERVICES INC.

AS-BUILT STRUCTURE LOCATION MAPS

TA-36

KAPPA SITE

DRAWN J. MORA

VERIFIED J. MORA

CHECKED H. SALAZAR

RELEASED H. SALAZAR

DATE 12-15-93

SUBMITTED JERRY FORTE

RECOMMENDED BRIAN COMER

APPROVED ROBERT PRUDHEL

Los Alamos — Los Alamos National Laboratory, Los Alamos, New Mexico 87545

SHEET 1 OF 7

CLASSIFICATION U

REVIEWER H. SALAZAR DATE 9-16-94

PROJECT ID 11952

DRAWING NO AB28

REV 2

J.C. NO 91-020

STRUCTURE LOCATION INDEX

TA-NUMBER	STRUCTURE DESIGNATION	STRUCTURE NOMENCLATURE	STRUCTURE LOCATOR SHEET NO.	STRUCTURE LOCATOR MAP KEY
36-1	KAPPA-1	LABORATORY & OFFICE BUILDING	4	C-3
36-3	KAPPA-3	EENIE CONTROL BUILDING	5	D-1
36-4	KAPPA-4	EENIE PREP. BUILDING	5	E-1
36-5	KAPPA-5	MEENIE PREP. BUILDING	5	F-4
36-6	KAPPA-6	MEENIE CONTROL BUILDING	5	E-4
36-7	KAPPA-7	MINIE PREP. BUILDING	5	F-5
36-8	KAPPA-8	MINIE CONTROL BUILDING	5	F-6
36-9	KAPPA-9	MOE MAGAZINE	6	F-3
36-10	KAPPA-10	MAGAZINE	6	F-5
36-11	KAPPA-11	LOWER SLOBOY. PREP. BUILDING	7	C-2
36-12	KAPPA-12	LOWER SLOBOY. CONTROL BUILDING	7	D-3
36-13	KAPPA-13	INSTRUMENT BOX	7	E-3
36-19	KAPPA-19	INSTRUMENT BOX	5	E-4
36-20	KAPPA-20	INSTRUMENT BOX	5	F-6
36-21	KAPPA-21	FIRING BOX, DOUBLE	7	E-3
36-22	KAPPA-22	GUARD STATION #460	4	B-3
36-44	KAPPA-44	STORAGE BUILDING	1	E-2
36-45	KAPPA-45	STORAGE BUILDING	1	E-2
36-46	KAPPA-46	STORAGE BUILDING	4	B-2
36-47	KAPPA-47	STORAGE BUILDING	4	B-2
36-48	KAPPA-48	LABORATORY BUILDING	4	A-3
36-53	KAPPA-53	STORAGE BUILDING	4	C-3
36-54	36-54	TRACTOR SHED	4	B-2
36-55	KAPPA-55	IJ CONTROL BUILDING	3	G-4
36-69	KAPPA-69	SECURITY PRECINCT FACILITY	4	G-4
36-80	KAPPA-80	TRANSPORTABLE	4	B-3
36-82	36-82	DAISY PREP. BUILDING	5	F-3
36-83	36-83	PROMOE MAGAZINE	5	F-6
36-84	36-84	OFFICE BUILDING	4	B-3
36-86	36-86	PIXY FACILITY	7	E-3
36-94	36-94	TRANSPORTAINER	4	A-3
36-95	36-95	TRANSPORTAINER	5	F-4
36-102	36-102	TRANSPORTAINER	6	B-3
36-103	36-103	TRANSPORTAINER	6	B-2
36-104	36-104	SHED	6	B-2
36-107	36-107	IJ CONTROL BUILDING	3	D-4
36-110	36-110	TRANSPORTAINER	5	E-1
36-112	36-112	TRANSPORTAINER	6	G-5
36-113	36-113	TRANSPORTAINER	3	D-5
36-117	36-117	PAJARITO BOOSTER #1	1	H-3
36-118	36-118	TRANSPORTAINER	5	G-5
36-119	36-119	TRANSPORTAINER	3	D-5
36-120	36-120	CONTROL BUILDING	5	E-6
36-121	36-121	TRANSPORTAINER	5	D-1
36-122	36-122	TRANSPORTAINER	5	F-5
36-124	36-124	TRANSPORTAINER	5	F-6
36-125	36-125	TRANSPORTAINER	4	A-3
36-127	36-127	SHED	7	G-5
36-129	36-129	TRANSPORTAINER	5	E-4
36-130	36-130	TRANSPORTAINER	7	C-2
36-131	36-131	TRANSPORTAINER	3	D-5
36-134	36-134	TRANSPORTAINER	7	C-2
36-135	36-135	SEWAGE LAGOONS	1	F-2
36-136	36-136	BACKFLOW PREVENTER	1	G-3
36-141	36-141	OIL TANK	7	D-4
36-142	36-142	OIL TANK	7	D-4
36-184	36-184	TRANSPORTAINER	7	D-4
36-194	36-194	SHED	1	F-2
36-197	36-197	TRANSPORTAINER	5	E-4

NO	DATE	CLASS REV	REVISIONS	DWN	VER	CHKD	REL	SUB	REC	APP
2	09-08-94		REVISED TO STATUS OF 09-02-94	JPW	JPW	HMS	HMS	JAF	BEC	RAP
1	05-16-94		REVISED PER NEW STANDARDS	HMS	JPW	JPW	HMS	JAF	BEC	RAP

JOHNSON CONTROLS WORLD SERVICES INC.

AS-BUILT STRUCTURE LOCATION MAPS

TA-36

KAPPA SITE

DRAWN	J. WORK
VERIFIED	J. WORK
CHECKED	H. SALAZAR
RELEASED	H. SALAZAR
DATE	12-15-93

SUBMITTED JERRY FORTE — RECOMMENDED BRYAN COHEN — APPROVED ROBERT PRONNEL

Los Alamos — Los Alamos National Laboratory, Los Alamos, New Mexico 87545

SHEET 2 OF 7

CLASSIFICATION U — REVIEWER H. SALAZAR — DATE 9-11-94

PROJECT ID	DRAWING NO	REV
11952	AB28	2

DPS 16 JCI

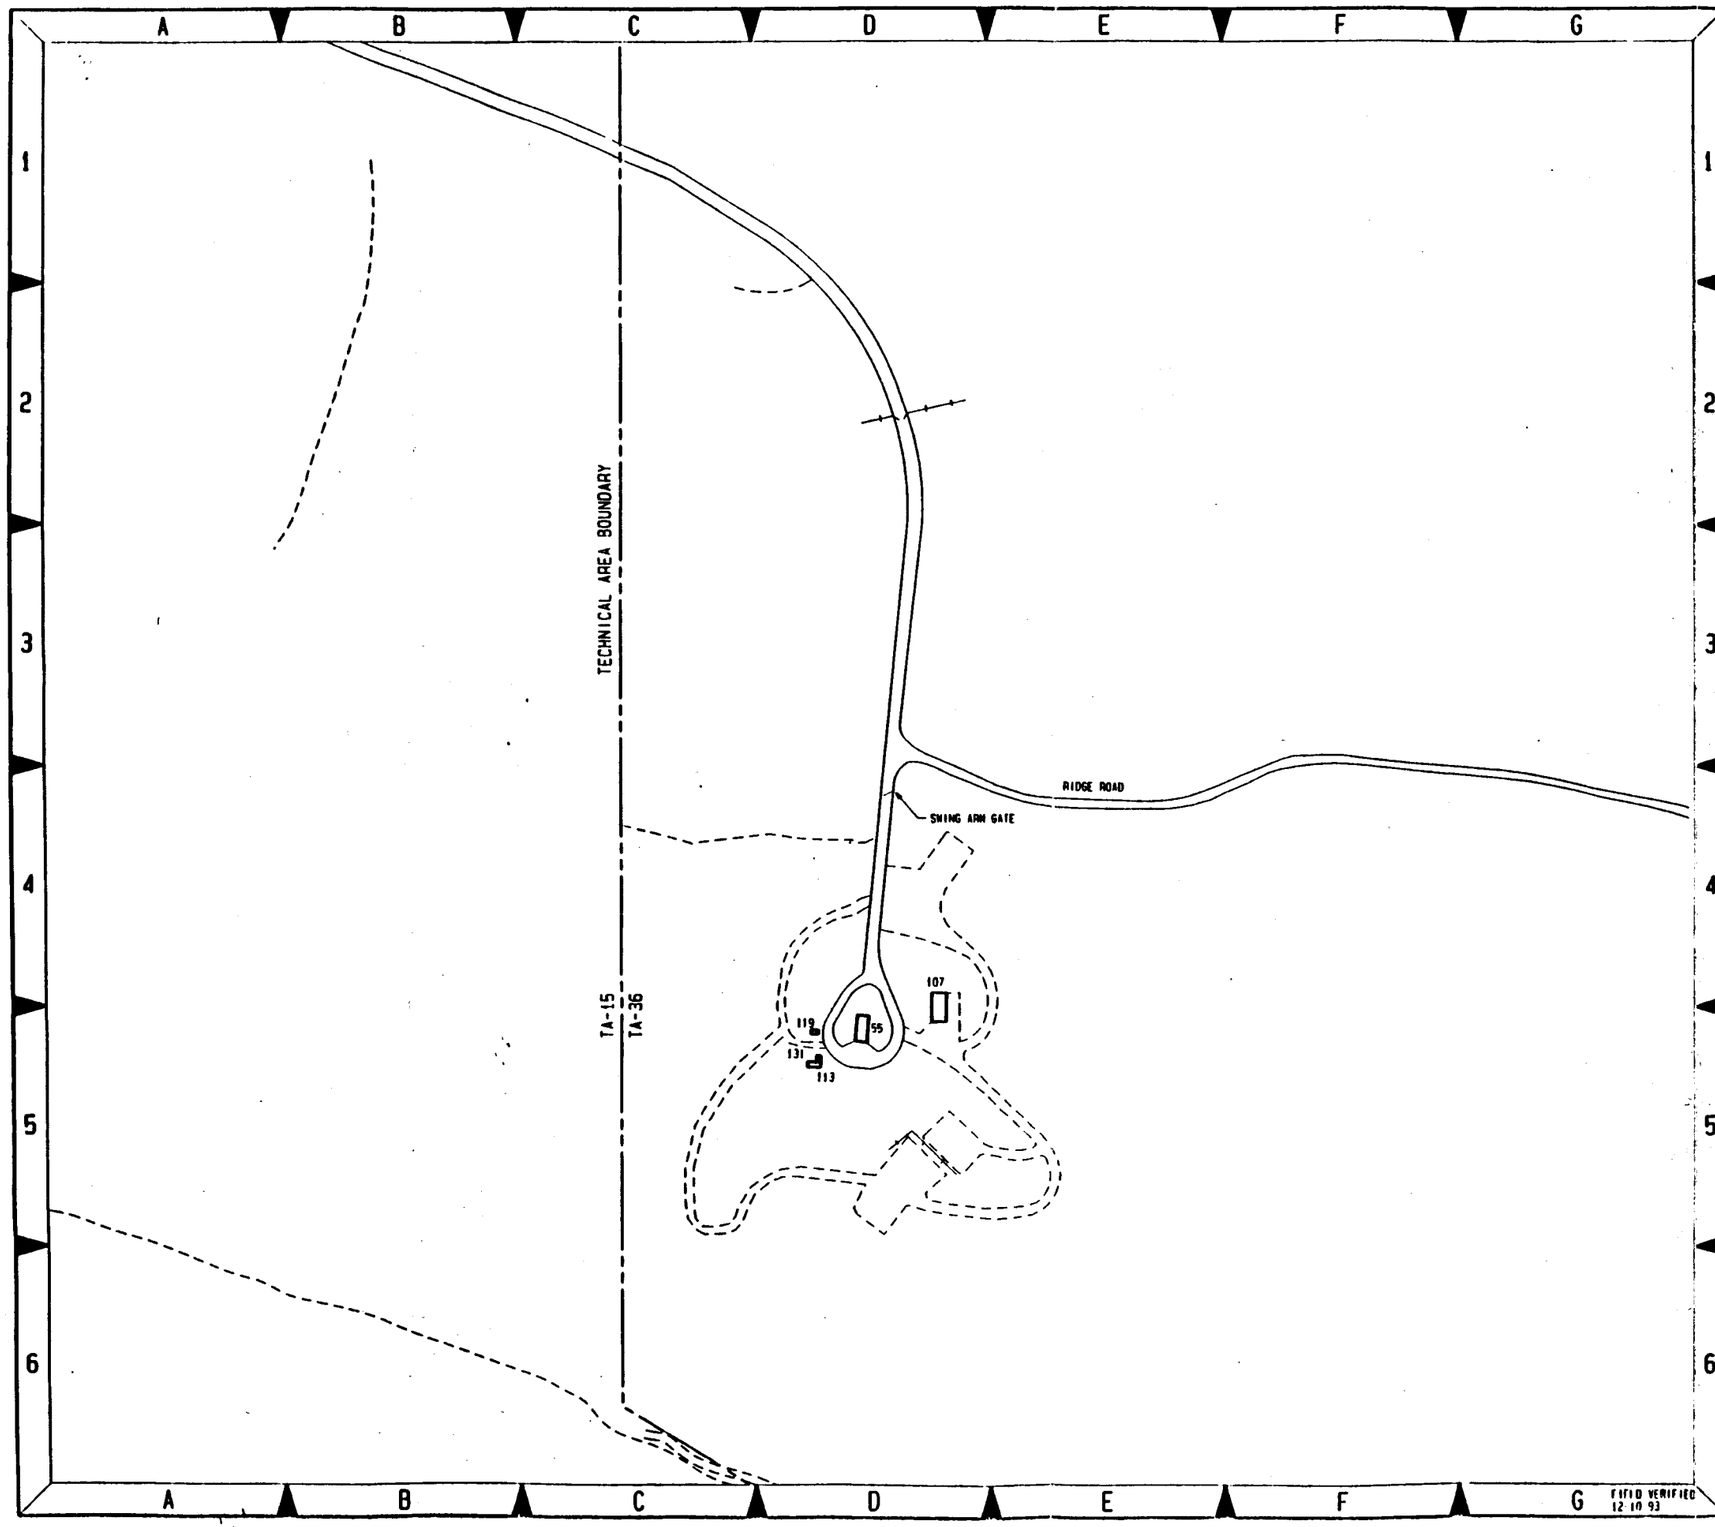

KEY MAP

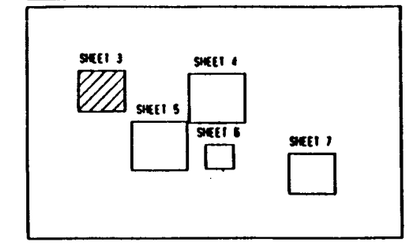

N

SCALE: 1:1200

100 0 100 200

FEET

NO	DATE	CLASS REV	REVISIONS	DWN	VER	CHKD	REL	SUB	REC	APP
1	05-16-94		REVISED PER NEW STANDARDS	HNS	JPH	JPH	HNS	JAF	BEC	RAP

JOHNSON CONTROLS WORLD SERVICES INC.

AS-BUILT STRUCTURE LOCATION MAPS

TA-36

KAPPA SITE

DRAWN J. HORN
VERIFIED J. HORN
CHECKED H. SALAZAR
RELEASED H. SALAZAR
DATE 12-15-93

SUBMITTED JERRY FORTE
RECOMMENDED BRYAN COHEN
APPROVED ROBERT PROMMEL

Los Alamos — Los Alamos National Laboratory, Los Alamos, New Mexico 87545

SHEET 3 / 7

CLASSIFICATION U REVIEWER H. SALAZAR DATE 8-18-94

PROJECT ID 11952 DRAWING NO AB28 REV 1

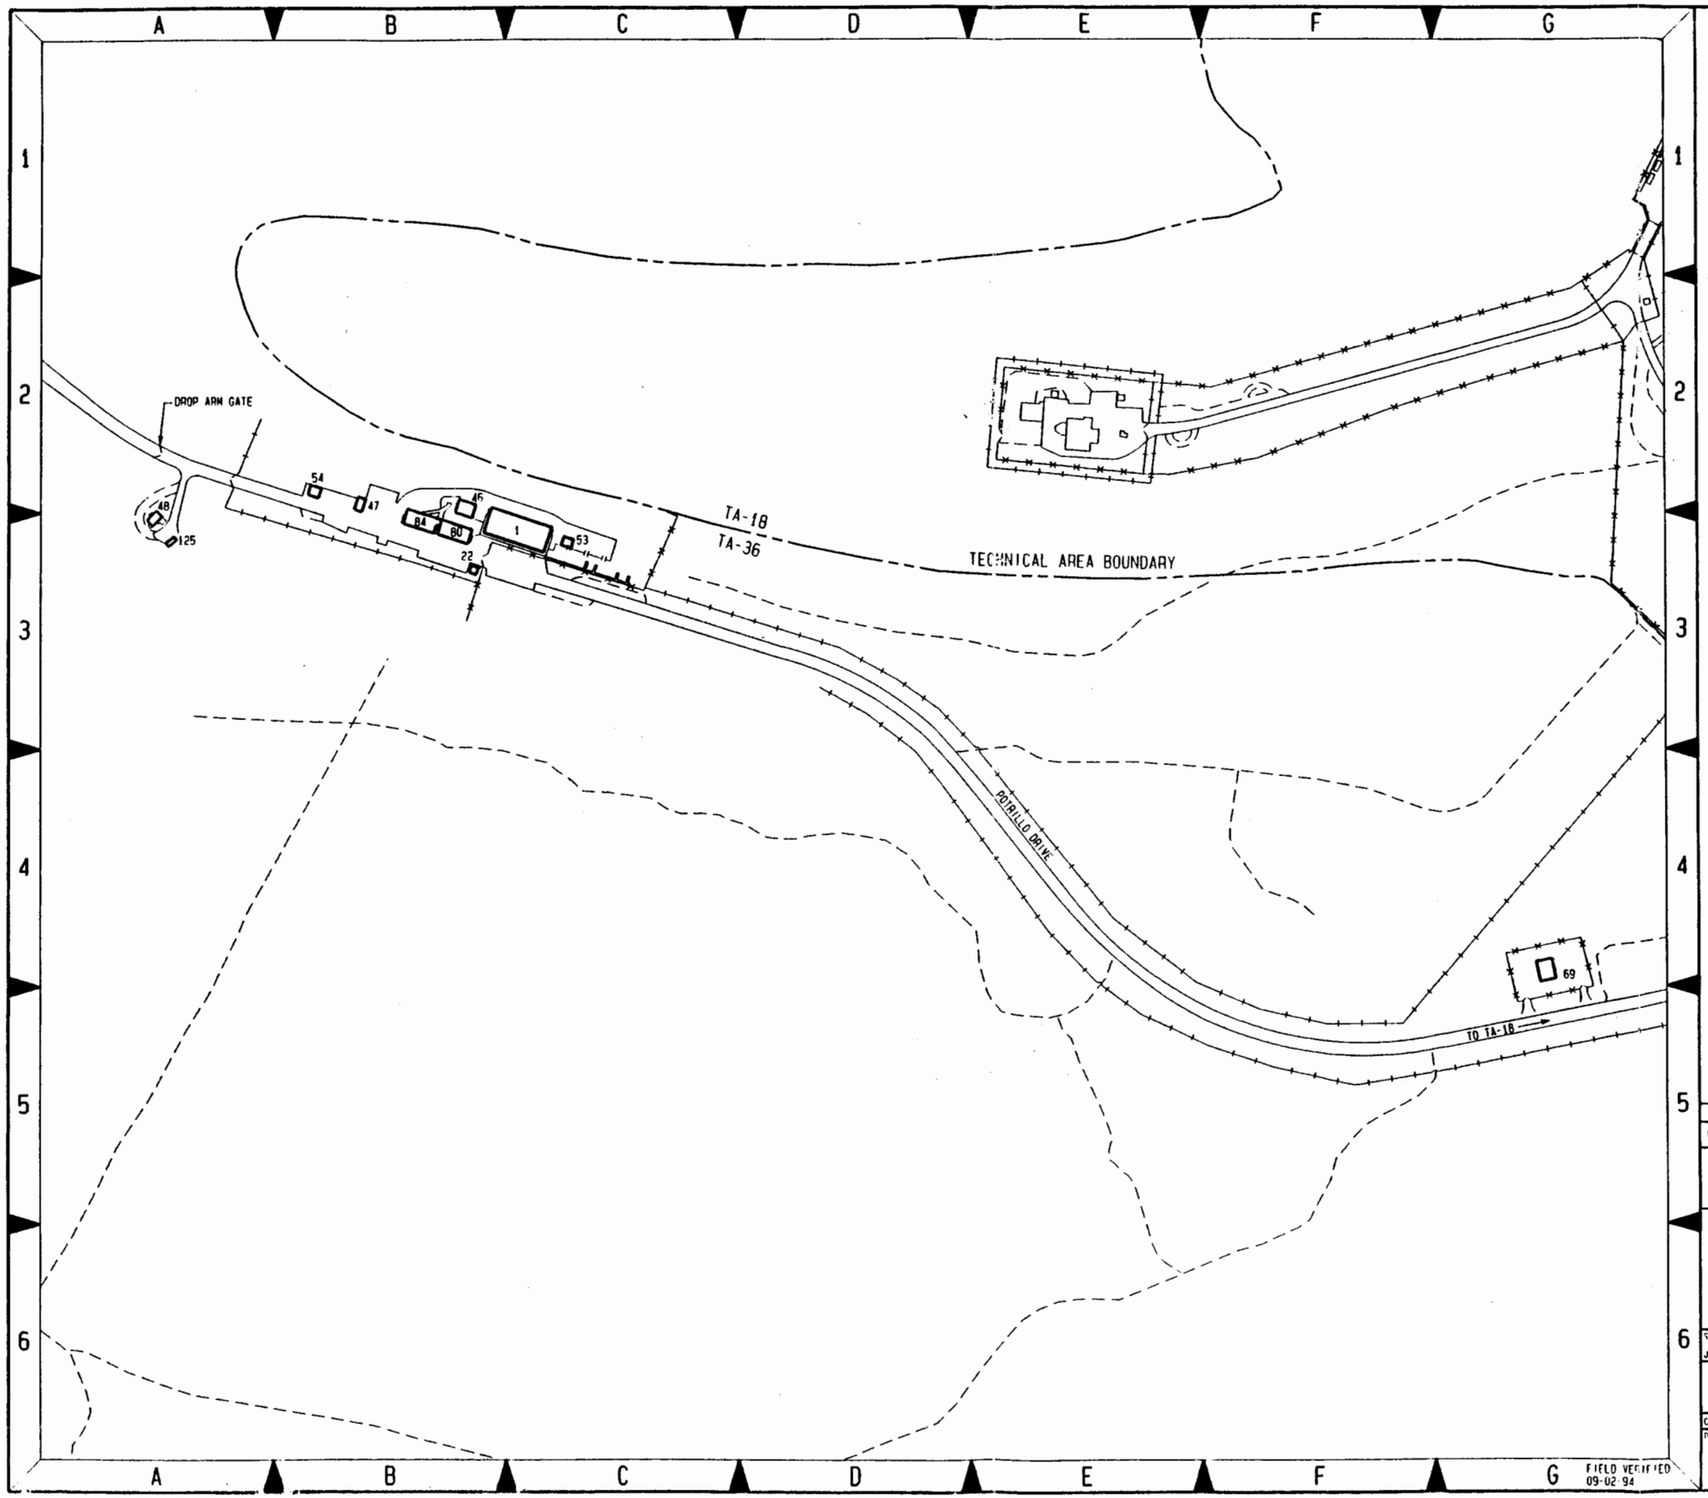

KEY MAP

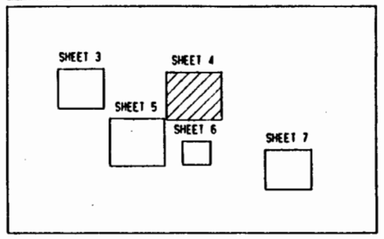

N

SCALE: 1:1440

120 0 120 240

FEET

NO	DATE	CLASS REV	REVISIONS	DWN	VER	CHKD	ELL	SUB	REC	APP
2	09-08-94		REVISED TO STATUS OF 09-02-94	JPW	JPW	HWS	HWS	JAF	BEC	RAP
1	05-16-94		REVISED PER NEW STANDARDS	HWS	JPW	JPN	HWS	JAF	BEC	RAP

JOHNSON CONTROLS WORLD SERVICES INC.

AS-BUILT STRUCTURE LOCATION MAPS

TA-36

KAPPA SITE

DRAWN J. HORK
VERIFIED J. HORK
CHECKED H. SALAZAR
RELEASED H. SALAZAR
DATE 12-15-93

SUBMITTED JERRY FORTE
RECOMMENDED BRYAN COMER
APPROVED ROBERT PROMMEL

Los Alamos

Los Alamos National Laboratory
Los Alamos, New Mexico 87545

SHEET 4 OF 7

CLASSIFICATION U REVIEWER H. SALAZAR DATE 9-16-94

PROJECT ID	DRAWING NO	REV
11952	AB28	2

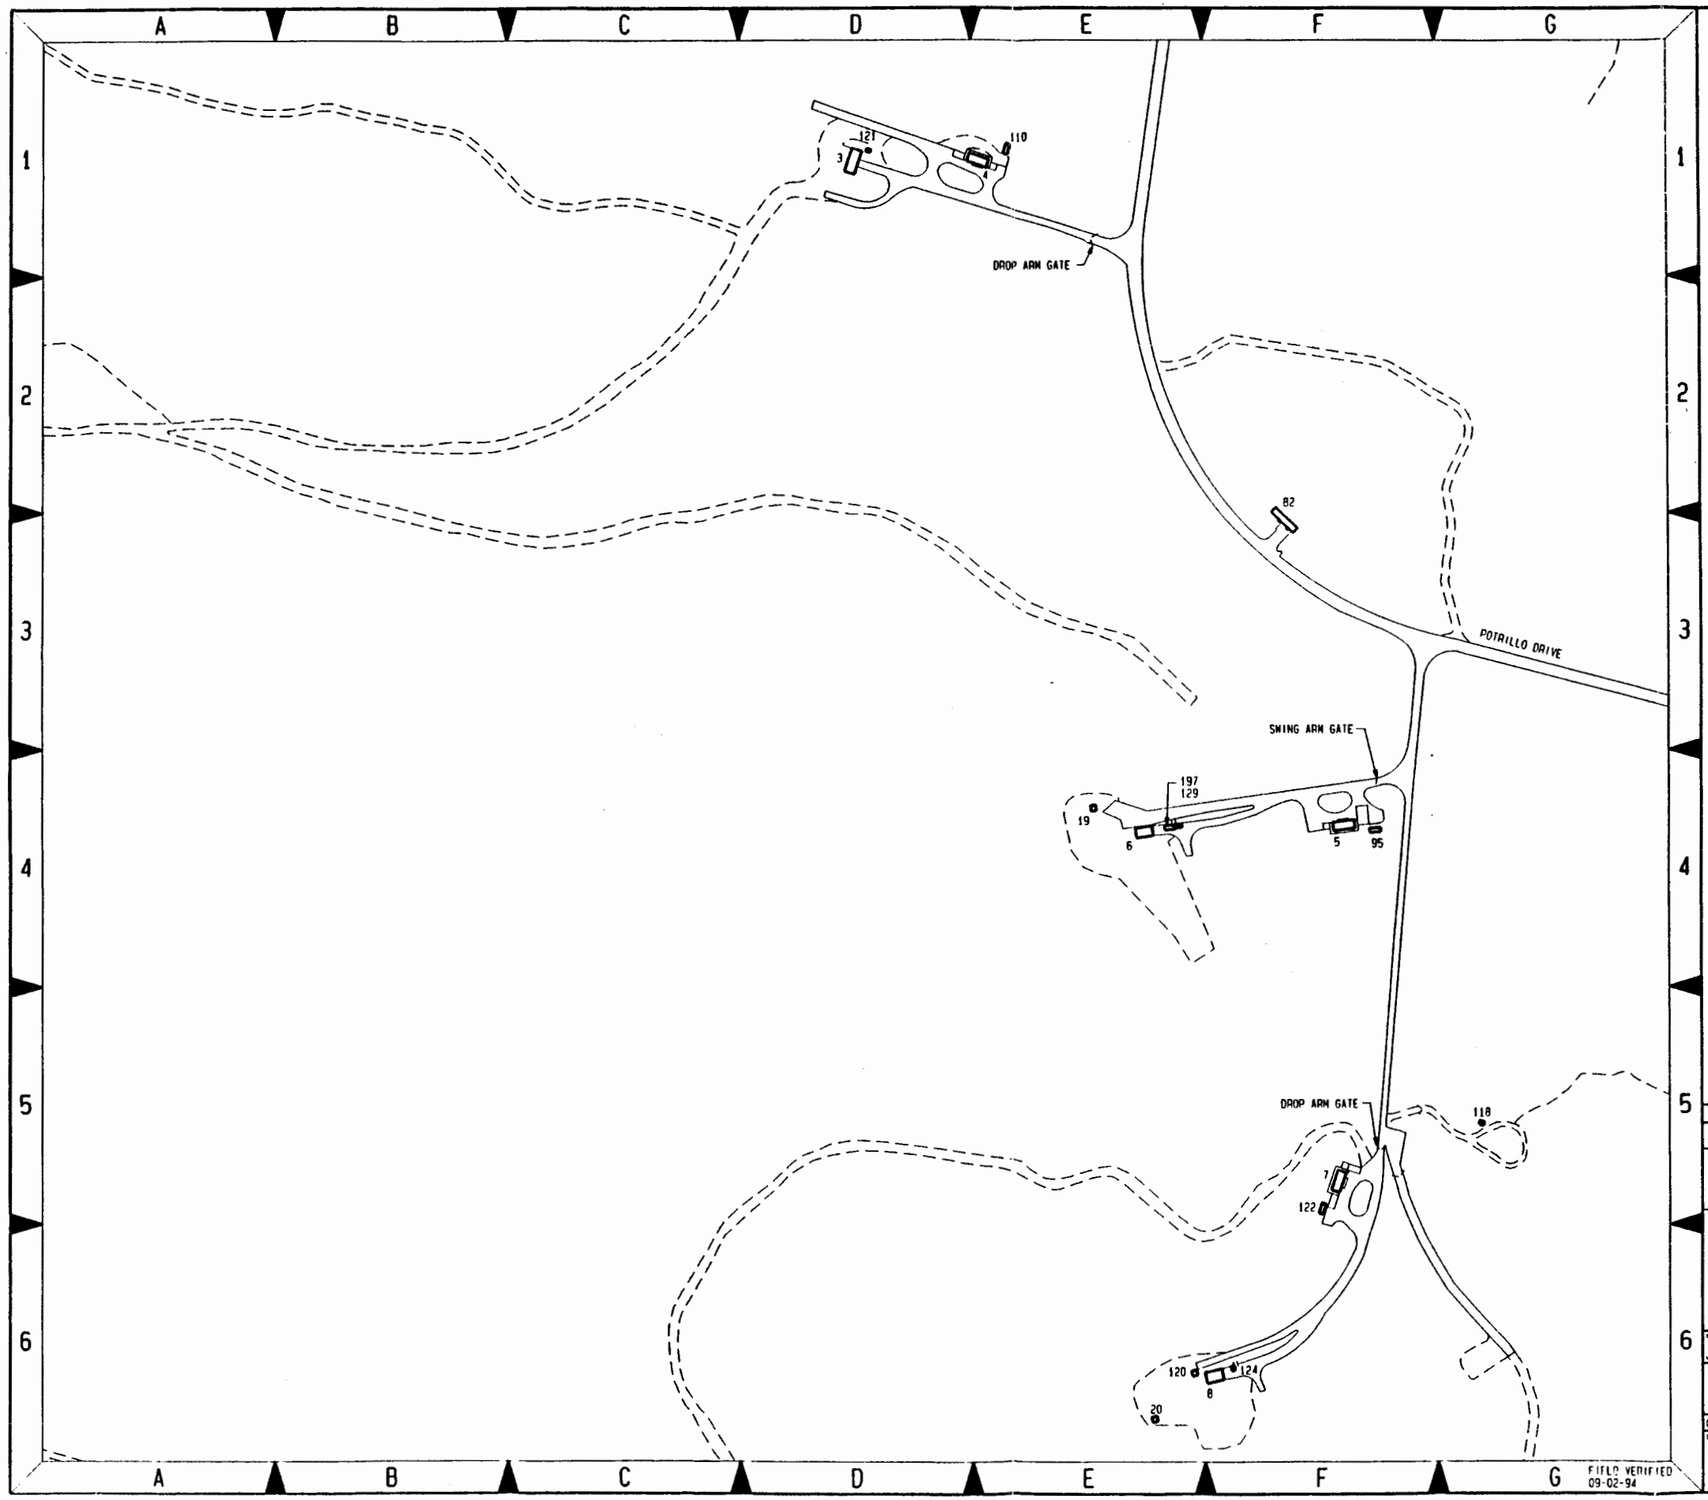

KEY MAP

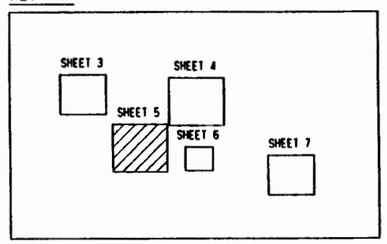

N

SCALE: 1:1440

120 0 120 240

FEET

NO	DATE	CLASS REV	REVISIONS	DWN	VER	CHKD	REL	SUB	REC	APP
2	09-08-94		REVISED TO STATUS OF 09-02-94	JPM	JPM	HMS	HMS	JAF	BEC	RAP
1	05-16-94		REVISED PER NEW STANDARDS	HMS	JPM	JPM	HMS	JAF	BEC	RAP

JOHNSON CONTROLS WORLD SERVICES INC.

AS-BUILT STRUCTURE LOCATION MAPS

TA-36

KAPPA SITE

DRAWN	J. WORK
VERIFIED	J. WORK
CHECKED	H. SALAZAR
RELEASED	H. SALAZAR
DATE	12-15-93

SUBMITTED JERRY FORTE Jerry Forte

RECOMMENDED BRYAN COWER

APPROVED ROBERT PROMMEL

Los Alamos — Los Alamos National Laboratory, Los Alamos, New Mexico 87545

SHEET 5 OF 7

CLASSIFICATION U REVIEWER H. SALAZAR DATE 9-16-94

PROJECT ID 11952

DRAWING NO AB28

REV 2

020-16 DN 1

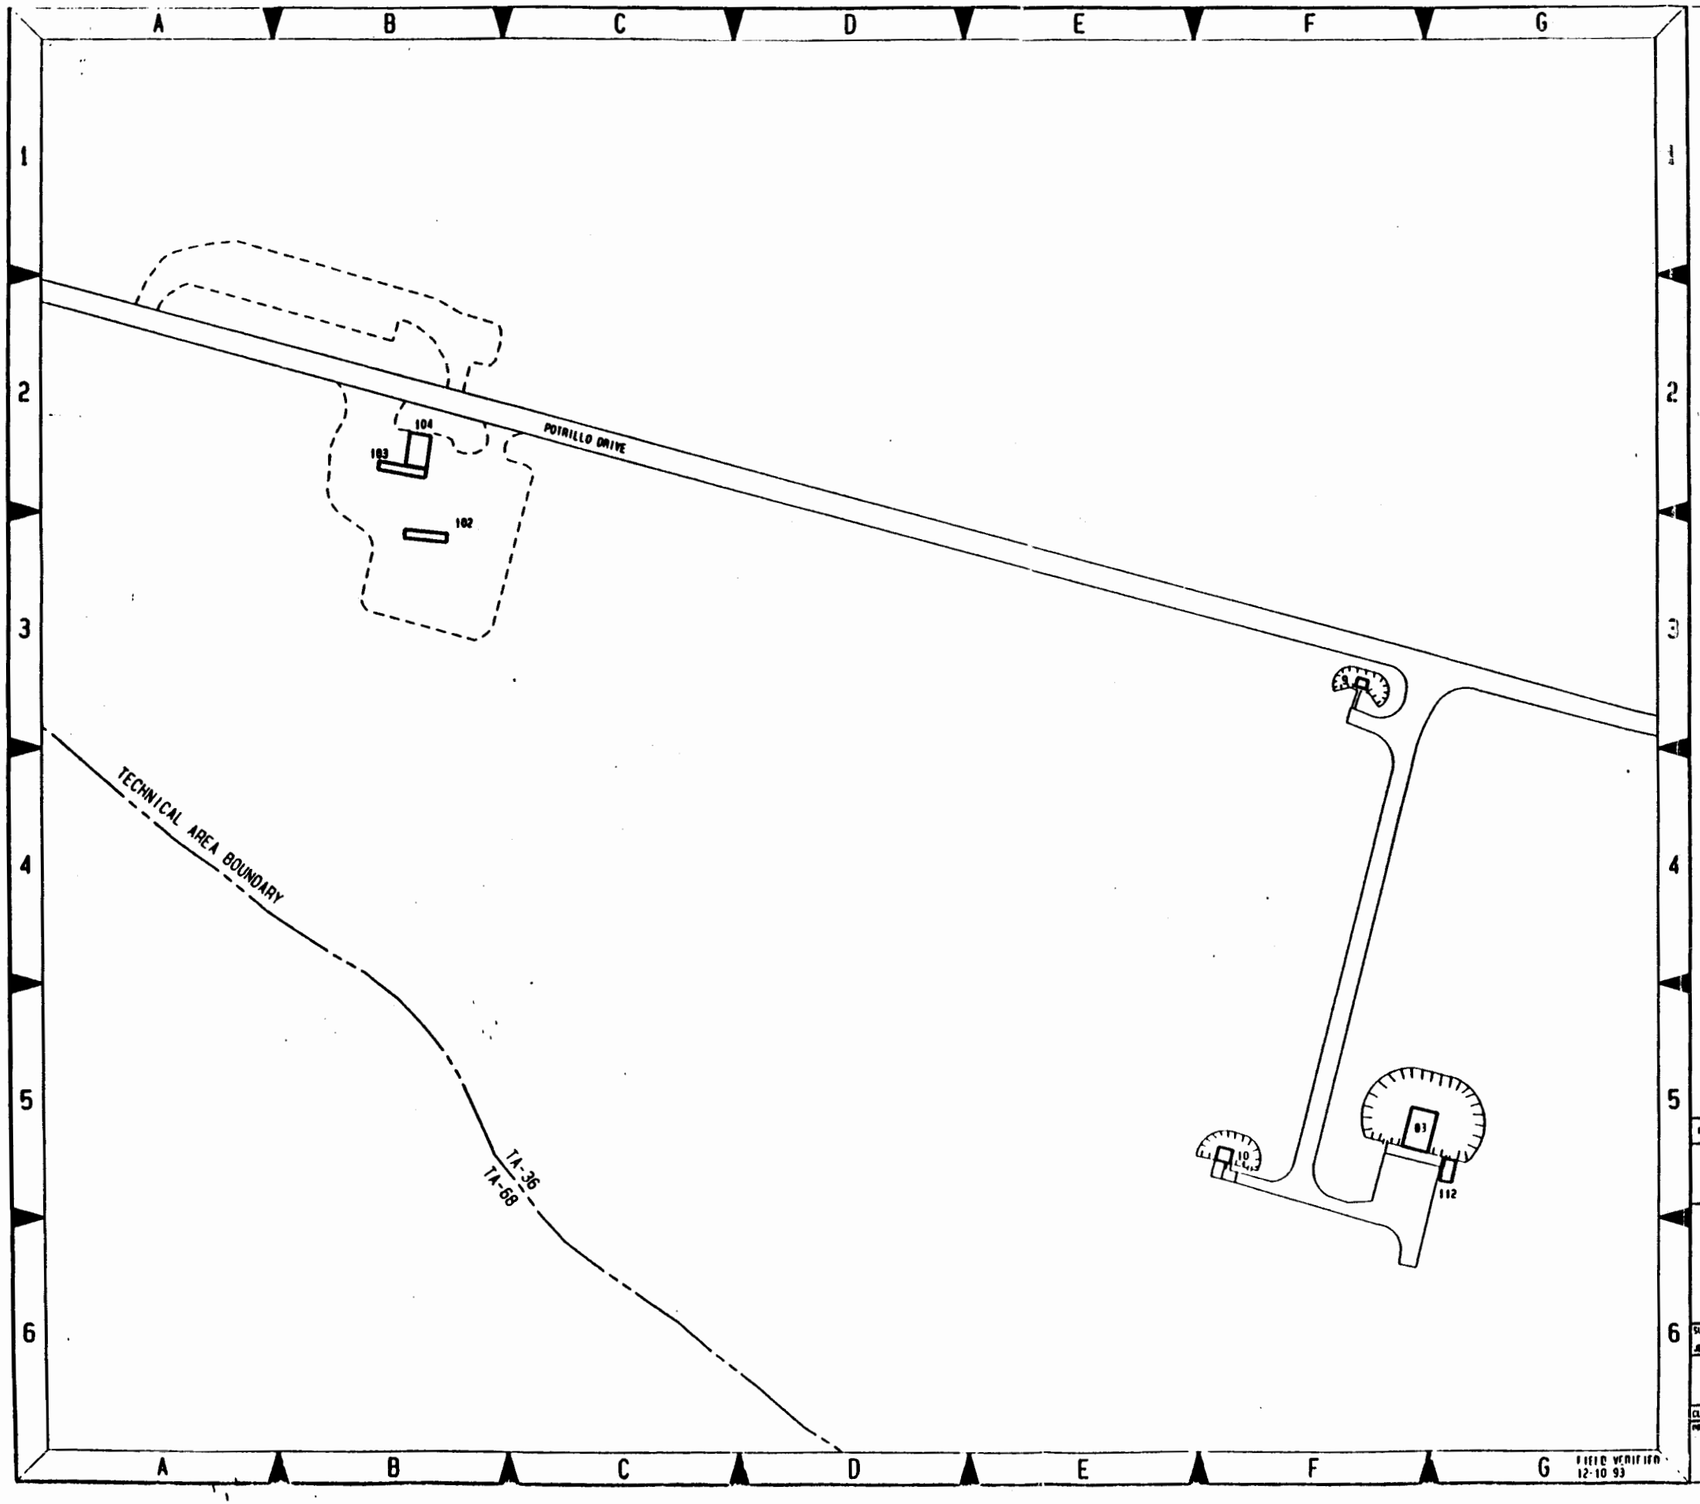

FIELD VERIFIED 12-10-93

KEY MAP

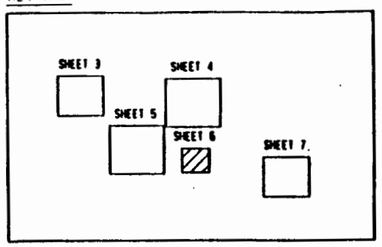

N

SCALE: 1:720

60 0 60 120

FEET

NO	DATE	CLASS REV	REVISIONS	DWN	VER	CHKD	REL	SUB	REC	APP
1	05-16-94		REVISED PER NEW STANDARDS	HNS	JPH	JPH	HNS	JAF	BEC	RAP

JOHNSON CONTROLS WORLD SERVICES INC.

AS-BUILT STRUCTURE LOCATION MAPS

TA-36

KAPPA SITE

DRAWN	J. [illegible]
VERIFIED	J. [illegible]
CHECKED	H. SALAZAR
RELEASED	H. SALAZAR
DATE	12-15-93

SUBMITTED JERRY FORTE

RECOMMENDED BRIAN COHEN

APPROVED ROBERT PROMMEL

Los Alamos — Los Alamos National Laboratory, Los Alamos, New Mexico 87545

SHEET 6 — 6 of 7

CLASSIFICATION 11 — REVIEWER H. SALAZAR — DATE 8-18-94

PROJECT ID 11952 — DRAWING NO AB28 — REV 1

020-16 ON 1

STRUCTURE LOCATION MAPS

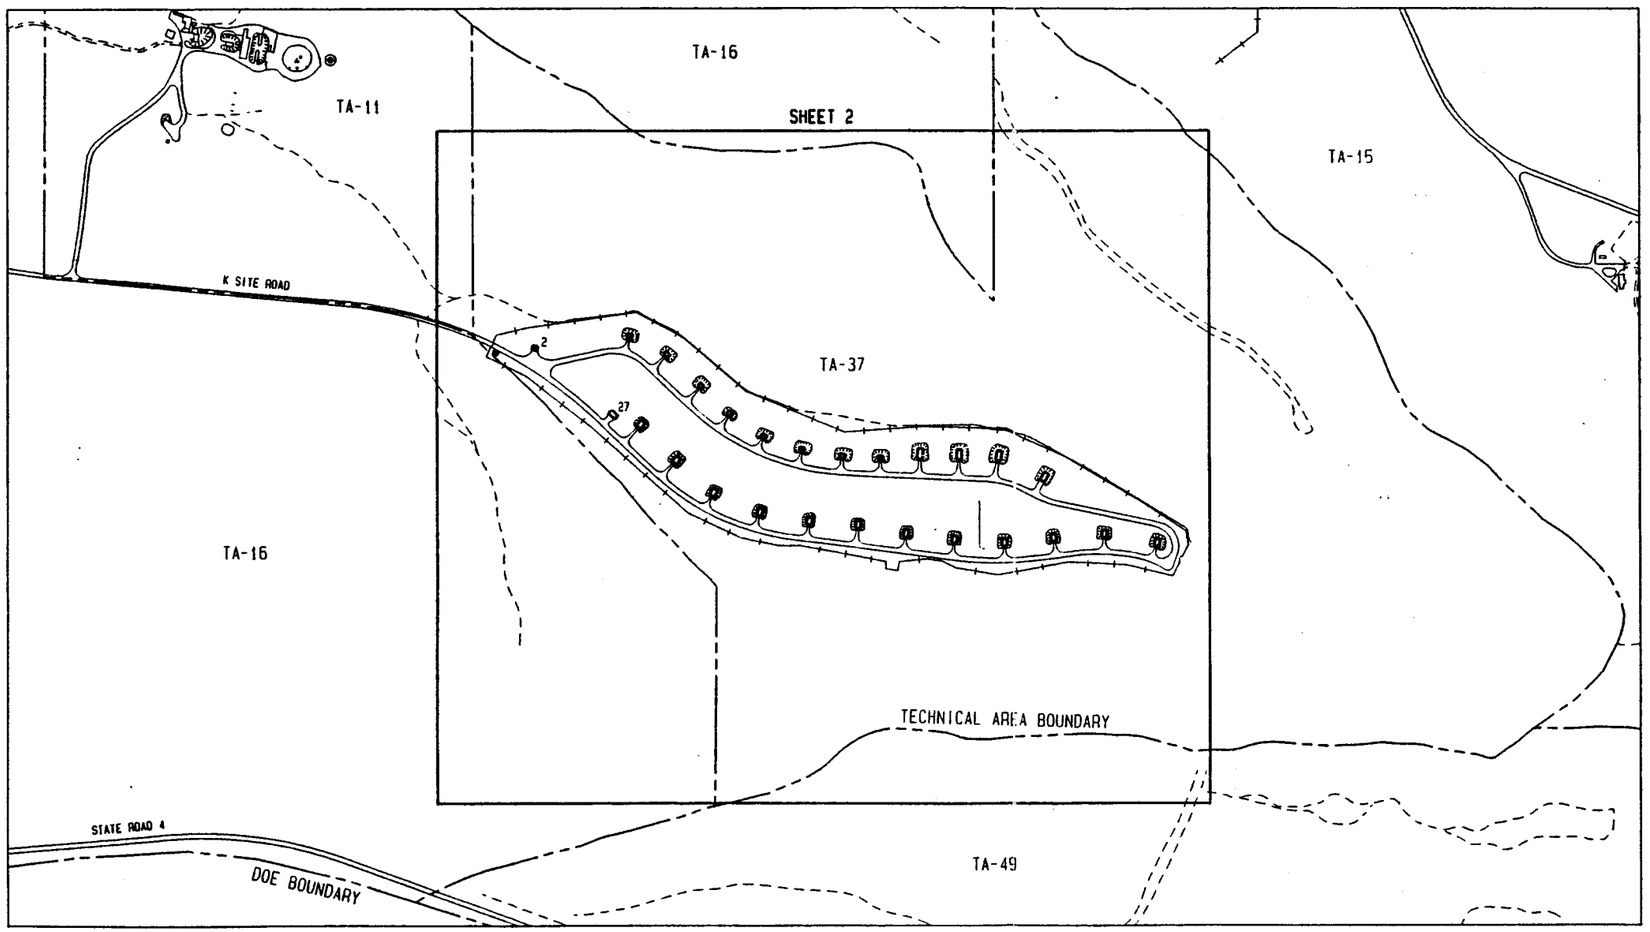

TA-37 KEY MAP

SCALE: 1:3600

300 0 300 600

FEET

N

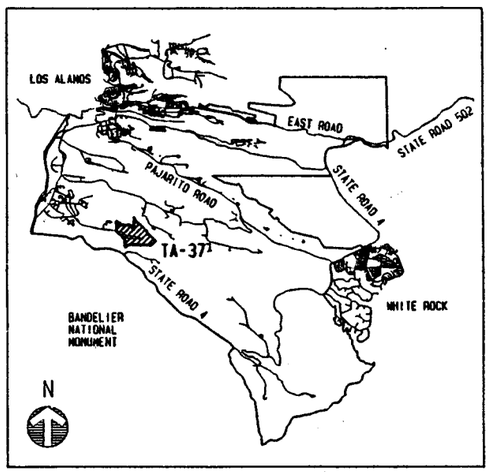

LOCATION PLAN

SCALE: NONE

NO	DATE	CLASS REV	REVISIONS	DWN	VER	CHKD	REL	SUB	REC	APP

JOHNSON CONTROLS WORLD SERVICES INC.

AS-BUILT STRUCTURE LOCATION MAPS

TA-37

MAGAZINE AREA C

DRAWN	K. SALAZAR
VERIFIED	K. SALAZAR
CHECKED	J. MORAN
RELEASED	K. SALAZAR
DATE	05-30-94

SUBMITTED JERRY FORTE — RECOMMENDED BRYAN COMER — APPROVED HUBERT PROMMEL

Los Alamos — Los Alamos National Laboratory, Los Alamos, New Mexico 87545

SHEET 1 OF 2

CLASSIFICATION U — REVIEWER K. SALAZAR — DATE 6-15-94

PROJECT ID	DRAWING NO	REV
11952	AB29	

JCT NO 91-020

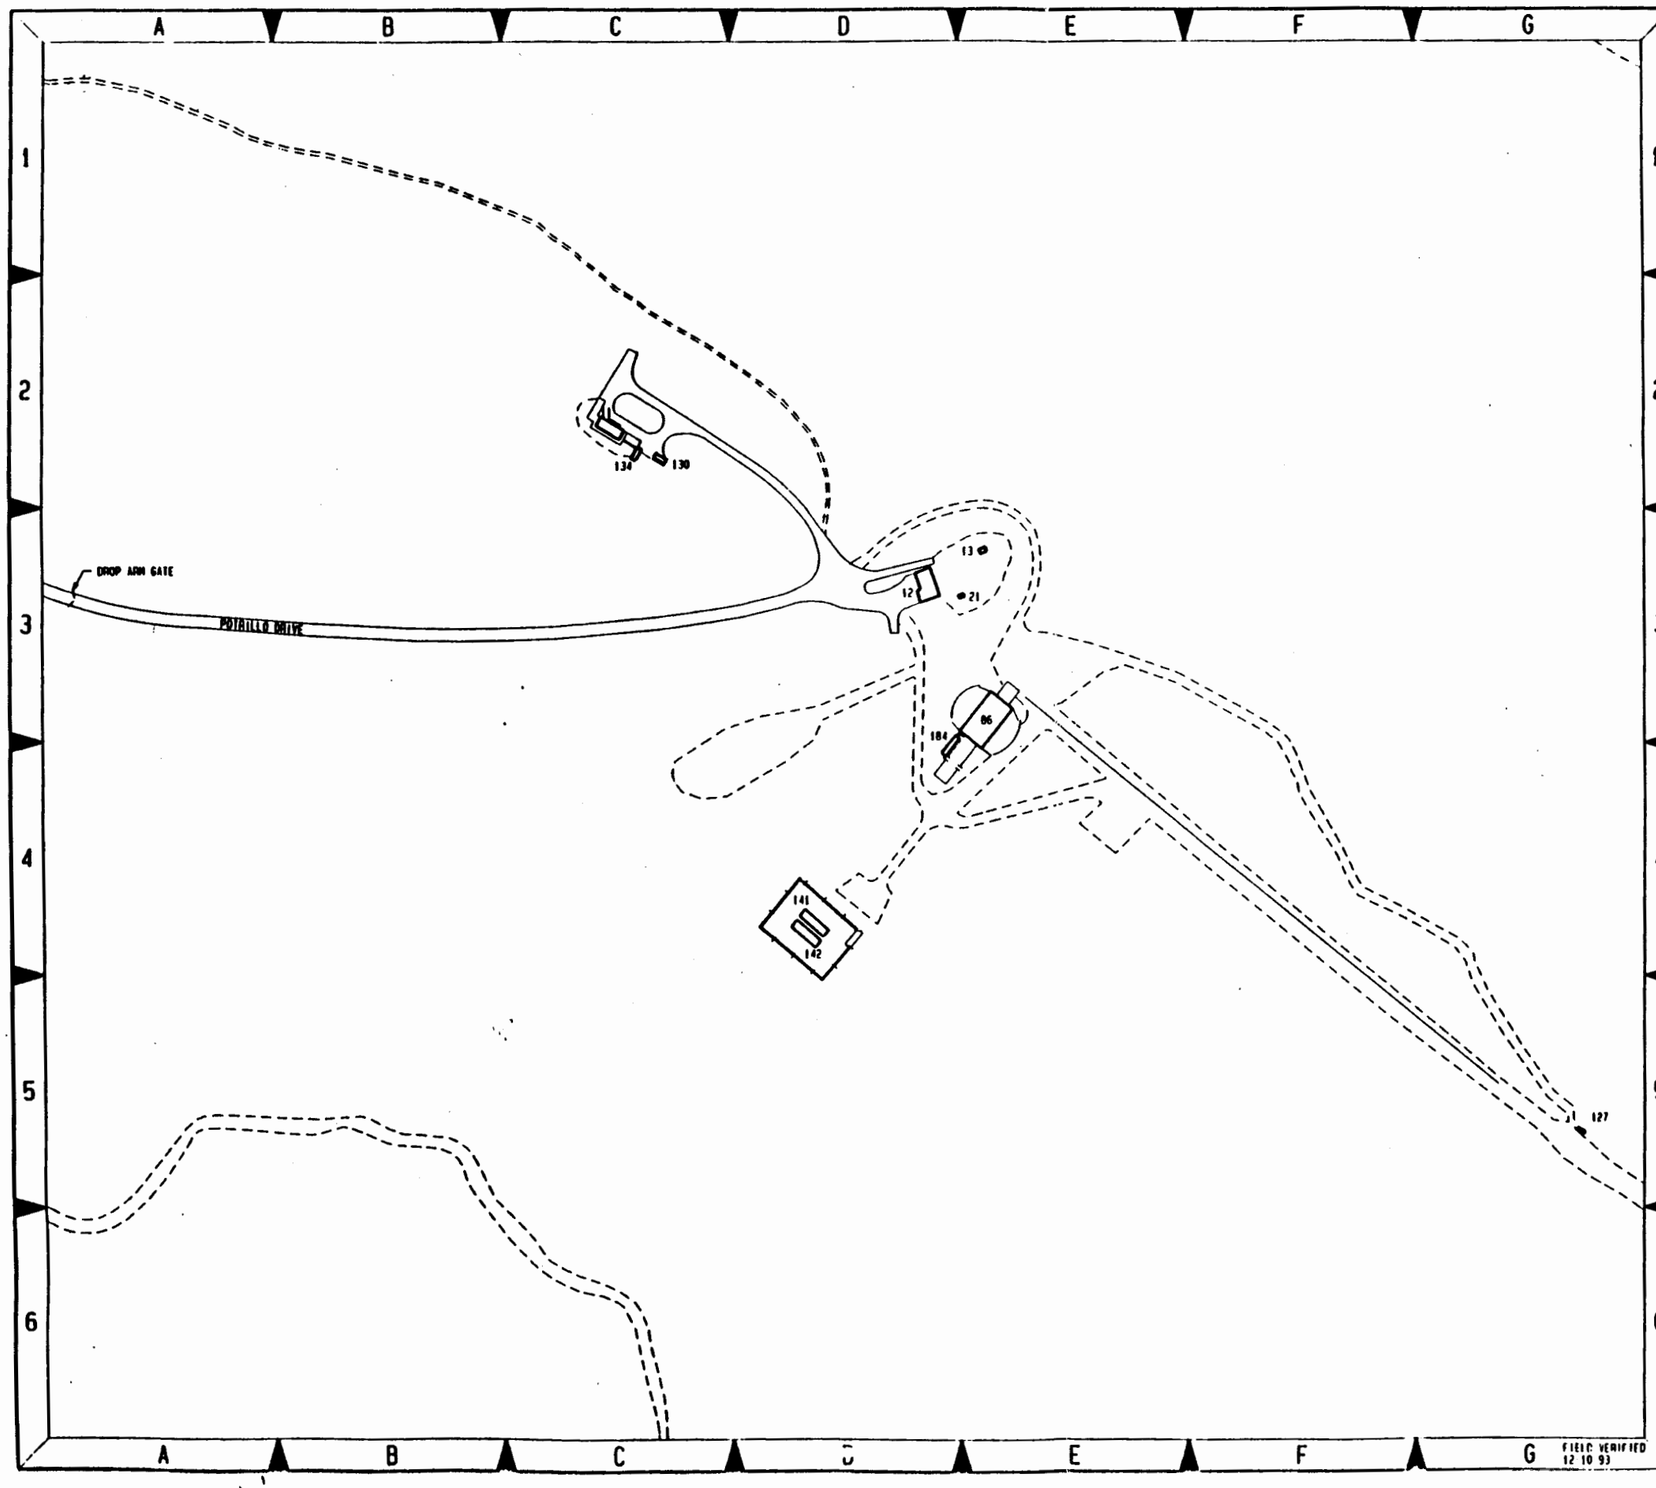

KEY MAP

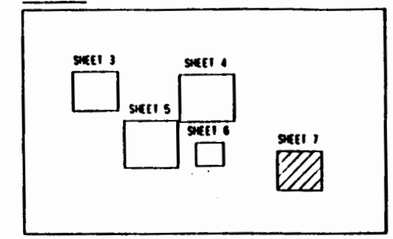

N

SCALE: 1:1200

100 0 100 200

FEET

NO	DATE	CLASS REV	REVISIONS	DWN	VER	CHKD	REL	SUB	REC	APP
1	05-16-94		REVISED PER NEW STANDARDS	HMS	JPH	JPH	HMS	JAF	BEC	RAP

JOHNSON CONTROLS WORLD SERVICES INC.

AS-BUILT STRUCTURE LOCATION MAPS

TA-36

KAPPA SITE

DRAWN J. NORK
VERIFIED J. NORK
CHECKED R. SALAZAR
RELEASED R. SALAZAR
DATE 12-15-93

SUBMITTED JERRY FORTE
RECOMMENDED BRYAN COWER
APPROVED ROBERT PROMMEL

Los Alamos — Los Alamos National Laboratory, Los Alamos, New Mexico 87545

SHEET 7 of 7

CLASSIFICATION U REVIEWER R. SALAZAR DATE 6-10-94

PROJECT ID 11952 DRAWING NO AB28 REV 1

0291-16 RW

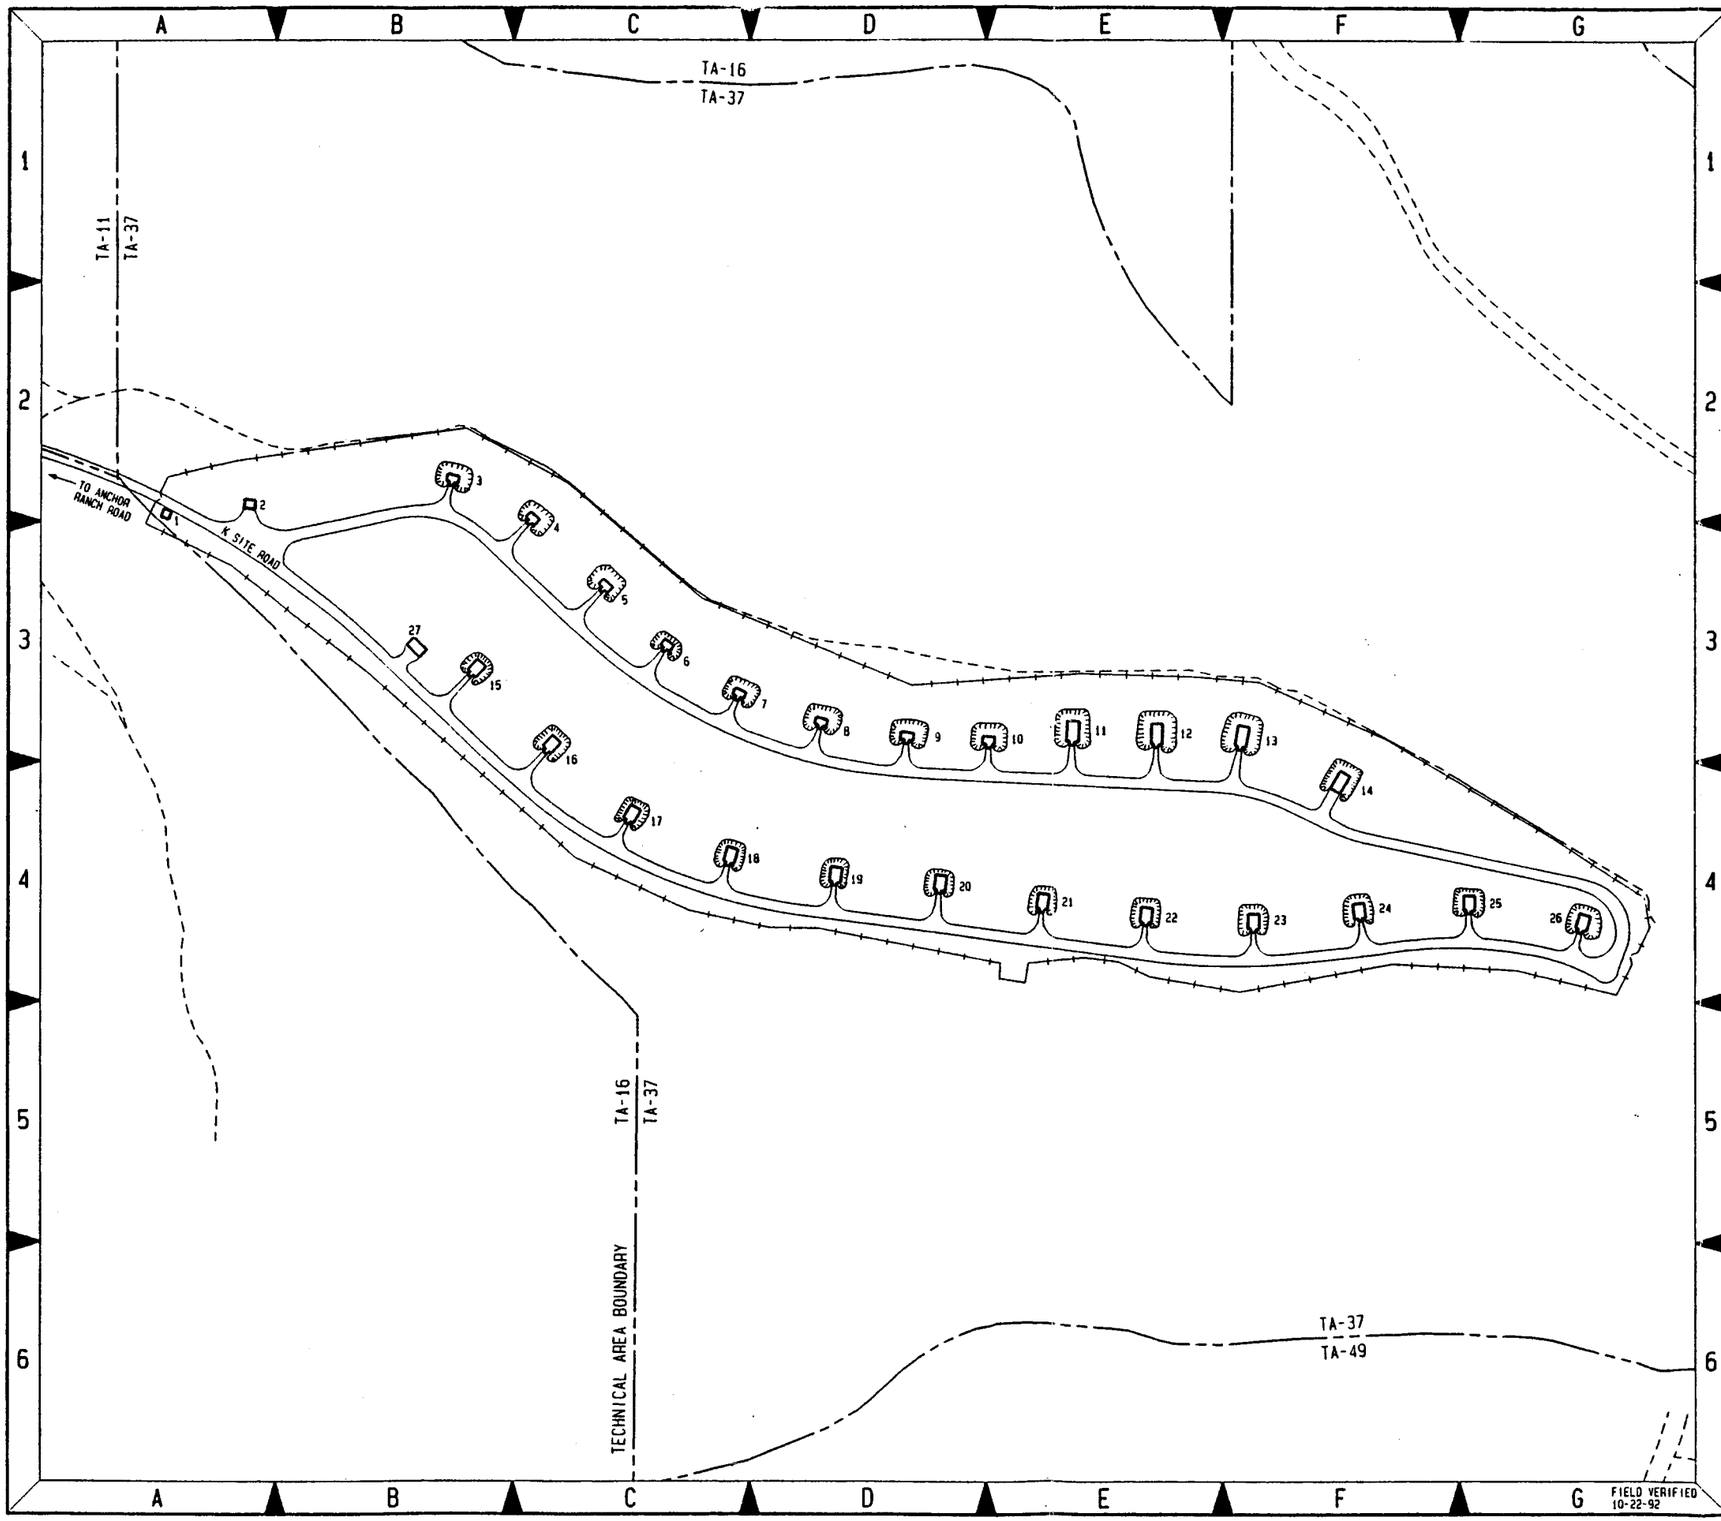

STRUCTURE LOCATION INDEX

TA-NUMBER	STRUCTURE DESIGNATION	STRUCTURE NOMENCLATURE	STRUCTURE LOCATOR SHEET NO.	STRUCTURE LOCATOR MAP KEY
37-1	MAC-1	OFFICE BUILDING	2	A-2
37-2	MAC-2	MAGAZINE	2	A-2
37-3	MAC-3	MAGAZINE	2	B-2
37-4	MAC-4	MAGAZINE	2	C-2
37-5	MAC-5	MAGAZINE	2	C-3
37-6	MAC-6	MAGAZINE	2	C-3
37-7	MAC-7	MAGAZINE	2	C-3
37-8	MAC-8	MAGAZINE	2	D-3
37-9	MAC-9	MAGAZINE	2	D-3
37-10	MAC-10	MAGAZINE	2	E-3
37-11	MAC-11	MAGAZINE	2	E-3
37-12	MAC-12	MAGAZINE	2	E-3
37-13	MAC-13	MAGAZINE	2	F-3
37-14	MAC-14	MAGAZINE	2	F-4
37-15	MAC-15	MAGAZINE	2	B-3
37-16	MAC-16	MAGAZINE	2	C-3
37-17	MAC-17	MAGAZINE	2	C-4
37-18	MAC-18	MAGAZINE	2	C-4
37-19	MAC-19	MAGAZINE	2	D-4
37-20	MAC-20	MAGAZINE	2	D-4
37-21	MAC-21	MAGAZINE	2	E-4
37-22	MAC-22	MAGAZINE	2	E-4
37-23	MAC-23	MAGAZINE	2	F-4
37-24	MAC-24	MAGAZINE	2	F-4
37-25	MAC-25	MAGAZINE	2	G-4
37-26	MAC-26	MAGAZINE	2	G-4
37-27	MAC-27	STORAGE BUILDING	2	B-3

N

SCALE: 1:1680

140 0 140 280

FEET

NO	DATE	CLASS REV	REVISIONS	DWN	VER	CHKD	REL	SUB	REC	APP
1	05-30-94		REVISED PER NEW STANDARDS	HMS	JPM	CPM	HMS	JAF	REC	RAP

JOHNSON CONTROLS WORLD SERVICES INC.

AS-BUILT STRUCTURE LOCATION MAPS

TA-37

MAGAZINE AREA C

DRAWN J. HORK

VERIFIED J. HORK

CHECKED H. SALAZAR

RELEASED H. SALAZAR

DATE 11-25-92

SUBMITTED JERRY FORTE

RECOMMENDED BRYAN COWEN

APPROVED ROBERT PROMMEL

Los Alamos National Laboratory
Los Alamos, New Mexico 87545

SHEET 2 OF 2

CLASSIFICATION U REVIEWER H. SALAZAR DATE 6-15-92

PROJECT ID 11952

DRAWING NO AB29

REV 1

JCI NO 91-020

TA-39

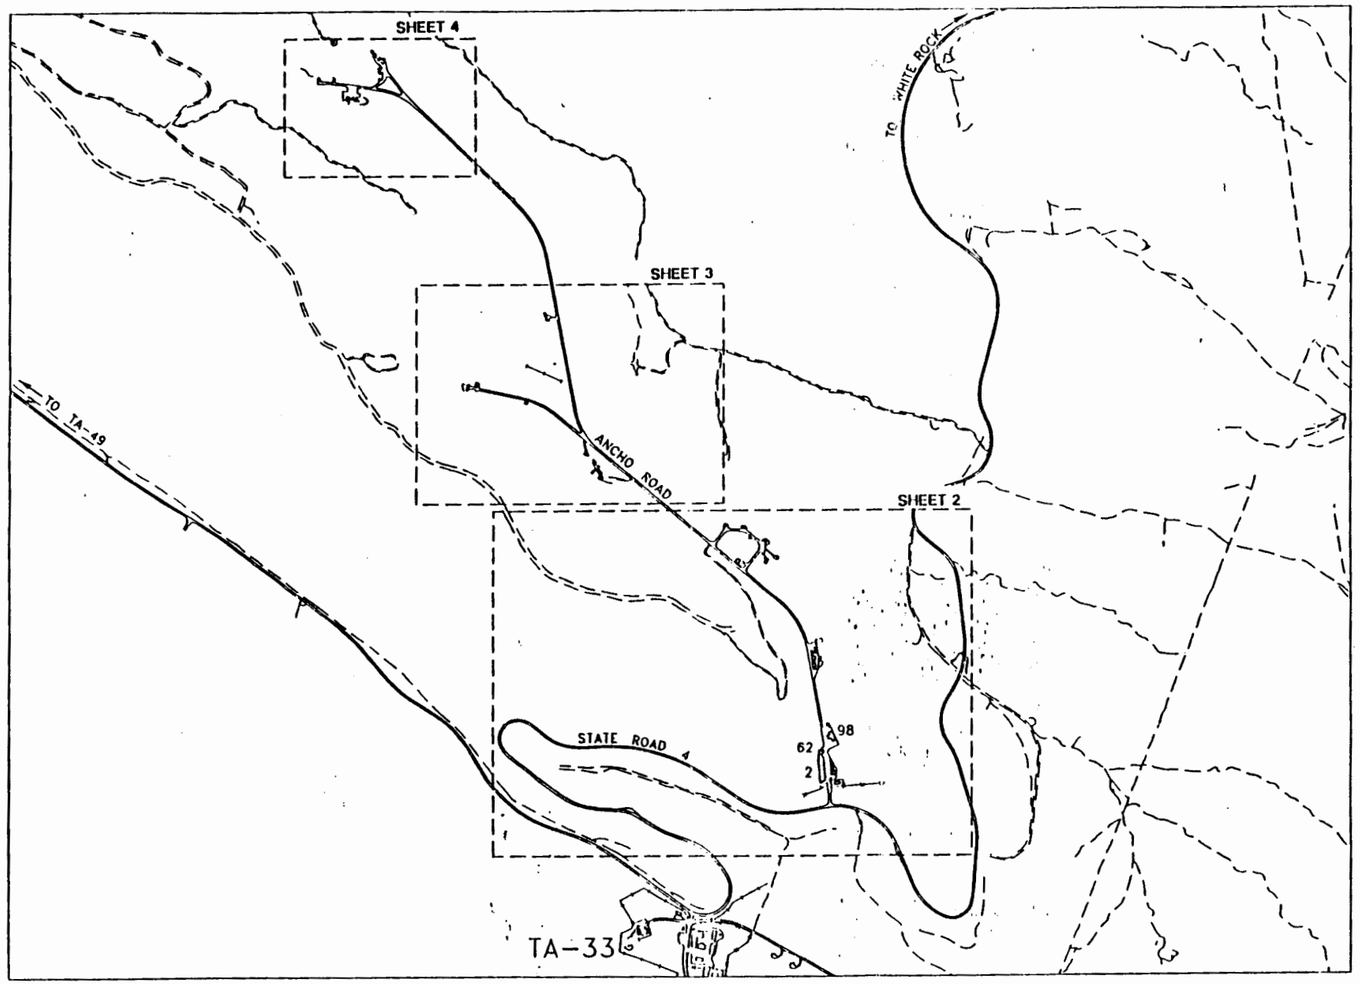

SCALE 1: 8400

700 0 700 1400 FEET

N

LATEST DISTRIBUTION

30SEPT92

EMERGENCY RESPONSE MAP

UPDATED DRAWING

AUTOGIS

STRUCTURE NUMBER INDEX

STRUCTURE TA-NUMBER	STRUCTURE DESIGNATION	STRUCTURE NOMENCLATURE	STRUCTURE LOCATOR SHEET NO.	STRUCTURE LOCATOR MAP KEY
39- 2	AC- 2	LABORATORY & OFFICE BLDG.	2	E-4
39- 3	AC- 3	MAIN MAGAZINE	2	D-1
39- 4	AC- 4	TRIM BUILDING	2	D-1
39- 5	AC- 5	READY MAGAZINE	2	D-1
39- 6	AC- 6	FIRING CHAMBER NO.1	3	B-3
39- 7	AC- 7	FIRING CHAMBER NO.2	4	D-1
39- 8	AC- 8	FIRING CHAMBER NO.3	4	B-2
39- 9	AC- 9	HOSE HOUSE	2	E-4
39- 10	AC- 10	HOSE HOUSE	2	E-4
39- 54	39- 54	TRANSPORTAINER	4	D-2
39- 56	AC- 56	GUN BUILDING	3	C-1
39- 57	AC- 57	FIRING CHAMBER	4	D-1
39- 62	AC- 62	STORAGE BUILDING	2	E-4
39- 63	AC- 63	EQUIPMENT SHELTER	3	C-3
39- 64	AC- 64	EQUIPMENT SHELTER	3	C-1
39- 66	AC- 66	BARRICADE	4	D-2
39- 67	AC- 67	CAPACITOR BANK ENCLOSURE	3	B-3
39- 68	AC- 68	STORAGE BUILDING	2	D-1
39- 69	AC- 69	LIGHT, GAS GUN FACILITY	2	E-3
39- 77	AC- 77	MAGAZINE	2	E-1
39- 88	AC- 88	FIRING CHAMBER	4	C-3
39- 89	AC- 89	GAS GUN SUPPORT BLDG.	2	E-3
39- 95	AC- 95	CAPACITOR BANK BUNKER	4	C-3
39- 96	AC- 96	UTILITY TUNNEL	4	C-3
39- 97	AC- 97	TRAILER BAY	4	C-3
39- 98	AC- 98	BRANCH SHOP BUILDING	2	E-4
39-100	AC-100	TRANSPORTABLE OFFICE BLDG.	2	E-4
39-101	AC-101	TRAILER LABORATORY	3	E-5
39-103	AC-103	TRANSPORTABLE OFFICE BLDG.	2	E-4
39-107	AC-107	TRANSPORTABLE OFFICE BLDG.	2	F-4
39-111	39-111	PULSED POWER BLDG.	2	D-1
39-115	39-115	TRANSPORTAINER	3	E-5
39-116	39-116	TRANSPORTAINER	3	E-5
39-119	39-119	TRANSPORTAINER	3	E-5
39-121	39-121	TRANSPORTAINER	3	E-5
39-122	39-122	TRANSPORTAINER	4	D-2
39-123	39-123	TRANSPORTAINER	2	E-3
39-124	39-124	TRANSPORTAINER	2	E-4
39-125	39-125	EXPERIMENTAL TRAILER	2	E-4
39-137	39-137	SHED	3	C-1
39-138	39-138	SOURCE BUILDING	3	B-3
39-139	39-139	SHED	3	D-4
39-141	39-141	CONTAMINATED OIL STORAGE	3	E-5
39-142	39-142	DRUM STORAGE	3	E-5
39-143	39-143	EXPERIMENTAL BUILDING	2	D-1
39-144	39-144	SHED	2	E-3
39-146	39-146	PASSAGEWAY	2	E-3
39-147	39-147	TRANSPORTAINER	3	C-1
39-148	39-148	TRANSPORTAINER	3	C-1
39-150	39-150	TRANSPORTAINER	2	E-4
39-151	39-151	EXPERIMENTAL TRAILER	2	E-4

NO	DATE	LAST REV.	REVISIONS	DWN	DES	CKD	REL	SUB	REC	APP

FACILITIES ENGINEERING DIVISION

STRUCTURE LOCATION MAP

TA-39

ANCHO CANYON SITE

DRAWN	C.SANDOVAL
DESIGN	
CHECKED	B. COWER
RELEASED	B. COWER
DATE	03-18-91

BLDG.

SUBMITTED | RECOMMENDED | APPROVED

LOS ALAMOS — LOS ALAMOS NATIONAL LABORATORY, LOS ALAMOS, NEW MEXICO 87545

SHEET 1 OF 4

CLASSIFICATION U REVIEWER DATE

LAB JOB NO.

DRAWING NO. ENG-R 5120

REV. 18

TA-39

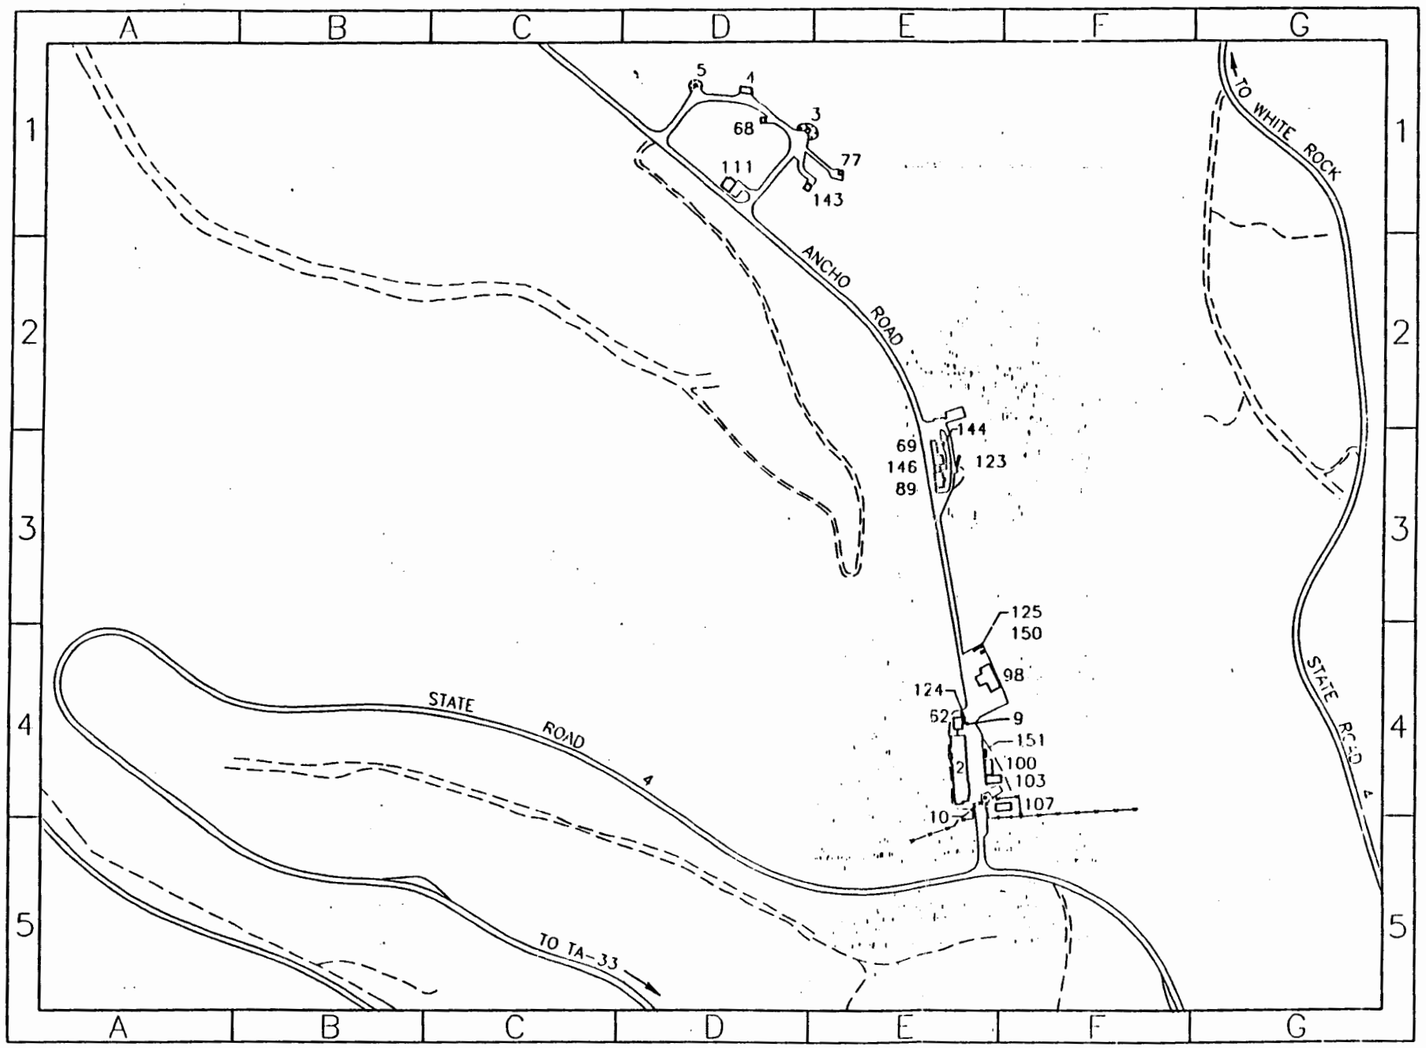

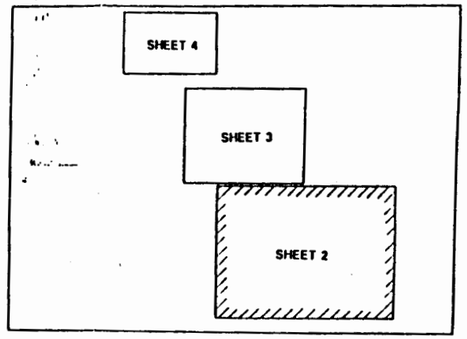

TA-39 MAP GUIDE

N

SCALE 1: 3000

250 0 250 500 FEET

LATEST DISTRIBUTION
30 SEPT 92
EMERGENCY RESPONSE MAP
UPDATED DRAWING

NO.	DATE	CLASS REV.	REVISIONS	DWN	DES	CPD	PEL	SUB	PEC	APP

FACILITIES ENGINEERING DIVISION

STRUCTURE LOCATION MAP
TA-39
ANCHO CANYON SITE

DRAWN	C. SANDOVAL
DESIGN	
CHECKED	B. COMER
RELEASED	B. COMER
DATE	03-18-91

BLDG.

SUBMITTED RECOMMENDED APPROVED

LOS ALAMOS — LOS ALAMOS NATIONAL LABORATORY, LOS ALAMOS, NEW MEXICO 87545

SHEET 2 OF 4

CLASSIFICATION U REVIEWER DATE 4-15-91

LAB JOB NO.

DRAWING NO. ENG-R 5120

REV. 18

AUTOCIS

TA-39

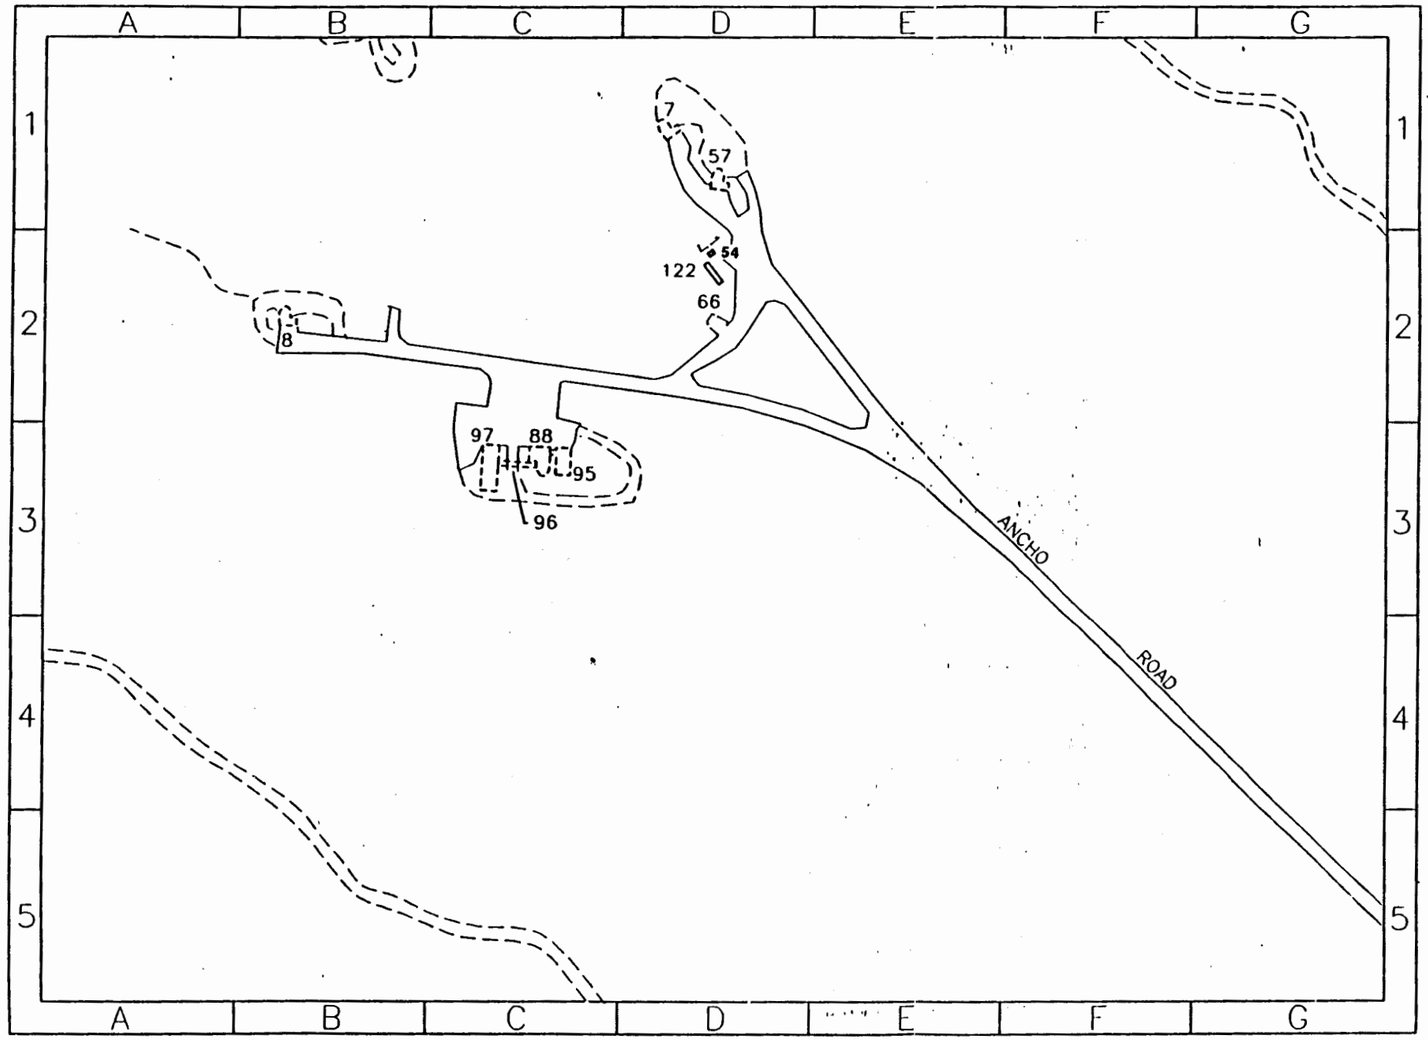

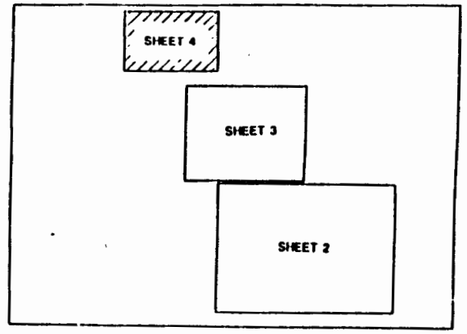

TA-39 MAP GUIDE

SCALE 1: 1200

100 0 100 200 FEET

N

LATEST DISTRIBUTION
30SEPT92
EMERGENCY RESPONSE MAP
UPDATED DRAWING

AUTOCIS

NO.	DATE	TASS REV.	REVISIONS	DWN	DES	CKD	REL	SUB	REC	APP

FACILITIES ENGINEERING DIVISION

STRUCTURE LOCATION MAP
TA-39
ANCHO CANYON SITE

DRAWN	C. SANDOVAL
DESIGN	
CHECKED	B. COWER
RELEASED	B. COWER
DATE	03-18-91

BLDG.
SUBMITTED / RECOMMENDED / APPROVED

LOS ALAMOS
LOS ALAMOS NATIONAL LABORATORY
LOS ALAMOS, NEW MEXICO 87545

SHEET 4 OF 4

CLASSIFICATION U REVIEWER DATE 4-15-91

LAB JOB NO.

DRAWING NO. ENG-R 5120

REV. 18

TA-39

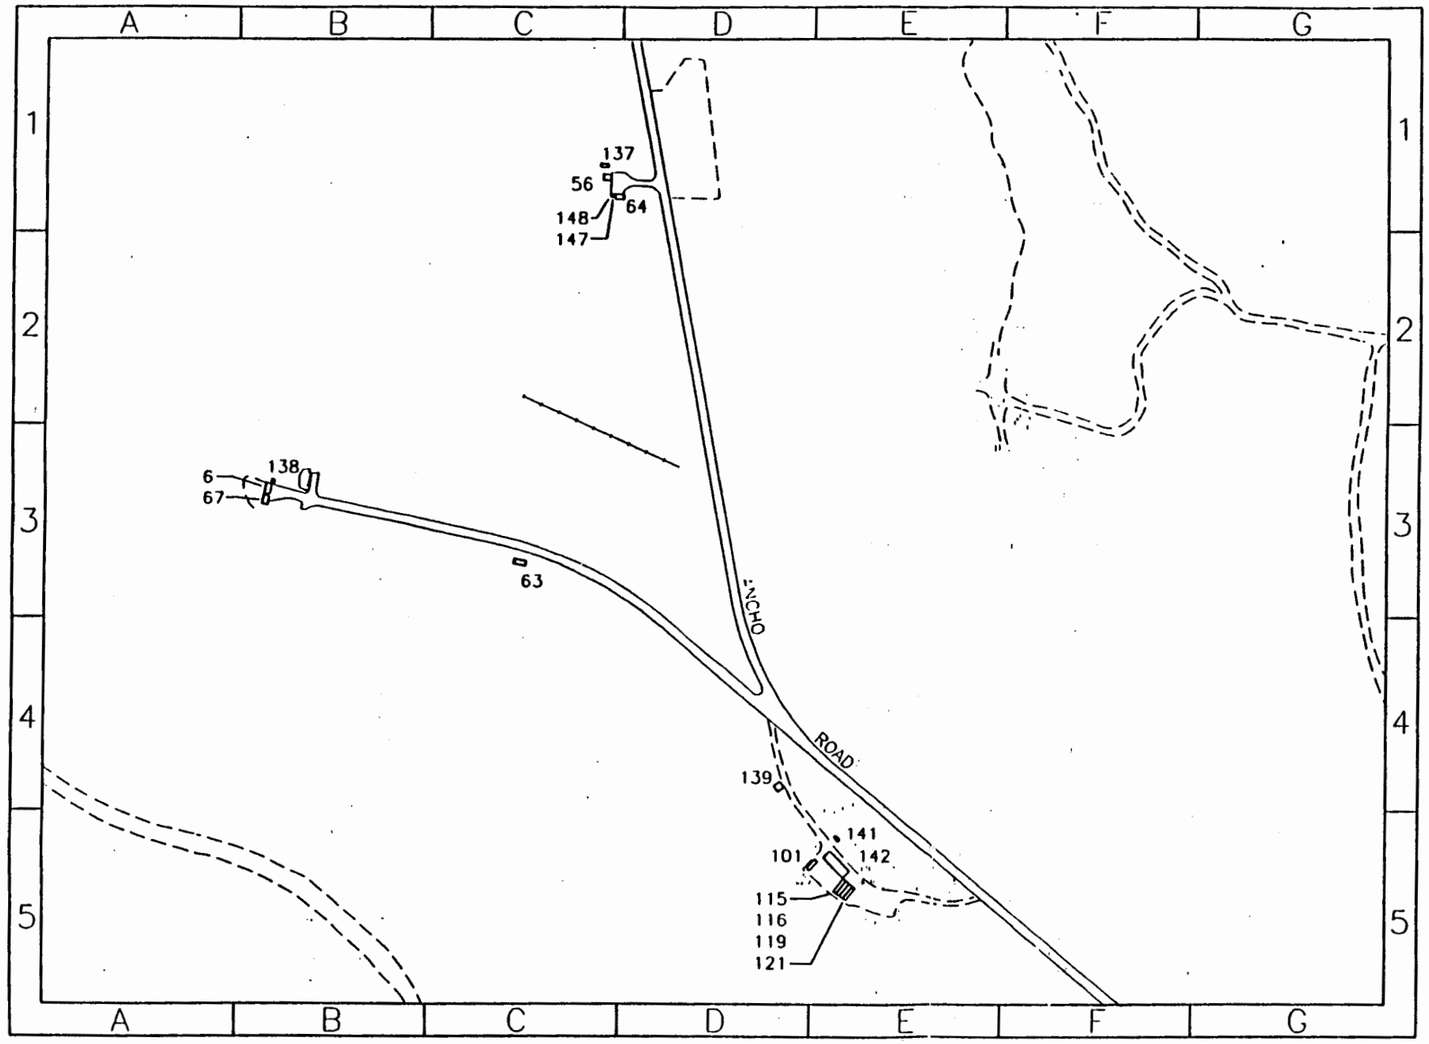

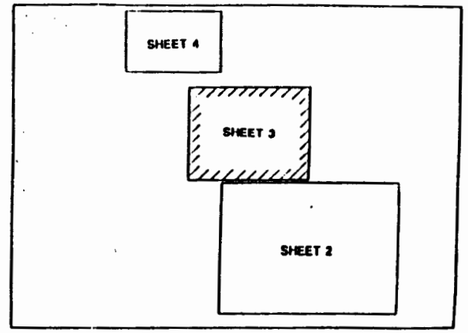

TA-39 MAP GUIDE

SCALE 1: 1920

160 0 160 320 FEET

N

LATEST DISTRIBUTION
30SEPT92
EMERGENCY RESPONSE MAP
UPDATED DRAWING

NO.	DATE	CLAS REV	REVISIONS	DWN	DES	CKD	REL	SUB	REC	APP

FACILITIES ENGINEERING DIVISION

STRUCTURE LOCATION MAP
TA-39
ANCHO CANYON SITE

DRAWN	C.SANDOVAL
DESIGN	
CHECKED	B. COWER
RELEASED	B. COWER
DATE	03-18-91

BLDG.
SUBMITTED / RECOMMENDED / APPROVED

LOS ALAMOS — LOS ALAMOS NATIONAL LABORATORY, LOS ALAMOS, NEW MEXICO 87545

SHEET 3 OF 4

CLASSIFICATION U — REVIEWER — DATE

LAB JOB NO. — DRAWING NO. ENG-R 5120 — REV. 18

AUTOCIS

STRUCTURE LOCATION MAPS

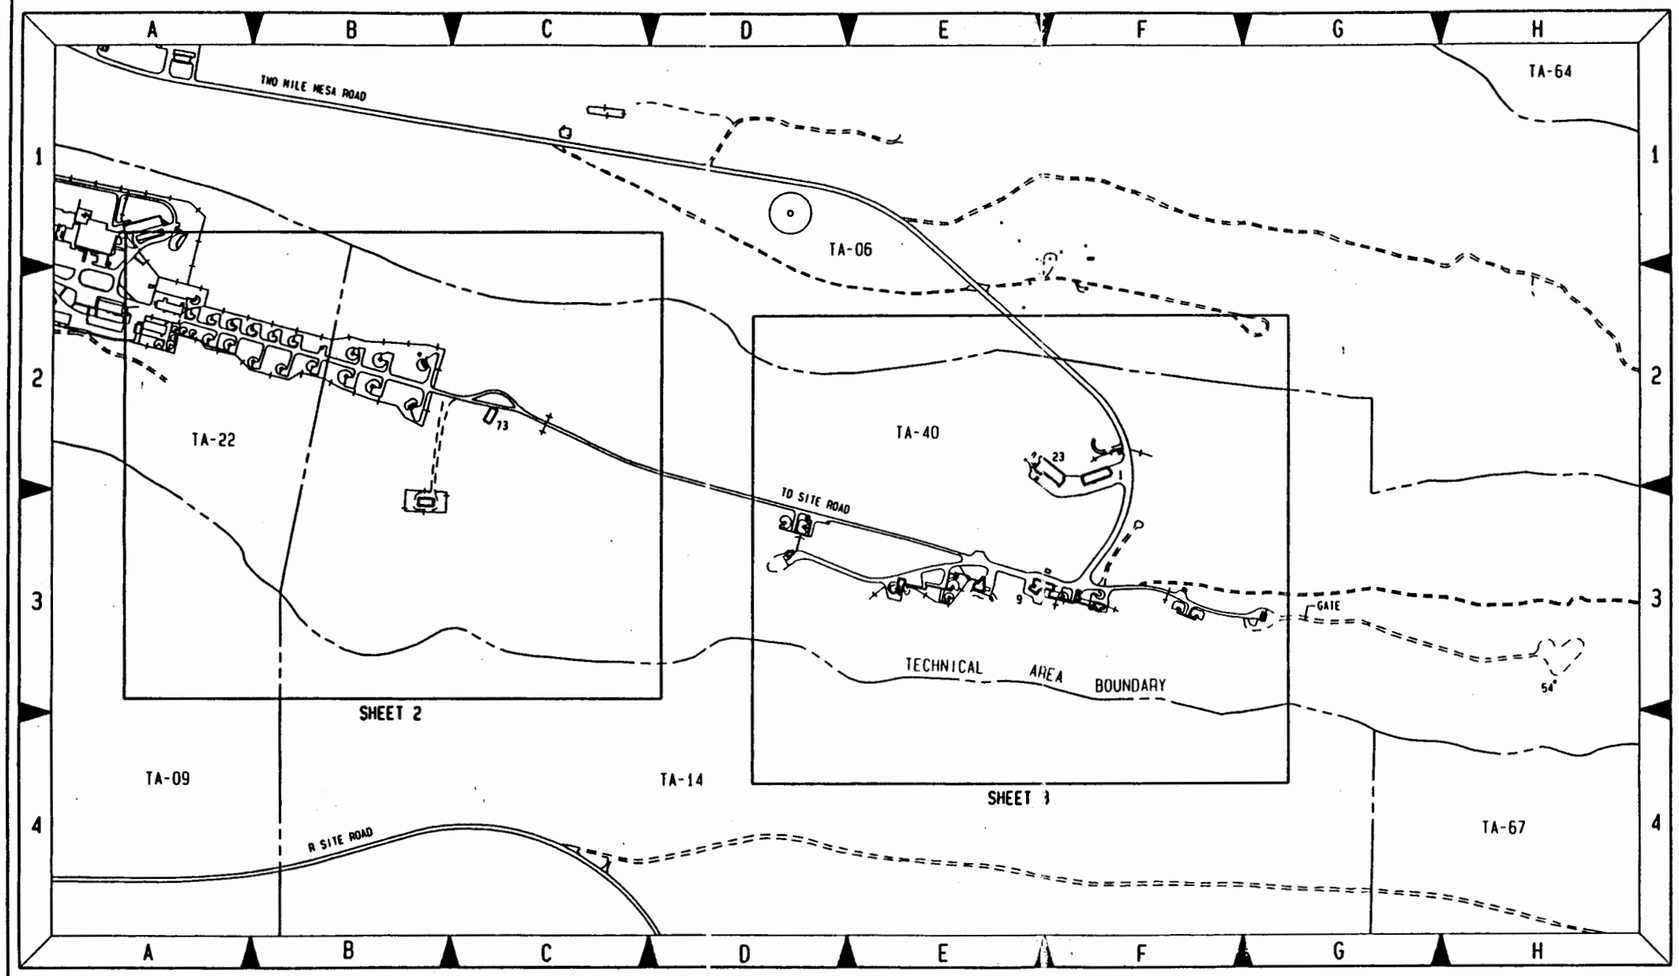

TA-40 KEY MAP

SCALE: 1:3600

300 0 300 600

FEET

N

FIELD VERIFIED 01-14-94

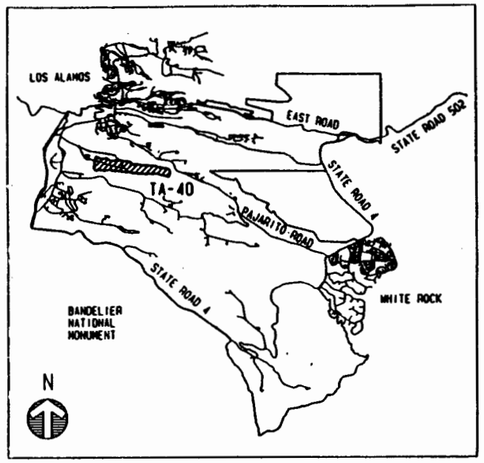

LOCATION PLAN

SCALE: NONE

NO	DATE	CLASS REV	REVISIONS	DRW	VER	CHKD	REL	SUB	REC	APP

JOHNSON CONTROLS WORLD SERVICES INC.

AS-BUILT STRUCTURE LOCATION MAPS

TA-40

DF SITE

DRAWN	J. HORNFELD
VERIFIED	J. HORNFELD
CHECKED	H. SALAZAR
RELEASED	H. SALAZAR
DATE	01-20-94

SUBMITTED: LARRY FORTE

RECOMMENDED: BRIAN COHEN

APPROVED: ROBERT PROMEL

Los Alamos

Los Alamos National Laboratory
Los Alamos, New Mexico 87545

SHEET 1 / 3

CLASSIFICATION U REVIEWER H. SALAZAR DATE

PROJECT ID 11952

DRAWING NO AB31

REV

JCI 91-020

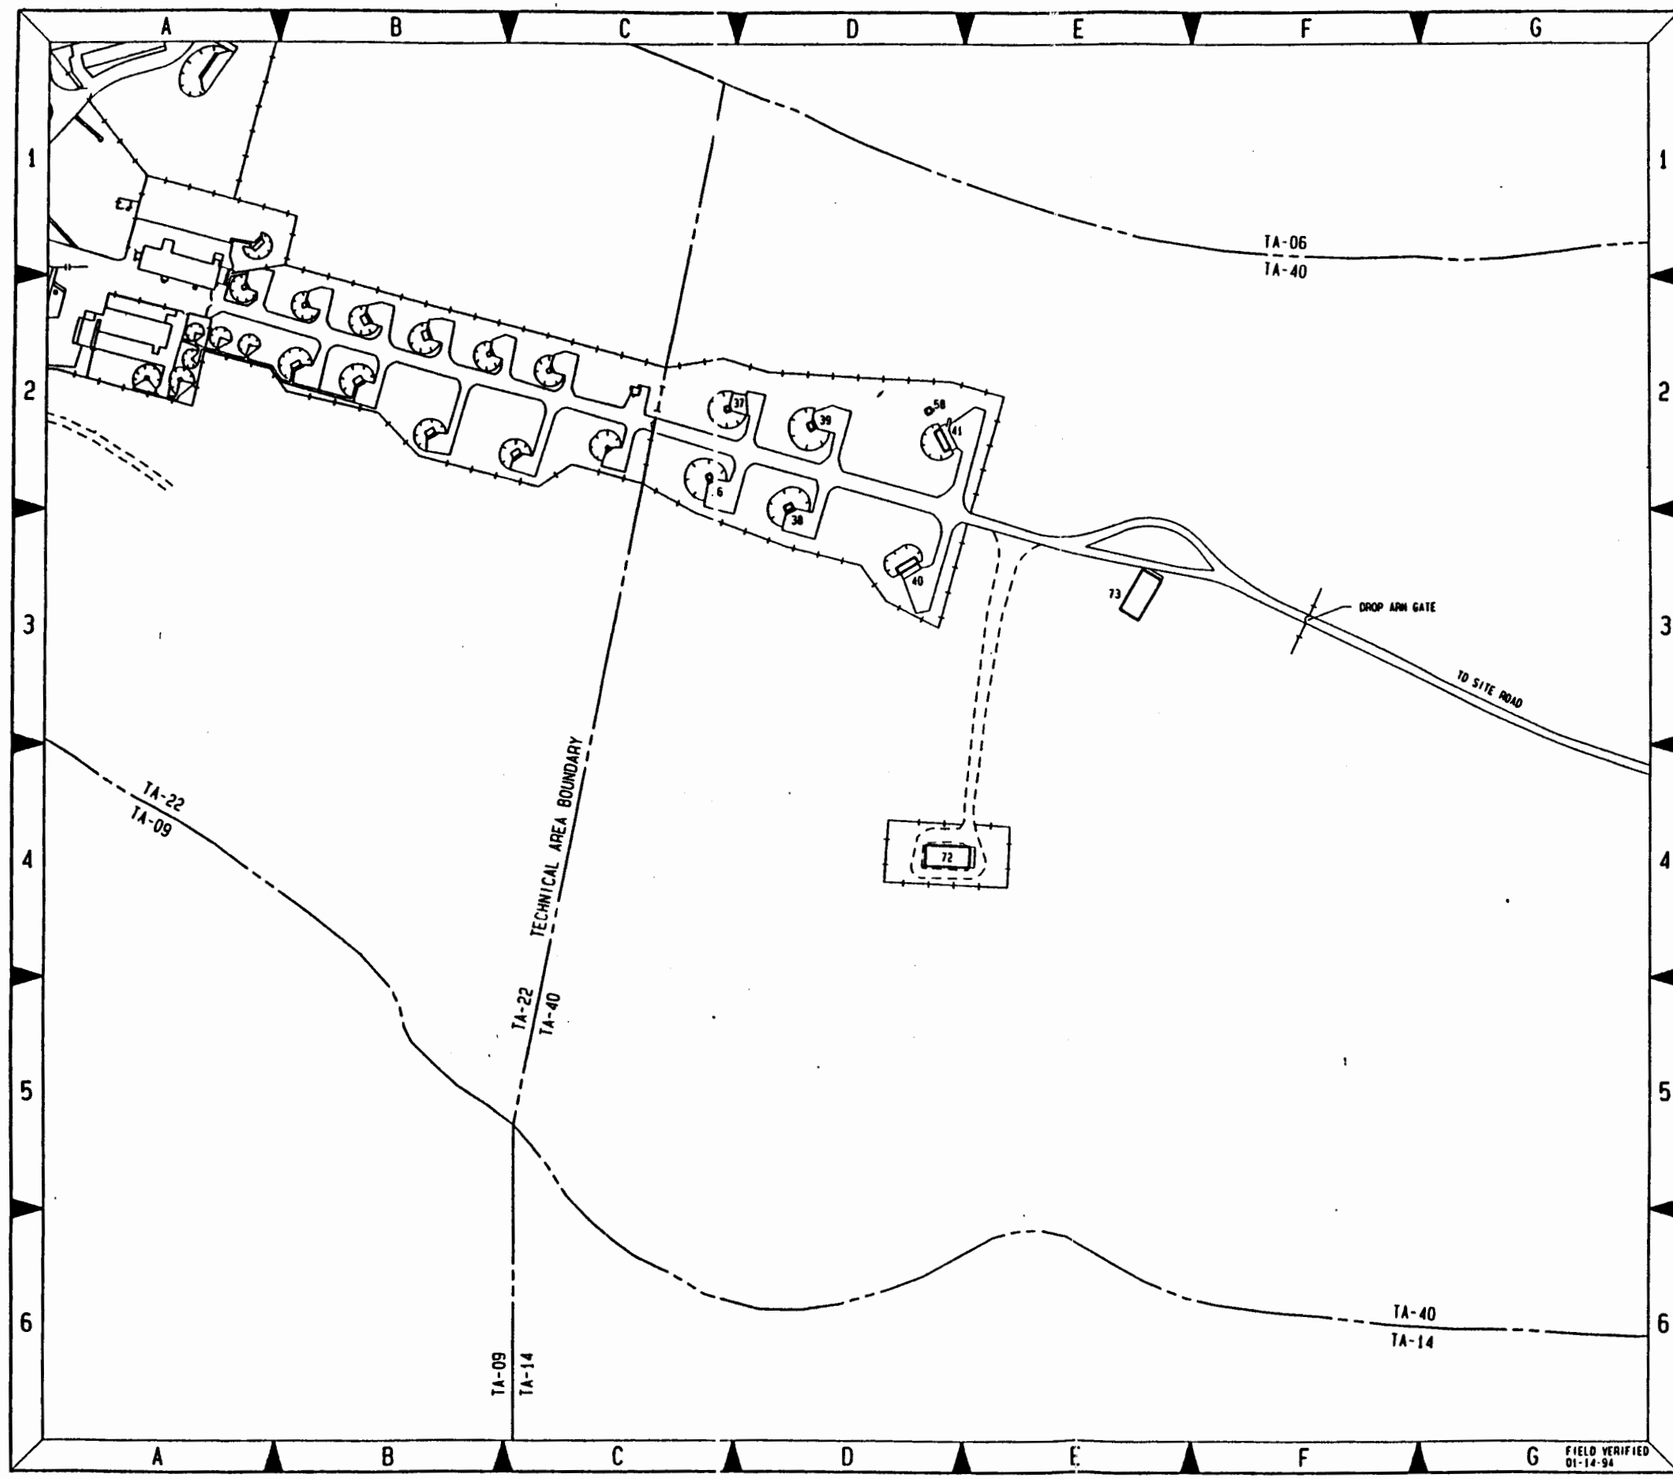

KEY MAP

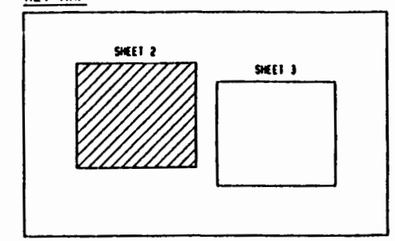

STRUCTURE LOCATION INDEX

STRUCTURE TA-NUMBER	STRUCTURE DESIGNATION	STRUCTURE NOMENCLATURE	STRUCTURE LOCATOR SHEET NO.	STRUCTURE LOCATOR MAP KEY
40-1	DF-1	LABORATORY & OFFICE BUILDING	3	E-3
40-2	DF-2	MAGAZINE	3	A-3
40-3	DF-3	PREPARATION BUILDING	3	A-3
40-4	DF-4	FIRING POINT	3	A-4
40-5	DF-5	FIRING POINT	3	B-4
40-6	DF-6	PREPARATION BUILDING	3	C-4
40-7	DF-7	MAGAZINE	3	C-4
40-8	DF-8	FIRING POINT	3	C-4
40-9	DF-9	FIRING POINT	3	D-4
40-10	DF-10	MAGAZINE	3	E-4
40-11	DF-11	PREPARATION & UTIL. BUILDING	3	E-4
40-12	DF-12	FIRING POINT	3	E-4
40-13	DF-13	MAGAZINE	3	F-4
40-14	DF-14	PREPARATION BUILDING	3	F-4
40-15	DF-15	FIRING POINT	3	G-4
40-16	DF-16	UTILITY BUILDING	3	A-3
40-17	DF-17	UTILITY BUILDING	3	C-4
40-18	DF-18	UTILITY BUILDING	3	F-4
40-19	DF-19	OFFICE & LAB BUILDING	3	E-2
40-23	DF-23	MACHINE SHOP	3	D-2
40-36	DF-36	MAGAZINE	2	C-2
40-37	DF-37	MAGAZINE	2	C-2
40-38	DF-38	MAGAZINE	2	D-2
40-39	DF-39	MAGAZINE	2	D-2
40-40	DF-40	MAGAZINE	2	D-3
40-41	DF-41	LABORATORY BUILDING	2	D-2
40-43	DF-43	STORAGE BUILDING	3	E-4
40-45	DF-45	SOLVENT SHED	3	D-3
40-54	40-54	OBSERVATION BARRICADE	1	H-3
40-58	40-58	EQUIPMENT BUILDING	2	D-2
40-64	40-64	TRANSPORTAINER	3	A-3
40-72	40-72	STORAGE BUILDING	2	D-4
40-73	40-73	STORAGE BUILDING	2	E-3

N

SCALE: 1:1200

100 0 100 200

FEET

NO	DATE	CLASS REV	REVISIONS	DWN	VER	CHKD	REL	SUB	REC	APP

JOHNSON CONTROLS WORLD SERVICES INC.

AS-BUILT STRUCTURE LOCATION MAPS

TA-40

DF SITE

DRAWN	J. MORE
VERIFIED	J. MORE
CHECKED	H. SALAZAR
RELEASED	H. SALAZAR
DATE	01-20-94

SUBMITTED JERRY FORTE

RECOMMENDED BRIAN COHEN

APPROVED ROBERT PROMMEL

Los Alamos — Los Alamos National Laboratory, Los Alamos, New Mexico 87545

SHEET 2 / 3

CLASSIFICATION U — REVIEWER H. SALAZAR — DATE 01-20-94

PROJECT ID 11952 — DRAWING NO AB31 — REV

JCI NO 91-020

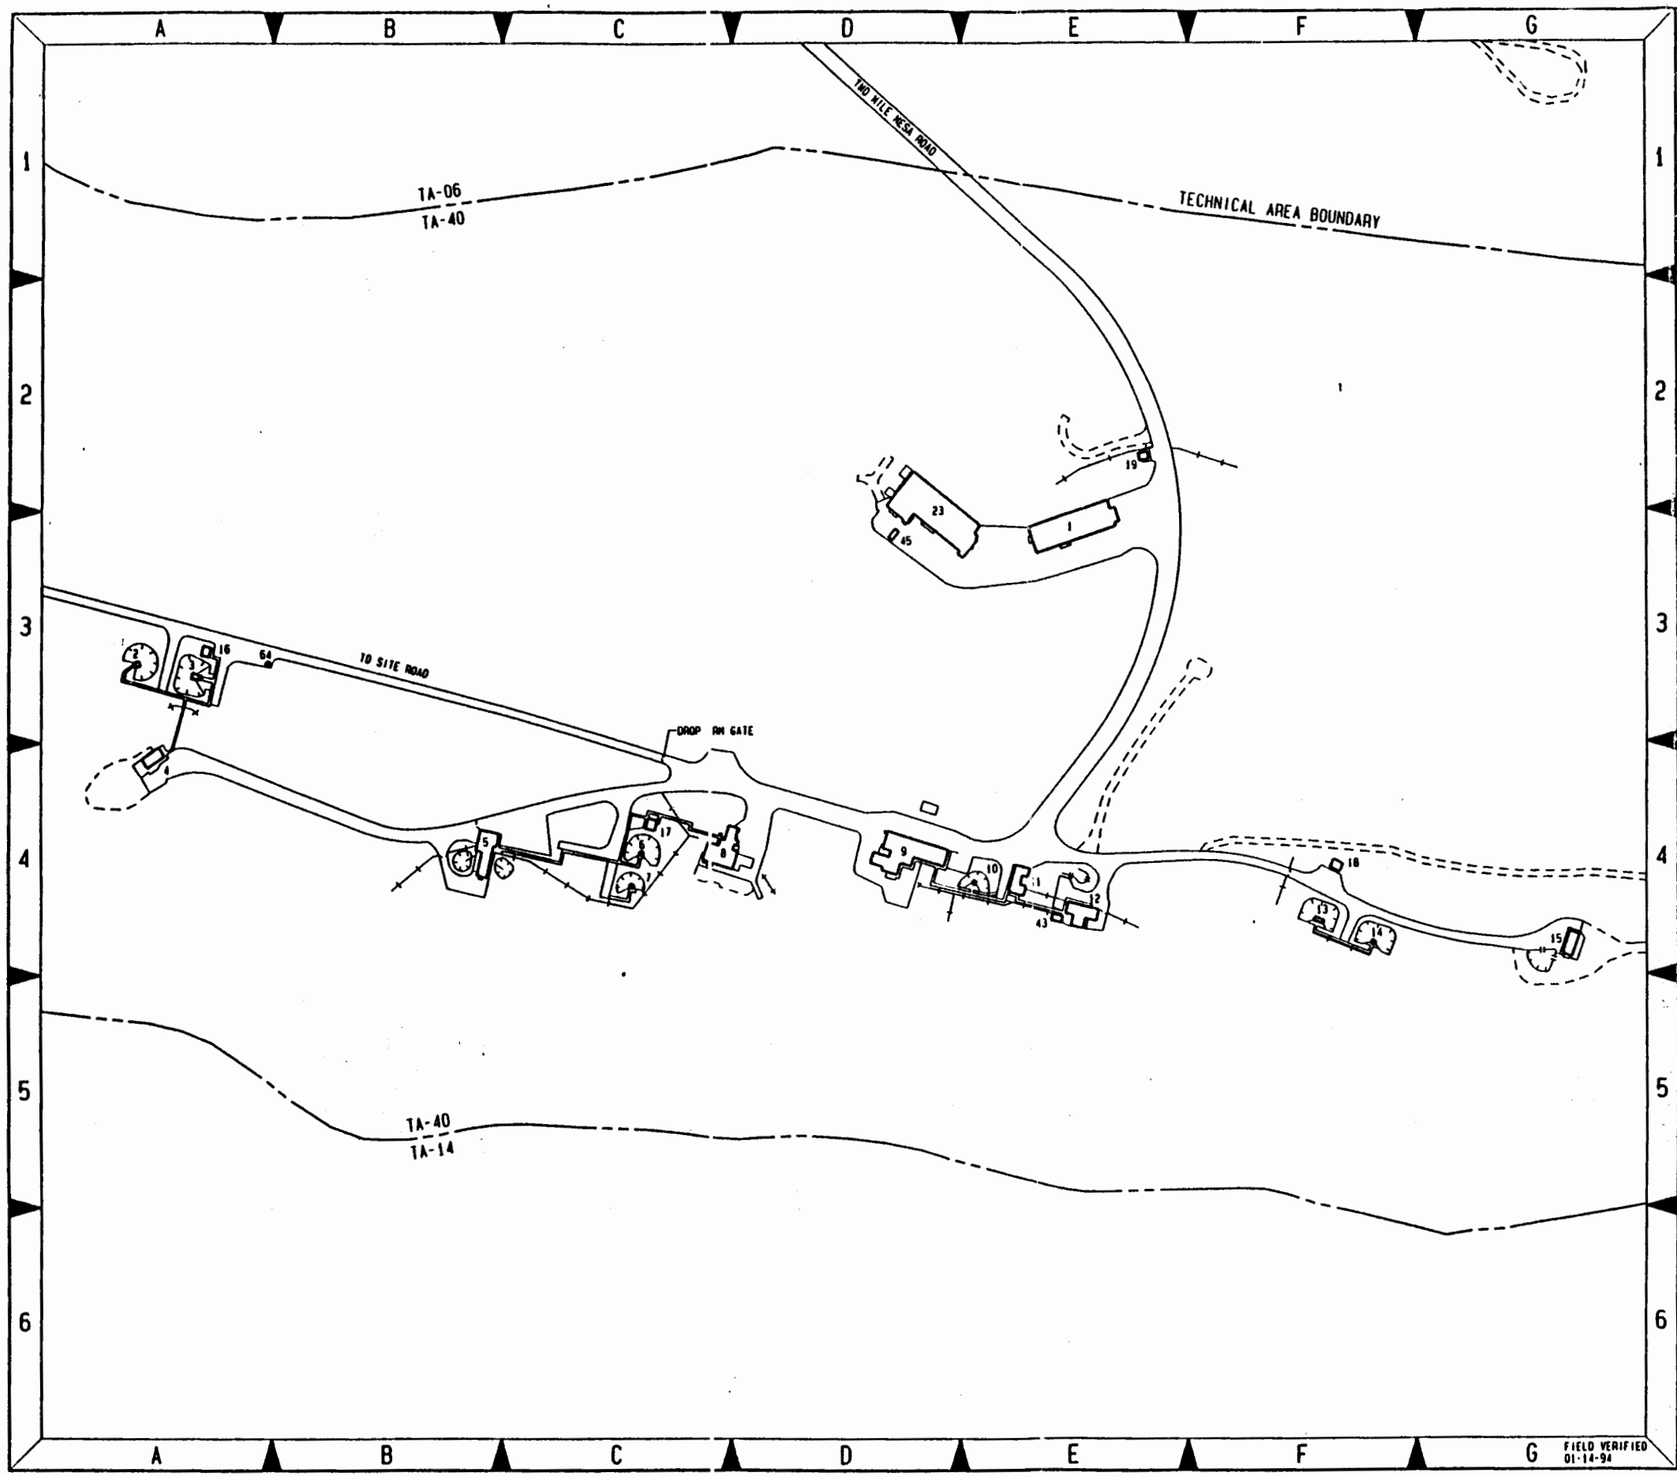

KEY MAP

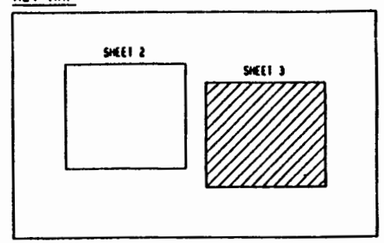

N

SCALE: 1:1200

100 0 100 200

FEET

NO	DATE	CLASS REV	REVISIONS	DWN	VER	CHKD	REL	SUB	REC	APP

JOHNSON CONTROLS WORLD SERVICES INC.

AS-BUILT STRUCTURE LOCATION MAPS

TA-40

DF SITE

DRAWN	J. HORK
VERIFIED	J. HORK
CHECKED	N. SALAZAR
RELEASED	N. SALAZAR
DATE	01-20-94

SUBMITTED JERRY FORTE — RECOMMENDED BRYAN COHEN — APPROVED ROBERT PRONNEL

Los Alamos — Los Alamos National Laboratory, Los Alamos, New Mexico 87545

SHEET 3 — 3 of 3

CLASSIFICATION — REVIEWER N. SALAZAR — DATE

PROJECT ID 11952 — DRAWING NO AB31 — REV

JCI NO 91-020

STRUCTURE LOCATION MAPS

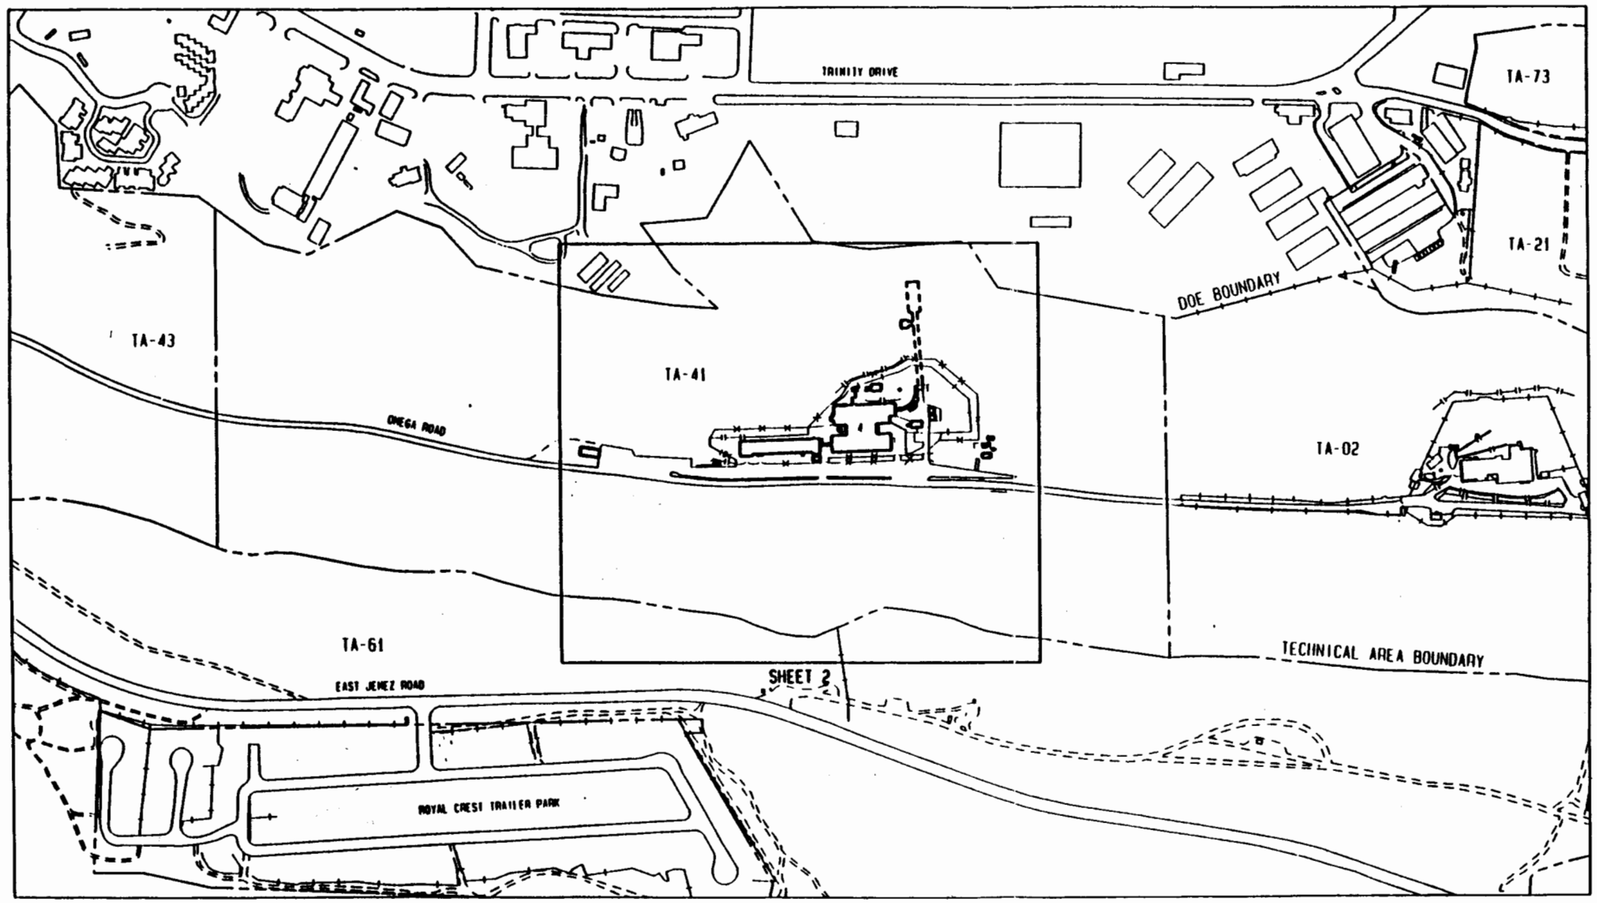

TA-41 KEY MAP

SCALE: 1:2400

200 0 200 400

FEET

N

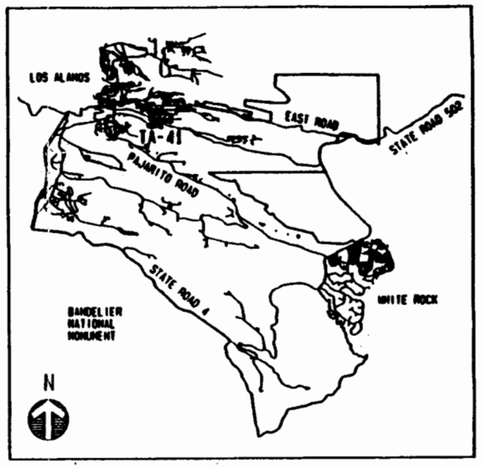

LOCATION PLAN

SCALE: NONE

NO	DATE	CLASS REV	REVISIONS	DWN	VER	CHKD	REL	SUB	REC	APP
1	05-16-94		REVISED PER NEW STANDARDS	DMB	JPH	HNS	HNS	JAF	BEC	RAP

JOHNSON CONTROLS WORLD SERVICES INC.

AS-BUILT STRUCTURE LOCATION MAPS

TA-41

W SITE

DRAWN J. [illegible]
VERIFIED R. SENA / J. [illegible]
CHECKED C. SANDOVAL
RELEASED H. SALAZAR
DATE 10-21-93

SUBMITTED JENNIE [illegible]
RECOMMENDED BRYAN COHEN [illegible]
APPROVED ROBERT PRUNNEL [illegible]

Los Alamos — Los Alamos National Laboratory, Los Alamos, New Mexico 87545

SHEET 1 / 2

CLASSIFICATION U — REVIEWER H. SALAZAR [illegible] — DATE 5-17-94

PROJECT ID 11952 — DRAWING NO AB32 — REV 1

DCD-16 ON 91-020

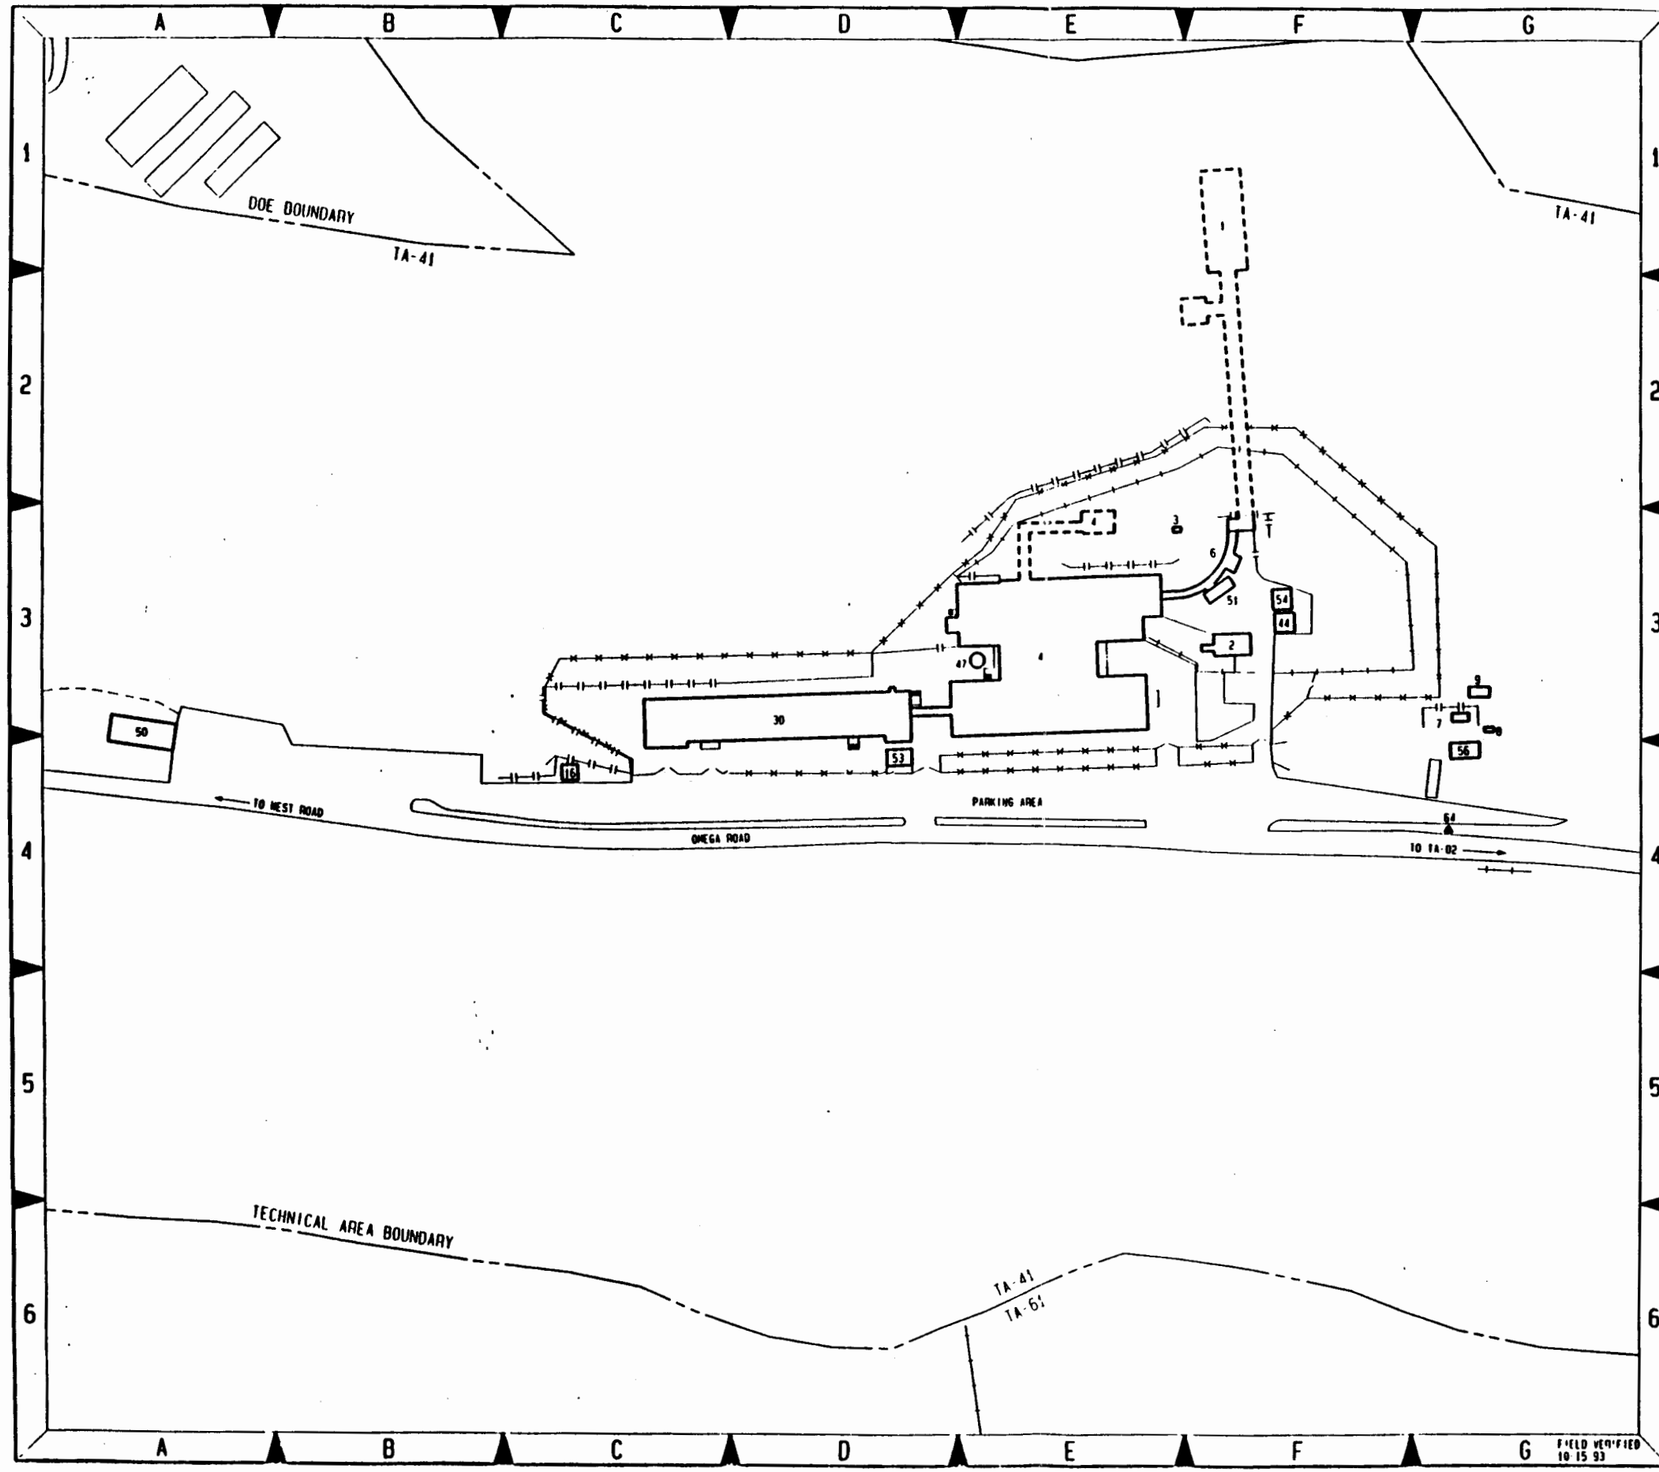

STRUCTURE LOCATION INDEX

STRUCTURE TA-NUMBER	STRUCTURE DESIGNATION	STRUCTURE NOMENCLATURE	STRUCTURE LOCATOR SHEET NO.	STRUCTURE LOCATOR MAP KEY
41-1	W 1	UNDERGROUND VAULT	2	F-1
41-2	W-2	GUARD STATION #313	2	F-3
41-3	W-3	BLOWER HOUSE	2	E-3
41-4	W-4	LABORATORY BUILDING	2	E-3
41-6	W-6	COVERED PASSAGEWAY	2	F-3
41-7	41-7	IMHOFF TANK & CHLORINE RM.	2	G-3
41-8	41-8	CONTACT TANK	2	G-3
41-9	41-9	DRYING BED	2	G-3
41-16	W-16	GUARD STATION #207	2	C-4
41-30	W-30	OFFICE BUILDING	2	D-3
41-44	W-44	STORAGE BUILDING	2	F-3
41-47	41-47	EXHAUST STACK	2	E-3
41-50	W-50	TRANSPORTABLE OFFICE BLDG.	2	A-3
41-51	W-51	TRAILER, OFFICE	2	F-3
41-53	W-53	GUARD STATION #311	2	D-4
41-54	W-54	STORAGE BUILDING	2	F-3
41-56	41-56	LIFT STATION	2	G-4
41-64	41-64	METEOROLOGICAL TOWER	2	G-4

N

SCALE: 1:600

50 0 50 100

FEET

NO	DATE	CLASS REV	REVISIONS	DWN	JPH	HHS	HHS	JAF	BEC	RAP
1	05-16-94		REVISED PER NEW STANDARDS	DMB	JPH	HHS	HHS	JAF	BEC	RAP

JOHNSON CONTROLS WORLD SERVICES INC.

AS-BUILT STRUCTURE LOCATION MAPS

TA-41

W SITE

DRAWN J. HOPKINS
VERIFIED H. SLAZAR, J. HOPKINS
CHECKED H. SALAZAR
RELEASED H. SALAZAR
DATE 10-21-93

SIGNATURE JERRY FORBE
RECOMMENDED BRYAN COMER
APPROVED ROBERT PADRINO

Los Alamos — Los Alamos National Laboratory, Los Alamos, New Mexico 87545

SHEET 2 / 2

CLASSIFICATION U REVIEWER H. SALAZAR DATE 8-17-94

PROJECT ID 11952

DRAWING NO AB32

REV 1

TA-43

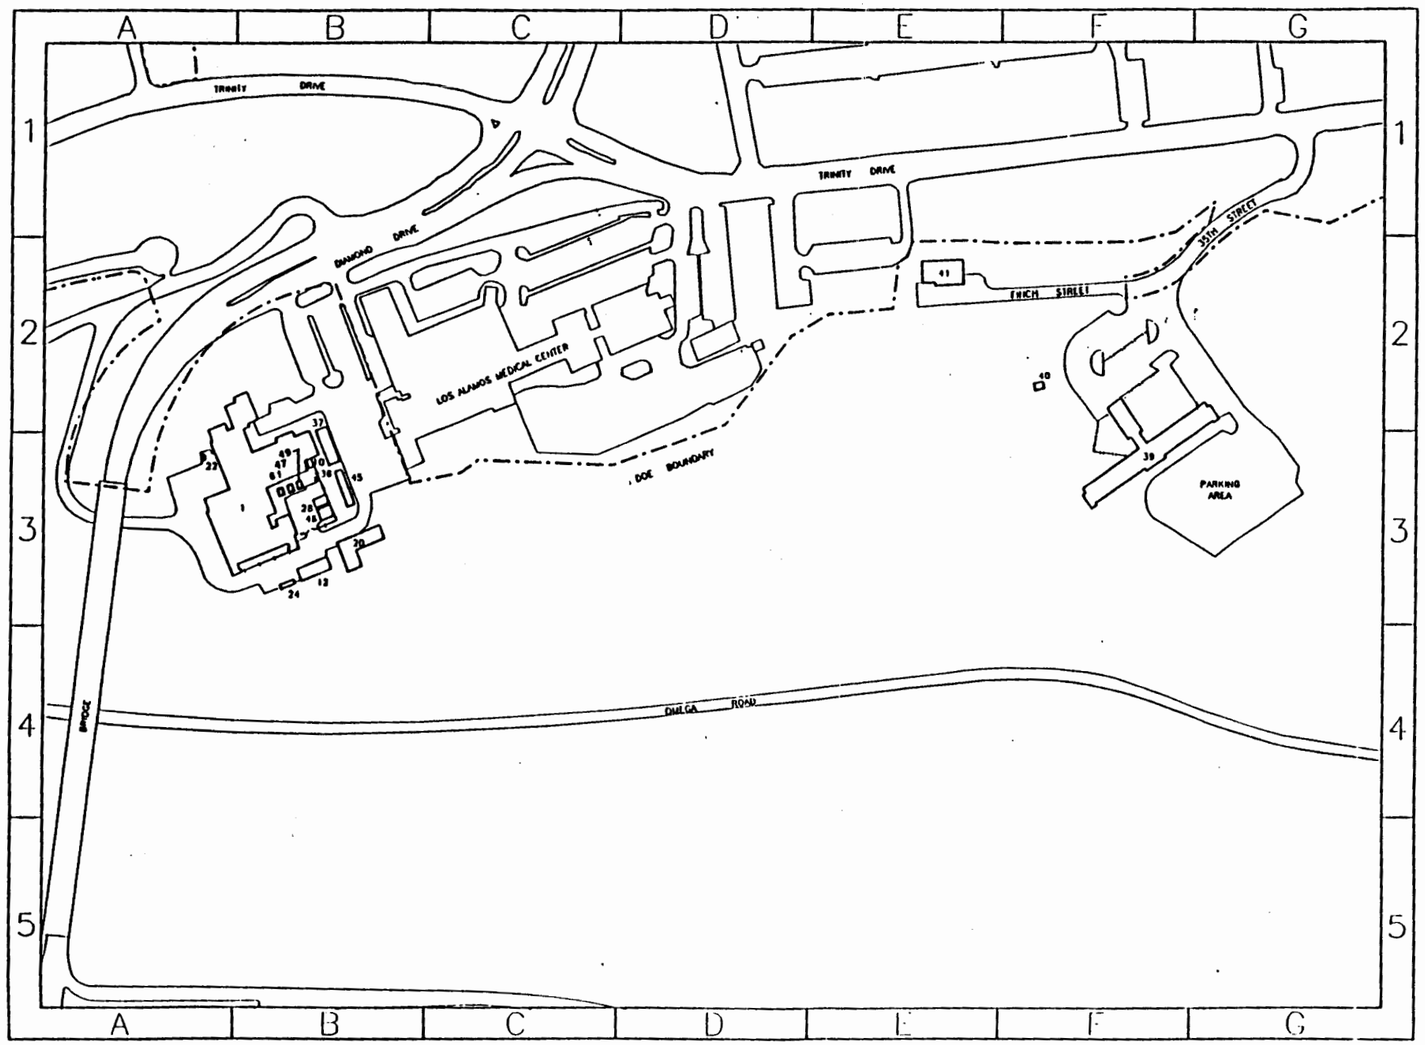

SCALE 1: 1440

120 0 120 240 FEET

N

STRUCTURE NUMBER INDEX

STRUCTURE TA-NUMBER	STRUCTURE DESIGNATION	STRUCTURE NOMENCLATURE	STRUCTURE LOCATOR SHEET NO.	STRUCTURE LOCATOR MAP KEY
43- 1	HRL- 1	HEALTH RESEARCH LABORATORY	1	B-3
43- 10	43- 10	SEWAGE LIFT STATION	1	B-3
43- 12	HRL- 12	WAREHOUSE	1	B-3
43- 20	HRL- 20	TRANSPORTABLE OFFICE BLDG.	1	B-3
43- 22	HRL- 22	EMERGENCY ACCESS	1	A-3
43- 24	HRL- 24	TRAILER, OFFICE	1	B-3
43- 28	HRL- 28	STORAGE SHED	1	B-3
43- 36	43- 36	STORAGE SHED	1	B-3
43- 37	43- 37	OFFICE TRAILER	1	B-3
43- 39	43- 39	DOE HEADQUARTERS	1	F-3
43- 40	43- 40	~~PUMP HOUSE~~ Sewage lift. sta	1	F-2
43- 41	43- 41	STEAM PLANT	1	E-2
43- 45	43- 45	LUNCH CONFERENCE ROOM	1	B-3
43- 46	43- 46	STORAGE SHED	1	B-3
43- 47	43- 47	CHEMICAL SHED	1	B-3
43- 49	43- 49	CHEMICAL SHED	1	B-3
43- 61	43- 61	CHEMICAL SHED	1	B-3

LATEST DISTRIBUTION

20 DEC 91

EMERGENCY RESPONSE MAP

UPDATED DRAWING

NO.	DATE	LAST REV.	REVISIONS	DWN	DES	CKD	PEL	SUB	REC	APP

FACILITIES ENGINEERING DIVISION

STRUCTURE LOCATION MAP

TA-43

HEALTH RESEARCH LABORATORY

BLDG.

DRAWN	C.SANDOVAL
DESIGN	
CHECKED	B. COMER
RELEASED	B. COMER
DATE	03-06-91

SUBMITTED [signature] RECOMMENDED [signature] APPROVED [signature]

LOS ALAMOS LOS ALAMOS NATIONAL LABORATORY LOS ALAMOS, NEW MEXICO 87545

SHEET 1 OF 1

CLASSIFICATION U REVIEWER [signature] DATE 4-15-91

LAB JOB NO.

DRAWING NO. ENG-R 5123

REV. 17

AUTOGIS

STRUCTURE LOCATION MAPS

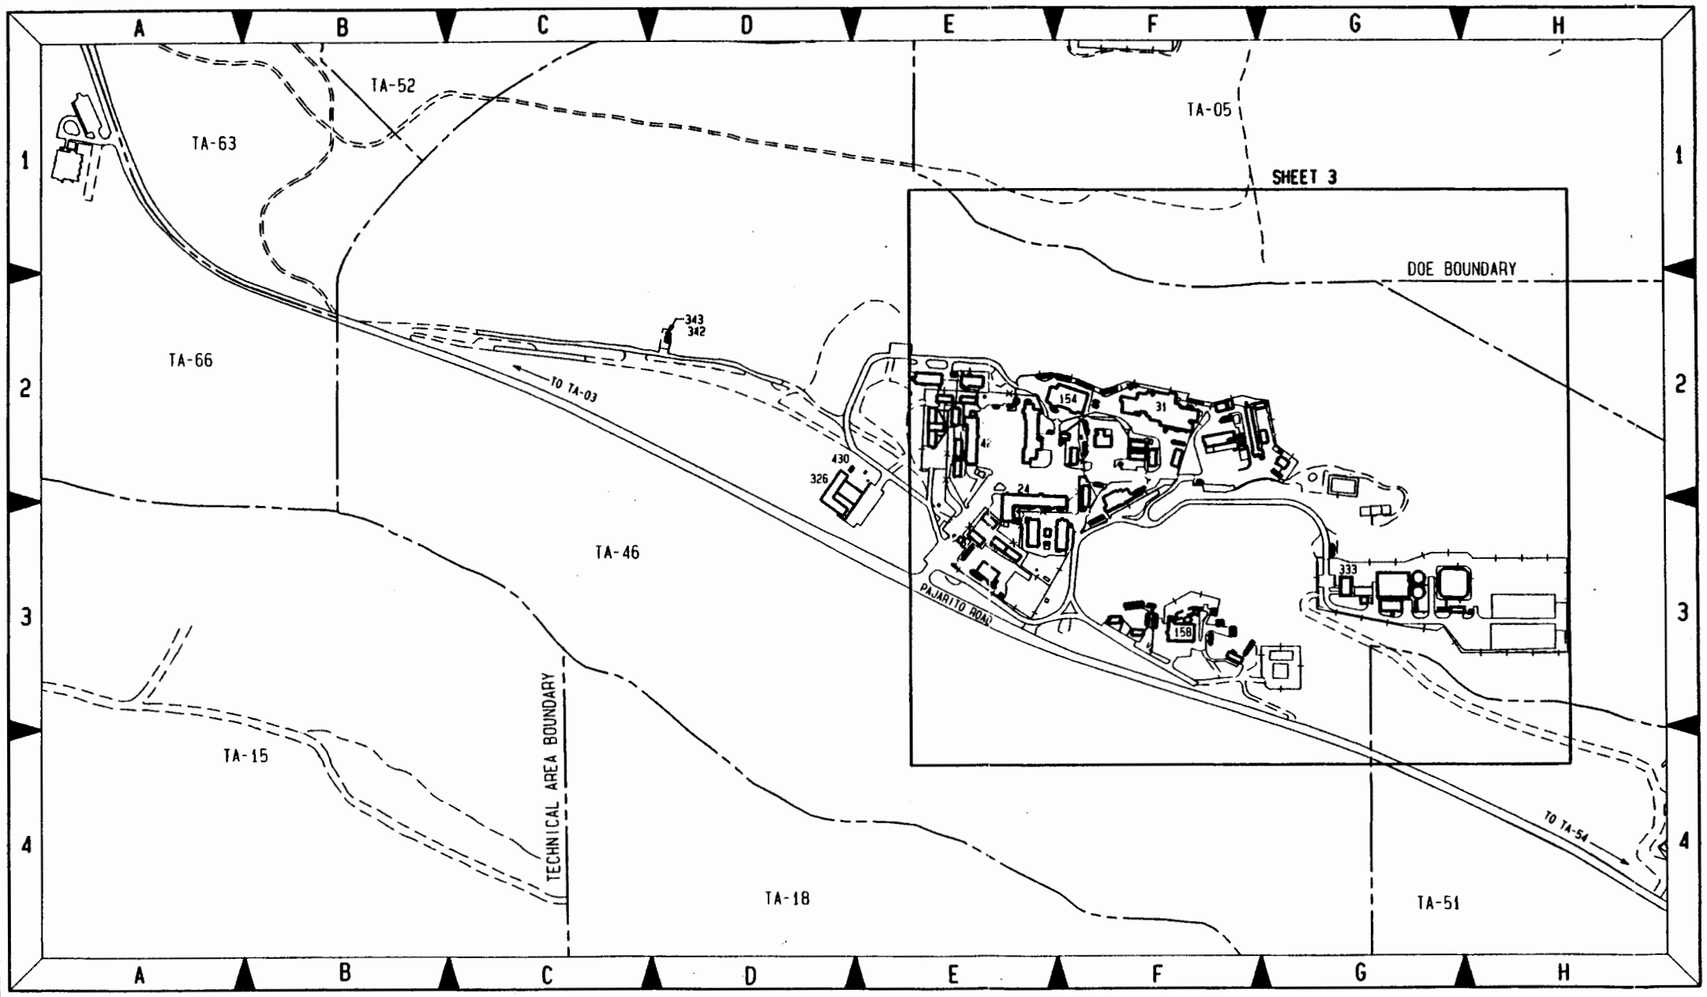

TA-46 KEY MAP

SCALE: 1:3000

250 0 250 500
FEET

N

FIELD VERIFIED
07-20-94

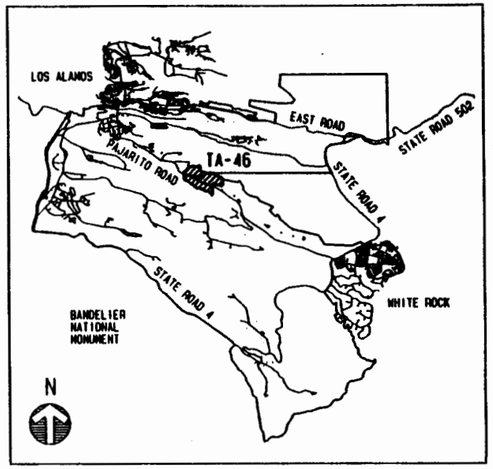

LOCATION PLAN

SCALE: NONE

NO	DATE	CLASS REV	REVISIONS	DWN	VER	CHKD	REL	SUB	REC	APP
2	08-02-94		REVISED TO STATUS OF 07-20-94	JAC	JAC	HMS	HMS	JAF	BEC	RAP
1	05-16-94		REVISED PER NEW STANDARDS AND TO STATUS OF 04-19-94	JAC	JPN JAC	HMS	HMS	JAF	BEC	RAP

JOHNSON CONTROLS WORLD SERVICES INC.

AS-BUILT STRUCTURE LOCATION MAPS

TA-46

WA SITE

DRAWN	J. NORK
VERIFIED	J. NORK
CHECKED	H. SALAZAR
RELEASED	H. SALAZAR
DATE	07-06-93

SUBMITTED JERRY FORIE — RECOMMENDED BRYAN COMER — APPROVED ROBERT PRONNEL

Los Alamos — Los Alamos National Laboratory, Los Alamos, New Mexico 87545

SHEET 1 OF 3

CLASSIFICATION U — REVIEWER H. SALAZAR — DATE 8-2-94

PROJECT ID	DRAWING NO	REV
11952	AB34	2

JCI NO 91-020

STRUCTURE LOCATION INDEX

STRUCTURE TA-NUMBER	STRUCTURE DESIGNATION	STRUCTURE NOMENCLATURE	STRUCTURE LOCATOR SHEET NO.	STRUCTURE LOCATOR MAP KEY
46-1	WA-1	LABORATORY BUILDING	3	B-3
46-2	46-2	GUARD HOUSE	3	A-4
46-16	46-16	TEST BUILDING NO. 1	3	D-3
46-17	46-17	UTILITY BUILDING	3	D-3
46-18	46-18	UTILITY TUNNEL	3	D-3
46-24	WA-24	LABORATORY/OFFICE BLDG.	3	B-4
46-25	WA-25	BATTERY BUILDING	3	D-3
46-30	WA-30	HYDRAULICS LABORATORY	3	C-3
46-31	46-31	TEST BUILDING NO. 2	3	C-3
46-36	WA-36	STORAGE BUILDING	3	B-3
46-37	WA-37	PROPELLANT PUMP HOUSE NO. 1	3	D-3
46-41	WA-41	LASER ISOTOPE SUPPORT FAC.	3	C-4
46-42	46-42	LASER SUPPORT FACILITY	3	A-3
46-58	WA-58	LABORATORY & SHOP BLDG.	3	D-3
46-59	WA-59	ENGINEERING TEST BLDG.	3	B-4
46-74	46-74	TEST FACILITY	3	C-3
46-75	WA-75	LASER/MACHINE SHOP	3	B-4
46-76	WA-76	LABORATORY	3	B-4
46-77	WA-77	WAREHOUSE	3	D-3
46-86	46-86	COOLING TOWER	3	D-3
46-87	WA-87	PUMP HOUSE	3	D-3
46-88	WA-88	CORE SUPPORT FACILITY	3	A-4
46-111	46-111	LIQUID NITROGEN TANK	3	A-5
46-119	WA-119	MODULAR OFFICE BLDG.	3	B-4
46-120	WA-120	MODULAR OFFICE BLDG.	3	A-4
46-121	WA-121	MODULAR OFFICE BLDG.	3	A-4
46-128	WA-128	MODULAR OFFICE BLDG.	3	C-3
46-134	46-134	GUARD STATION	3	A-4
46-154	WA-154	LASER ISOTOPE ENRICH. FAC.	3	B-3
46-158	WA-158	LASER INDUCED CHEMISTRY LAB	3	C-5
46-161	WA-161	ACCELERATOR VAULT FACILITY	3	C-5
46-165	WA-165	TRANSPORTABLE OFFICE BLDG	3	C-3
46-175	46-175	TRAILER, OFFICE	3	D-5
46-176	46-176	TRAILER, OFFICE	3	C-5
46-177	46-177	TRAILER, OFFICE	3	C-5
46-178	WA-178	TRANSPORTABLE OFFICE BLDG.	3	A-3
46-179	WA-179	TRANSPORTABLE OFFICE BLDG.	3	A-3
46-180	WA-180	TRAILER, OFFICE	3	A-3
46-181	46-181	TRAILER, OFFICE	3	A-4
46-182	WA-182	TRANSPORTABLE OFFICE BLDG.	3	B-3
46-183	WA-183	TRAILER, OFFICE	3	B-3
46-184	WA-184	TRAILER, OFFICE	3	B-3
46-185	WA-185	TRAILER, OFFICE	3	C-4
46-186	WA-186	TRAILER, OFFICE	3	E-4
46-187	WA-187	TRANSPORTABLE OFFICE BLDG.	3	C-3
46-188	WA-188	TRANSPORTABLE OFFICE BLDG.	3	C-3
46-189	WA-189	TRAILER, OFFICE	3	C-3
46-191	WA-191	TRAILER, OFFICE	3	D-3
46-194	WA-194	MODULAR SOLAR HOUSE	3	C-5
46-195	WA-195	MODULAR SOLAR HOUSE	3	C-5
46-198	46-198	TRAILER, OFFICE	3	C-5
46-200	46-200	SPECTROMETER FACILITY	3	A-2
46-201	46-201	TRANSPORTABLE OFFICE BLDG.	3	A-3
46-202	46-202	TRANSPORTABLE OFFICE BLDG.	3	A-3
46-204	WA-204	TRANSPORTABLE OFFICE BLDG.	3	D-5
46-207	WA-207	TRAILER, OFFICE	3	C-5
46-208	WA-208	LABORATORY BLDG.	3	C-5
46-217	46-217	TRANSPORTABLE OFFICE BLDG.	3	A-4
46-218	46-218	TRANSPORTABLE OFFICE BLDG.	3	B-4
46-221	46-221	TRANSPORTAINER	3	D-5
46-231	46-231	TRANSPORTABLE OFFICE BLDG.	3	A-3
46-232	46-232	TRANSPORTABLE OFFICE BLDG.	3	A-3
46-234	46-234	TRANSPORTABLE OFFICE BLDG.	3	A-3
46-239	46-239	TRANSPORTAINER	3	D-5
46-240	46-240	TRANSPORTAINER	3	B-3
46-241	46-241	TRAILER, OFFICE	3	B-2
46-242	46-242	TRAILER, OFFICE	3	B-2
46-247	46-247	TRANSPORTAINER	3	D-5
46-250	46-250	DIAGNOSTICS FACILITY	3	A-2
46-251	46-251	TRAILER, OFFICE	3	D-5
46-252	46-252	MORGAN STORAGE SHED	3	A-5
46-254	46-254	TEST CELL	3	D-4
46-255	46-255	MORGAN SHED	3	C-3
46-257	46-257	STORAGE SHED	3	B-4
46-258	46-258	STORAGE SHED	3	B-4
46-260	46-260	TRANSPORTAINER	3	B-4
46-262	46-262	STORAGE SHED	3	B-4
46-263	46-263	STORAGE SHED	3	C-3
46-271	46-271	TANK, STORAGE	3	A-5
46-272	46-272	TRANSPORTAINER	3	B-4
46-274	46-274	STORAGE SHED	3	B-3
46-276	46-276	TRANSPORTAINER	3	C-3
46-277	46-277	TRANSPORTAINER	3	B-3
46-278	46-278	TRANSPORTAINER	3	A-2
46-279	46-279	TRANSPORTAINER	3	B-3
46-282	46-282	TRANSPORTAINER	3	A-2
46-283	46-283	TRANSPORTAINER	3	B-3
46-285	46-285	TRANSPORTAINER	3	B-3
46-286	46-286	MORGAN STORAGE SHED	3	B-4
46-293	46-293	TRANSPORTAINER	3	B-3
46-294	46-294	TRANSPORTAINER	3	B-3
46-296	46-296	TRANSPORTAINER	3	D-3
46-297	46-297	TRANSPORTAINER	3	B-4
46-298	46-298	TRANSPORTAINER	3	B-4
46-299	46-299	TRANSPORTAINER	3	D-5
46-300	46-300	TRANSPORTAINER	3	D-5
46-301	46-301	TRANSPORTAINER	3	B-4
46-302	46-302	TRANSPORTAINER	3	C-4
46-303	46-303	TRANSPORTAINER	3	B-3
46-306	46-306	TRANSPORTAINER	3	C-3
46-307	46-307	TRANSPORTAINER	3	D-5
46-308	46-308	TRANSPORTAINER	3	D-5
46-310	46-310	TRANSPORTAINER	3	A-3
46-311	46-311	TRANSPORTAINER	3	B-3
46-312	46-312	TRANSPORTAINER	3	D-5
46-313	46-313	TRANSPORTAINER	3	D-5
46-314	46-314	TRAILER, OFFICE	3	B-4
46-318	46-318	STORAGE SHED	3	B-4
46-319	46-319	TRANSPORTAINER	3	C-4
46-320	46-320	TRANSPORTAINER	3	D-3
46-321	46-321	TRANSPORTAINER	3	C-3
46-322	46-322	TRANSPORTAINER	3	C-3
46-323	46-323	TRANSPORTAINER	3	C-3
46-324	46-324	TRANSPORTAINER	3	B-4
46-325	46-325	TRAILER, OFFICE	3	B-3
46-326	46-326	TECHNICAL SUPPORT FACILITY	1	D-2
46-333	46-333	MAINTENANCE BUILDING	3	E-5
46-334	46-334	ENTRANCE WORKS	3	E-5
46-335	46-335	BLOWER COMPLEX	3	F-5
46-336	46-336	EQUALIZATION & AERATION BASIN	3	F-5
46-337	46-337	NORTH CLAIRIFIER	3	F-5
46-338	46-338	SOUTH CLARIFIER	3	F-5
46-339	46-339	PUMP STATION	3	F-5
46-340	46-340	CHLORINE STORAGE FACILITY	3	F-5
46-341	46-341	TRANSPORTAINER	3	C-4
46-342	46-342	GAS TEST FACILITY	1	D-2
46-343	46-343	STORAGE SHED	1	D-2
46-347	46-347	CHLORINE CONTACT BASIN	3	F-5
46-357	46-357	PUMP SHED	3	A-5
46-359	46-359	TRANSPORTAINER	3	C-4
46-360	46-360	TRANSPORTAINER	3	C-4
46-375	46-375	EFFLUENT HOLDING POND	3	F-5
46-392	46-392	TRANSPORTAINER	3	A-3
46-393	46-393	TRANSPORTAINER	3	C-4
46-397	46-397	TRAILER, OFFICE	3	C-3
46-398	46-398	TRANSPORTAINER	3	B-3
46-400	46-400	TRANSPORTAINER	3	D-3
46-401	46-401	TRANSPORTAINER	3	C-3
46-402	46-402	CHEMICAL STORAGE SHED	3	D-5
46-416	46-416	SHED	3	B-4
46-418	46-418	EQUIPMENT ROOM	3	A-3
46-419	46-419	SHED	3	B-3
46-420	46-420	EQUIPMENT BLDG.	3	D-3
46-421	46-421	ELECTROMAGNETIC SHEILD ENCLOSURE	3	D-5
46-427	46-427	TRANSPORTAINER	3	D-3
46-428	46-428	TRANSPORTAINER	3	F-5
46-430	46-430	TRANSPORTAINER	1	D-2

NO	DATE	CLASS REV	REVISIONS	DWN	VER	CHKD	REL	SUB	REC	APP
2	08-02-94		REVISED TO STATUS OF 07-20-94	JAC	JAC	JPN	HMS	JAF	BEC	RAP
1	05-16-94		REVISED PER NEW STANDARDS AND TO STATUS OF 04-19-94	JAC	JAC	JPN	HMS	JAF	BEC	RAP

JOHNSON CONTROLS WORLD SERVICES INC.

AS-BUILT STRUCTURE LOCATION MAPS

TA-46

WA SITE

DRAWN J. HORK
VERIFIED J. HORK
CHECKED H. SALAZAR
RELEASED H. SALAZAR
DATE 06-23-93

SUBMITTED JERRY FORTE
RECOMMENDED BRIAN COMER
APPROVED ROBERT PROMMEL

Los Alamos

Los Alamos National Laboratory
Los Alamos, New Mexico 87545

SHEET 2 2/3

CLASSIFICATION U REVIEWER H. SALAZAR DATE 8-2-94

PROJECT ID 11952

DRAWING NO AB34

REV 2

JCI NO 91-020

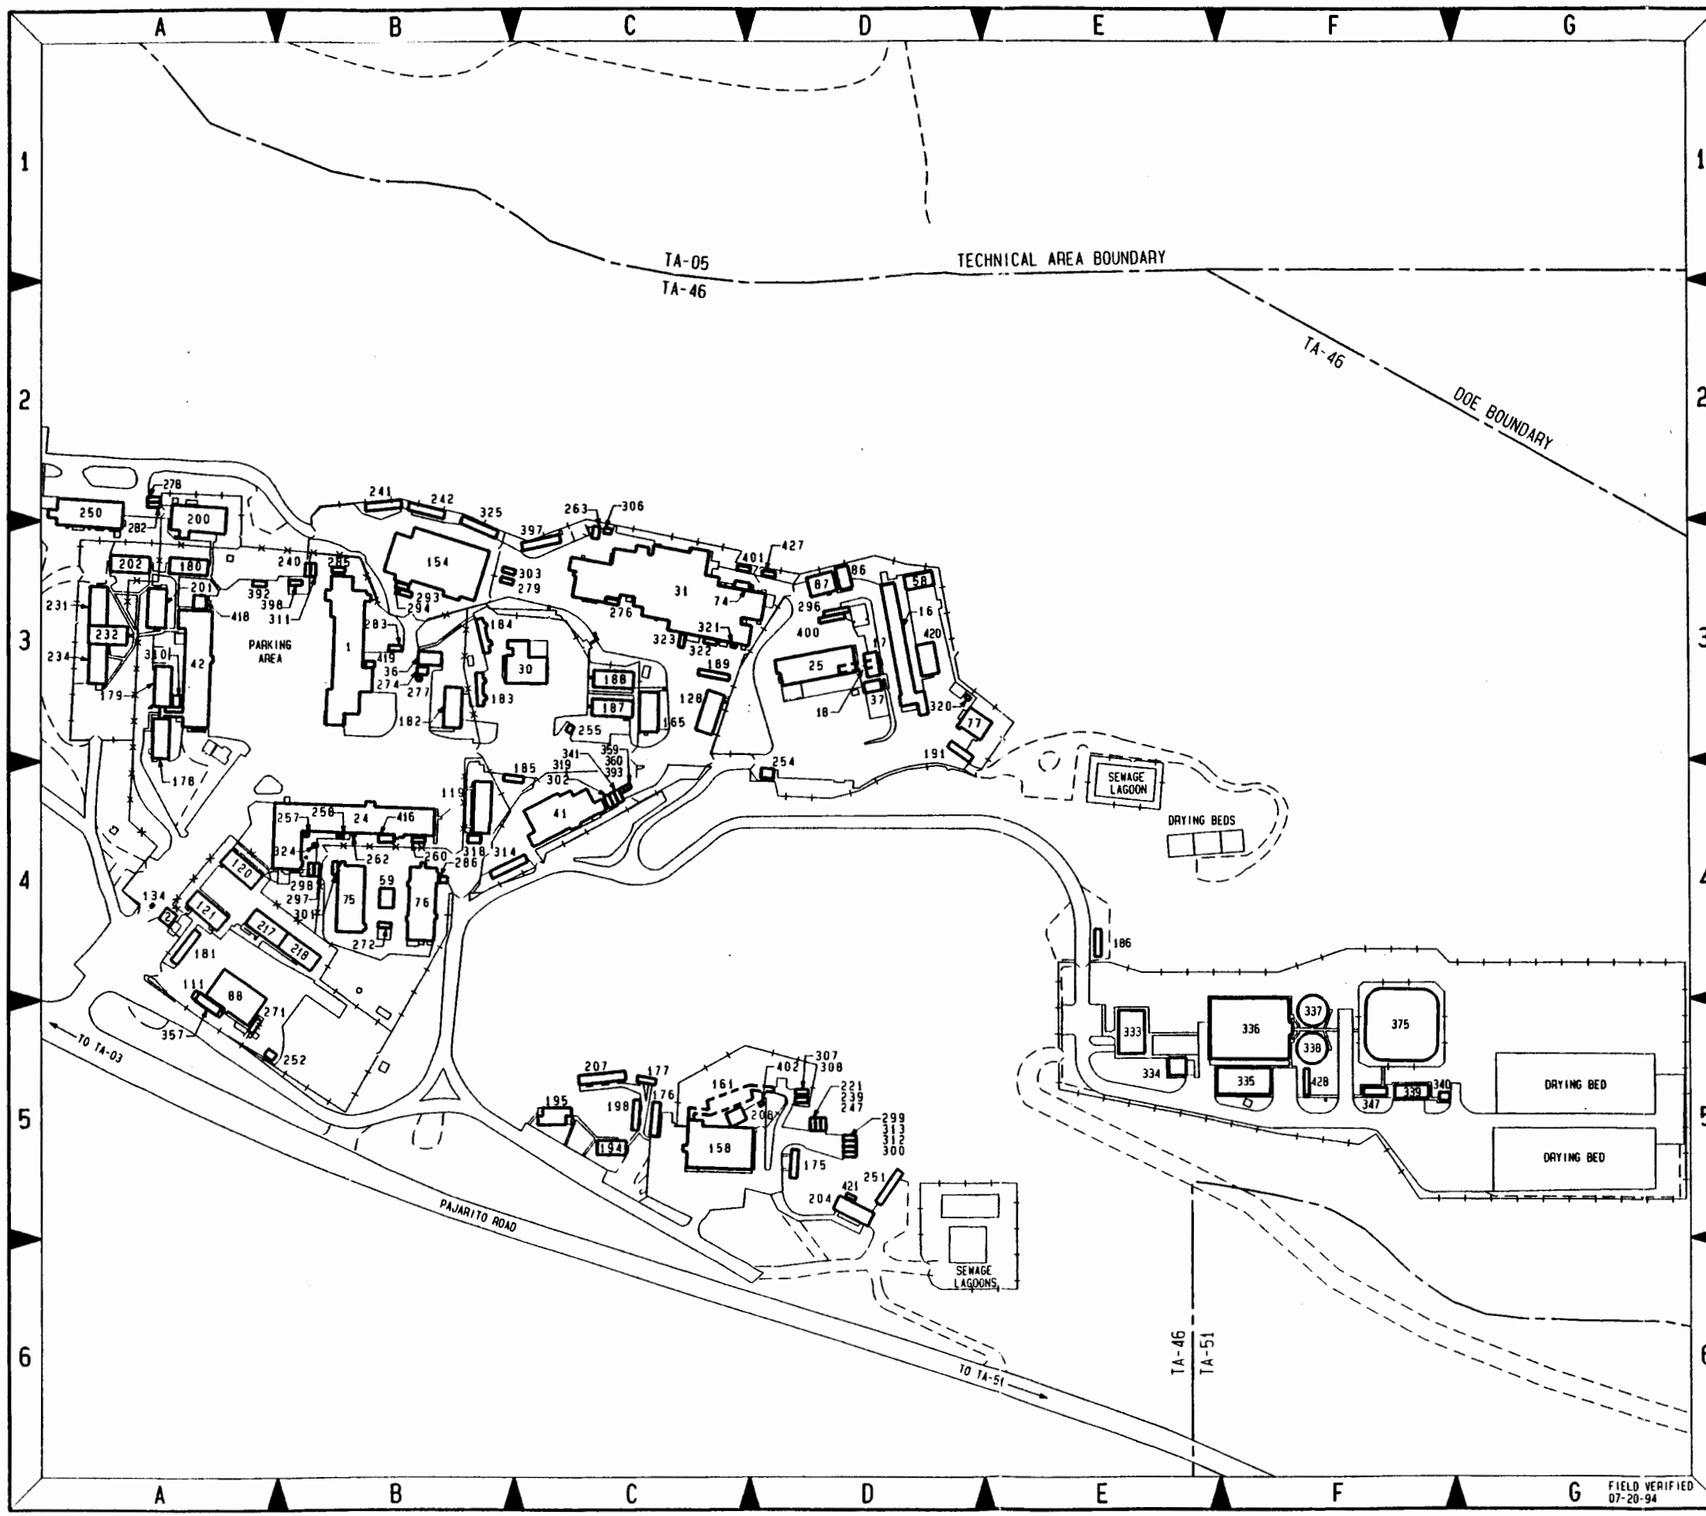

N

SCALE: 1:1200

100 0 100 200

FEET

NO	DATE	CLASS REV	REVISIONS	DWN	VER	CHKD	REL	SUB	REC	APP
2	08-02-94		REVISED TO STATUS OF 07-20-94	JAC	JAC	JPN	HNS	JAF	BEC	RAP
1	05-15-94		REVISED PER NEW STANDARDS AND TO STATUS OF 04-19-94	JAC	JPN JAC	JPN	HNS	JAF	BEC	RAP

JOHNSON CONTROLS WORLD SERVICES INC.

AS-BUILT STRUCTURE LOCATION MAPS

TA-46

WA SITE

DRAWN J. NORK
VERIFIED J. NORK
CHECKED H. SALAZAR
RELEASED H. SALAZAR
DATE 10-27-93

SUBMITTED JERRY FORIE
RECOMMENDED BRYAN CONER
APPROVED ROBERT PROMMEL

Los Alamos — Los Alamos National Laboratory, Los Alamos, New Mexico 87545

SHEET 3 OF 3

CLASSIFICATION U REVIEWER H. SALAZAR DATE 8-2-94

PROJECT ID 11952 | DRAWING NO AB34 | REV 2

JCI NO 91-020

STRUCTURE LOCATION MAPS

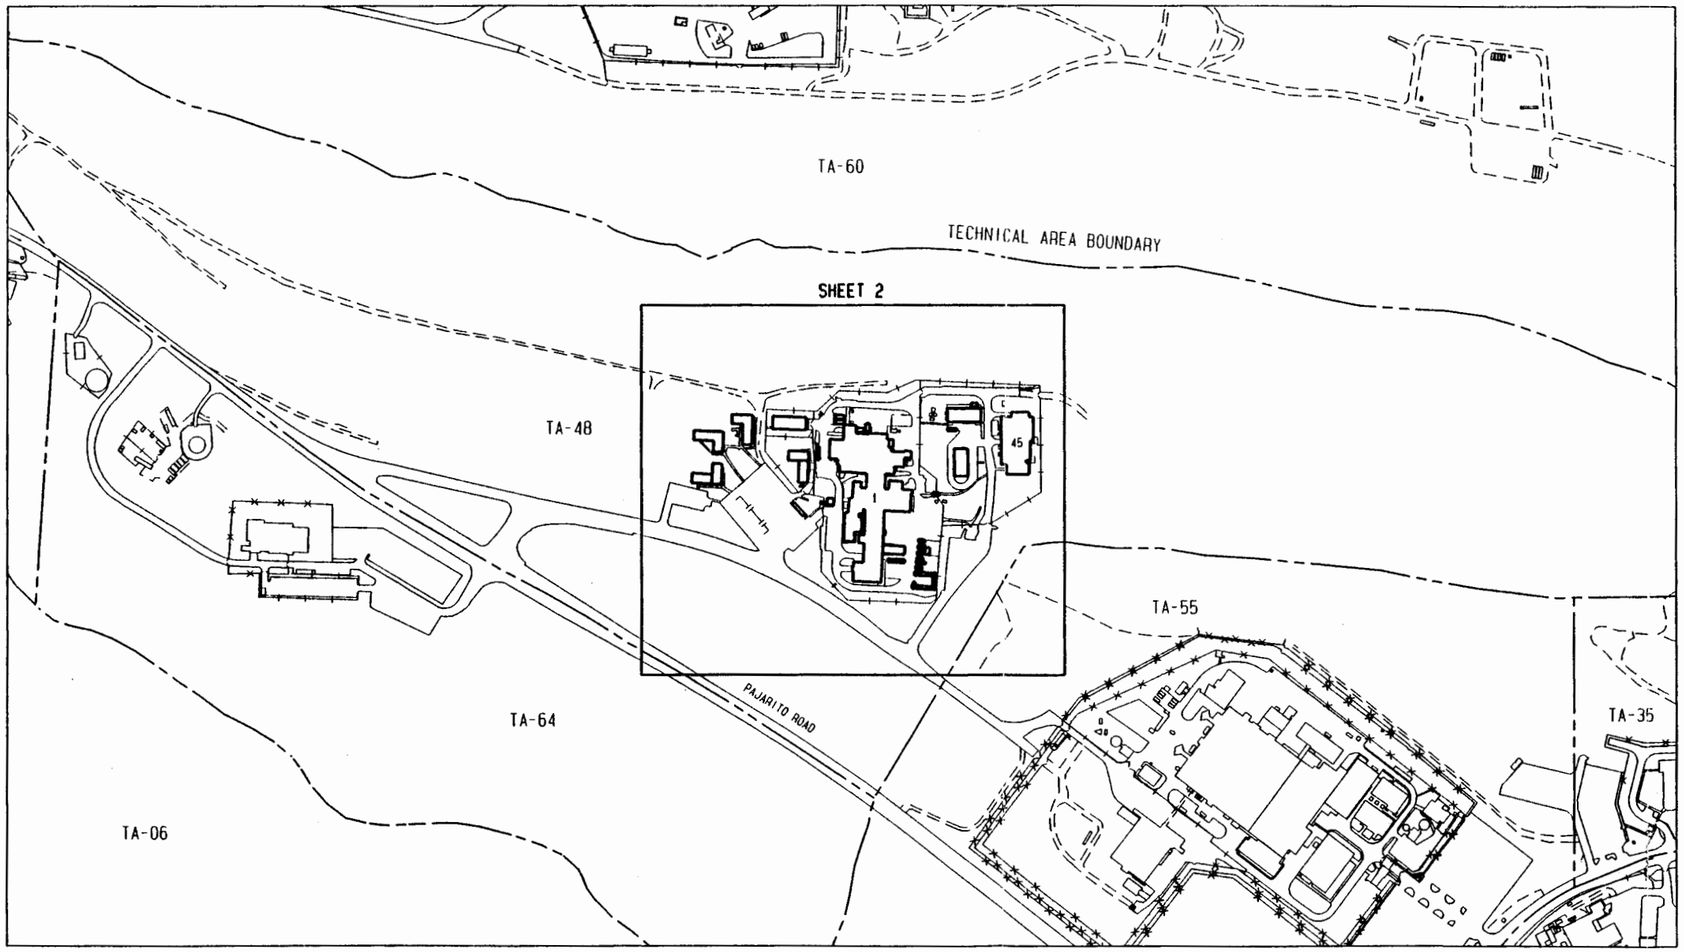

TA-48 KEY MAP

SCALE: 1:2400

200 0 200 400

FEET

N

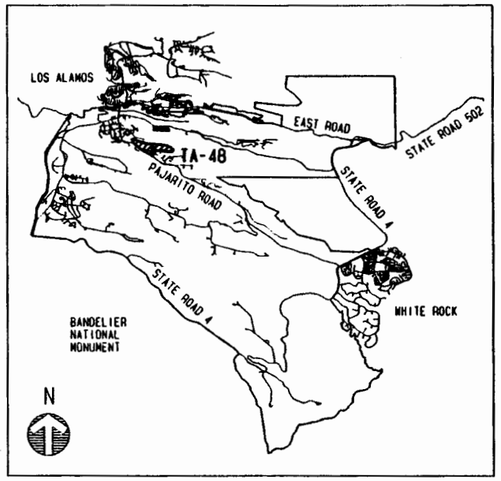

LOCATION PLAN

SCALE: NONE

NO	DATE	CLASS REV	REVISIONS	DWN	VER	CHKD	REL	SUB	REC	APP
1	06-10-94		REVISED PER NEW STANDARDS AND TO STATUS OF 05 04-94	JAC	JAC	DPM	HMS	JAF	BEC	RAP

JOHNSON CONTROLS WORLD SERVICES INC.

AS-BUILT STRUCTURE LOCATION MAPS

TA-48

RADIOCHEMISTRY SITE

DRAWN	J. WORK
VERIFIED	J. WORK
CHECKED	H. SALAZAR
RELEASED	H. SALAZAR
DATE	09-23-93

SUBMITTED Hmo for JERRY FORTE Jerry Forte

RECOMMENDED BRYAN COMER RtP for BEC

APPROVED ROBERT PHONNEL RtP

Los Alamos — Los Alamos National Laboratory, Los Alamos, New Mexico 87545

SHEET 1 OF 2

CLASSIFICATION U REVIEWER H SALAZAR H. Sal DATE 6/22/94

PROJECT ID 11952

DRAWING NO AB35

REV 1

J 91-020

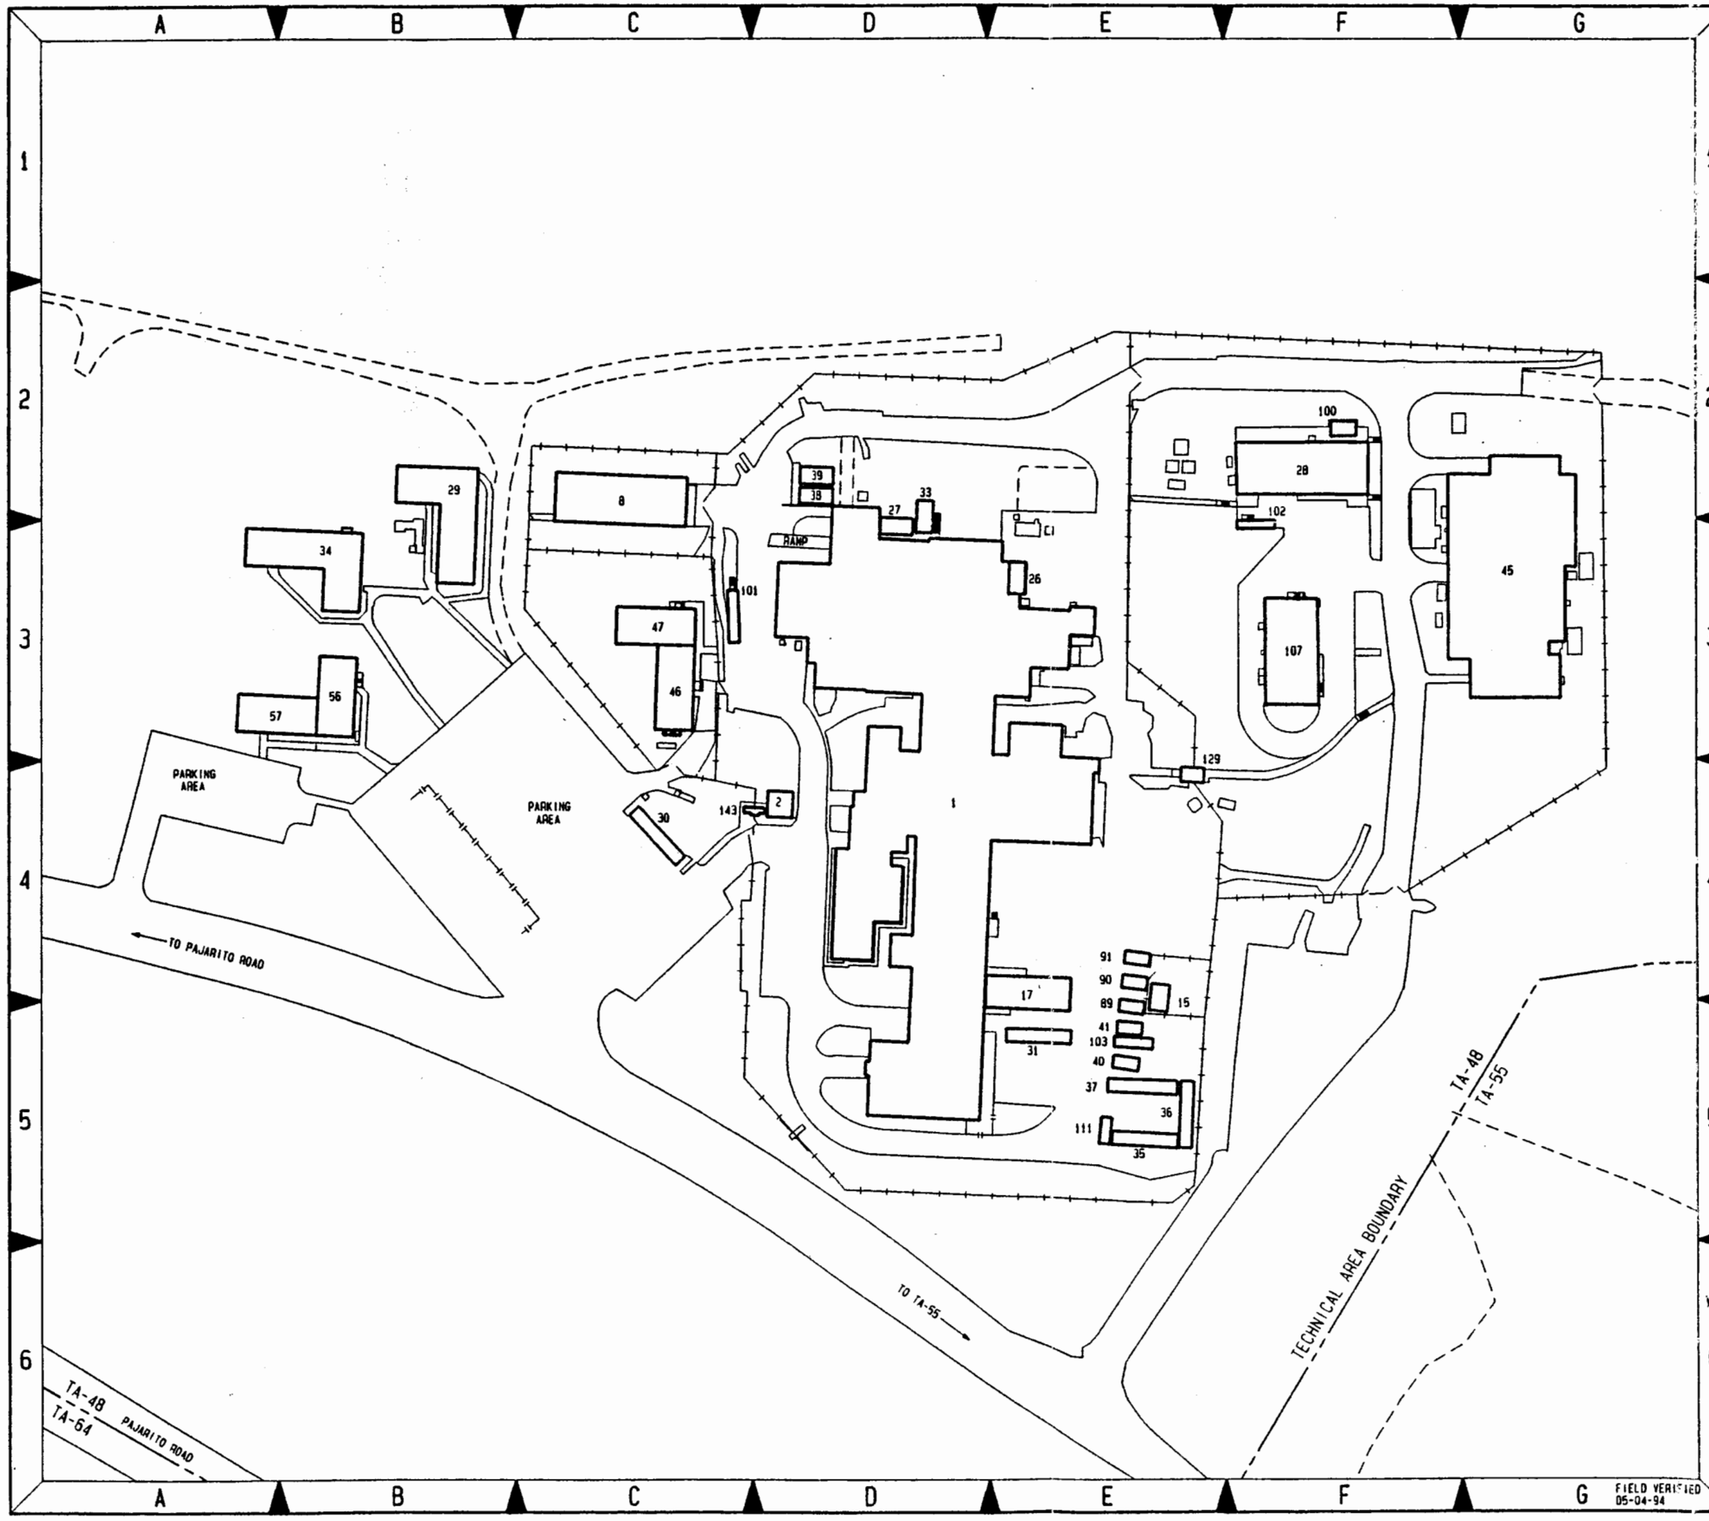

STRUCTURE LOCATION INDEX

STRUCTURE TA-NUMBER	STRUCTURE DESIGNATION	STRUCTURE NOMENCLATURE	STRUCTURE LOCATOR SHEET NO.	STRUCTURE LOCATOR MAP KEY
48-1	RC-1	RAD. CHEMICAL LAB BLDG.	2	D-4
46-2	RC-2	GUARD STATION #416	2	D-4
48-8	RC-8	ISOTOPE SEPERATOR BLDG.	2	C-2
48-15	RC-15	METAL SHED	2	E-4
48-17	RC-17	ASSEMBLY & CHECKOUT BLDG.	2	E-4
48-26	48-26	OFFICE BUILDING	2	E-3
48-27	48-27	OFFICE BUILDING	2	D-3
48-28	48-28	ADVANCED ANALYTICAL DEV. BLDG.	2	F-2
48-29	RC-29	TRANSPORTABLE OFFICE BLDG.	2	B-2
48-30	RC-30	TRAILER, OFFICE	2	C-4
48-31	RC-31	TRAILER, LAB & OFFICE	2	E-5
48-33	48-33	TRANSPORTABLE OFFICE BLDG.	2	D-2
48-34	RC-34	TRANSPORTABLE OFFICE BLDG.	2	B-3
48-35	RC-35	RAILROAD BOXCAR, STORAGE	2	E-5
48-36	RC-36	RAILROAD BOXCAR, STORAGE	2	E-5
48-37	RC-37	RAILROAD BOXCAR, STORAGE	2	E-5
48-38	RC-38	STORAGE BLDG.	2	D-2
48-39	RC-39	STORAGE BLDG.	2	D-2
48-40	RC-40	STORAGE SHED	2	E-5
48-41	RC-41	STORAGE SHED	2	E-5
48-45	48-45	A.R.W. DIAGNOSTICS BLDG.	2	G-3
48-46	RC-46	TRANSPORTABLE OFFICE BLDG.	2	C-3
48-47	RC-47	TRANSPORTABLE OFFICE BLDG.	2	C-3
48-56	RC-56	TRANSPORTABLE OFFICE BLDG.	2	B-3
48-57	RC-57	TRANSPORTABLE OFFICE BLDG.	2	B-3
48-89	RC-89	STORAGE SHED	2	E-5
48-90	RC-90	STORAGE SHED	2	E-4
48-91	RC-91	STORAGE SHED	2	E-4
48-100	48-100	STORAGE SHED	2	F-2
48-101	48-101	TRAILER, STORAGE	2	C-3
48-102	48-102	TRAILER, STORAGE	2	F-3
48-103	48-103	TRAILER, STORAGE	2	E-5
48-107	48-107	WEAPONS ANALYT. CHEMISTRY FAC.	2	F-3
48-111	48-111	TRANSPORTAINER	2	E-5
48-129	48-129	PALM READER STATION	2	E-4
48-143	48-143	MARDEX BOOTH	2	D-4

N

SCALE: 1:600

50 0 50 100

FEET

NO	DATE	CLASS REV	REVISIONS	DWN	VER	CHKD	REL	SUB	REC	APP
1	06-15-94		REVISED PER NEW STANDARDS AND STATUS OF 05-04-94	JAC	JAC	JPM	HMS	JAF	BEC	RAP

JOHNSON CONTROLS WORLD SERVICES INC.

AS-BUILT STRUCTURE LOCATION MAPS

TA-48

RADIOCHEMISTRY SITE

DRAWN	J. [illegible]
VERIFIED	J. NORK
CHECKED	H. SALAZAR
RELEASED	H. SALAZAR
DATE	09-23-93

SUBMITTED JERRY FORTE — RECOMMENDED BRYAN COMER RAP for BEC — APPROVED ROBERT PROMMEL

Los Alamos — Los Alamos National Laboratory, Los Alamos, New Mexico 87545

SHEET 2 OF 2

CLASSIFICATION U — REVIEWER H. SALAZAR — DATE 6-15-94

PROJECT ID 11952 — DRAWING NO AB35 — REV 1

JCI NO 91-020

TA-49

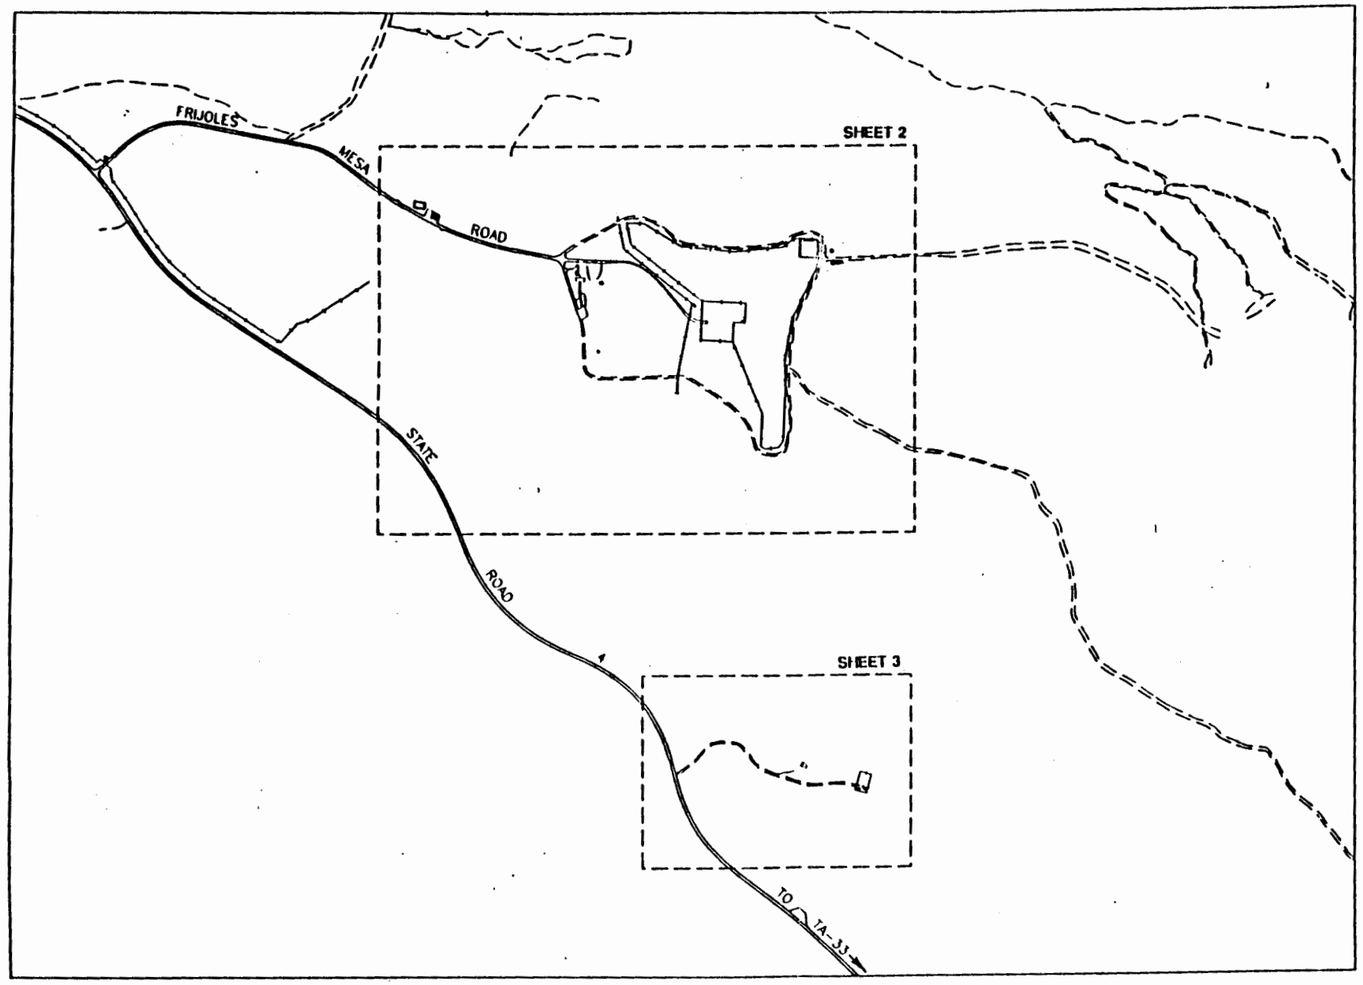

SCALE 1: 6000

500 0 500 1000 FEET

N

STRUCTURE NUMBER INDEX

STRUCTURE TA-NUMBER	STRUCTURE DESIGNATION	STRUCTURE NOMENCLATURE	STRUCTURE LOCATOR SHEET NO.	STRUCTURE LOCATOR MAP KEY
49- 23	FM- 23	BOTTLE HOUSE	2	F-2
49-101	FM-101	TEST WELL NO. 5	2	E-3
49-113	FM-113	HDT TRAINING FACILITY	2	C-3
49-114	FM-114	EXPLOSIVES MAGAZINE	2	C-2
49-115	FM-115	ANTENNA TEST FACILITY	2	A-1
49-121	49-121	CABLE BUILDING	2	F-2
49-122	49-122	TRAILER, STORAGE	3	F-3
49-123	49-123	ANTENNA	3	E-3
49-124	49-124	SHED	3	F-3
49-130	49-130	TRAILER, STORAGE	2	A-1
49-131	49-131	TRAILER, STORAGE	2	A-1
49-132	49-132	TRAILER, STORAGE	2	A-1
49-133	49-133	TRAILER, STORAGE	2	A-1
49-135	49-135	FRAME BLDG.	2	C-2
49-136	49-136	TRAILER	2	C-2
49-137	49-137	TRAILER, STORAGE	2	A-1

LATEST DISTRIBUTION
20 DEC 91
EMERGENCY RESPONSE MAP
UPDATED DRAWING

NO.	DATE	LAST REV.	REVISIONS	DWN	DES	CKD	REL	SUB	REC	APP

FACILITIES ENGINEERING DIVISION

STRUCTURE LOCATION MAP
TA-49
FRIJOLES MESA SITE

DRAWN	C. SANDOVAL
DESIGN	
CHECKED	B. COMER
RELEASED	B. COMER
DATE	03-11-91

BLDG.
SUBMITTED
RECOMMENDED
APPROVED

LOS ALAMOS — LOS ALAMOS NATIONAL LABORATORY, LOS ALAMOS, NEW MEXICO 87545

SHEET 1 OF 3

CLASSIFICATION U REVIEWER DATE 4-18-91

LAB JOB NO.

DRAWING NO. ENG-R 5126

REV. 12

AUTOCIS

TA-49

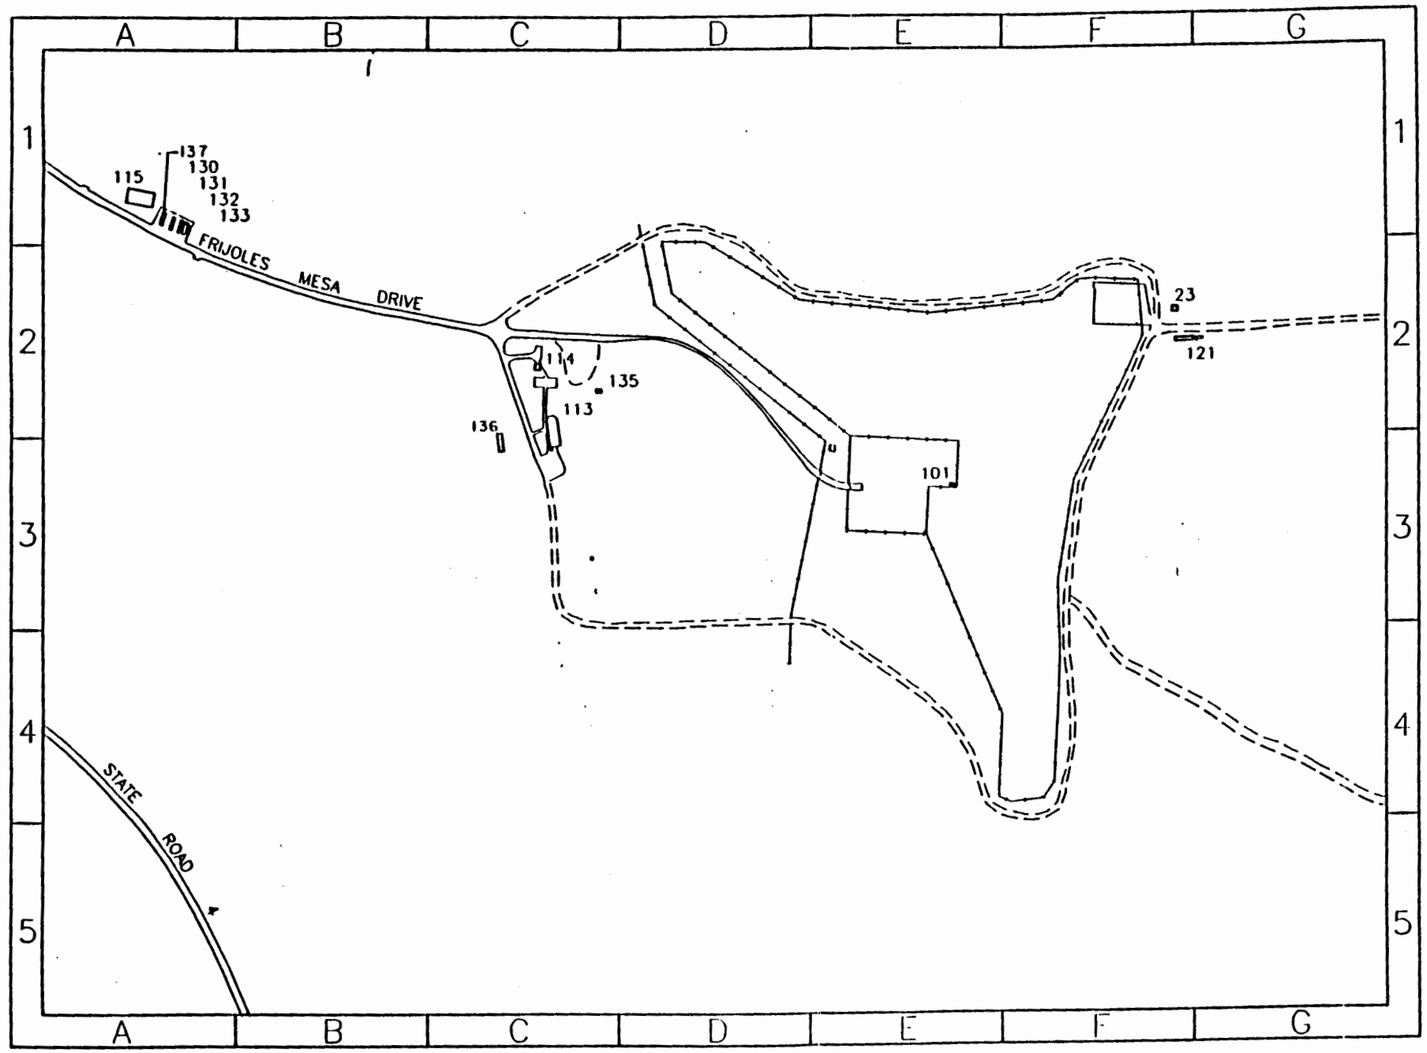

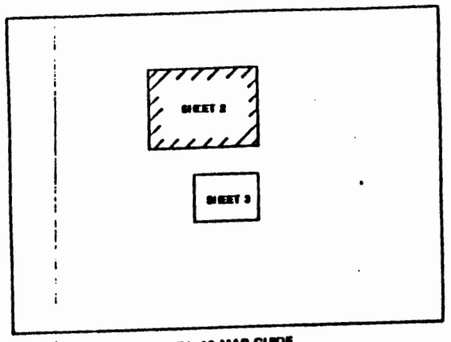

TA-49 MAP GUIDE

SCALE 1: 2400

200 0 200 400 FEET

N

LATEST DISTRIBUTION
20 DEC 91
EMERGENCY RESPONSE MAP
UPDATED DRAWING

NO.	DATE	LAST REV.	REVISIONS	DWN	DES	CKD	REL	SUB	REC	APP

FACILITIES ENGINEERING DIVISION

STRUCTURE LOCATION MAP
TA-49
FRIJOLES MESA SITE

DRAWN	C.SANDOVAL
DESIGN	
CHECKED	B. COMER
RELEASED	B. COMER
DATE	03-11-91

BLDG.

SUBMITTED RECOMMENDED APPROVED

LOS ALAMOS LOS ALAMOS NATIONAL LABORATORY LOS ALAMOS, NEW MEXICO 87545

SHEET 2 OF 3

CLASSIFICATION U REVIEWER DATE

LAB JOB NO.

DRAWING NO. ENG-R 5126

REV. 12

AUTOCIS

TA-49

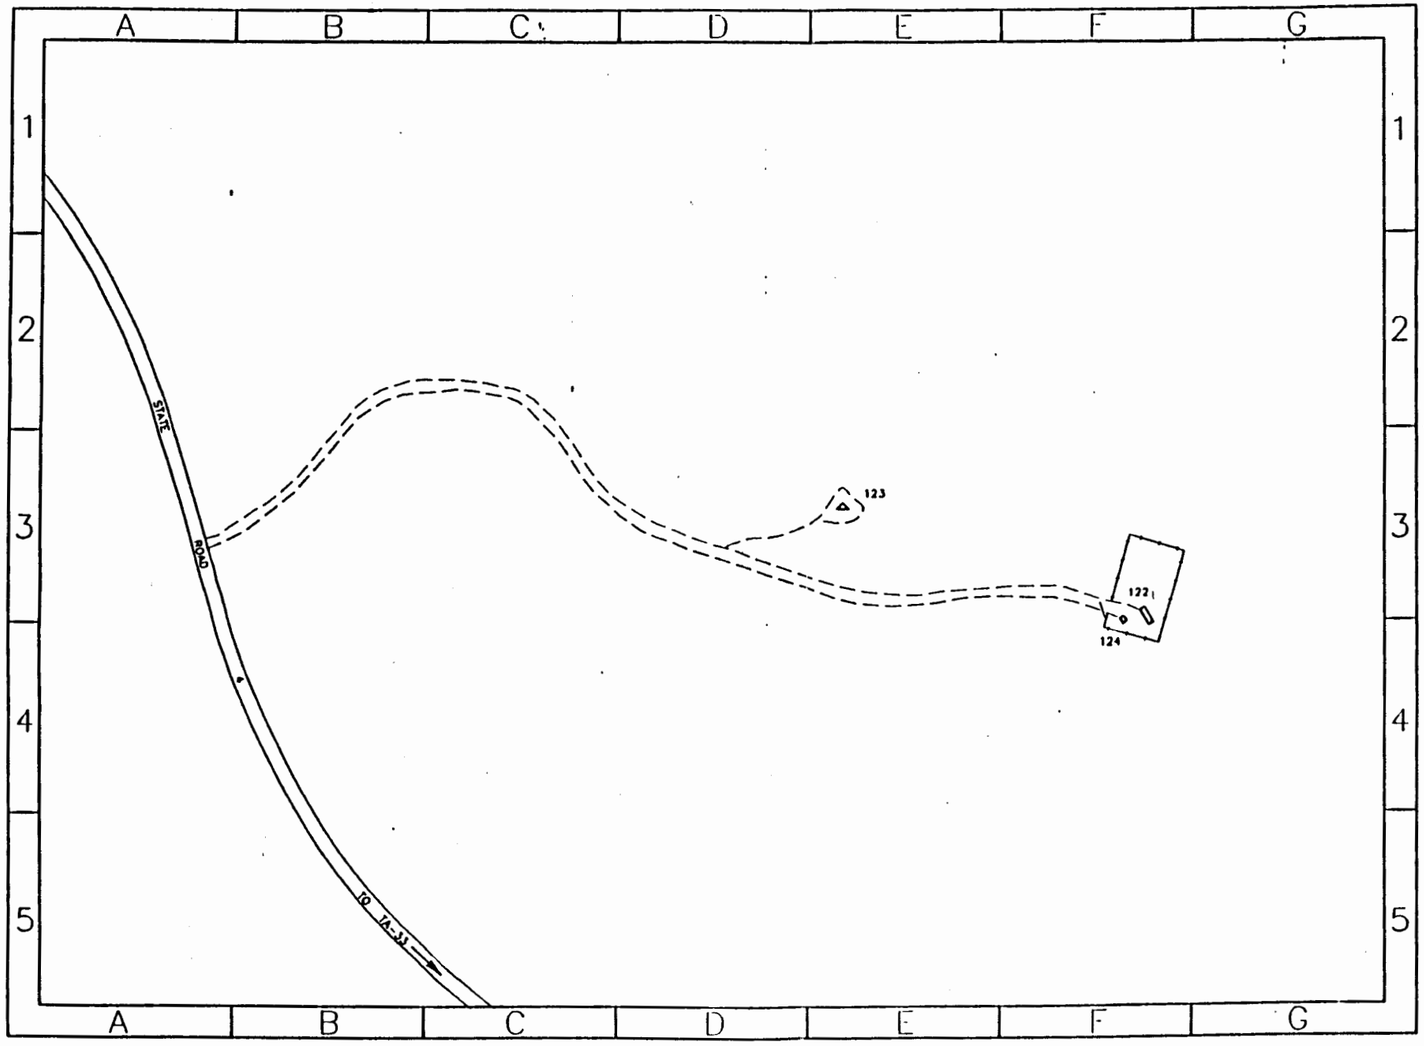

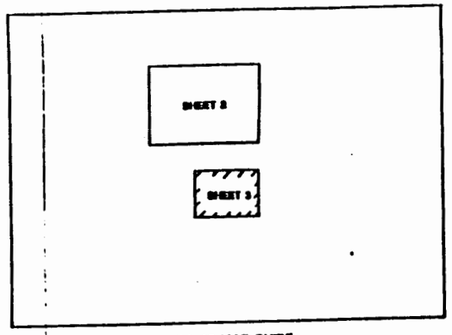

TA-49 MAP GUIDE

N

SCALE 1: 1200

100 0 100 200 FEET

LATEST DISTRIBUTION
20 DEC 9
EMERGENCY RESPONSE MAP
UPDATED DRAWING

AUTOCIS

NO.	DATE	LATEST REV.	REVISIONS	DWN	DES	CKD	REL	SUB	REC	APP

FACILITIES ENGINEERING DIVISION

STRUCTURE LOCATION MAP
TA-49
FRIJOLES MESA SITE

DRAWN	C. SANDOVAL
DESIGN	
CHECKED	B. COMER
RELEASED	B. COMER
DATE	03-11-91

BLDG.

SUBMITTED | RECOMMENDED | APPROVED

LOS ALAMOS — LOS ALAMOS NATIONAL LABORATORY, LOS ALAMOS, NEW MEXICO 87545

SHEET 3 OF 3

CLASSIFICATION U — REVIEWER — DATE 4-15-91

LAB JOB NO.

DRAWING NO. ENG-R 5126

REV. 12

STRUCTURE LOCATION MAPS

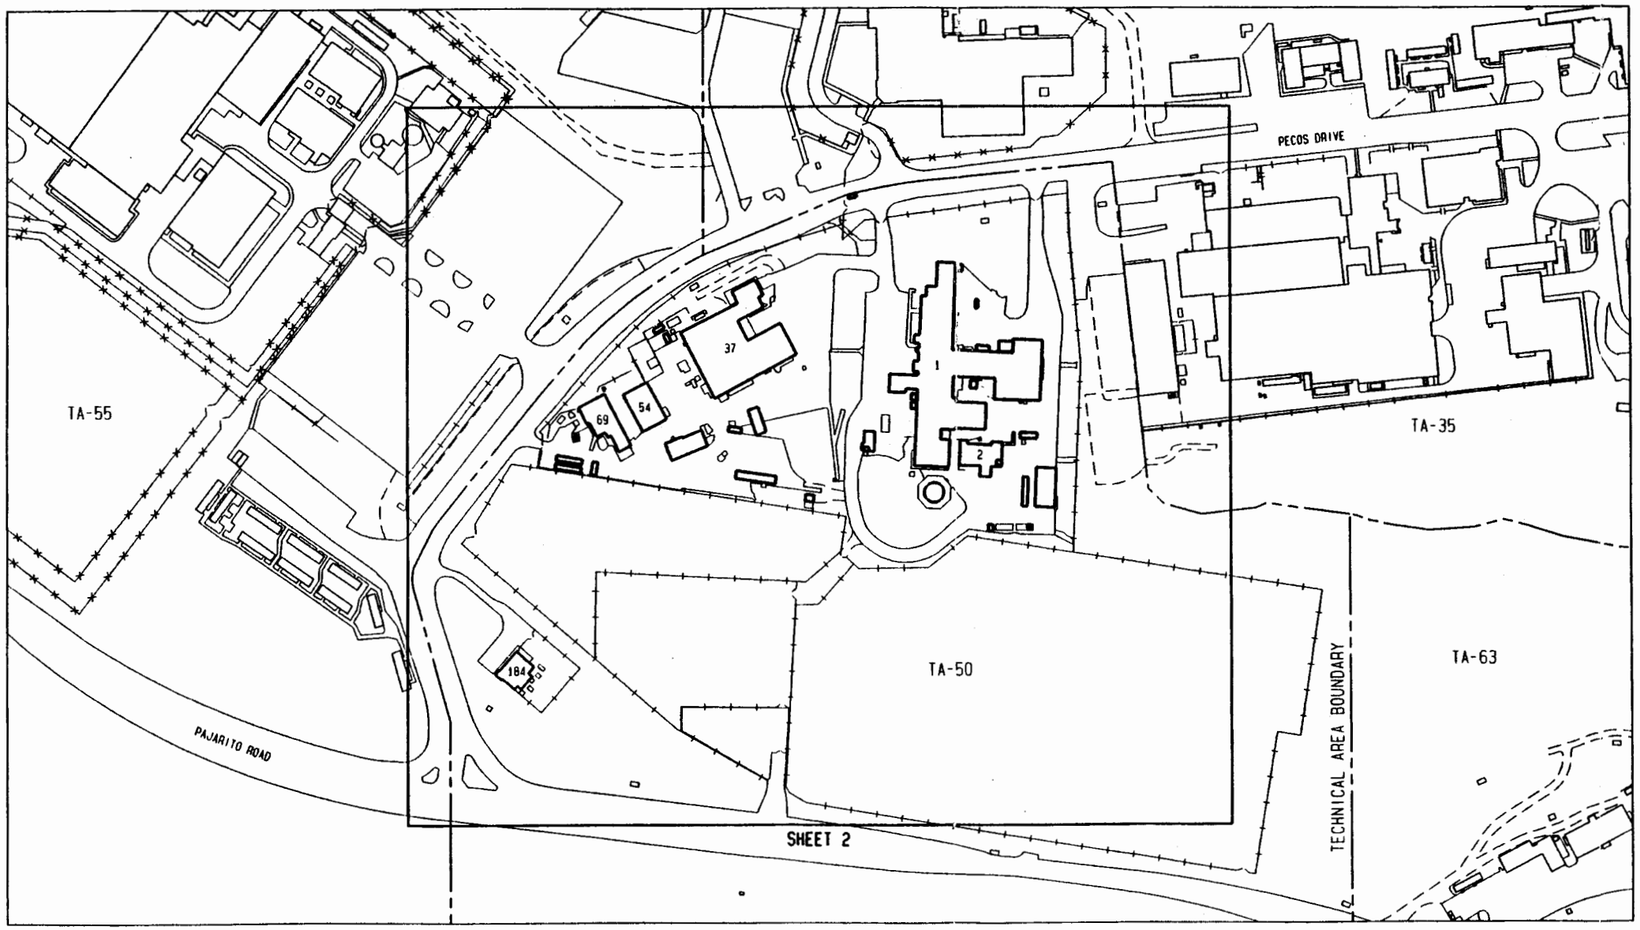

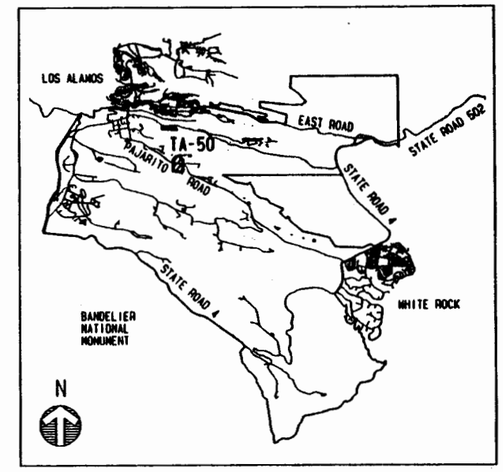

LOCATION PLAN

SCALE: NONE

TA-50 KEY MAP

SCALE: 1:1200

100 0 100 200

FEET

N

NO	DATE	CLASS REV	REVISIONS	DWN	VER	CHKD	REL	SUB	REC	APP
1	07-29-94		REVISED TO STATUS OF 07-25-94	JAC	JAC	JPW	HMS	JAF	BEC	RAP

JOHNSON CONTROLS WORLD SERVICES INC.

AS-BUILT STRUCTURE LOCATION MAPS

TA-50

WM SITE

DRAWN	D. BACA
VERIFIED	D. BACA
CHECKED	H. SALAZAR
RELEASED	H. SALAZAR
DATE	06-15-94

SUBMITTED JERRY FORTE | RECOMMENDED BRYAN COMER | APPROVED ROBERT PROMMEL

Los Alamos — Los Alamos National Laboratory, Los Alamos, New Mexico 87545

SHEET 1 OF 2

CLASSIFICATION U | REVIEWER H. SALAZAR | DATE 8-2-94

PROJECT ID 11952 | DRAWING NO AB37 | REV 1

JCI NO 91-020

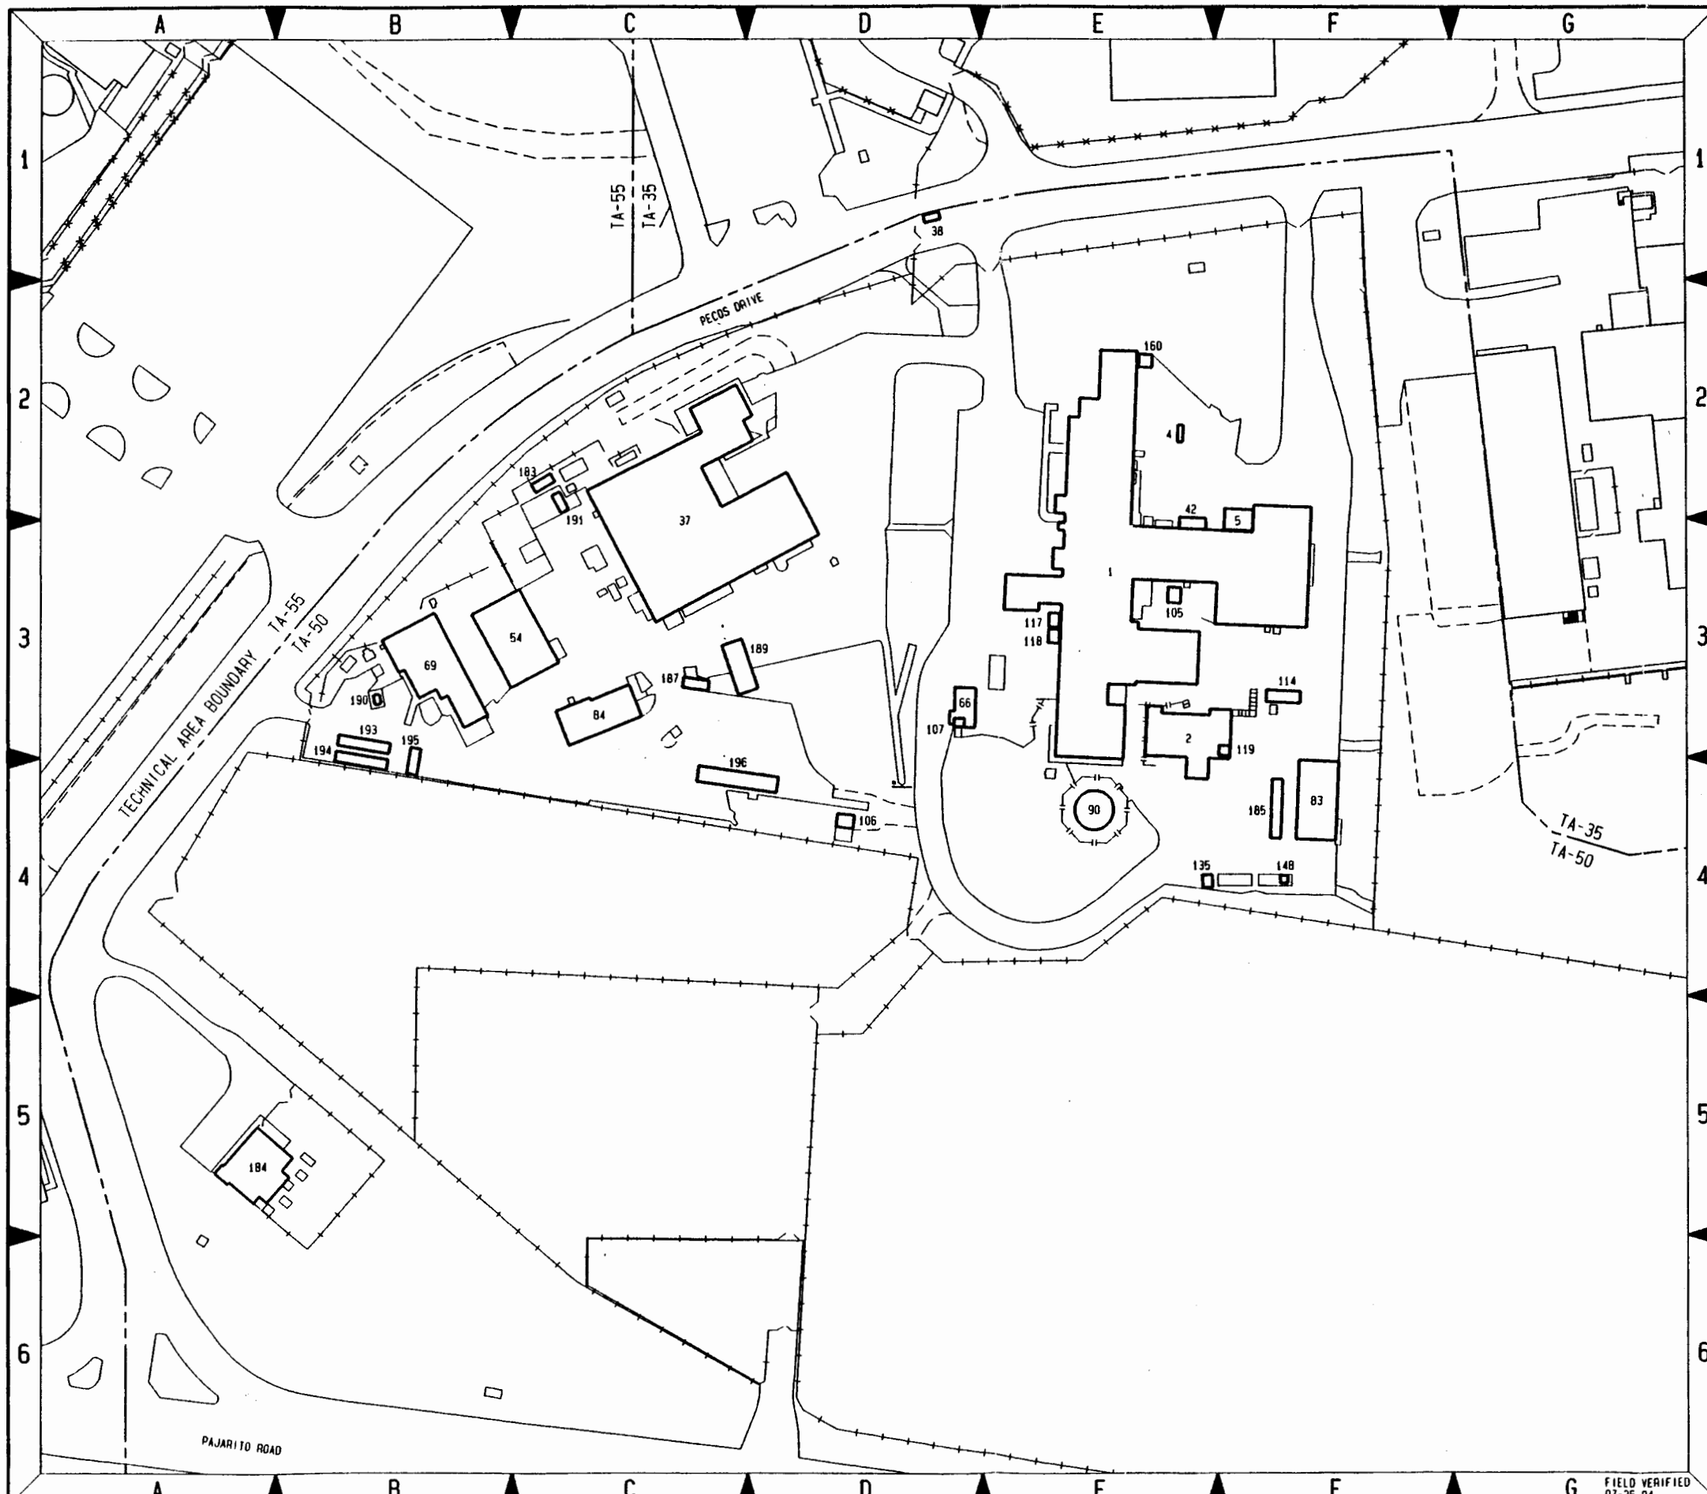

STRUCTURE LOCATION INDEX

TA-NUMBER	STRUCTURE DESIGNATION	STRUCTURE NOMENCLATURE	STRUCTURE LOCATOR SHEET NO.	STRUCTURE LOCATOR MAP KEY
50-1	50-1	LIQUID DISPOSAL PLANT	2	E-3
50-2	WM-2	PUMPING STATION, ACID	2	E-3
50-4	WM-4	SUBSTATION	2	E-2
50-5	50-5	HOLDING TANK, ACID	2	F-3
50-37	WM-37	TRANSURANIC BUILDING	2	C-3
50-38	WM-38	GUARD STATION	2	D-1
50-42	50-42	LIQUID FUEL TANK	2	E-3
50-54	WM-54	TDF WAREHOUSE	2	C-3
50-66	50-66	PIT, ACID & CAUSTIC	2	D-3
50-69	WM-69	SIZE REDUCTION FACILITY	2	B-3
50-83	50-83	STORAGE BUILDING	2	F-4
50-84	WM-84	TRANSPORTABLE OFFICE BLDG.	2	C-3
50-90	50-90	HOLDING TANK	2	E-4
50-105	50-105	STORAGE SHED	2	E-3
50-106	50-106	STORAGE SHED	2	D-4
50-107	50-107	EXHAUST STACK	2	D-3
50-114	50-114	MATERIALS CONTAINMENT BLDG.	2	F-3
50-117	50-117	STORAGE SHED	2	E-3
50-118	50-118	STORAGE SHED	2	E-3
50-119	50-119	STORAGE SHED	2	F-3
50-135	50-135	STORAGE SHED	2	E-4
50-148	50-148	SAFETY STORAGE	2	F-4
50-160	50-160	MORGAN SHED	2	E-2
50-183	50-183	DIESEL FUEL TANK	2	C-2
50-184	50-184	COMMUNICATIONS BUILDING	2	A-5
50-185	50-185	DECONTAMINATION TRAILER	2	F-4
50-187	50-187	TRANSPORTAINER	2	C-3
50-189	50-189	STORAGE SHED	2	C-3
50-190	50-190	HOLDING TANK	2	B-3
50-191	50-191	GENERATOR	2	C-2
50-193	50-193	TRANSPORTAINER	2	B-3
50-194	50-194	TRANSPORTAINER	2	B-4
50-195	50-195	TRANSPORTAINER	2	B-4
50-196	50-196	TRAILER, OFFICE	2	C-4

N

SCALE: 1:600

50 0 50 100
FEET

NO	DATE	CLASS REV	REVISIONS	DWN	VER	CHKD	REL	SUB	REC	APP
3	07-29-94		REVISED TO STATUS OF 07-25-94	JAC	JAC	JPM	HMS	JAF	BEC	RAP
2	06-15-94		REVISED PER NEW STANDARDS	DMB	JPM	HMS	HMS	JAF	BEC	RAP
1	01-31-94		REVISED TO STATUS OF 01-25-94	JPM	JPM	HMS	HMS	JAF	BEC	RAP

JOHNSON CONTROLS WORLD SERVICES INC.

AS-BUILT STRUCTURE LOCATION MAPS

TA-50

WM SITE

DRAWN	J. MORK
VERIFIED	J. MORK
CHECKED	H. SALAZAR
RELEASED	H. SALAZAR
DATE	01-31-94

SUBMITTED JERRY FORTE
RECOMMENDED BRYAN COMER
APPROVED ROBERT PROMMEL

Los Alamos

Los Alamos National Laboratory
Los Alamos, New Mexico 87545

SHEET 2 OF 2

CLASSIFICATION U REVIEWER H. SALAZAR DATE 8-2-94

PROJECT ID	DRAWING NO	REV
11952	AB37	3

JCI NO 91-020

TA-51

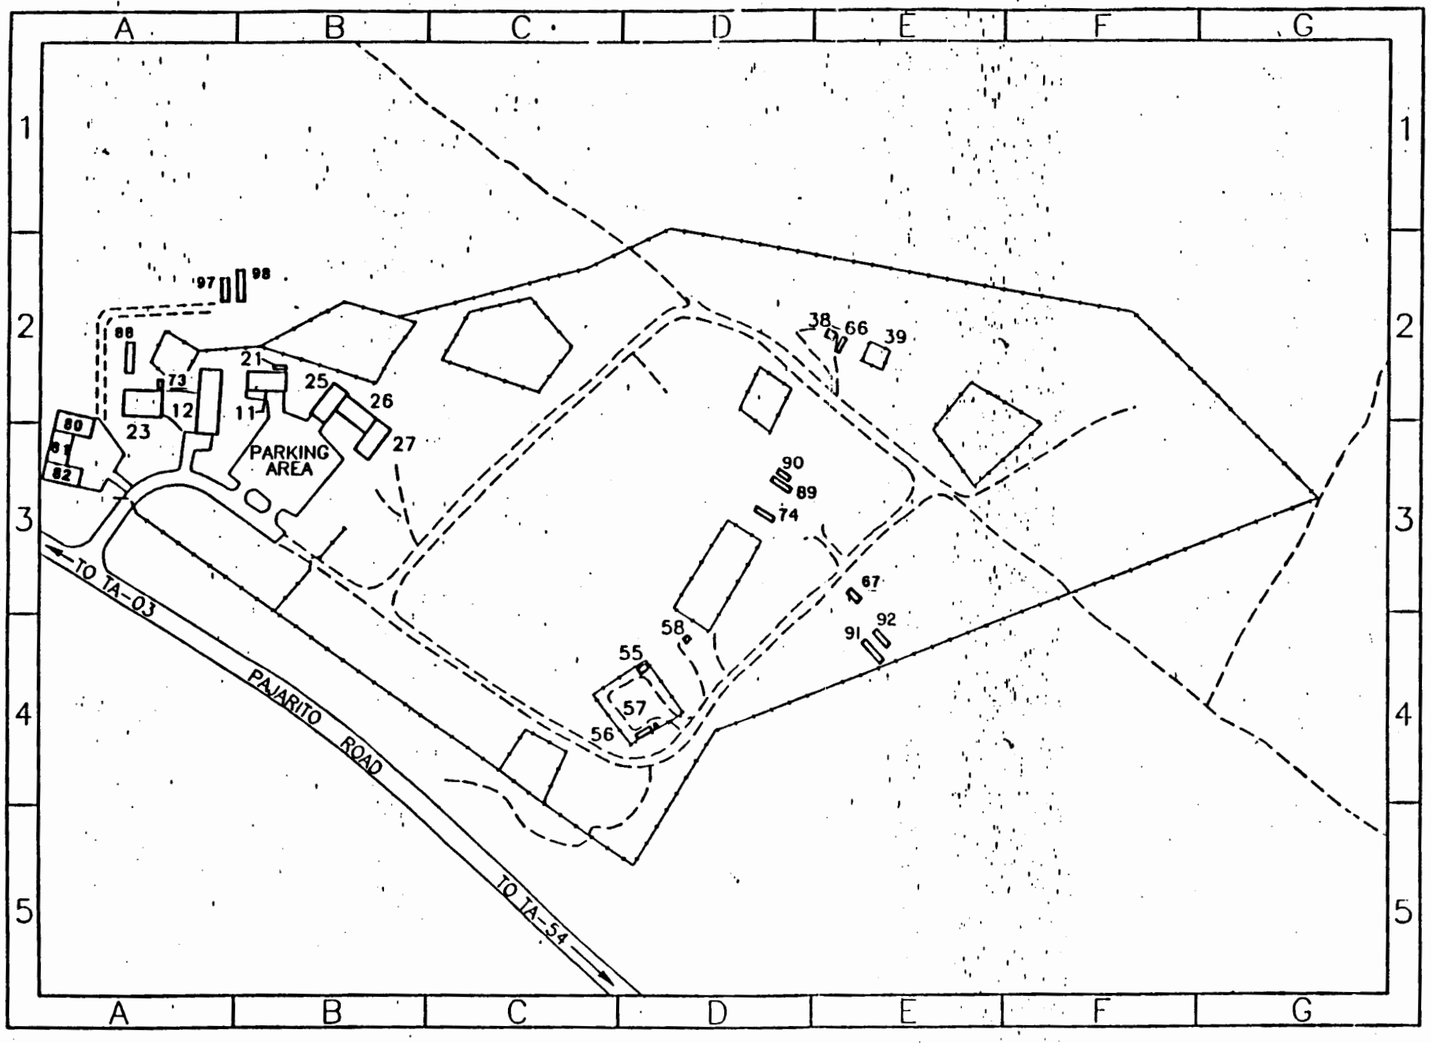

SCALE 1:1200

100 0 100 200 FEET

N

AUTOGIS

STRUCTURE NUMBER INDEX

STRUCTURE TA-NUMBER	STRUCTURE DESIGNATION	STRUCTURE NOMENCLATURE	STRUCTURE LOCATOR SHEET NO.	STRUCTURE LOCATOR MAP KEY
51- 11	51-11	ENVIRONMENTAL RESEARCH LAB	1	B-2
51- 12	51-12	ENVIRONMENTAL SCIENCE LAB	1	B-2
51- 21	REF-21	TRAILER	1	B-2
51- 23	REF-23	LIBRARY & MAINTENANCE BLDG	1	B-2
51- 25	REF-25	TRANSPORTABLE OFFICE BLDG.	1	B-2
51- 26	REF-26	TRANSPORTABLE OFFICE BLDG.	1	B-2
51- 27	REF-27	TRANSPORTABLE OFFICE BLDG.	1	B-2
51- 38	51-38	BURIAL CLUSTER	1	D-1
51- 39	51-39	BURIAL CLUSTER	1	D-1
51- 55	51-55	STORAGE SHED	1	C-2
51- 56	51-56	TRAILER, STORAGE	1	C-3
51- 57	51-57	STORAGE SHED	1	C-3
51- 58	51-58	STORAGE SHED	1	C-2
51- 66	51-66	TRAILER, LABORATORY	1	D-1
51- 67	51-67	TRAILER, LABORATORY	1	E-3
51- 73	51-73	HAZARDOUS WASTE STORAGE	1	A-2
51- 74	51-74	SEMI TRAILER	1	D-3
51- 80	51-80	TRANSPORTABLE OFFICE BLDG.	1	A-3
51- 81	51-81	TRANSPORTABLE OFFICE BLDG.	1	A-3
51- 82	51-82	TRANSPORTABLE OFFICE BLDG.	1	A-3
51- 88	51-88	TRAILER, OFFICE	1	A-2
51- 89	51-89	SEMI TRAILER	1	D-3
51- 90	51-90	SEMI TRAILER	1	D-3
51- 91	51-91	SEMI TRAILER	1	E-4
51- 92	51-92	SEMI TRAILER	1	E-4
51- 97	51-97	TRAILER, OFFICE	1	A-2
51- 98	51-98	TRAILER, OFFICE	1	B-2

LATEST DISTRIBUTION
29JUNE92
EMERGENCY RESPONSE MAP
UPDATED DRAWING

NO.	DATE	LAST REV.	REVISIONS	DWN	DES	CKD	REL	SUB	REC	APP

FACILITIES ENGINEERING DIVISION

STRUCTURE LOCATION MAP
TA-51
RADIATION EXPOSURE FACILITY

DRAWN	C. SANDOVAL
DESIGN	
CHECKED	B. COMER
RELEASED	B. COMER
DATE	03-06-91

BLDG.

SUBMITTED | RECOMMENDED | APPROVED

LOS ALAMOS — LOS ALAMOS NATIONAL LABORATORY, LOS ALAMOS, NEW MEXICO 87545

SHEET 1 OF 1

CLASSIFICATION U | REVIEWER | DATE

LAB JOB NO. | DRAWING NO. ENG-R 5128 | REV. 11

STRUCTURE LOCATION MAPS

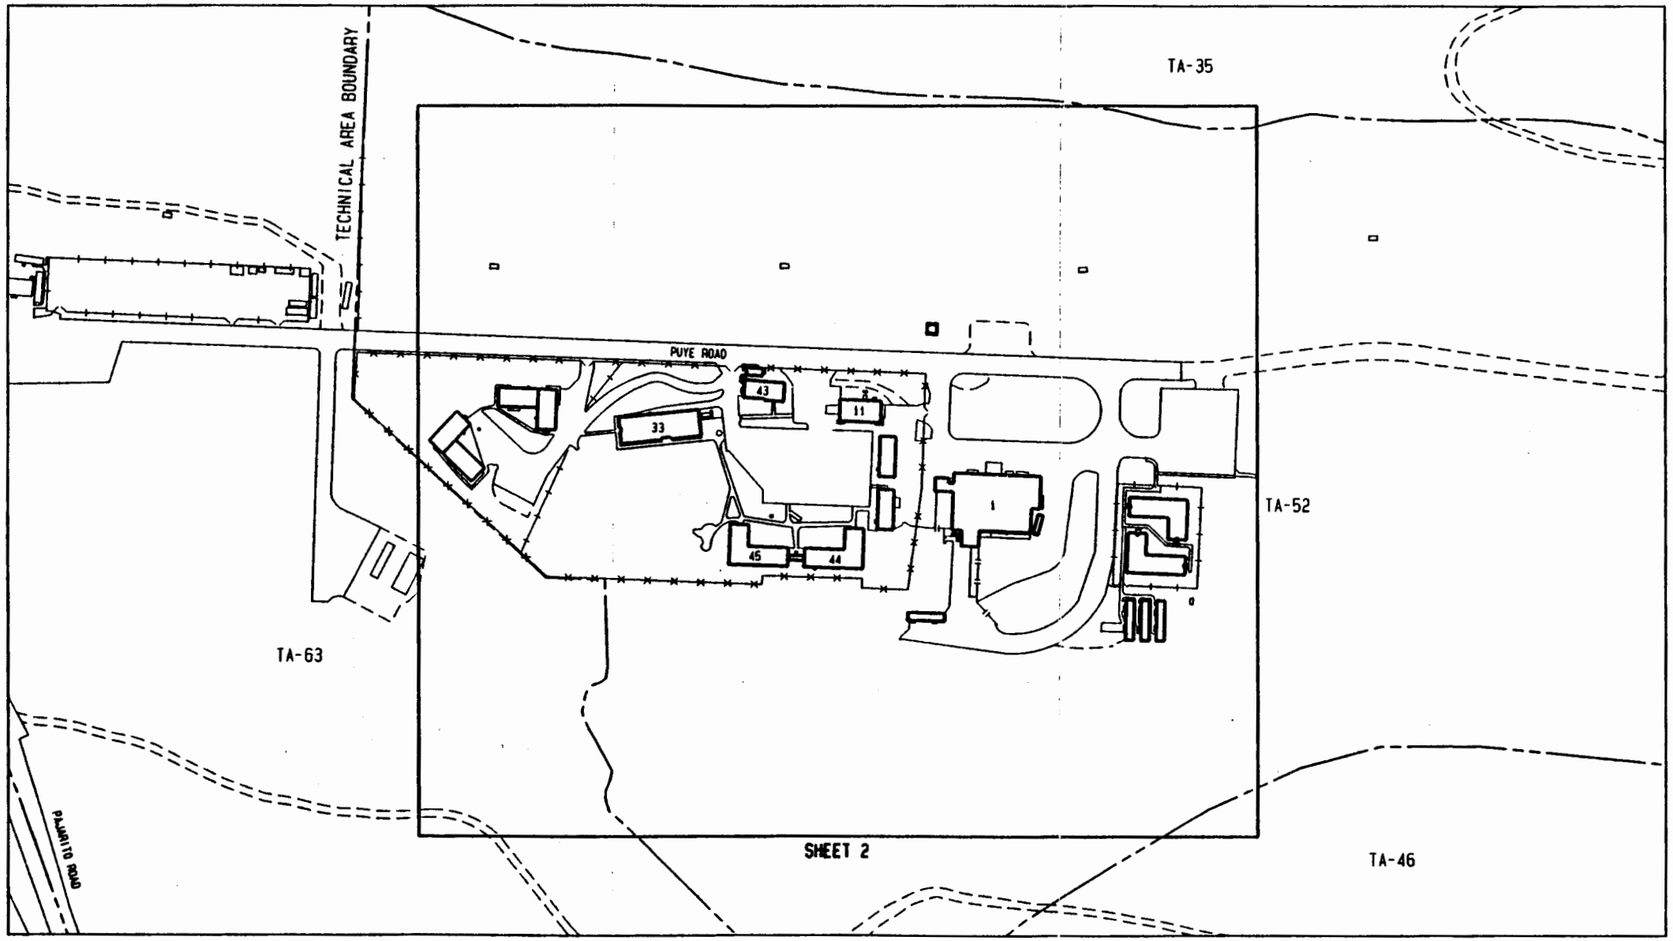

TA-52 KEY MAP

SCALE: 1:1200

100 0 100 200
FEET

N

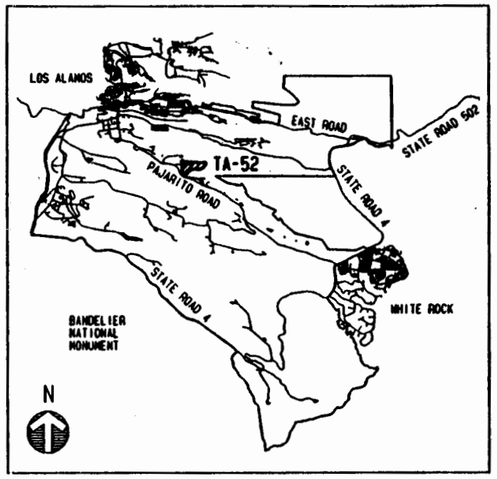

LOCATION PLAN

SCALE: NONE

NO	DATE	CLASS REV	REVISIONS	DWN	VER	CHKD	REL	SUB	REC	APP

JOHNSON CONTROLS WORLD SERVICES INC.

AS-BUILT STRUCTURE LOCATION MAPS

TA-52

REACTOR DEVELOPMENT SITE

DRAWN	B. BACA
VERIFIED	J. [illegible]
CHECKED	H. SALAZAR
RELEASED	H. SALAZAR
DATE	06-30-94

SUBMITTED JERRY FORTE — RECOMMENDED BRYAN COMER — APPROVED ROBERT PROMMEL

Los Alamos — Los Alamos National Laboratory, Los Alamos, New Mexico 87545

SHEET 1 OF 2

CLASSIFICATION U — REVIEWER H. SALAZAR — DATE 6/29/94

PROJECT ID 11952 — DRAWING NO AB39 — REV

JCI NO 91-020

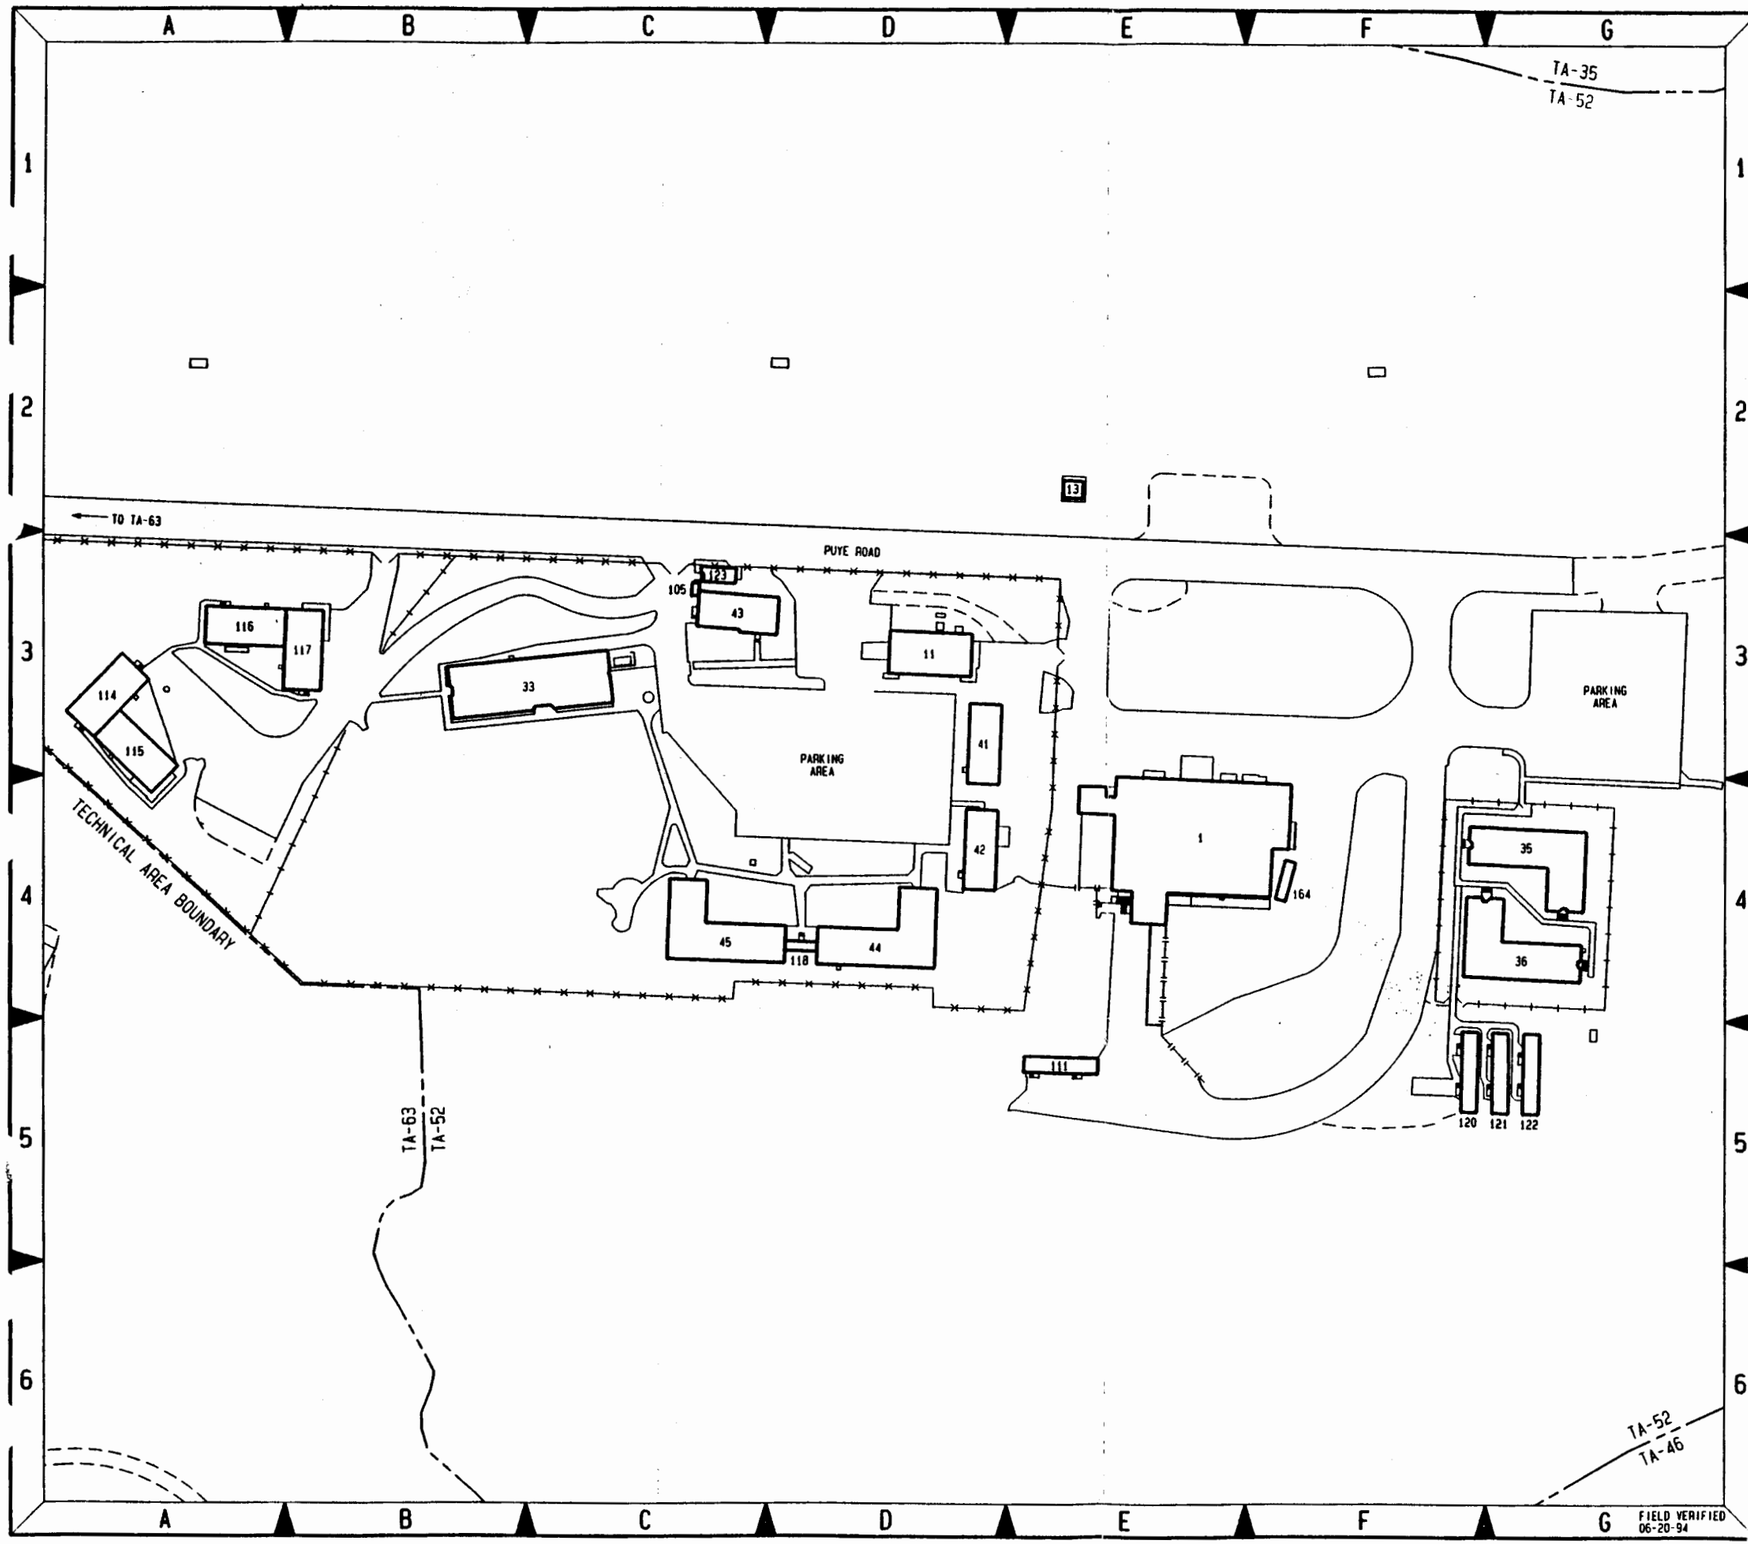

STRUCTURE LOCATION INDEX

TA-NUMBER	STRUCTURE DESIGNATION	STRUCTURE NOMENCLATURE	STRUCTURE LOCATOR SHEET NO.	STRUCTURE LOCATOR MAP KEY
52-1	RD-1	LABORATORY/OFFICE	2	E-4
52-11	RD-11	MECHANICAL ASSEMBLY BLDG.	2	D-3
52-13	RD-13	SWITCHGEAR	2	E-2
52-33	RD-33	WEAPONS SUPPORT OFFICE	2	C-3
52-35	RD-35	TRANSPORTABLE OFFICE BLDG.	2	G-4
52-36	RD-36	TRANSPORTABLE OFFICE BLDG.	2	G-4
52-41	52-41	TRANSPORTABLE OFFICE BLDG.	2	D-3
52-42	RD-42	TRANSPORTABLE OFFICE BLDG.	2	D-4
52-43	RD-43	TRANSPORTABLE OFFICE BLDG.	2	C-3
52-44	RD-44	TRANSPORTABLE OFFICE BLDG.	2	D-4
52-45	RD-45	TRANSPORTABLE OFFICE BLDG.	2	C-4
52-105	52-105	GUARD STATION #417	2	C-3
52-111	52-111	TRAILER, OFFICE	2	E-5
52-114	52-114	TRANSPORTABLE OFFICE BLDG.	2	A-3
52-115	52-115	TRANSPORTABLE OFFICE BLDG.	2	A-3
52-116	52-116	TRANSPORTABLE OFFICE BLDG.	2	A-3
52-117	52-117	TRANSPORTABLE OFFICE BLDG.	2	B-3
52-118	52-118	PASSAGEWAY	2	D-4
52-120	52-120	TRAILER, OFFICE	2	F-5
52-121	52-121	TRAILER, OFFICE	2	G-5
52-122	52-122	TRAILER, OFFICE	2	G-5
52-123	52-123	GUARD STATION	2	C-3
52-164	52-164	TRAILER, STORAGE	2	F-4

N

SCALE: 1:600

50 0 50 100

FEET

NO	DATE	CLASS REV	REVISIONS	DWN	VER	CHKD	REL	SUB	REC	APP

JOHNSON CONTROLS WORLD SERVICES INC.

AS-BUILT STRUCTURE LOCATION MAPS

TA-52

REACTOR DEVELOPMENT SITE

DRAWN O. BACA
VERIFIED J. FRONK
CHECKED H. SALAZAR
RELEASED H. SALAZAR
DATE 06-30-94

SUBMITTED JERRY FORTE
RECOMMENDED BRYAN COMER
APPROVED ROBERT PROMMEL

Los Alamos — Los Alamos National Laboratory, Los Alamos, New Mexico 87545

SHEET 2 OF 2

CLASSIFICATION U REVIEWER H. SALAZAR DATE 6/29/94

PROJECT ID 11952

DRAWING NO AB39

REV

JCI WO 91-020

STRUCTURE LOCATION MAPS

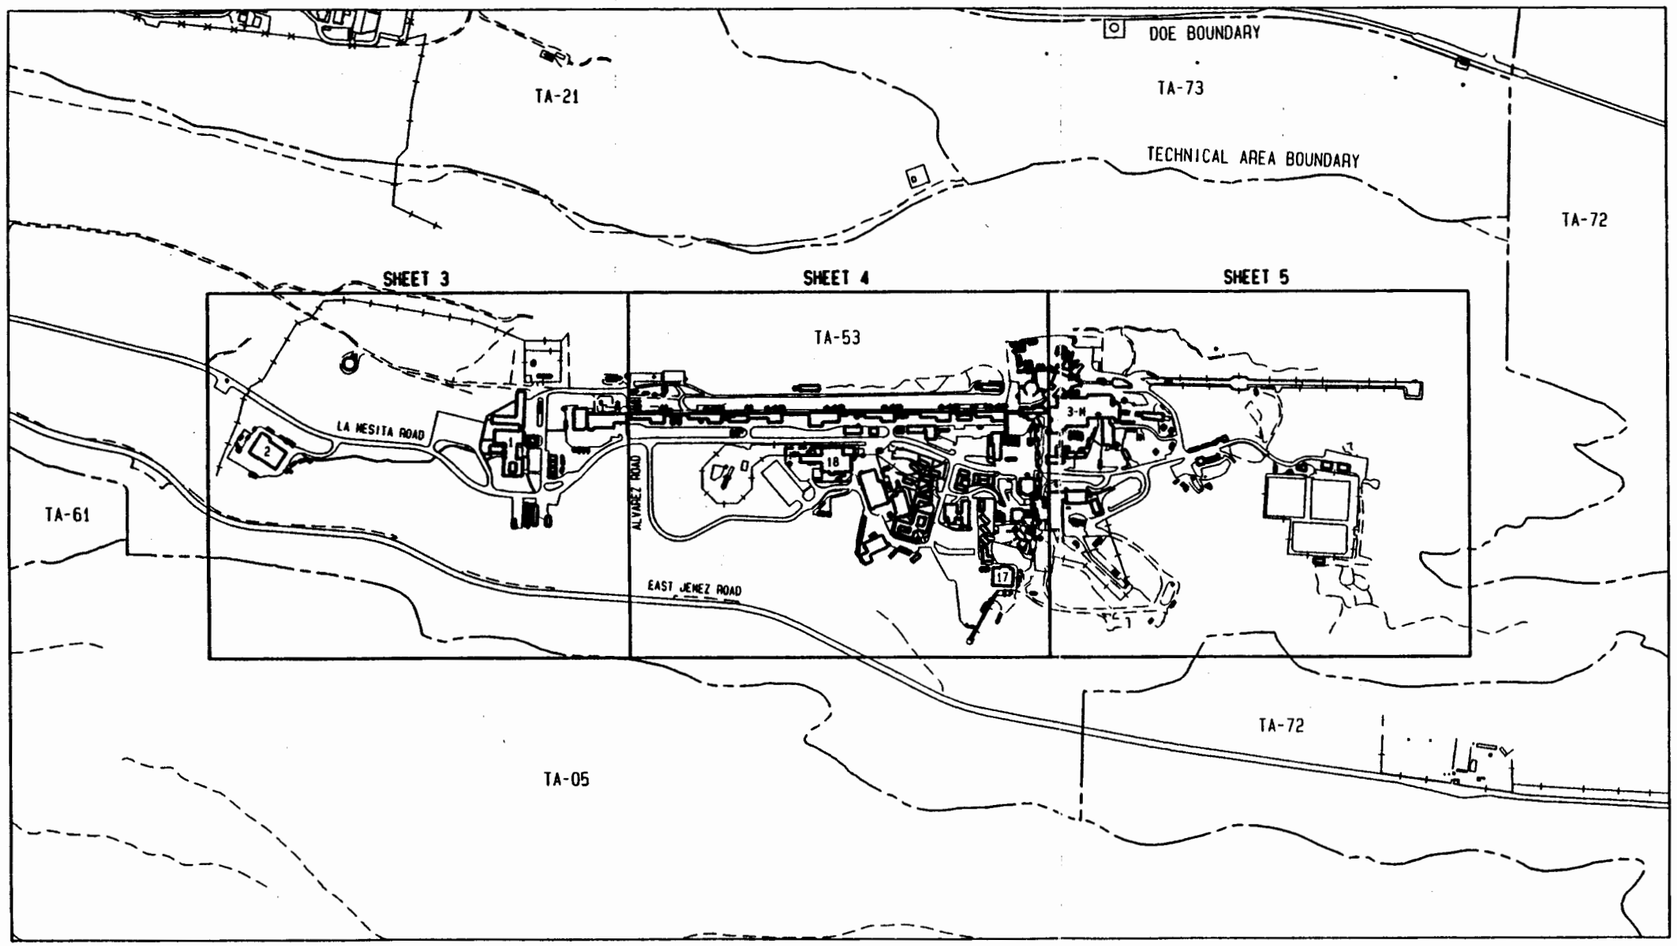

TA-53 KEY MAP

SCALE: 1:4800

400 0 400 800

FEET

N

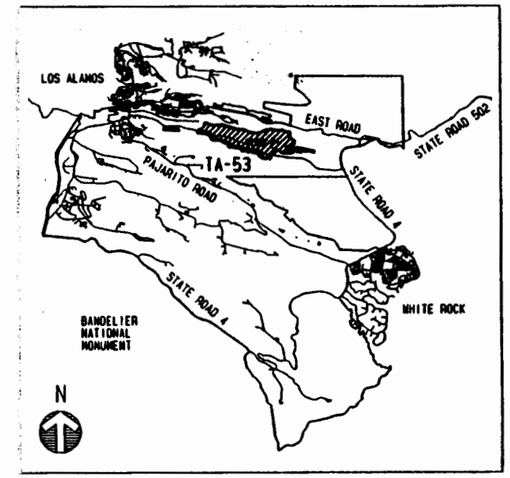

LOCATION PLAN

SCALE: NONE

NO	DATE	CLASS REV	REVISIONS	DWN	VER	CHKD	REL	SUB	REC	APP
1	06-30-94		REVISED TO NEW STANDARDS AND TO STATUS OF 05-28-94	JAC	JAC	JPH	HRS	JAP	BEC	RAP

JOHNSON CONTROLS WORLD SERVICES INC.

AS-BUILT STRUCTURE LOCATION MAPS

TA-53

WASTE DISPOSAL SITE

DRAWN	J. HORK
VERIFIED	J. HORK
CHECKED	H. SALAZAR
RELEASED	H. SALAZAR
DATE	06-30-94

SUBMITTED JERRY FORTE — RECOMMENDED BRYAN COMER — APPROVED ROBERT PROMMEL

Los Alamos — Los Alamos National Laboratory, Los Alamos, New Mexico 87545

SHEET 1 OF 5

CLASSIFICATION U — REVIEWER H. SALAZAR — DATE 6-30-94

PROJECT ID 11952 — DRAWING NO AB40 — REV 1

JCI NO 91-020

STRUCTURE LOCATION INDEX

TA-NUMBER	STRUCTURE DESIGNATION	STRUCTURE NOMENCLATURE	STRUCTURE LOCATOR SHEET NO.	STRUCTURE LOCATOR MAP KEY
53-1	MPF-1	LABORATORY & OFFICE BLDG.	3	F-3
53-2	MPF-2	EQUIPMENT TEST LABORATORY	3	A-3
53-3A	53-3A	SECTOR A	3	G-3
53-3B	53-3B	SECTOR B	4	A-3
53-3C	53-3C	SECTOR C	4	B-3
53-3D	53-3D	SECTOR D	4	C-3
53-3E	53-3E	SECTOR E	4	D-3
53-3F	53-3F	SECTOR F	4	E-3
53-3G	53-3G	SECTOR G	4	F-3
53-3H	53-3H	SECTOR H	4	G-3
53-3J	53-3J	SECTOR J	3	G-3
53-3M	53-3M	SECTOR M	5	A-2
53-3N	53-3N	SECTOR N	5	A-2
53-3P	53-3P	SECTOR P	4	G-2
53-3R	53-3R	SECTOR R	5	A-3
53-3S	53-3S	SECTOR S	4	G-2
53-4	MPF-4	OPERATIONS BUILDING	4	G-3
53-5	MPF-5	SERVICE CORRIDOR	4	G-3
53-6	53-6	ACCELERATOR TECH. BLDG.	4	F-4
53-7	MPF-7	WNR BUILDING	4	G-4
53-8	MPF-8	PROTON STORAGE RING LAB	4	G-4
53-10	MPF-10	HIGH RESOLUTION BEAM FAC.	5	A-2
53-14	MPF-14	ACCELERATOR TECHNOLOGY LAB	4	E-5
53-15	53-15	WNR LAB SUPPORT BUILDING	5	A-4
53-16	53-16	WAREHOUSE	5	A-4
53-17	MPF-17	PROTON STOR. RING FACILITY	4	G-5
53-18	MPF-18	FMIT WAREHOUSE	4	E-4
53-19	MPF-19	ACCELERATOR TECH LAB	4	E-4
53-20	MPF-20	MODULAR OFFICE BUILDING	4	F-4
53-21	MPF-21	MODULAR OFFICE BUILDING	4	F-4
53-22	MPF-22	DEV. & TESTING FACILITY	5	A-3
53-23	MPF-23	COMPUTER MAINTENANCE BLDG.	4	F-3
53-24	MPF-24	DATA ANALYSIS BUILDING	4	E-3
53-25	MPF-25	ACCEL. MAINTENANCE BLDG.	4	B-3
53-26	MPF-26	SUB-STOCKROOM & WAREHOUSE	4	D-3
53-27	MPF-27	CRAFTS SHOP	5	C-3
53-28	MPF-28	PROTON STOR. RING EQP. BL.	4	G-4
53-29	MPF-29	40 METER EXPERIMENT STA.	4	G-4
53-30	53-30	NEUTRON SCATTERING HALL	5	A-4
53-31	53-31	NPB TECH SUPPORT BLDG.	4	E-4
53-32	53-32	PRE-ENGINEERED SHED	5	E-3
53-34	53-34	SERVICE BUILDING	4	G-5
53-35	MPF-35	DETECTOR SHED	5	A-5
53-36	MPF-36	DETECTOR SHED	4	G-5
53-37	MPF-37	GUARD STATION	4	G-4
53-39	MPF-39	SHOP & STORAGE BUILDING	5	A-3
53-40	53-40	OFFICE BUILDING	3	F-4
53-41	MPF-41	WAREHOUSE	4	E-3
53-43	MPF-43	OFFICE BUILDING	5	A-3
53-44	MPF-44	TRANSPORTABLE	3	F-3
53-45	MPF-45	TRANSPORTABLE	3	F-3
53-46	MPF-46	TRANSPORTABLE	3	F-3
53-47	MPF-47	TRANSPORTABLE	3	F-3
53-54	MPF-54	PUMP HOUSE	3	C-2
53-55	MPF-55	WATER TANK	3	C-2
53-56	MPF-56	BEAD BLASTER BUILDING	3	A-3
53-60	MPF-60	COOLING TOWER	3	G-2
53-61	MPF-61	UTILITY BUILDING	3	G-2
53-62	MPF-62	COOLING TOWER	4	D-2
53-63	MPF-63	UTILITY BUILDING	4	C-2
53-64	MPF-64	COOLING TOWER	4	G-2
53-65	MPF-65	UTILITY BUILDING	4	F-2
53-70	53-70	115 KVA SUBSTATION	3	F-2
53-293	53-293	COOLING TOWER	4	E-3
53-294	53-294	COOLING TOWER	4	E-4
53-315	53-315	WRS COUNTING HOUSE	5	A-2
53-364	MPF-364	NEUTRON EXP. SERVICE BLDG.	5	B-3
53-365	53-365	ATSU FACILITY	4	D-3
53-368	MPF-368	PUMP SHED	4	G-4
53-369	53-369	WNR TARGET CELL #4	4	G-4
53-370	MPF-370	DETECTOR SHED	4	G-5
53-371	MPF-371	DETECTOR SHED	4	G-5
53-372	MPF-372	STORAGE SHED	4	G-5
53-374	MPF-374	METAL SHED	4	G-4
53-380	MPF-380	MORGAN SHED	4	G-4
53-381	MPF-381	DETECTOR SHED	4	G-4
53-382	MPF-382	DETECTOR SHED	4	G-4
53-384	MPF-384	DETECTOR SHED	4	G-5
53-385	53-385	GUARD STATION #457	4	E-5
53-389	53-389	TRAILER	5	A-2
53-394	53-394	TRANSPORTABLE OFFICE BLDG.	4	F-4
53-395	53-395	TRANSPORTABLE OFFICE BLDG.	4	F-4
53-396	53-396	TRANSPORTABLE OFFICE BLDG.	4	F-4
53-397	53-397	TRANSPORTABLE OFFICE BLDG.	4	F-4
53-398	53-398	TRANSPORTABLE OFFICE BLDG.	4	F-3
53-399	53-399	TRANSPORTABLE OFFICE BLDG.	4	G-4
53-400	MPF-400	TRANSPORTABLE OFFICE BLDG.	4	E-3
53-401	MPF-401	TRANSPORTABLE OFFICE BLDG.	4	E-3
53-402	MPF-402	TRANSPORTABLE OFFICE BLDG.	4	E-4
53-403	MPF-403	TRANSPORTABLE OFFICE BLDG.	4	F-3
53-404	MPF-404	TRANSPORTABLE OFFICE BLDG.	4	E-4
53-405	MPF-405	TRANSPORTABLE OFFICE BLDG.	4	E-4
53-406	MPF-406	TRANSPORTABLE OFFICE BLDG.	4	F-4
53-407	MPF-407	TRANSPORTABLE OFFICE BLDG.	4	F-5
53-408	MPF-408	TRANSPORTABLE OFFICE BLDG.	5	B-3
53-409	MPF-409	TRANSPORTABLE OFFICE BLDG.	4	E-4
53-410	MPF-410	TRAILER, MONITORING	3	B-3
53-411	MPF-411	TRAILER, OFFICE	3	F-3
53-413	53-413	TRAILER, OFFICE	4	F-3
53-415	MPF-415	TRAILER, OFFICE	3	F-3
53-416	53-416	TRAILER, OFFICE	3	F-3
53-420	MPF-420	TRAILER, OFFICE	3	F-3
53-421	MPF-421	TRAILER, OFFICE	3	F-3
53-422	MPF-422	TRAILER, OFFICE	5	A-3
53-426	MPF-426	TRAILER, OFFICE	4	E-3
53-427	MPF-427	TRAILER, OFFICE	4	E-3
53-428	53- 428	TRAILER, OFFICE	3	F-4
53-429	MPF-429	TRAILER, OFFICE	5	A-2
53-432	MPF-432	TRAILER, OFFICE	5	B-3
53-433	MPF-433	TRAILER, OFFICE	4	G-3
53-439	MPF-439	TRAILER, ELECTRONICS LAB	4	A-2
53-442	MPF-442	TRAILER, OFFICE	3	F-3
53-443	MPF-443	TRAILER, OFFICE	5	A-3
53-444	MPF-444	TRAILER, COMPUTER	5	B-2
53-445	MPF-445	TRAILER, LABORATORY	4	A-2
53-446	MPF-446	TRAILER, STORAGE	3	G-3
53-449	MPF-449	TRAILER, LABORATORY	5	A-3
53-450	53-450	TRAILER, OFFICE	3	F-4
53-451	MPF-451	TRAILER, SLEEPER	4	E-3
53-453	MPF-453	TRAILER, OFFICE	4	G-3
53-454	MPF-454	TRAILER, OFFICE	3	F-2
53-455	MPF-455	TRAILER, OFFICE	3	B-3
53-456	53-456	TRAILER, OFFICE	5	D-2
53-458	53-458	STORAGE TRAILER	4	A-2
53-460	MPF-460	TRAILER, LABORATORY	5	A-2
53-461	MPF-461	TRAILER, STORAGE	3	B-3
53-463	MPF-463	TRAILER, OFFICE	5	A-3
53-464	MPF-464	TRAILER, SHOP	4	G-2
53-467	MPF-467	TRAILER, OFFICE	4	A-2
53-469	MPF-469	TRAILER, STORAGE	4	B-3
53-470	MPF-470	TRAILER, LABORATORY	5	A-3
53-473	53-473	TRANSPORTAINER	5	A-3
53-474	MPF-474	TRAILER, OFFICE	3	F-3
53-475	MPF-475	TRAILER, OFFICE	4	G-1
53-476	53-476	TRAILER, OFFICE	5	A-1
53-482	MPF-482	TRAILER, LABORATORY	5	A-3
53-485	MPF-485	TRAILER, STORAGE	3	G-3
53-486	MPF-486	TRAILER, STORAGE	3	G-3
53-487	MPF-487	TRAILER, STORAGE	4	G-1
53-489	MPF-489	TRAILER, STORAGE	5	C-4
53-491	MPF-491	TRAILER, STORAGE	3	G-2
53-495	MPF-495	TRAILER, STORAGE	4	A-2
53-498	MPF-498	TRAILER, STORAGE	3	B-3
53-499	53-499	TRAILER, STORAGE	5	A-2
53-500	MPF-500	TRAILER, STORAGE	5	D-3
53-501	MPF-501	TRAILER, STORAGE	4	B-3
53-502	53-502	TRAILER, LABORATORY	4	G-3
53-505	MPF-505	TRAILER, REMOTE CONTROL	5	A-3
53-507	53-507	TRAILER, STORAGE	4	G-1
53-508	MPF-508	TRAILER, STORAGE	3	B-3
53-509	53-509	TRAILER, STORAGE	5	E-3
53-510	MPF-510	TRAILER, REMOTE CONTROL	5	A-3
53-511	53-511	METAL SHED	4	G-1
53-514	MPF-514	TRAILER, LABORATORY	5	B-3
53-515	53-515	TRAILER, OFFICE	5	F-4
53-516	53-516	STORAGE TRAILER	5	E-3
53-517	MPF-517	TRAILER, LABORATORY	4	G-1
53-520	MPF-520	TRAILER, OFFICE	5	A-2
53-524	53-524	TRAILER, OFFICE	3	F-4
53-525	MPF-525	TRAILER, OFFICE	4	G-3
53-526	MPF-526	TRANSPORTABLE OFFICE BLDG.	3	F-4
53-527	53-527	TRAILER, USER LOUNGE	4	F-3
53-535	MPF-535	TRAILER, STORAGE	5	C-6
53-539	MPF-539	TRAILER, ELECTRONICS LAB	4	G-3
53-540	MPF-540	TRAILER, LAB/OFFICE	4	G-4
53-541	MPF-541	TRAILER, LAB/OFFICE	4	G-4
53-544	53-544	TRAILER, OFFICE	5	C-3
53-545	53-545	TRAILER, LABORATORY	4	A-2
53-549	MPF-549	TRAILER, LAB/OFFICE	4	E-5
53-553	53-553	TRAILER, OFFICE	5	C-3
53-558	MPF-558	TRAILER, OFFICE	5	A-2
53-569	53-569	TRAILER, OFFICE	5	C-3
53-570	53-570	TRAILER, OFFICE	5	C-3
53-573	53-573	TRAILER, OFFICE	4	G-5
53-574	53-574	TRAILER	5	A-4
53-575	MPF-575	TRAILER, EQUIPMENT	5	A-2
53-576	53-576	TRAILER, LABORATORY	5	B-2
53-594	53-594	TRANSPORTAINER	5	C-4
53-595	MPF-595	TRANSPORTAINER	4	A-2
53-596	53-596	TRANSPORTAINER	5	A-1
53-597	53-597	TRANSPORTAINER	4	A-2
53-598	53-598	TRANSPORTAINER	4	A-3
53-599	53-599	TRANSPORTAINER	4	A-3
53-600	53-600	TRANSPORTAINER	4	D-4
53-601	53-601	TRANSPORTAINER	4	D-4
53-602	53-602	TRANSPORTAINER	4	A-2
53-603	53-603	TRANSPORTAINER	4	D-4
53-604	53-604	TRANSPORTAINER	3	G-3
53-605	MPF-605	TRANSPORTAINER	3	F-4
53-606	MPF-606	TRANSPORTAINER	4	A-3
53-607	MPF-607	TRANSPORTAINER	3	B-3
53-608	MPF-608	TRANSPORTAINER	3	B-3
53-609	MPF-609	TRANSPORTAINER	3	B-3
53-610	53-610	TRANSPORTAINER	3	B-3
53-612	53-612	TRANSPORTAINER	4	G-3
53-614	53-614	TRANSPORTAINER	4	F-2
53-615	53-615	TRANSPORTAINER	4	F-2
53-616	53-616	DETECTOR SHED	4	F-6
53-617	53-617	CRYOGENIC BLDG.	4	D-3
53-618	53-618	TRANSPORTAINER	4	F-6
53-620	MPF-620	COMPRESSOR BUILDING	4	E-4
53-621	MPF-621	LEAD STORAGE BUILDING	5	E-5
53-622	53-622	M.L. NEUTRON EXPERIMENTAL HALL	5	A-4
53-625	53-625	STORAGE SHED	4	G-5
53-633	53-633	TRAILER, LABORATORY	4	G-6
53-635	53-635	TRAILER, STORAGE	5	C-[illegible]
53-636	53-636	TRAILER, STORAGE	5	C-4
53-637	53-637	HYDROGEN TANK	4	C-3
53-638	53-638	LIQUID NITROGEN TANK	4	C-3
53-639	53-639	HELIUM STORAGE TANK	4	C-3
53-640	53-640	MINERAL OIL TANK	5	B-3
53-642	53-642	TRAILER, CYIOGENICS	4	A-2
53-644	53-644	SHED	5	B-2
53-645	53-645	TANK	4	E-4
53-671	53-671	MORGAN SHED	5	C-4
53-673	53-673	STORAGE SHED	5	C-4
53-674	53-674	STORAGE SHED	5	C-3
53-675	53-675	TRAILER, STORAGE	5	C-3
53-676	53-676	GUARD STATION #458	4	D-4
53-677	53-677	STORAGE SHED	4	A-2
53-678	53-678	EQUIPMENT SHED	4	E-4
53-679	53-679	METAL SHED	5	A-5
53-680	MPF-680	TRANSPORTAINER	4	B-3
53-681	53-681	TRANSPORTAINER	5	B-2
53-682	53-682	TRANSPORTAINER	4	G-5
53-683	53-683	TRANSPORTAINER	4	E-4
53-684	53-684	MILITARY SHELTER	4	F-6
53-685	53-685	MILITARY SHELTER	4	F-6
53-686	53-686	TRANSPORTAINER	4	G-3
53-687	53-687	TRANSPORTAINER	4	G-5
53-688	53-688	TRANSPORTAINER	5	A-3
53-689	53-689	TRANSPORTAINER	4	G-3
53-694	53-694	TRAILER, OFFICE	5	C-3
53-696	53-696	TRANSPORTAINER	4	F-6
53-697	53-697	TRANSPORTAINER	4	F-6
53-698	53-698	TRANSPORTAINER	4	F-6
53-699	53-699	TRANSPORTAINER	4	F-6
53-700	53-700	TRANSPORTAINER	4	D-5
53-701	MPF-701	TRANSPORTAINER	4	D-5
53-702	MPF-702	TRANSPORTAINER	4	D-5
53-703	MPF-703	TRANSPORTAINER	4	D-5
53-704	MPF-704	TRANSPORTAINER	4	D-4
53-705	MPF-705	TRANSPORTAINER	4	D-4
53-706	MPF-706	TRANSPORTAINER	4	D-4
53-707	53-707	TRANSPORTAINER	3	A-3
53-708	53-708	TRANSPORTAINER	4	D-3
53-709	53-709	TRANSPORTAINER	4	D-3
53-710	MPF-710	TRANSPORTAINER	4	E-4
53-711	53-711	TRANSPORTAINER	4	D-4
53-712	53-712	TRANSPORTAINER	4	D-4
53-713	53-713	TRANSPORTAINER	4	D-4
53-714	53-714	TRANSPORTAINER	4	F-5
53-715	53-715	TRANSPORTAINER	4	D-4
53-716	53-716	TRANSPORTAINER	5	A-3
53-717	MPF-717	TRANSPORTAINER	3	B-3
53-718	53-718	TRANSPORTAINER	4	C-3
53-719	MPF-719	TRANSPORTAINER	4	G-1
53-720	MPF-720	TRANSPORTAINER	4	G-1
53-721	MPF-721	TRANSPORTAINER	4	G-1
53-722	MPF-722	TRANSPORTAINER	4	G-1
53-723	MPF-723	TRANSPORTAINER	4	G-1
53-724	53-724	TRANSPORTAINER	4	F-5
53-726	53-726	TRANSPORTAINER	5	A-4
53-733	53-733	STORAGE SHED	3	F-2
53-734	53-734	STORAGE SHED	5	B-6
53-735	53-735	STORAGE SHED	5	C-5
53-737	53-737	COUNTING HOUSE	5	A-2
53-738	53-738	COUNTING HOUSE	5	A-2
53-739	53-739	STORAGE TANK	5	A-1
53-740	53-740	STORAGE TANK	4	G-1
53-741	53-741	STORAGE TANK	4	G-1
53-742	53-742	STORAGE TANK	4	G-1
53-744	53-744	STORAGE SHED	5	B-3
53-745	53-745	EQUIPMENT SHED	3	A-3
53-746	53-746	EQUIPMENT SHED	3	A-3
53-747	53-747	TRANSPORTAINER	4	A-2
53-748	53-748	TRANSPORTAINER	3	F-2
53-749	53-749	TRANSPORTAINER	5	B-2
53-754	53-754	TRANSPORTAINER	4	F-6
53-755	53-755	TRANSPORTAINER	4	A-2
53-757	53-757	CRYOGENIC BLDG.	4	D-3
53-758	53-758	CRYO. UTILITY ENCLOSURE	4	B-3
53-759	53-759	WEATHER SHELTER	4	B-4
53-760	53-760	HYDROGEN TANK	4	B-4
53-765	53-765	TRANSPORTAINER	4	F-2
53-773	53-773	TRAILER, EXPERIMENTAL	5	B-2
53-774	53-774	PORTAL MONITOR	4	G-4
53-776	MPF-776	TRANSPORTAINER	5	A-5
53-777	MPF-777	TRANSPORTAINER	5	A-5
53-778	53-778	TRANSPORTAINER	3	G-2
53-779	MPF-779	TRANSPORTAINER	4	D-3
53-780	MPF-780	TRANSPORTAINER	5	A-5
53-781	MPF-781	TRANSPORTAINER	5	A-5
53-782	MPF-782	TRANSPORTAINER	5	A-5
53-783	MPF-783	TRANSPORTAINER	5	A-5
53-784	MPF-784	TRANSPORTAINER	4	G-3
53-786	MPF-786	TRANSPORTAINER	4	D-4
53-787	MPF-787	TRANSPORTAINER	4	D-4
53-803	53-803	TRANSPORTAINER	4	A-2
53-804	MPF-804	TRANSPORTAINER	5	A-3
53-805	MPF-805	TRANSPORTAINER	5	A-3
53-806	MPF-806	TRANSPORTAINER	4	G-1
53-807	MPF-807	TRANSPORTAINER	4	B-3
53-808	MPF-808	TRANSPORTAINER	4	D-3
53-809	MPF-809	TRANSPORTAINER	3	F-4
53-810	MPF-810	TRAILER, LABORATORY	4	G-2
53-812	MPF-812	TRANSPORTAINER	4	A-2
53-813	MPF-813	TRANSPORTAINER	3	F-4
53-814	MPF-814	TRANSPORTAINER	3	A-3
53-815	MPF-815	TRANSPORTAINER	3	F-4
53-816	53-816	TRANSPORTAINER	5	A-2
53-818	MPF-818	TRANSPORTAINER	4	A-2
53-819	MPF-819	TRANSPORTAINER	4	C-2
53-823	MPF-823	WNR BLDG. #7	4	G-4
53-826	MPF-826	METAL SHED	5	A-4
53-828	MPF-828	TRANSPORTAINER	3	A-3
53-829	MPF-829	TRANSPORTAINER	3	A-3
53-830	MPF-830	TRANSPORTAINER	3	A-3
53-831	MPF-831	TRANSPORTAINER	3	A-3
53-832	MPF-832	TRANSPORTAINER	3	A-3
53-833	MPF-833	TRANSPORTAINER	4	D-3
53-834	MPF-834	TRANSPORTAINER	4	D-5
53-835	MPF-835	TRANSPORTAINER	4	E-4
53-836	53-836	TRANSPORTAINER	4	F-5
53-839	MPF-839	TRANSPORTAINER	5	A-3
53-840	53-840	TRANSPORTAINER	4	G-3
53-841	MPF-841	TRANSPORTAINER	4	F-2
53-843	MPF-843	TRANSPORTAINER	5	A-3
53-844	53-844	TRANSPORTAINER	4	G-3
53-845	MPF-845	TRANSPORTAINER	3	F-4
53-846	MPF-846	TRANSPORTAINER	4	F-5
53-847	MPF-847	TRANSPORTAINER	4	F-5
53-848	MPF-848	TRANSPORTAINER	4	F-5
53-849	MPF-849	TRANSPORTAINER	4	G-3
53-850	MPF-850	TRANSPORTAINER	4	D-5
53-851	MPF-851	TRANSPORTAINER	4	D-4
53-852	MPF-852	TRANSPORTAINER	4	C-3
53-853	MPF-853	TRANSPORTAINER	4	D-4
53-854	MPF-854	TRANSPORTAINER	4	D-4
53-855	MPF-855	TRANSPORTAINER	4	D-4
53-856	MPF-856	TRANSPORTAINER	4	D-4
53-857	MPF-857	TRANSPORTAINER	4	D-4
53-858	MPF-858	TRANSPORTAINER	4	D-4
53-859	MPF-859	TRANSPORTAINER	4	D-4
53-860	53-860	TRANSPORTAINER	3	A-3
53-862	53-862	STORAGE BOX	5	C-4
53-865	53-865	TRANSPORTAINER	4	G-3
53-866	MPF-866	TRANSPORTAINER	4	D-4
53-867	MPF-867	TRANSPORTAINER	4	D-4
53-870	MPF-870	TRANSPORTAINER	4	D-4
53-872	MPF-872	TRANSPORTAINER	4	D-4
53-873	MPF-873	TRANSPORTAINER	4	D-4
53-874	MPF-874	TRANSPORTAINER	4	D-3
53-878	53-878	TRANSPORTAINER	3	G-3
53-880	53-880	SEMI-TRAILER	4	G-5
53-882	MPF-882	TRANSPORTABLE OFFICE BLDG.	4	F-5
53-883	53-883	STORAGE SHED	4	G-3
53-885	MPF-885	TRANSPORTABLE	4	E-5
53-886	MPF-886	TRANSPORTABLE	4	E-5
53-889	MPF-889	TRAILER, REST ROOM	4	E-5
53-890	MPF-890	TRANSPORTAINER	3	A-3
53-894	53-894	TRANSPORTAINER	3	G-3
53-898	53-898	TRANSPORTABLE OFFICE BLDG.	4	G-2
53-1020	53-1020	METEOROLOGICAL TOWER	5	C-1
53-1021	53-1021	TRANSPORTAINER	3	G-2
53-1022	53-1022	TRANSPORTAINER	4	A-3
53-1030	53-1030	TRANSPORTAINER	4	F-6
53-1031	53-1031	STORAGE SHED	5	B-5
53-1032	53-1032	COOLING TOWER	4	E-3
53-1036	53-1036	TRANSPORTAINER	3	A-3
53-1037	53-1037	TRANSPORTAINER	3	B-3
53-1038	53-1038	VALVE ROOM	4	E-3
53-1039	53-1039	METAL SHED	5	A-4
53-1043	53-1043	TRANSPORTAINER	4	G-4
53-1045	53-1045	SHED	4	G-2
53-1046	53-1046	MORGAN SHED	5	C-2
53-1050	53-1050	TRANSPORTAINER	5	A-3
53-1053	53-1053	CHEMICAL WASTE STORAGE	4	D-3
53-1054	53-1054	SHED	4	D-3
53-1057	53-1057	WATER CEREMKOF DETECTOR	5	B-3
53-1058	53-1058	MINERAL OIL TANK	5	C-3
53-1059	53-1059	STORAGE TRAILER	4	G-4
53-1060	53-1060	LIQUID NITROGEN TANK	4	G-4
53-1062	53-1062	EQUIPMENT SHELTER	4	E-4
53-1063	53-1063	EQUIPMENT SHELTER	4	D-5
53-1064	53-1064	EQUIPMENT SHELTER	5	A-3
53-1065	53-1065	WATER CEREMKOF DETECTOR	5	B-3
53-1066	53-1066	WATER CEREMKOF DETECTOR	5	B-2
53-1067	53-1067	WATER CEREMKOF DETECTOR	5	B-3
53-1068	53-1068	WATER CEREMKOF DETECTOR	5	C-3
53-1070	53-1070	COOLING TOWER	4	G-4
53-1071	53-1071	SPILL CONTAINMENT AREA	5	E-3
53-1072	53-1072	SPILL CONTAINMENT AREA	5	E-3
53-1073	53-1073	TRANSPORTAINER	4	G-5
53-1088	53-1088	TRANSPORTAINER	4	G-6
53-1089	53-1089	TRANSPORTAINER	4	F-6
53-1090	53-1090	PORTAL MONITOR	4	G-4
53-1114	53-1114	TRANSPORTAINER	4	A-3
53-1115	53-1115	TRANSPORTAINER	4	A-3
53-1116	53-1116	TRANSPORTAINER	4	B-3
53-1117	53-1117	TRANSPORTAINER	4	B-3
53-1118	53-1118	TRANSPORTAINER	4	B-2
53-1120	53-1120	TRANSPORTAINER	5	A-5
53-1121	53-1121	TRANSPORTAINER	5	A-5
53-1138	53-1138	METAL SHED	4	G-4
53-1139	53-1139	CHEM. STORAGE SHED	4	D-5
53-1145	53-1145	E,S & H CHECKPOINT	3	A-2
53-1146	53-1146	HAZ. WASTE STORAGE	4	G-3
53-1147	53-1147	TRAILER, STORAGE	4	G-4
53-1168	53-1168	TRAILER, EXPERIMENTAL	4	D-5

NO	DATE	CLASS REV	REVISIONS	DWN	VER	CHKD	REL	SUB	REC	APP
2	06-30-94		REVISED TO NEW STANDARDS AND TO STATUS OF 05-28-94	JAC	JAC	JPN	HMS	JAF	BEC	RAP
1	01-31-94		REVISED TO STATUS OF 01-21-94	JPN	JPN	HMS	HMS	JAF	BEC	RAP

JOHNSON CONTROLS WORLD SERVICES INC.

AS-BUILT STRUCTURE LOCATION MAPS

TA-53

MESON PHYSICS FACILITY

DRAWN: J. NORK
VERIFIED: J. NORK
CHECKED: H. SALAZAR
RELEASED: H. SALAZAR
DATE: 01-31-94

SUBMITTED: JERRY FORTE
RECOMMENDED: BRYAN COMER
APPROVED: ROBERT PROMMEL

Los Alamos — Los Alamos National Laboratory, Los Alamos, New Mexico 87545

SHEET 2 / 5

CLASSIFICATION: U REVIEWER: H. SALAZAR DATE: 6-30-94

PROJECT ID: 11952
DRAWING NO: AB40
REV: 2

JCI NO 91-020

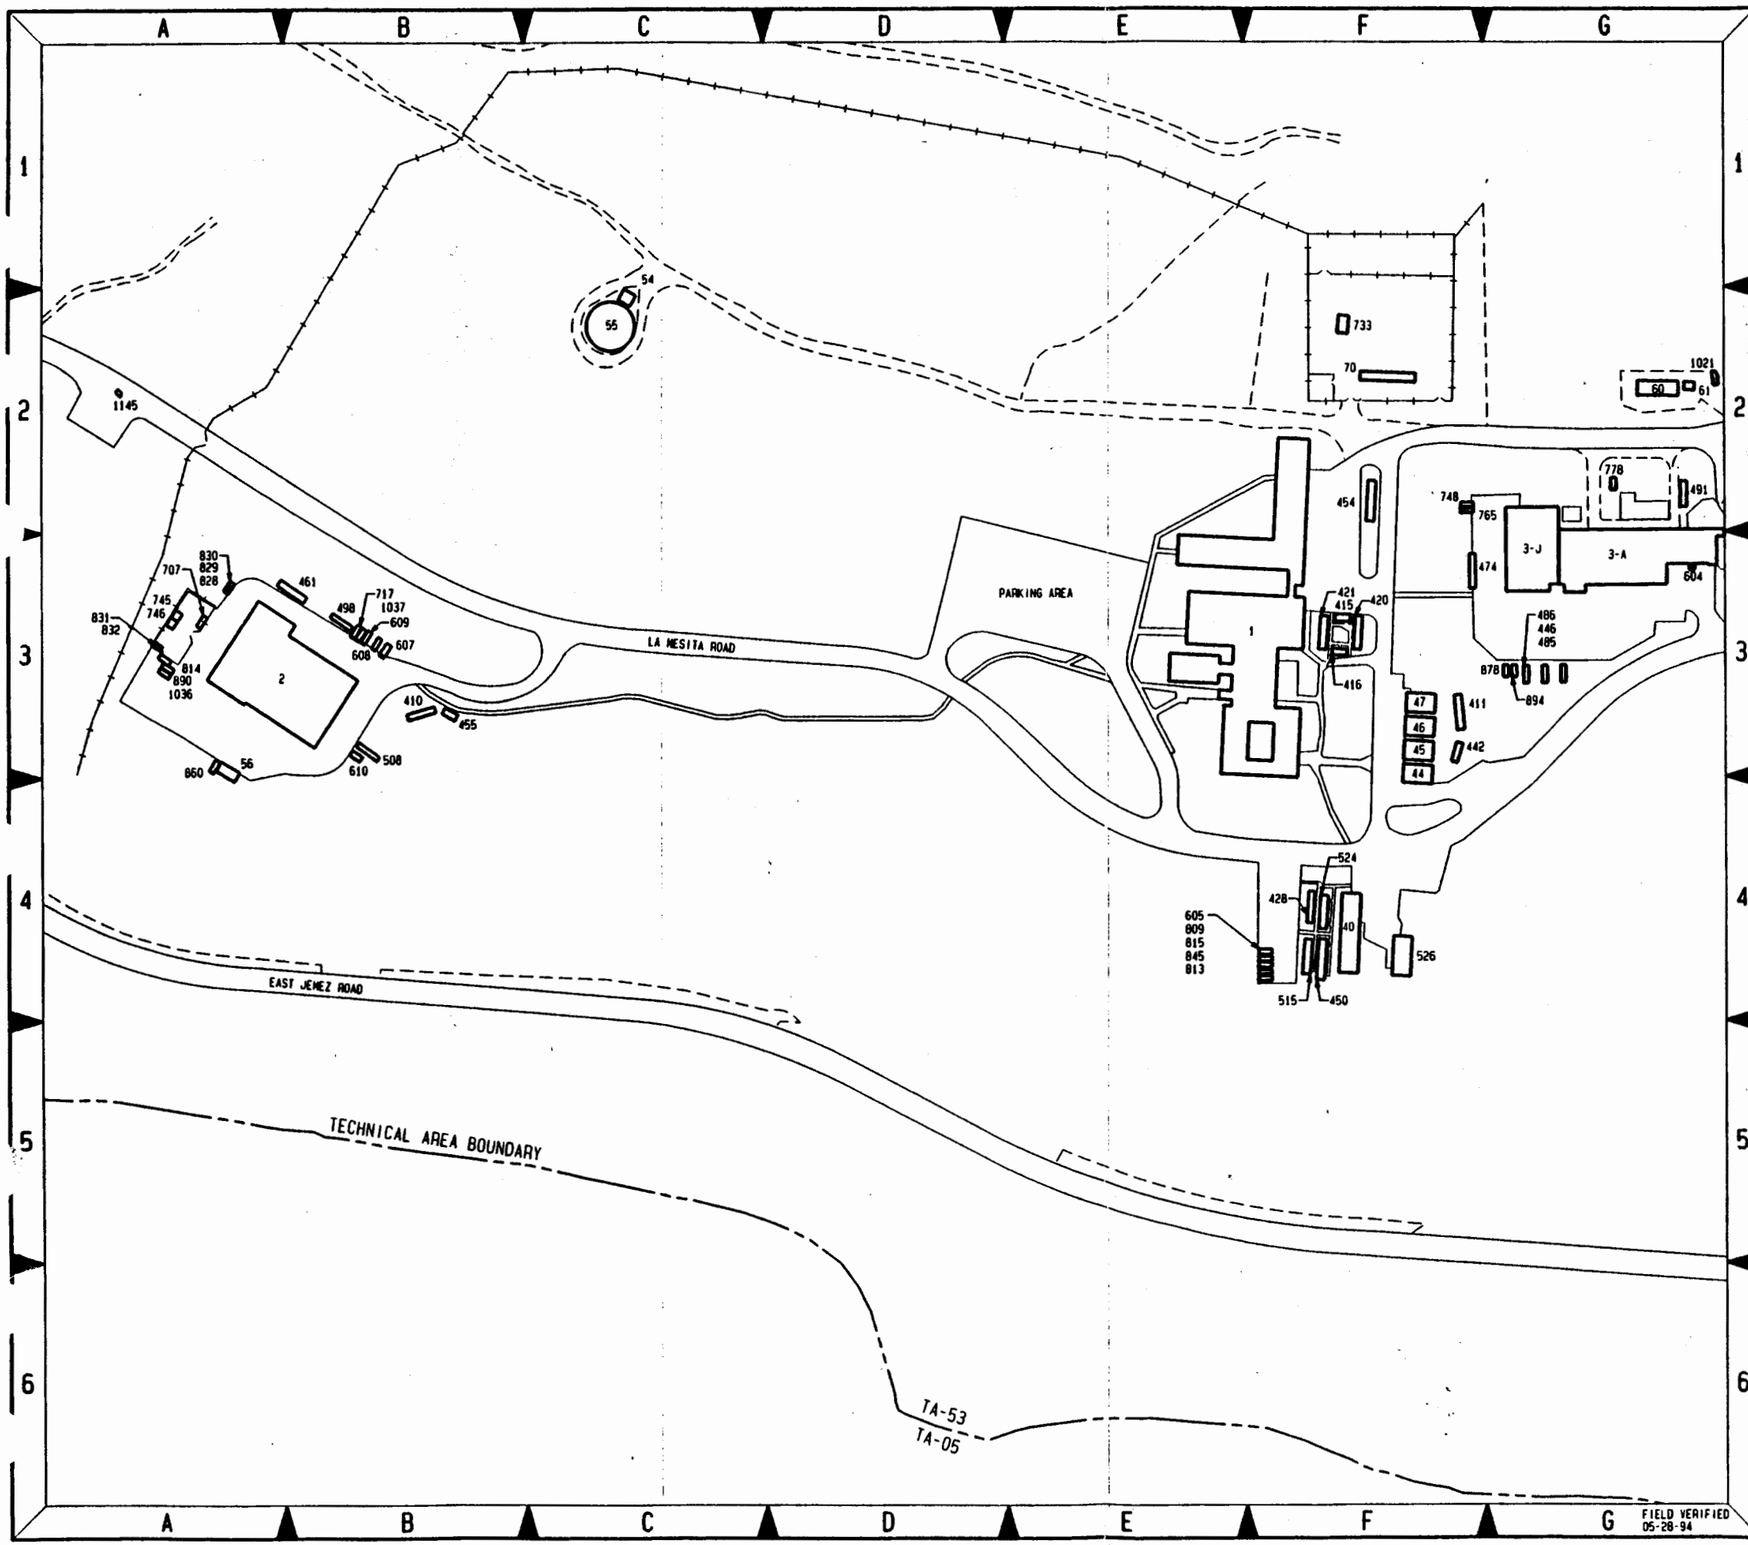

FIELD VERIFIED 05-28-94

KEY MAP

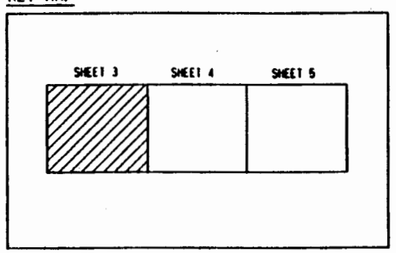

N

SCALE: 1:1200

100 0 100 200

FEET

NO	DATE	CLASS REV	REVISIONS	DWN	VER	CHKD	REL	SUB	REC	APP
2	06-30-94		REVISED TO NEW STANDARDS AND TO STATUS OF 05-28-94	JAC	JAC	JPM	HWS	JAF	BEC	RAP
1	01-31-94		REVISED TO STATUS OF 01-21-94	JPM	JPM	HWS	HWS	JAF	BEC	RAP

JOHNSON CONTROLS WORLD SERVICES INC.

AS-BUILT STRUCTURE LOCATION MAPS

TA-53

MESON PHYSICS FACILITY

DRAWN	J. NORK
VERIFIED	J. NORK
CHECKED	H. SALAZAR
RELEASED	H. SALAZAR
DATE	01-31-94

SUBMITTED JERRY FORTE — RECOMMENDED BRYAN COMER — APPROVED ROBERT PROMMEL

Los Alamos

Los Alamos National Laboratory
Los Alamos, New Mexico 87545

SHEET 3 OF 5

CLASSIFICATION U — REVIEWER H. SALAZAR — DATE 6-20-94

PROJECT ID 11952 — DRAWING NO AB40 — REV 2

JC NO 91-020

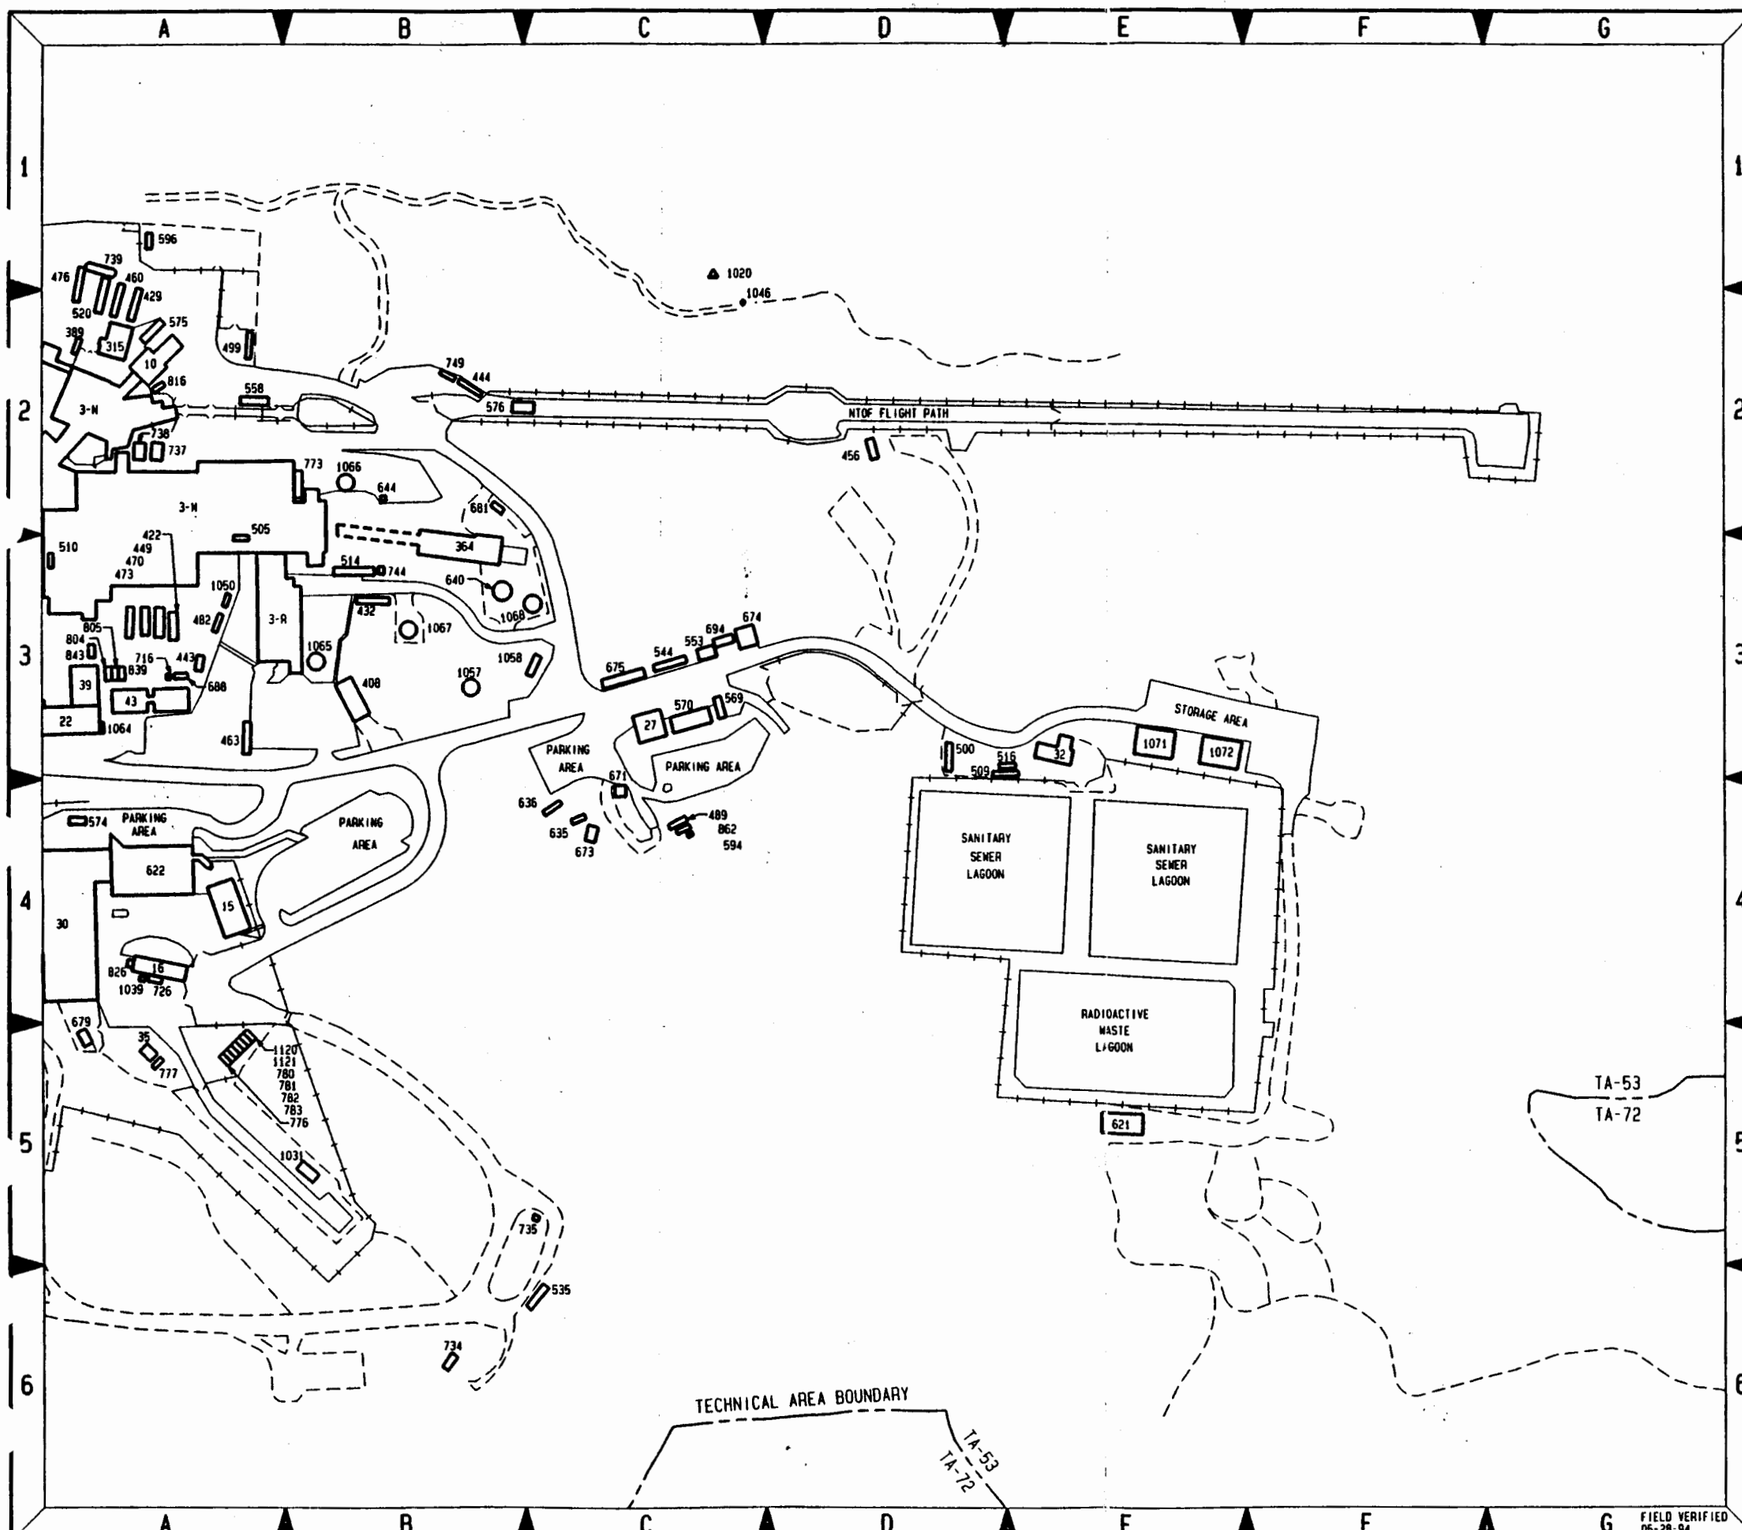

KEY MAP

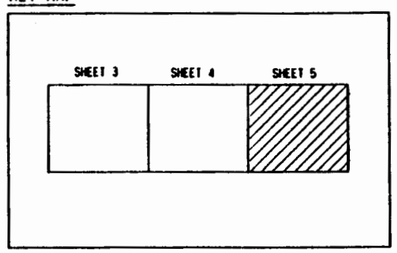

N

SCALE: 1:1200

100 0 100 200

FEET

NO	DATE	CLASS REV	REVISIONS	DWN	VER	CHKD	REL	SUB	REC	APP
2	06-30-94		REVISED TO NEW STANDARDS AND TO STATUS OF 05-28-94	JAC	JAC	JPM	HMS	JAF	BEC	RAP
1	01-31-94		REVISED TO STATUS OF 01-21-94	JPM	JPM	HMS	HMS	JAF	BEC	RAP

JOHNSON CONTROLS WORLD SERVICES INC.

AS-BUILT STRUCTURE LOCATION MAPS

TA-53

MESON PHYSICS FACILITY

DRAWN
VERIFIED
CHECKED H. SALAZAR
RELEASED H. SALAZAR
DATE 01-31-94

SUBMITTED JERRY FORTE
RECOMMENDED BRYAN COMER
APPROVED ROBERT PROMMEL

Los Alamos — Los Alamos National Laboratory, Los Alamos, New Mexico 87545

SHEET 5 OF 5

CLASSIFICATION U REVIEWER H. SALAZAR DATE 6-30-94

PROJECT ID 11952

DRAWING NO AB40

REV 2

JC NO 1020

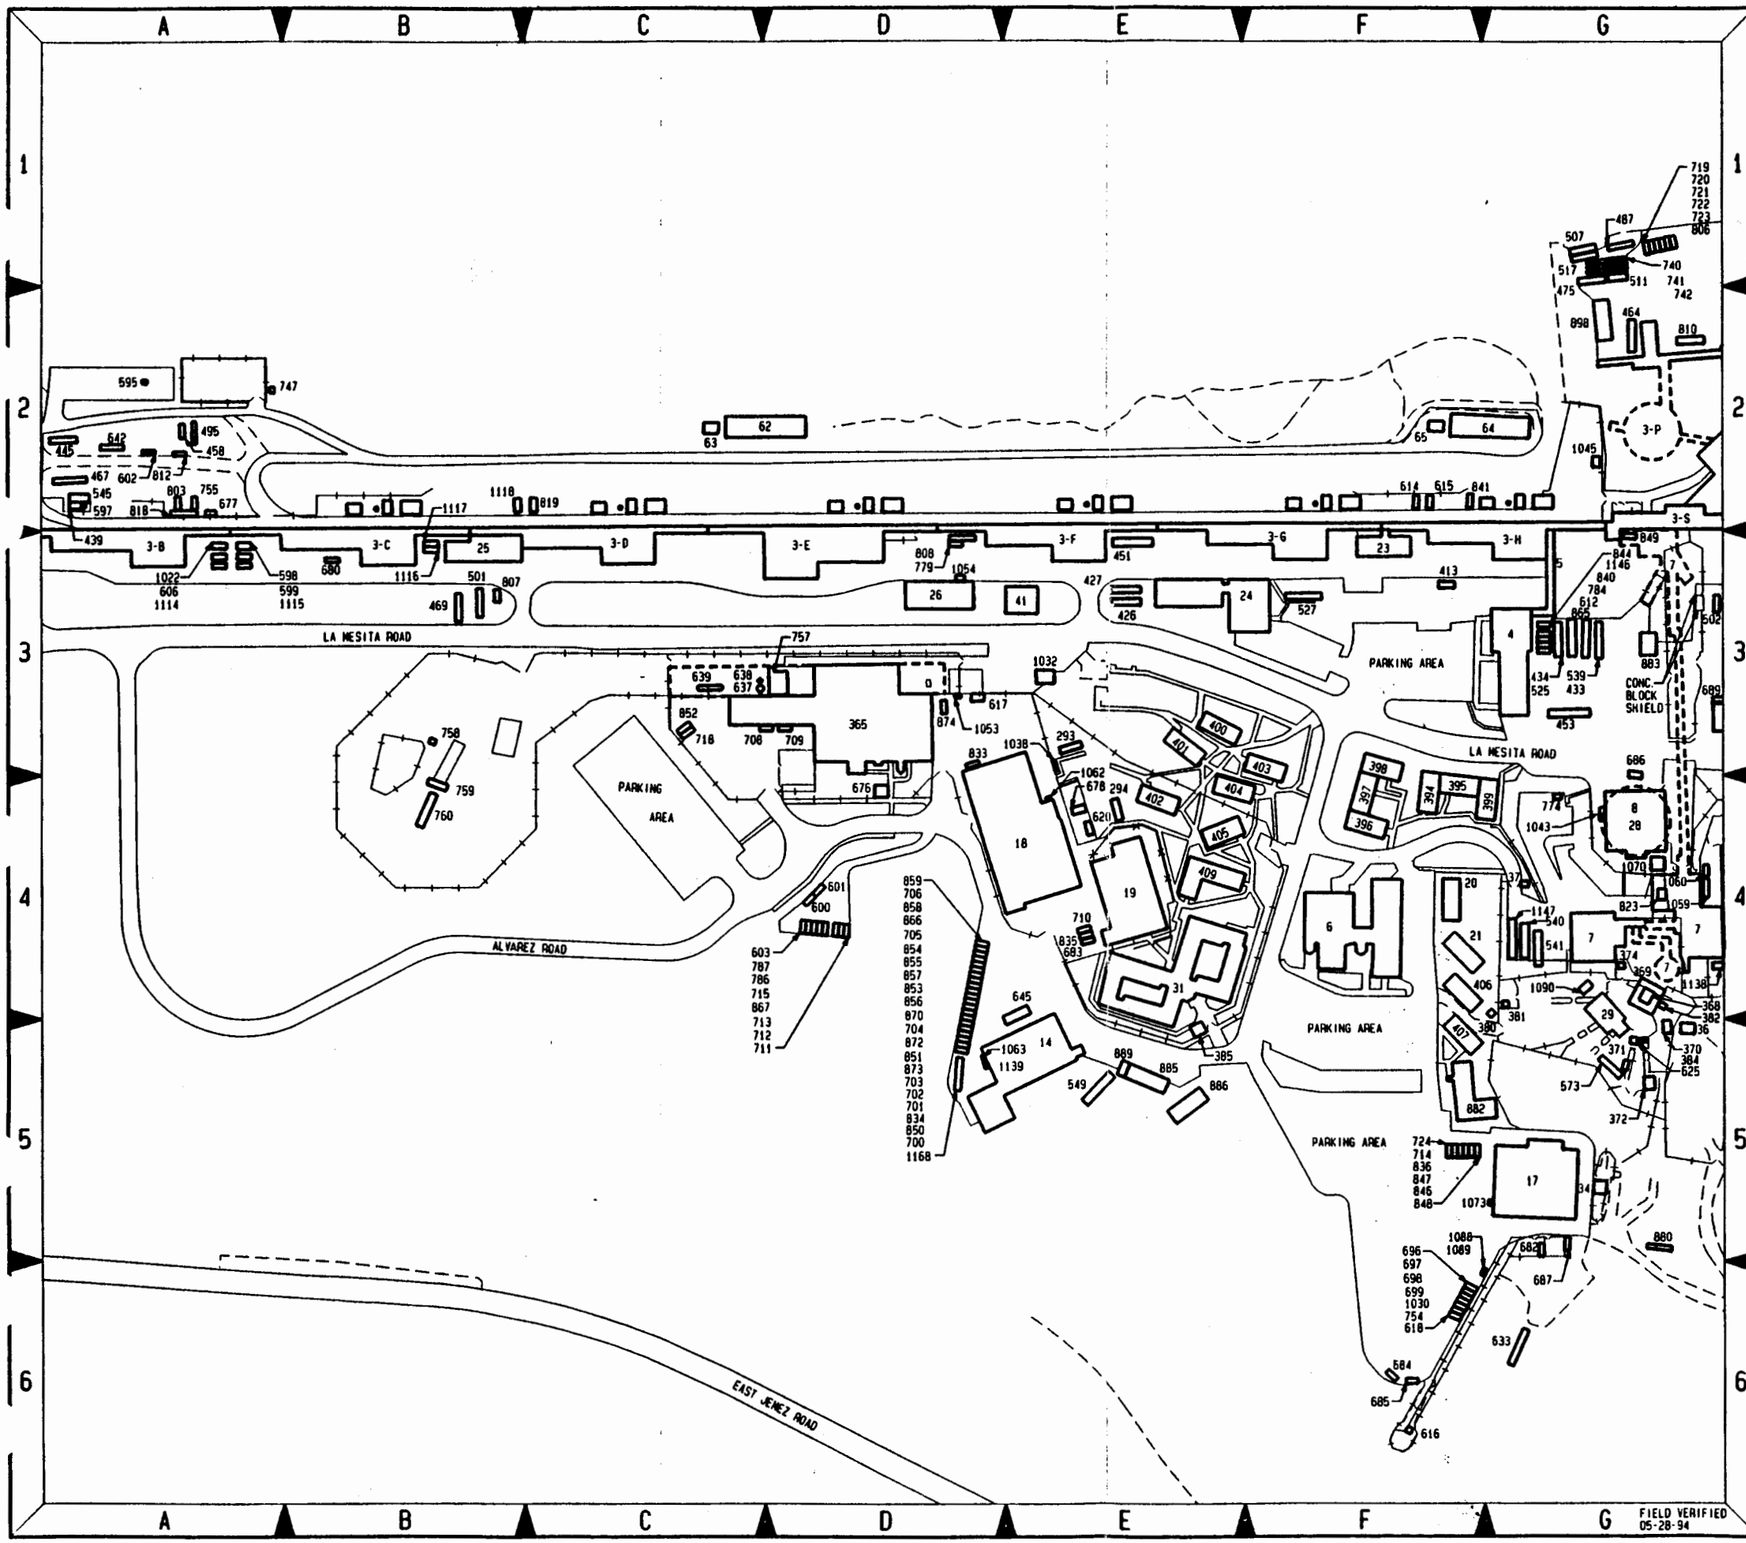

KEY MAP

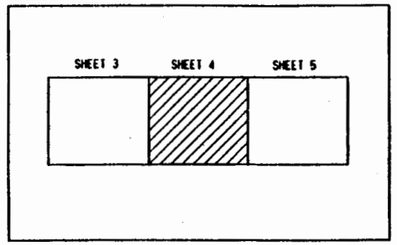

N

SCALE: 1:1200

100 0 100 200

FEET

NO	DATE	CLASS REV	REVISIONS	DWN	VER	CHKD	REL	SUB	REC	APP
2	06-30-94		REVISED TO NEW STANDARDS AND TO STATUS OF 05-28-94	JAC	JAC	JPN	HNS	JAF	BEC	RAP
1	01-31-94		REVISED TO STATUS OF 01-21-94	JPN	JPN	HNS	HNS	JAF	BEC	RAP

JOHNSON CONTROLS WORLD SERVICES INC.

AS-BUILT STRUCTURE LOCATION MAPS

TA-53

MESON PHYSICS FACILITY

DRAWN J. HONK
VERIFIED J. HONK
CHECKED H. SALAZAR
RELEASED H. SALAZAR
DATE 01-31-94

SUBMITTED JERRY FORTE
RECOMMENDED BRYAN CONE
APPROVED ROBERT PROMMEL

Los Alamos — Los Alamos National Laboratory, Los Alamos, New Mexico 87545

SHEET 4 OF 5

CLASSIFICATION U REVIEWER H. SALAZAR DATE 6-30-94

PROJECT ID 11952 | DRAWING NO AB40 | REV 2

JCI NO 91-020

STRUCTURE LOCATION MAPS

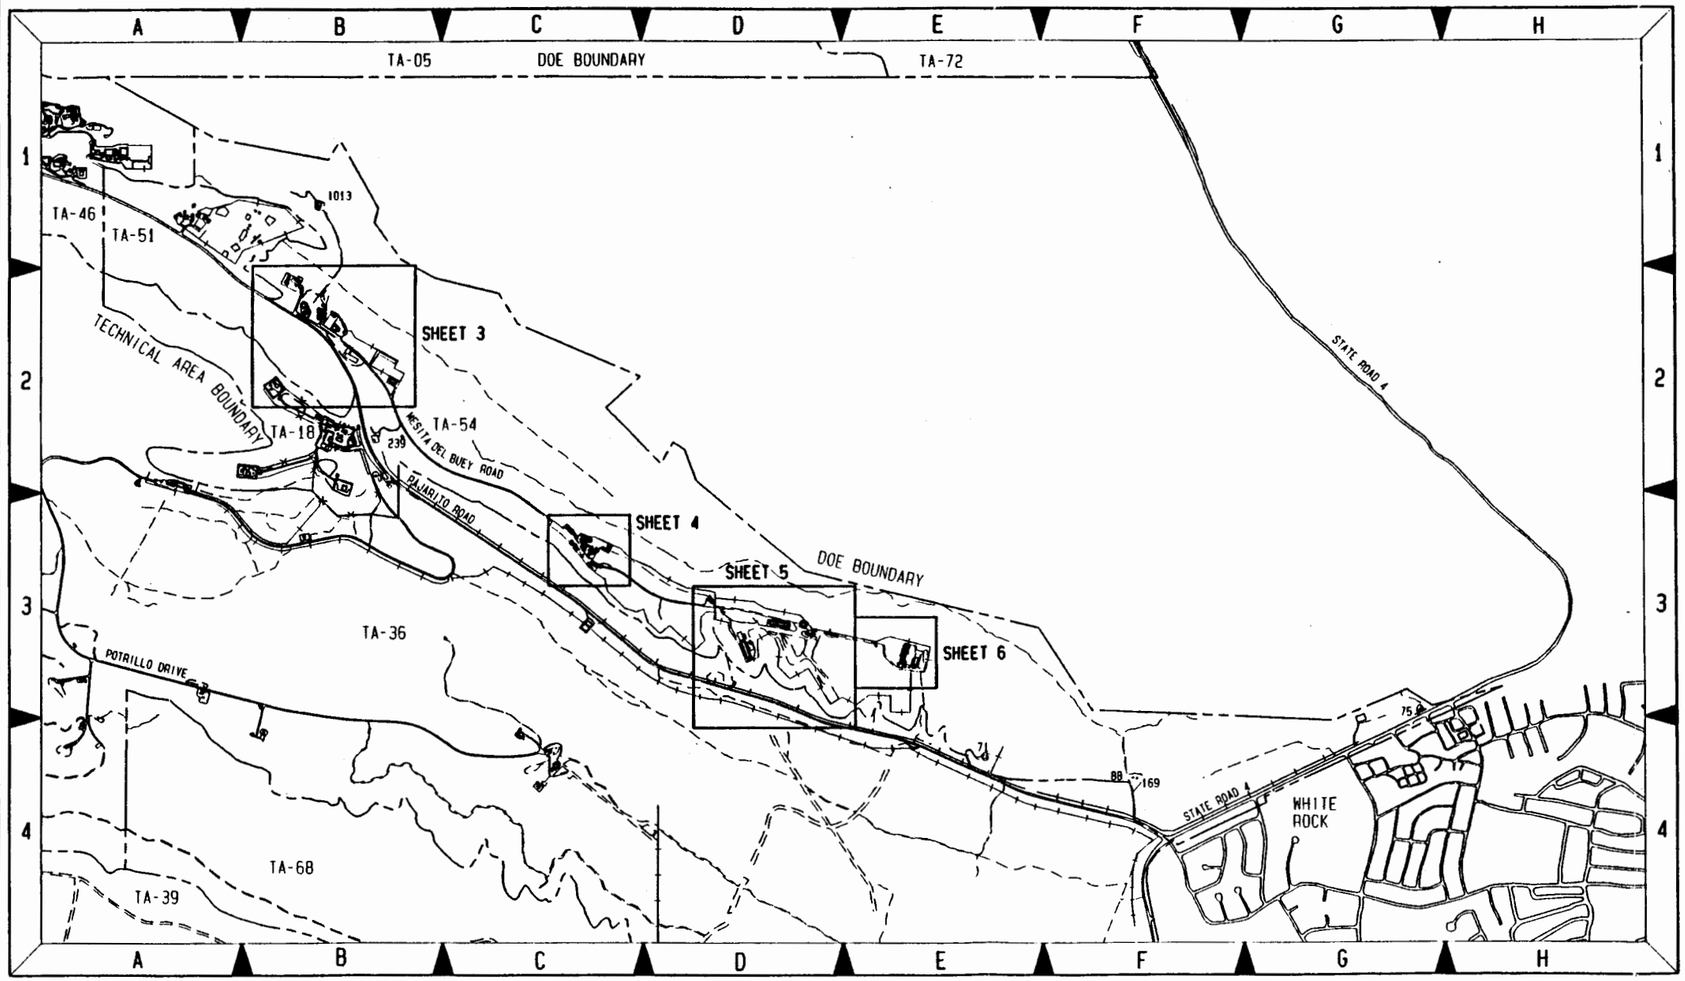

TA-54 KEY MAP

SCALE: 1:12000

1000 0 1000 2000

FEET

N

FIELD VERIFIED 08-25-94

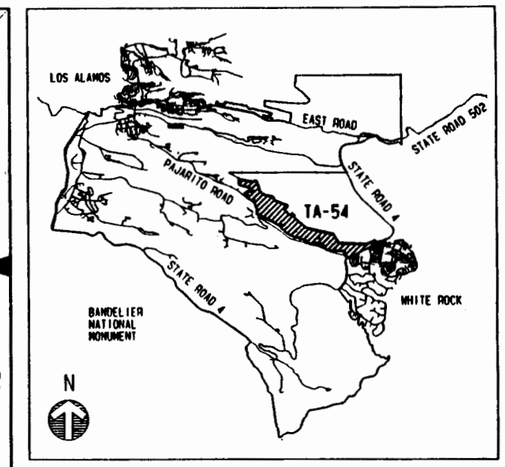

LOCATION PLAN

SCALE: NONE

NO	DATE	CLASS REV	REVISIONS	DWN	VER	CHKD	REL	SUB	REC	APP
2	09-08-94		REVISED TO STATUS OF 08-25-94	JAC	JAC	JPM	HMS	JAF	BEC	RAP
1	07-29-94		REVISED TO NEW STANDARDS AND TO STATUS OF 07-22-94	JAC	JAC	JPM	HMS	JAF	BEC	RAP

JOHNSON CONTROLS WORLD SERVICES INC.

AS-BUILT STRUCTURE LOCATION MAPS

TA-54

WASTE DISPOSAL SITE

DRAWN	J. NORK
VERIFIED	N. SENA / J. NORK
CHECKED	C. SANDOVAL
RELEASED	H. SALAZAR
DATE	09-23-93

SUBMITTED: JERRY FORTE — RECOMMENDED: BRYAN COMER — APPROVED: ROBERT PROMMEL

Los Alamos — Los Alamos National Laboratory, Los Alamos, New Mexico 87545

SHEET 1 OF 6

CLASSIFICATION: U — REVIEWER: H. SALAZAR — DATE: 9-16-94

PROJECT ID: 11952 — DRAWING NO: AB41 — REV: 2

JCI NO 91-020

STRUCTURE LOCATION INDEX

TA-NUMBER	STRUCTURE DESIGNATION	STRUCTURE NOMENCLATURE	STRUCTURE LOCATOR SHEET NO.	STRUCTURE LOCATOR MAP KEY
54-2	54-2	OPERATIONS BLDG.	5	F-3
54-8	54-8	CONTAMINATED DRUM STORAGE	5	F-3
54-10	54-10	METEOROLOGICAL TOWER	6	B-3
54-11	54-11	WASTE MGMT. CONTROL FACILITY	5	E-2
54-12	54-12	WOOD SHED	4	D-5
54-20	54-20	EQUIPMENT SHELTER	5	F-2
54-22	54-22	TRANSPORTABLE	4	C-3
54-23	54-23	TRAILER, STORAGE	5	F-2
54-25	54-25	METAL SHED	5	A-1
54-31	54-31	MORGAN SHED	4	D-3
54-32	54-32	CANOPY & PAD	4	D-4
54-33	54-33	TRU-WASTE DRUM FACILITY	5	E-2
54-34	54-34	TRANSPORTABLE	3	D-3
54-35	54-35	TREATMENT PAD	4	D-3
54-36	54-36	SAMPLING PAD	4	D-3
54-37	54-37	TRAILER, OFFICE	4	C-3
54-38	54-38	TRU-WASTE MDA/MDE	3	D-3
54-39	54-39	PCB WASTE STORAGE FACILITY	4	D-4
54-46	MD-46	MORGAN SHED	4	D-3
54-48	54-48	TENSION SUPPORT BLDG.	6	E-4
54-49	54-49	TENSION SUPPORT BLDG.	5	C-3
54-50	54-50	MORGAN SHED	4	D-2
54-51	54-51	TRAILER, OFFICE	4	D-3
54-52	54-52	MORGAN SHED	3	D-3
54-55	54-55	MORGAN SHED	4	D-3
54-58	54-58	TRANSPORTATION PAD	4	C-3
54-60	54-60	TRAILER, OFFICE	4	D-3
54-62	54-62	CANOPY	4	D-3
54-64	54-64	TRANSPORTABLE	4	C-3
54-68	54-68	TRANSPORTAINER	4	D-3
54-69	54-69	TRANSPORTAINER	4	D-3
54-70	54-70	TRANSPORTAINER	4	D-3
54-71	MD-71	WATER TANK	1	E-4
54-75	MD-75	WHITE ROCK PUMP STATION	1	G-3
54-76	MD-76	STORAGE SHED	6	B-3
54-77	54-77	TRANSPORTAINER	5	E-2
54-78	54-78	TRANSPORTAINER	5	E-2
54-79	54-79	EQUIPMENT SHELTER	5	F-2
54-82	54-82	DRUM CRUSHER SHED	4	D-3
54-83	54-83	PASSAGEWAY	4	C-3
54-84	54-84	PASSAGEWAY	4	C-3
54-88	54-88	METEOROLOGICAL TOWER	1	F-4
54-92	54-92	STORAGE SHED	5	F-2
54-93	54-93	RAD. MONITOR STATION	4	D-5
54-94	54-94	TRANSIT BLDG.	5	B-2
54-111	54-111	LOW LEVEL WASTE OPERATIONS OFF.	4	D-5
54-117	54-117	TRAILER, OFFICE	4	C-2
54-144	54-144	STORAGE SHED	5	C-3
54-145	54-145	STORAGE SHED	5	C-3
54-146	54-146	STORAGE SHED	5	C-3
54-153	54-153	TENSION SUPPORT BLDG.	5	D-2
54-154	54-154	MORGAN SHED	4	C-4
54-155	54-155	MORGAN SHED	4	C-4
54-156	54-156	MORGAN SHED	4	D-5
54-157	54-157	CONTROLLER BLDG.	4	D-5
54-161	54-161	MORGAN SHED	4	C-3
54-169	54-169	INSRUMENTATION SHED	1	F-4
54-174	54-174	MIXED WASTE STORAGE UNIT	5	C-3
54-175	54-175	MIXED WASTE STORAGE UNIT	5	C-3
54-176	54-176	MIXED WASTE STORAGE UNIT	5	C-3
54-177	54-177	CHEM. STORAGE SHED	5	C-3
54-185	54-185	TRAILER, OFFICE	4	C-2
54-186	54-186	TRANSPORTAINER	4	D-5
54-210	54-210	TRAILER, OFFICE	4	B-2
54-211	54-211	TRAILER, OFFICE	4	B-2
54-212	54-212	MIXED WASTE STORAGE UNIT	5	C-3
54-213	54-213	TRAILER, OFFICE	5	A-1
54-216	54-216	TENSION SUPPORT BLDG.	4	E-3
54-218	54-218	TRAILER, STORAGE	5	A-1
54-221	54-221	TRAILER, OFFICE	4	B-2
54-223	54-223	TRAILER, STORAGE	3	D-3
54-239	54-239	TRAILER, CORE DESCRIPTION	1	B-2
54-240	54-240	TRAILER, FIELD LAB	5	A-1
54-249	54-249	TRANSPORTAINER	5	A-1
54-282	54-282	TENSION SUPPORT DOME	3	G-5
54-284	54-284	TRAILER, OFFICE	6	F-5
54-1001	54-1001	BIO RESEARCH BLDG.	3	B-1
54-1002	54-1002	LIFT BLDG.	3	B-1
54-1003	54-1003	CONTROL BLDG.	3	B-1
54-1004	54-1004	STORAGE BLDG.	3	B-1
54-1005	54-1005	TRAILER, OFFICE	3	B-1
54-1006	54-1006	WATER TANK	3	C-2
54-1007	54-1007	PAJARITO BOOSTER #2	3	C-2
54-1008	54-1008	CHLORINATION STATION	3	C-2
54-1009	54-1009	CHEMISTRY LAB	3	C-3
54-1010	54-1010	EMERGENCY GENERATOR	3	D-2
54-1013	54-1013	PAJARITO WELL #4	1	B-1
54-1014	54-1014	TRAILER, OFFICE	3	C-2
54-1015	54-1015	TRAILER, OFFICE	3	C-3
54-1024	54-1024	CHEM PAC STORAGE	3	D-3
54-1025	54-1025	CHEM PAC STORAGE	3	D-3

NO	DATE	CLASS REV	REVISIONS	DWN	VER	CHKD	REL	SUB	REC	APP
2	09-08-94		REVISED TO STATUS OF 08-25-94	JAC	JAC	JPK	HMS	JAF	BEC	RAP
1	07-29-94		REVISED TO NEW STANDARDS AND TO STATUS OF 07-22-94	JAC	JAC	JPK	HMS	JAF	BEC	RAP

JOHNSON CONTROLS WORLD SERVICES INC.

AS-BUILT STRUCTURE LOCATION MAPS

TA-54

WASTE DISPOSAL SITE

DRAWN	J. HORK
VERIFIED	H. SENA, J. HORK
CHECKED	C. SANDOVAL
RELEASED	H. SALAZAR
DATE	09-23-93

SUBMITTED HMS for JERRY FORTE Jerry Forte
RECOMMENDED BRYAN COWER Bryan Cower
APPROVED ROBERT PROMMEL Bryan Cower

Los Alamos — Los Alamos National Laboratory, Los Alamos, New Mexico 87545

SHEET 2 OF 6

CLASSIFICATION U REVIEWER H. SALAZAR DATE 9-16-94

PROJECT ID 11952 | DRAWING NO AB41 | REV 2

JCI NO 31-020

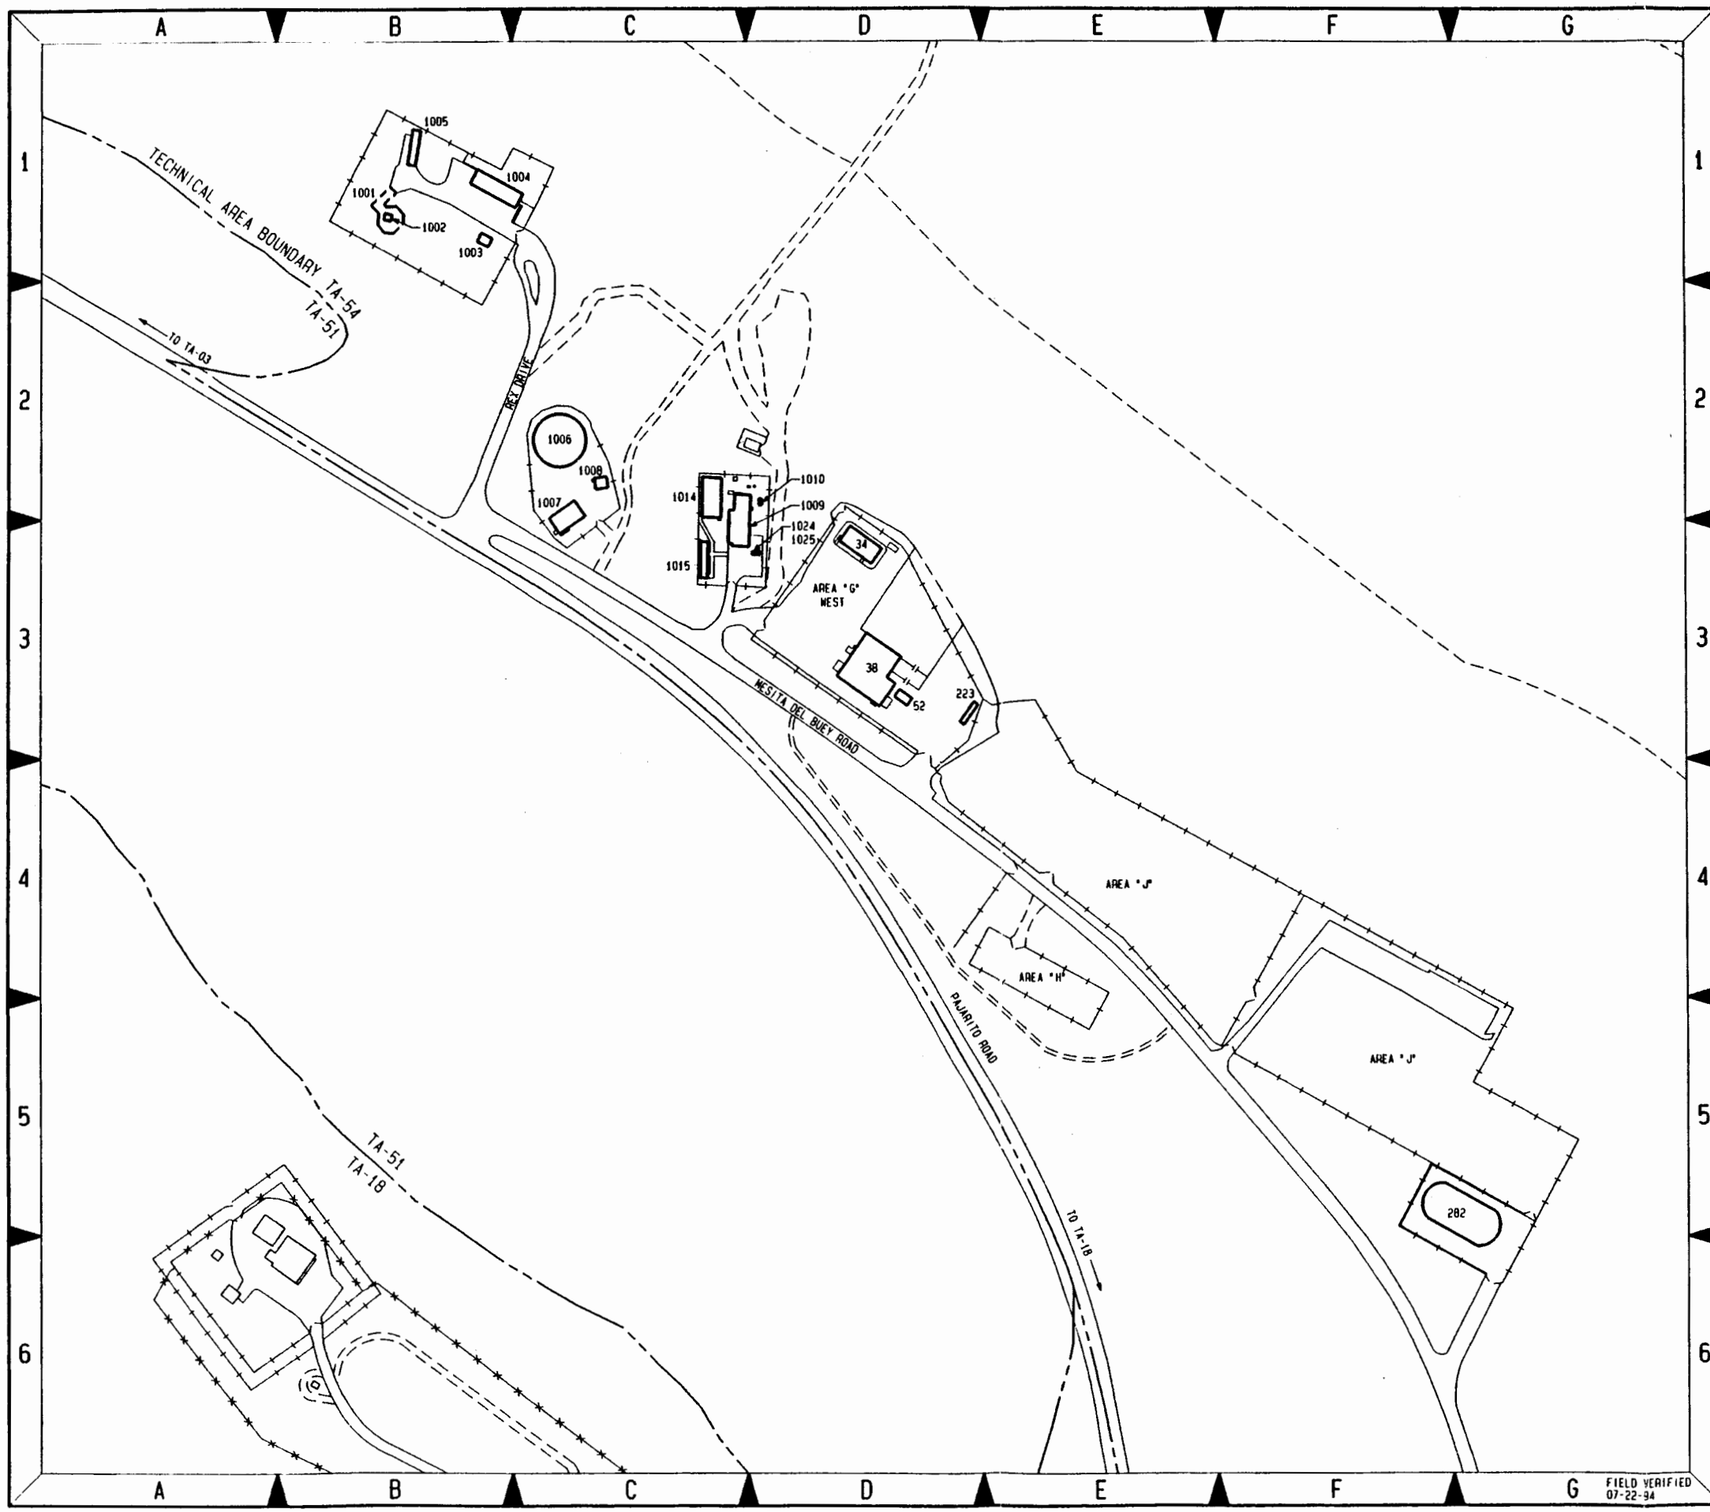

KEY MAP

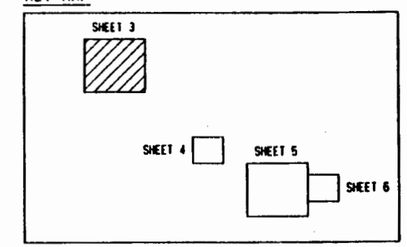

N

SCALE: 1:1200

100 0 100 200

FEET

NO	DATE	CLASS REV	REVISIONS	DWN	VER	CHKD	REL	SUB	REC	APP
1	07-29-94		REVISED TO NEW STANDARDS AND TO STATUS OF 07-22-94	JAC	JAC	JPM	HMS	JAF	BEC	RAP

JOHNSON CONTROLS WORLD SERVICES INC.

AS-BUILT STRUCTURE LOCATION MAPS

TA-54

WASTE DISPOSAL SITE

DRAWN	J. NORK
VERIFIED	N. SENA, J. NORK
CHECKED	C. SANDOVAL
RELEASED	H. SALAZAR
DATE	09-23-93

SUBMITTED JERRY FORTE

RECOMMENDED BRIAN COMER

APPROVED ROBERT PRONNEL

Los Alamos — Los Alamos National Laboratory, Los Alamos, New Mexico 87545

SHEET 3 OF 6

CLASSIFICATION U REVIEWER H. SALAZAR DATE 8-2-94

PROJECT ID 11952

DRAWING NO AB41

REV 1

JCI NO 91-020

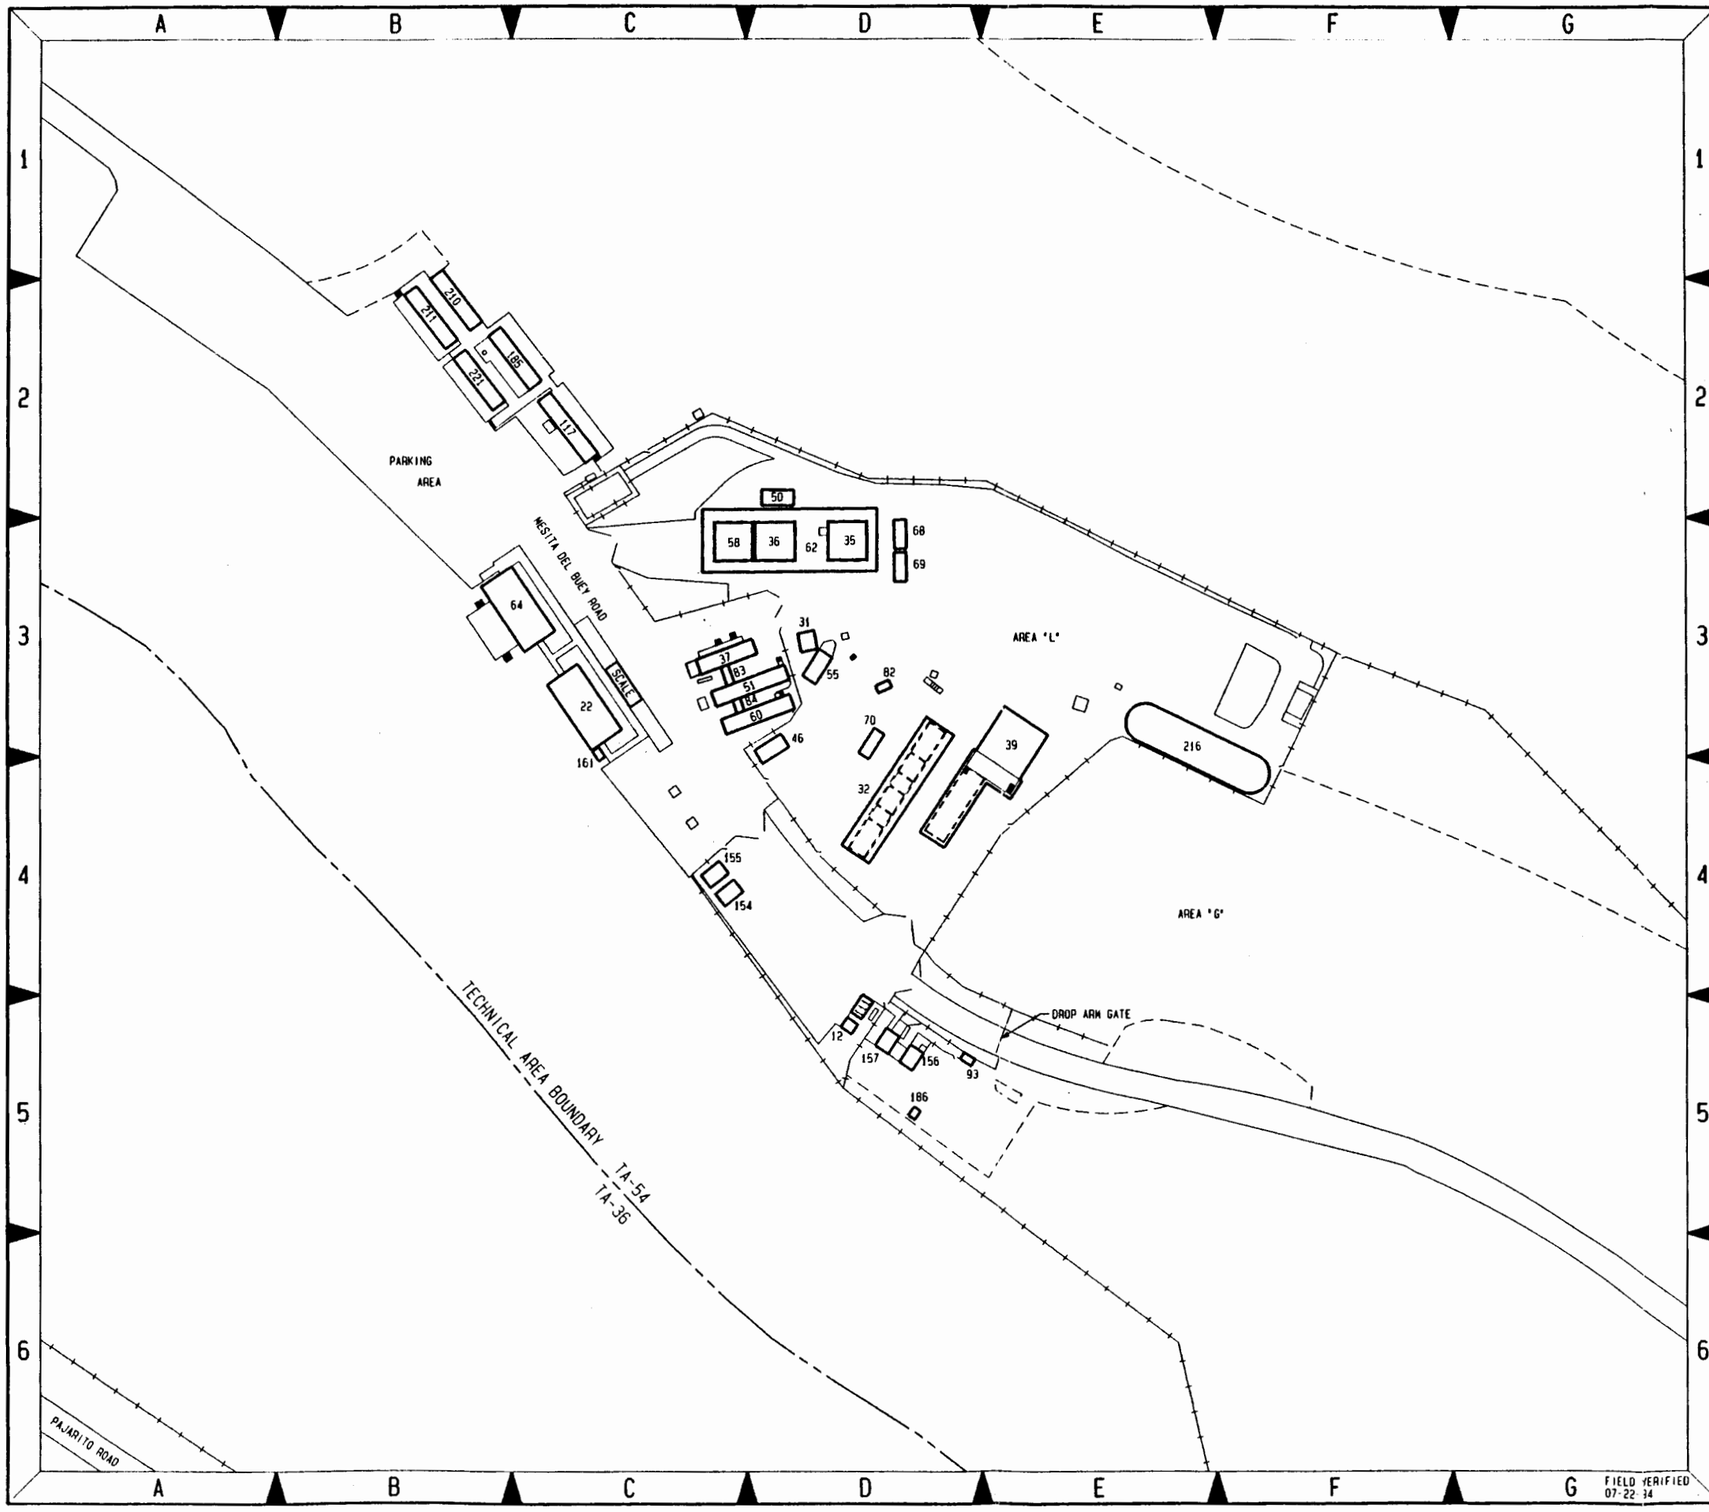

KEY MAP

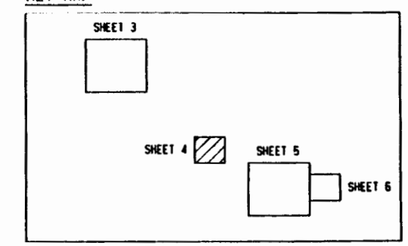

N

SCALE: 1:600

50 0 50 100

FEET

NO	DATE	CLASS REV	REVISIONS	DWN	VER	CHKD	REL	SUB	REC	APP
1	07-29-94		REVISED TO NEW STANDARDS AND TO STATUS OF 07-22-94	JAC	JAC	HNS	HNS	JAF	BEC	RAP

JOHNSON CONTROLS WORLD SERVICES INC.

AS-BUILT STRUCTURE LOCATION MAPS

TA-54

WASTE DISPOSAL SITE

DRAWN	J. HORK
VERIFIED	H. SENA, J. HORK
CHECKED	C. SANDOVAL
RELEASED	H. SALAZAR
DATE	09-23-93

SUBMITTED JERRY FORTE — RECOMMENDED BRYAN COHEN — APPROVED ROBERT PROMMEL

Los Alamos — Los Alamos National Laboratory, Los Alamos, New Mexico 87545

SHEET 4 OF 6

CLASSIFICATION U — REVIEWER H. SALAZAR — DATE 8-2-94

PROJECT ID	DRAWING NO	REV
11952	AB41	1

020-16 NO. JAC

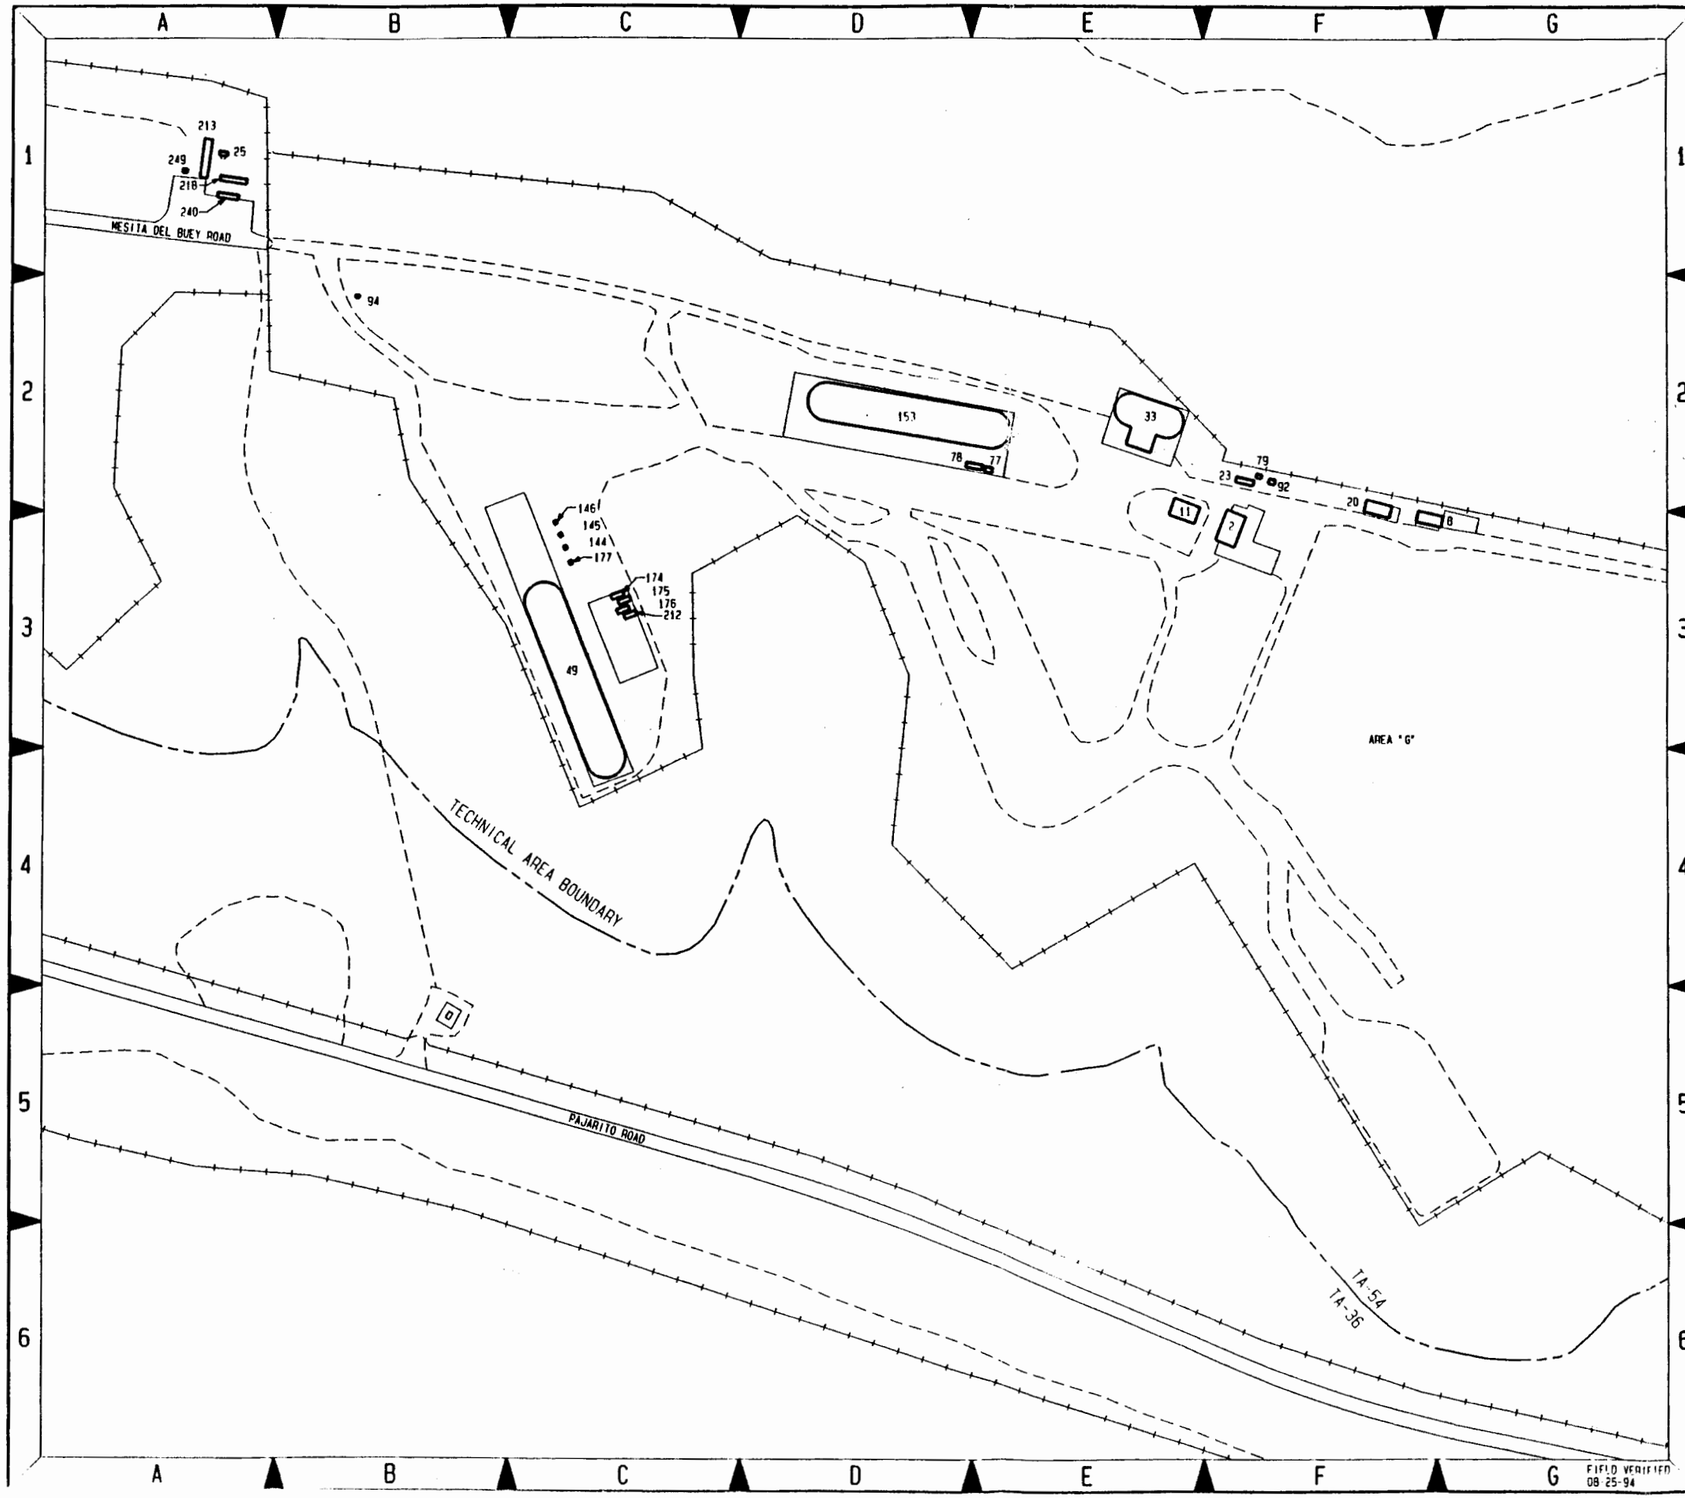

KEY MAP

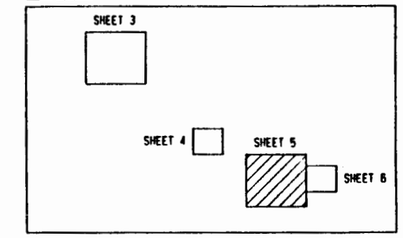

N

SCALE: 1:1200

100 0 100 200

FEET

NO	DATE	CLASS REV	REVISIONS	DWN	VER	CHKD	REL	SUB	REC	APP
2	09-08-94		REVISED TO STATUS OF 08-25-94	JAC	JAC	JPM	HMS	JAF	BEC	RAP
1	07-29-94		REVISED TO NFM STANDARDS AND TO STATUS OF 07-22-94	JAC	JAC	JPM	HMS	JAF	BEC	RAP

JOHNSON CONTROLS WORLD SERVICES INC.

AS-BUILT STRUCTURE LOCATION MAPS

TA-54

WASTE DISPOSAL SITE

DRAWN	J. MORK
VERIFIED	H. SENA, J. MORK
CHECKED	C. SANDOVAL
RELEASED	H. SALAZAR
DATE	09-23-93

SUBMITTED Jerry Forte — RECOMMENDED Bryan Comer — APPROVED Robert Prommel

Los Alamos — Los Alamos National Laboratory, Los Alamos, New Mexico 87545

SHEET 5 OF 6

CLASSIFICATION U — REVIEWER H. SALAZAR — DATE 9-16-94

PROJECT ID 11952 — DRAWING NO AB41 — REV 2

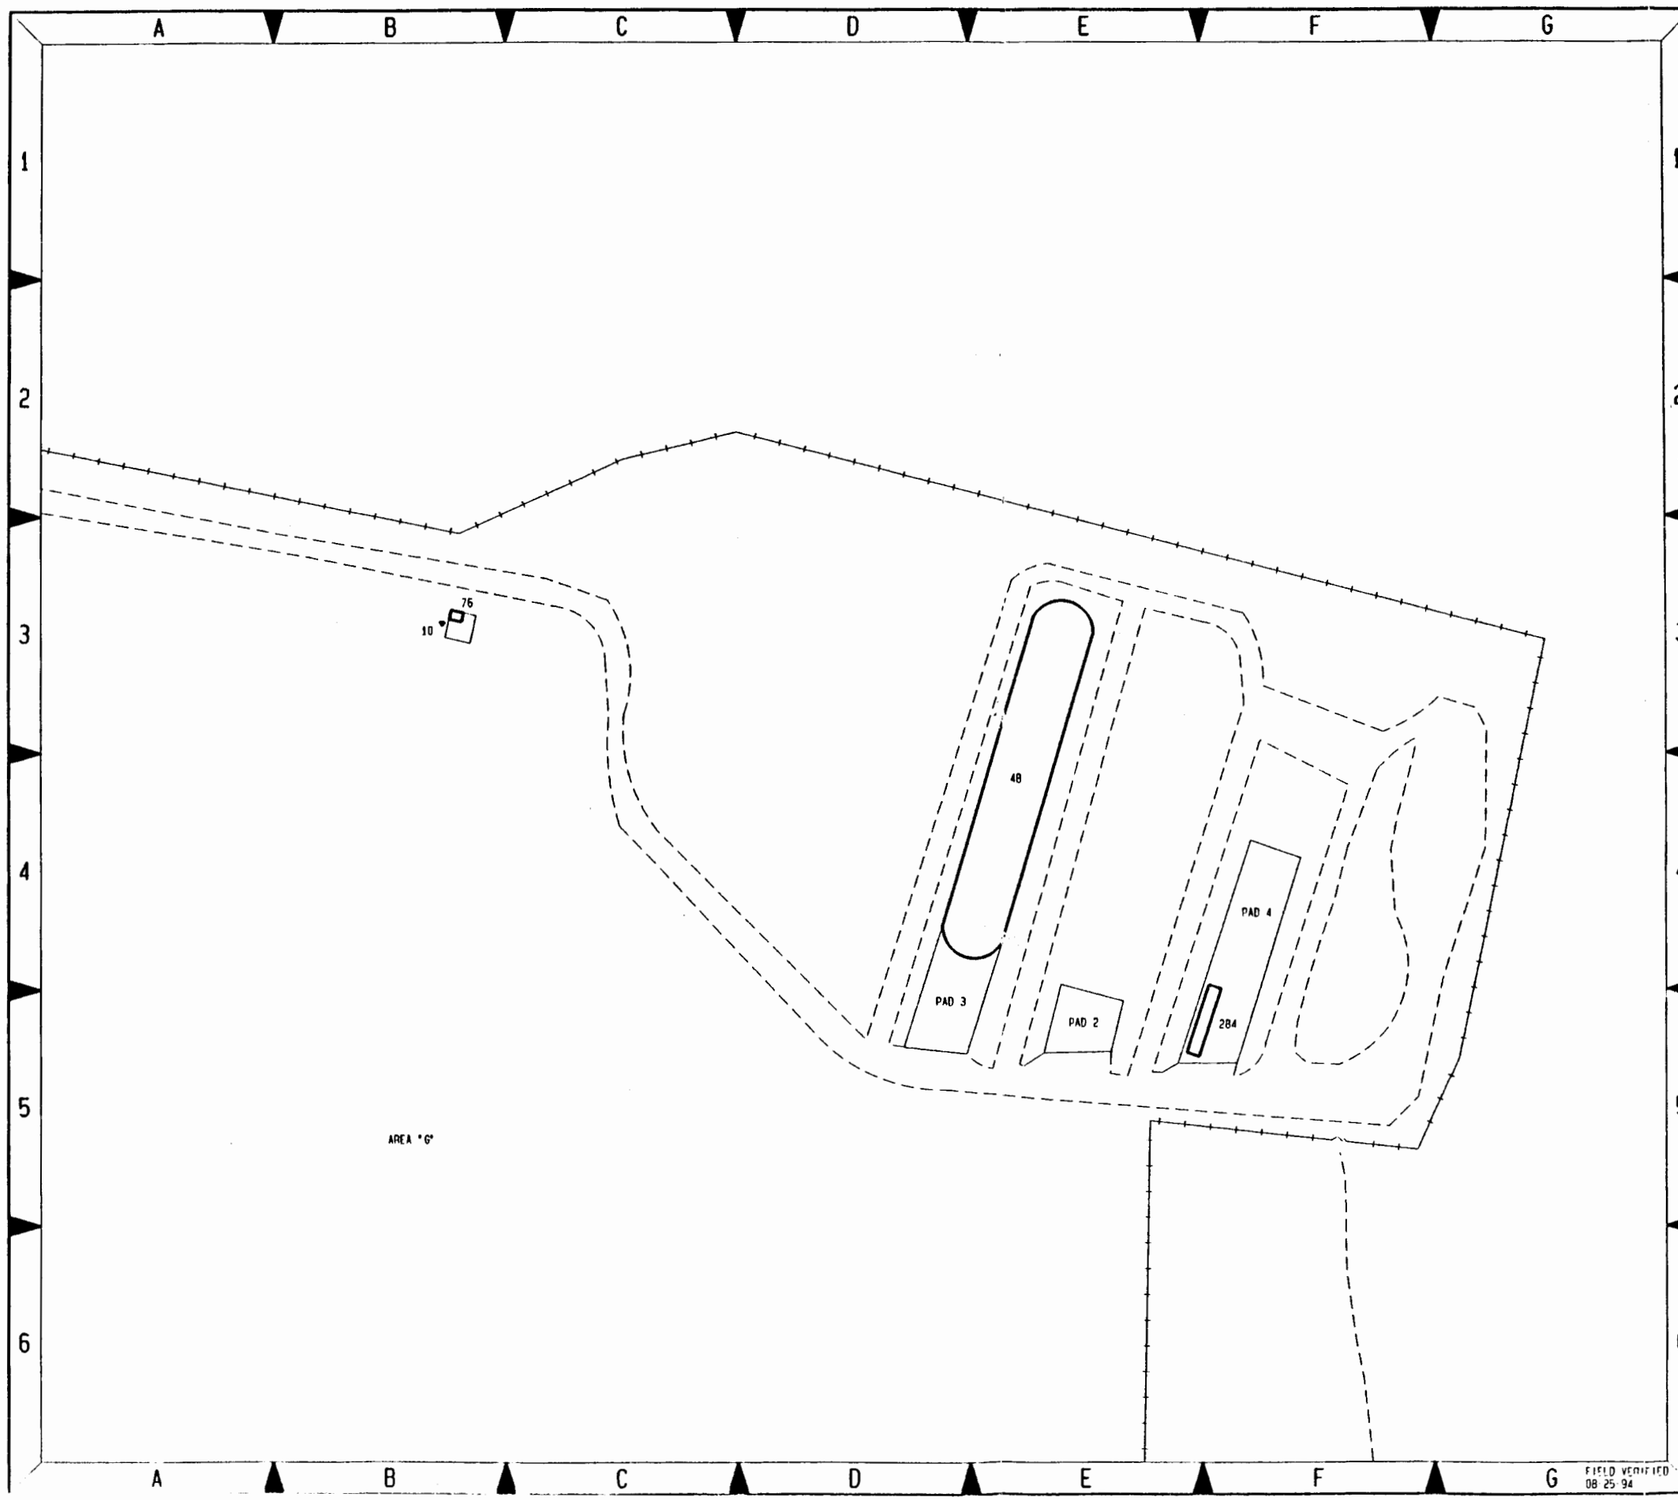

KEY MAP

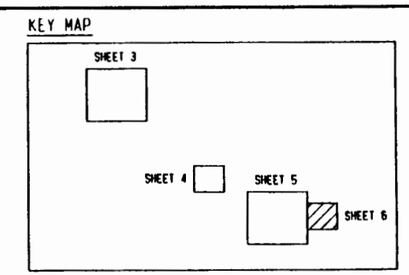

N

SCALE: 1:600

50 0 50 100

FEET

NO	DATE	CLASS REV	REVISIONS	DWN	VER	CHKD	REL	SUB	REC	APP
2	09-08-94		REVISED TO STATUS OF 08-25-94	JAC	JAC	JPM	HMS	JAF	BEC	RAP
1	07-29-94		REVISED TO NEW STANDARDS AND TO STATUS OF 07-22-94	JAC	JAC	JPM	HMS	JAF	BEC	RAP

JOHNSON CONTROLS WORLD SERVICES INC.

AS-BUILT STRUCTURE LOCATION MAPS

TA-54

WASTE DISPOSAL SITE

DRAWN	J. MORE
VERIFIED	H. SENA, J. MORE
CHECKED	C. SANDOVAL
RELEASED	H. SALAZAR
DATE	09-23-93

SUBMITTED JERRY FORTE — RECOMMENDED BRIAN COMER — APPROVED ROBERT PROMMEL

Los Alamos — Los Alamos National Laboratory, Los Alamos, New Mexico 87545

SHEET 6 OF 6

CLASSIFICATION U — REVIEWER H. SALAZAR — DATE 9-16-94

PROJECT ID	DRAWING NO	REV
11952	AB41	2

STRUCTURE LOCATION INDEX

TA-NUMBER	STRUCTURE DESIGNATION	STRUCTURE NOMENCLATURE	STRUCTURE LOCATOR SHEET NO.	STRUCTURE LOCATOR MAP KEY
55-1	PF-1	ADMINISTRATION BUILDING	3	E-4
55-2	PF-2	SUPPORT OFFICE BUILDING	3	D-4
55-3	PF-3	SUPPORT BUILDING	3	D-3
55-4	PF-4	PLUTONIUM BUILDING	3	D-3
55-5	PF-5	WAREHOUSE	3	E-3
55-6	PF-6	UTILITY BUILDING	3	E-3
55-7	PF-7	CALCIUM BUILDING	3	D-2
55-8	PF-8	GENERATOR BUILDING	3	D-2
55-9	PF-9	GUARD STATION	3	E-4
55-10	PF-10	PUMP HOUSE	3	E-3
55-11	PF-11	PUMP HOUSE	3	C-3
55-12	55-12	WATER TANK	3	E-3
55-13	55-13	WATER TANK	3	E-3
55-14	55-14	WATER TANK	3	C-3
55-18	PF-18	CANOPY	3	D-3
55-20	PF-20	OFFICE BUILDING	3	E-3
55-21	55-21	UTILIDOR	3	E-3
55-22	PF-22	VEHICLE MONITORING STATION	3	E-4
55-28	PF-28	NUCLEAR MATERIALS BUILDING	3	F-3
55-39	55-39	EDUCATIONAL SUPPORT CENTER	3	E-3
55-41	PF-41	NUCLEAR MATERIALS STORAGE	3	C-3
55-42	PF-42	PROCESS SUPPORT BUILDING	3	D-2
55-43	PF-43	ASSESSMENT BUILDING	3	D-2
55-47	PF-47	GENERATOR BUILDING	3	C-2
55-48	PF-48	GUARD TOWER	3	B-3
55-53	55-53	CEMENT STORAGE SILO	3	C-3
55-54	55-54	RADIO TOWER	3	C-3
55-55	55-55	STORAGE SHED	3	C-3
55-100	55-100	TANK, NITROGEN	3	D-3
55-101	55-101	TANK, ARGON	3	D-3
55-107	PF-107	TRAILER, OFFICE	3	E-3
55-110	55-110	TRAILER, OFFICE	3	E-5
55-114	55-114	OFFICE BUILDING	3	E-3
55-124	55-124	TRAILER, OFFICE	3	E-5
55-125	PF-125	GUARD TOWER	3	F-3
55-127	55-127	TANK, NITRIC ACID	3	D-3
55-134	55-134	STORAGE SHED	3	C-3
55-135	55-135	TRAILER, OFFICE	3	E-5
55-136	55-136	TRAILER, OFFICE	3	E-5
55-137	55-137	TRAILER, OFFICE	3	E-5
55-138	55-138	TRAILER, OFFICE	3	E-5
55-139	55-139	TRAILER, OFFICE	3	E-5
55-142	55-142	ASSESSMENT BUILDING	3	C-3
55-144	55-144	TRAILER, OFFICE	3	E-5
55-145	PF-145	TRAILER, OFFICE	3	E-5
55-147	55-147	COLD FOOD STORAGE BUILDING	3	E-3
55-148	55-148	TUNNEL ACCESS	3	C-3
55-150	55-150	TRANSPORTAINER	3	C-2
55-151	55-151	TRANSPORTAINER	3	C-2
55-152	55-152	TRANSPORTAINER	3	E-5
55-154	55-154	TRANSPORTAINER	3	C-2
55-155	55-155	TRANSPORTAINER	3	D-2
55-157	55-157	TRANSPORTAINER	3	E-3
55-158	55-158	TRANSPORTAINER	3	E-3
55-162	55-162	GUARD TOWER	3	C-4
55-170	55-170	SHED	3	C-2
55-172	PF-172	TRANSPORTAINER	3	C-2
55-177	55-177	TRAILER, OFFICE	3	E-6
55-185	55-185	DRUM STORAGE BUILDING	3	C-3
55-187	55-187	TRANSPORTAINER	3	E-5
55-188	55-188	TRANSPORTAINER	3	C-2
55-189	55-189	SHED	3	C-2
55-190	55-190	TRANSPORTAINER	3	E-3
55-191	55-191	TRANSPORTAINER	3	E-3
55-192	55-192	TRANSPORTAINER	3	D-3
55-194	55-194	TRANSPORTAINER	3	C-2
55-215	55-215	TRANSPORTAINER	3	C-3
55-218	55-218	SHED	3	C-2
55-223	55-223	EQUIPMENT SHELTER	3	D-2
55-243	55-243	TEMPORARY GUARD STATION	3	C-3
55-263	55-263	SAN. SEWER MONITORING STATION	3	E-3
55-265	55-265	TEMP. GAURD STATION	3	C-3
55-266	55-266	VACUUM PUMP SHELTER	3	D-2
55-267	55-267	DIESEL FUEL TANK	3	F-3

NO	DATE	CLASS REV	REVISIONS	DWN	VER	CHKD	REL	SUB	REC	APP
1	06-15-94		REVISED PER NEW STANDARDS	DWB	JPM	HMS	HMS	JAF	BEC	RAP

JOHNSON CONTROLS WORLD SERVICES INC.

AS-BUILT STRUCTURE LOCATION MAPS

TA-55

PLUTONIUM FACILITY SITE

DRAWN: J. WORK
VERIFIED: J. WORK
CHECKED: H. SALAZAR
RELEASED: H. SALAZAR
DATE: 03-29-93

SUBMITTED: JERRY FORTE
RECOMMENDED: BRYAN COWER — RAP for BEC
APPROVED: HERBERT PROMMEL

Los Alamos — Los Alamos National Laboratory, Los Alamos, New Mexico 87545

SHEET 2 OF 3

CLASSIFICATION U REVIEWER H. SALAZAR DATE 6-15-94

PROJECT ID: 11952
DRAWING NO: AB42
REV: 1

J.C. NO 93-026

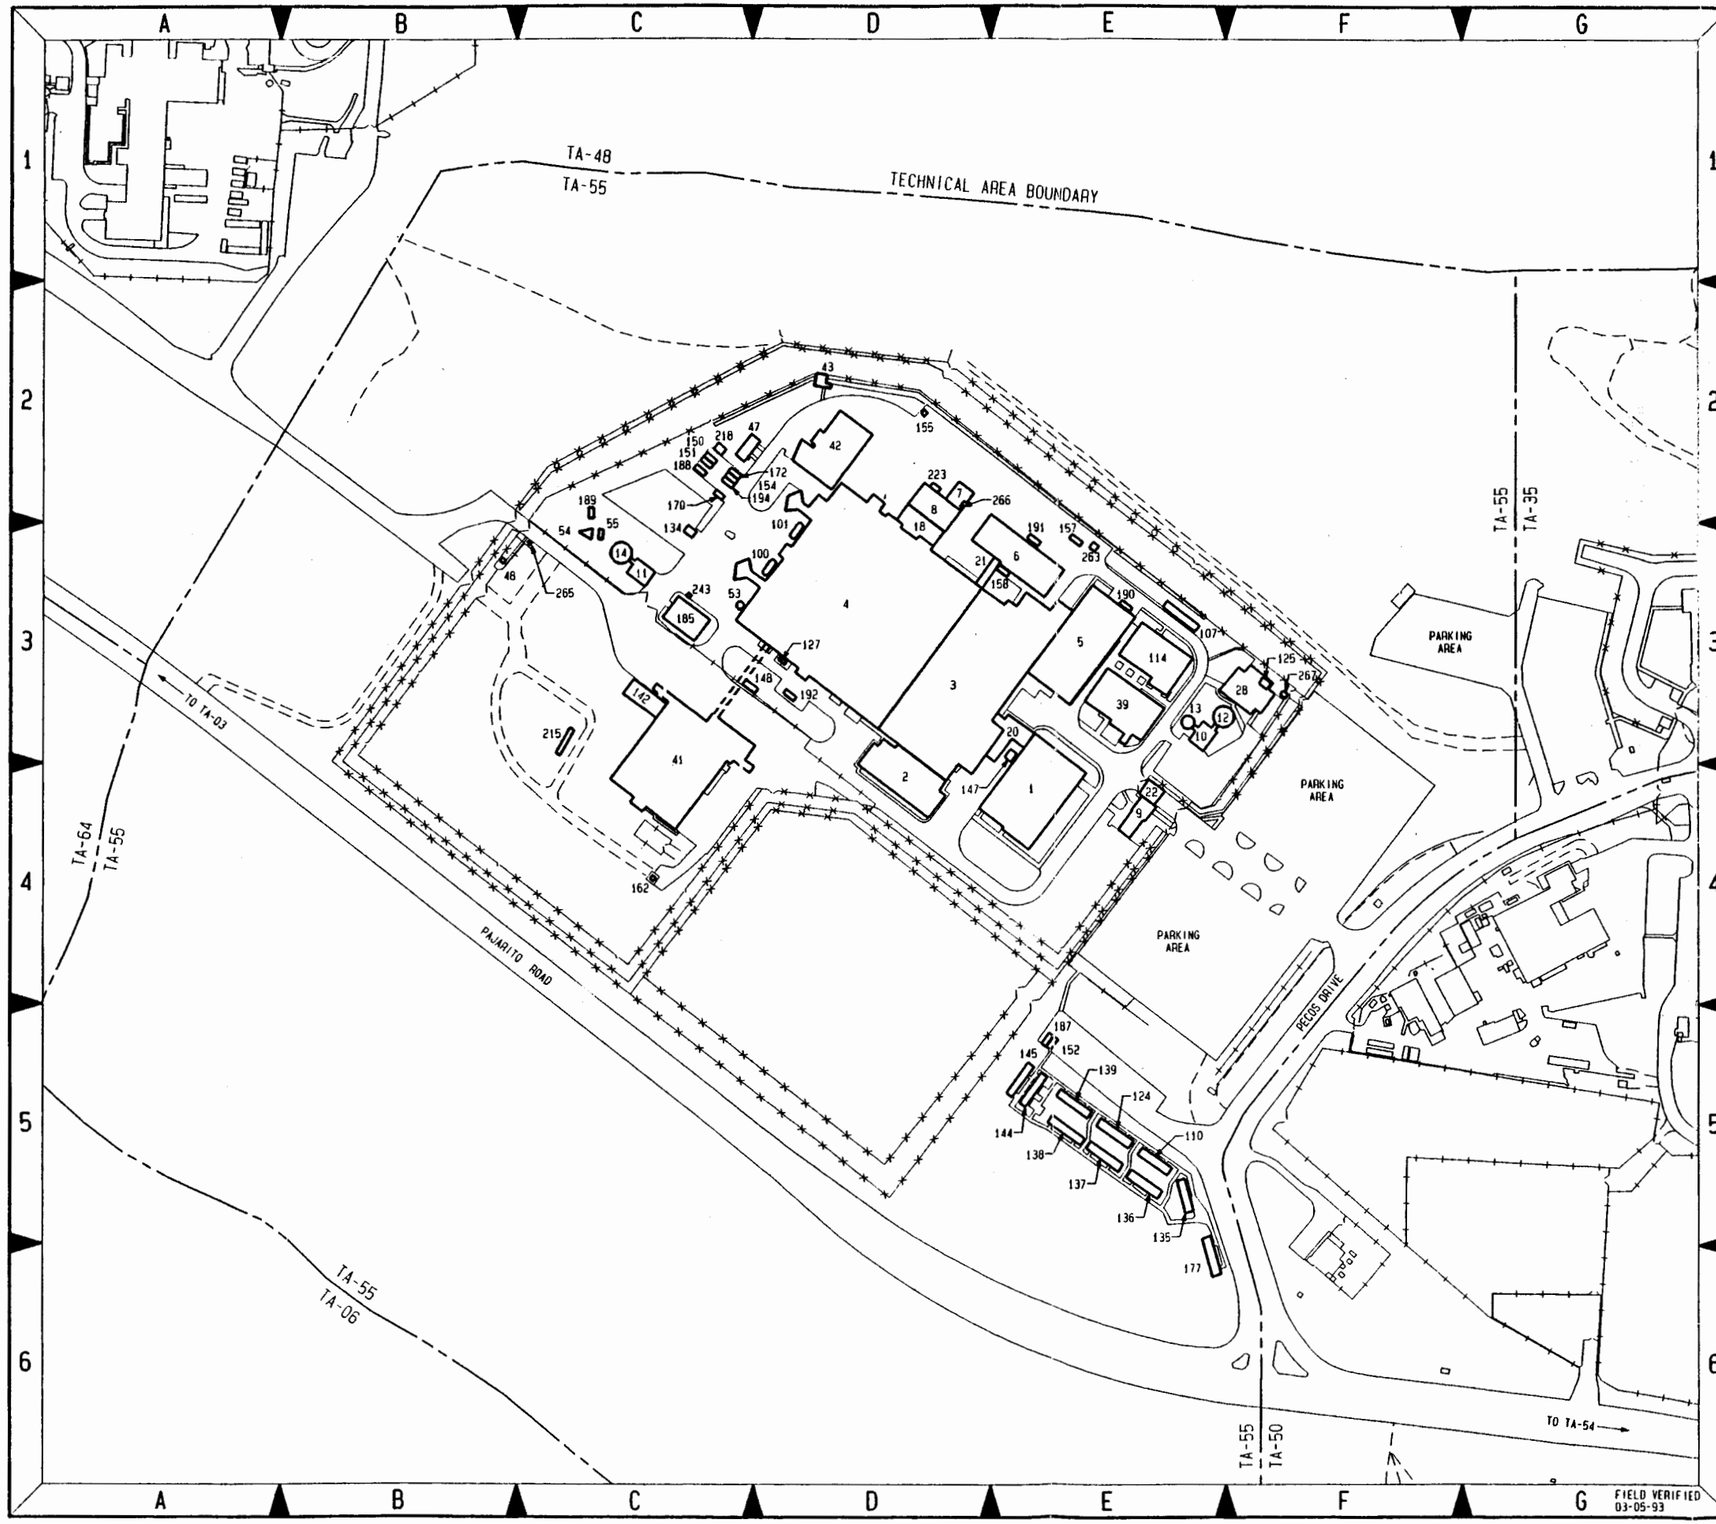

FIELD VERIFIED 03-05-93

N

SCALE: 1:1200

100 0 100 200

FEET

NO	DATE	CLASS REV	REVISIONS	DWN	VER	CHKD	REL	SUB	REC	APP
1	06-15-94		REVISED PER NEW STANDARDS	DMB	JPM	HMS	HMS	JAF	BEC	RAP

JOHNSON CONTROLS WORLD SERVICES INC.

AS-BUILT STRUCTURE LOCATION MAPS

TA-55

PLUTONIUM FACILITY SITE

DRAWN	J. NORK
VERIFIED	J. NORK
CHECKED	H. SALAZAR
RELEASED	H. SALAZAR
DATE	03-29-93

SUBMITTED JERRY FORTE — RECOMMENDED BRIAN COMER RAP for BEC — APPROVED ROBERT PROMMEL

Los Alamos — Los Alamos National Laboratory, Los Alamos, New Mexico 87545

SHEET 3 OF 3

CLASSIFICATION — REVIEWER H. SALAZAR — DATE

PROJECT ID	DRAWING NO	REV
11952	AB42	1

JCI NO 91-020

TA-57

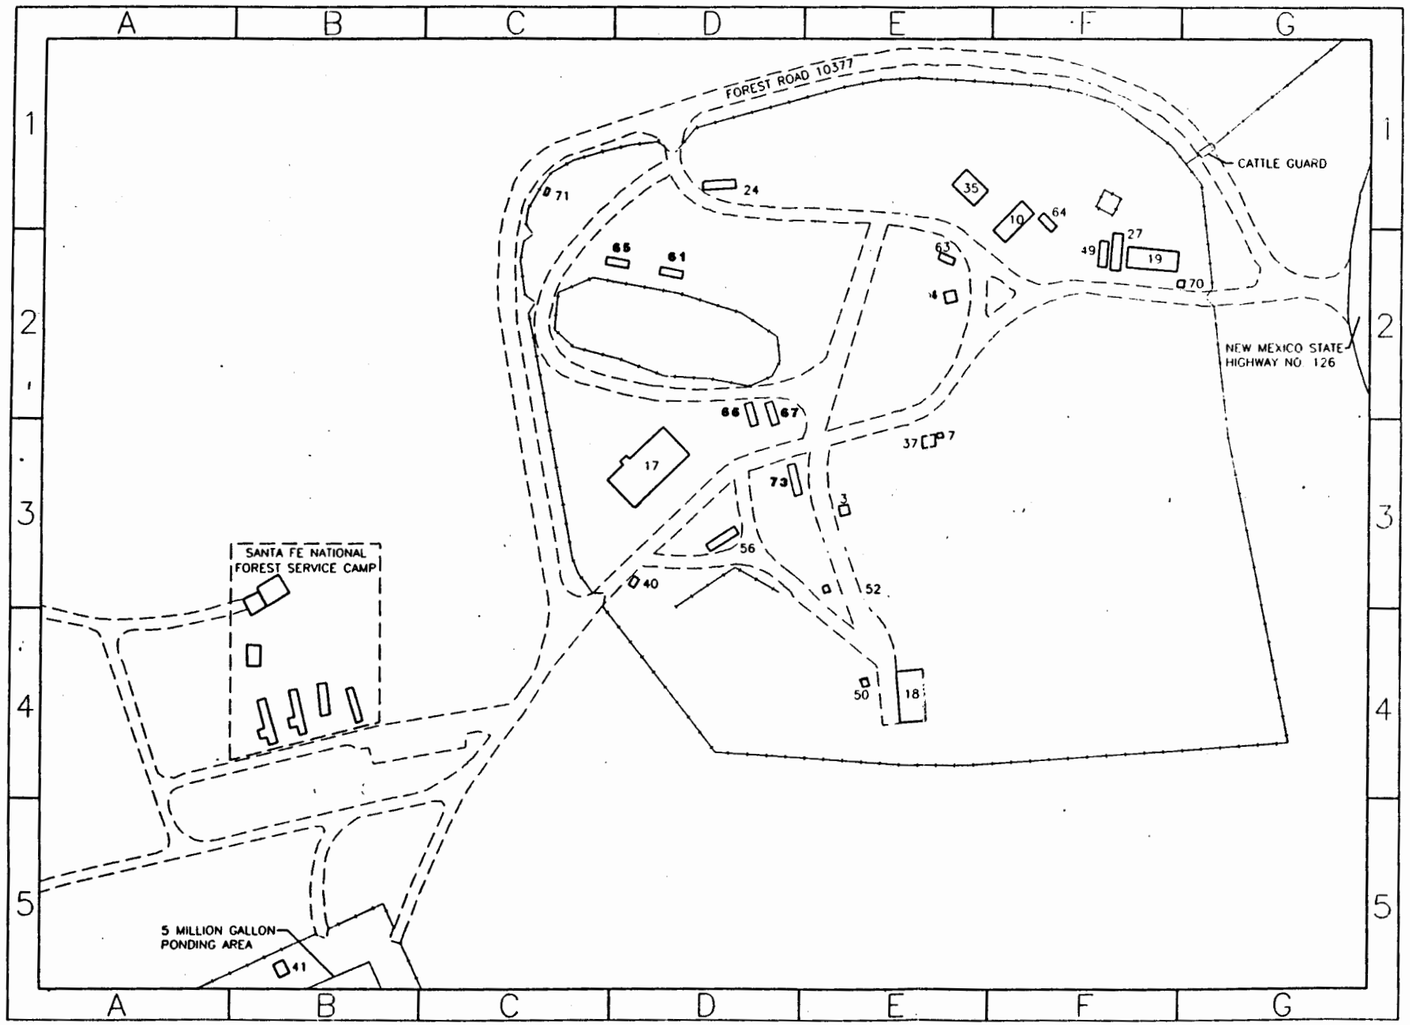

SCALE 1: 900

75 0 75 150 FEET

N

STRUCTURE NUMBER INDEX

STRUCTURE TA-NUMBER	STRUCTURE DESIGNATION	STRUCTURE NOMENCLATURE	STRUCTURE LOCATOR SHEET NO.	STRUCTURE LOCATOR MAP KEY
57-3	FHS-3	WELL HEAD	1	E-3
57-4	57-4	WELL HEAD	1	E-2
57-7	FHS-7	PUMP HOUSE	1	E-3
57-10	FHS-10	HEAT EXCHANGER	1	F-1
57-17	57-17	OPERATIONS BUILDING	1	D-3
57-18	57-18	WAREHOUSE	1	E-4
57-19	FHS-19	CDA COMPUTER TRANSPORTABLE	1	F-2
57-24	FHS-24	TRAILER, HYDRO	1	D-1
57-27	FHS-27	TRAILER, PARTS	1	F-2
57-35	FHS-35	CONTROL BUILDING	1	E-1
57-37	FHS-37	WATER WELL #1	1	E-3
57-40	FHS-40	WATER WELL #2	1	D-3
57-41	FHS-41	PUMPHOUSE	1	B-5
57-49	57-49	TRAILER, OFFICE	1	F-2
57-50	57-50	OXYGEN SHED	1	E-4
57-52	57-52	ACETYLENE SHED	1	E-3
57-56	57-56	OIL STORAGE SHED	1	D-3
57-57	57-57	STORAGE SHED	1	D-3
57-59	57-59	STORAGE SHED	1	D-3
57-60	57-60	DRUM STORAGE SHED	1	D-2
57-61	57-61	TRAILER, CHEMICAL	1	D-2
57-62	57-62	TRANSPORTAINER	1	E-2
57-63	57-63	TRAILER, CABLEHEAD	1	E-2
57-64	57-64	TRANSPORTAINER	1	F-1
57-65	57-65	TRAILER, DRILL	1	D-2
57-66	57-66	TRANSPORTAINER	1	D-2
57-67	57-67	TRANSPORTAINER	1	D-2
57-70	57-70	GUARD HOUSE	1	G-2
57-71	57-71	STORAGE SHED	1	C-1
57-73	57-73	TRAILER, STORAGE	1	D-3

LATEST DISTRIBUTION
31AUG94
EMERGENCY RESPONSE MAP
UPDATED DRAWING

NO.	DATE	CLASS REV.	REVISIONS	DWN	DES	CKD	REL	SUB	REC	APP

FACILITIES ENGINEERING DIVISION

STRUCTURE LOCATION MAP
TA-57
FENTON HILL SITE

DRAWN	J. MORK
DESIGN	
CHECKED	B. COMER
RELEASED	B. COMER
DATE	02-27-91

BLDG.
SUBMITTED
RECOMMENDED
APPROVED

LOS ALAMOS — LOS ALAMOS NATIONAL LABORATORY, LOS ALAMOS, NEW MEXICO 87545

SHEET 1 OF 1

CLASSIFICATION
REVIEWER
DATE

LAB JOB NO.
DRAWING NO. ENG-R 5133
REV. 28

AUTOCIS

TA-58

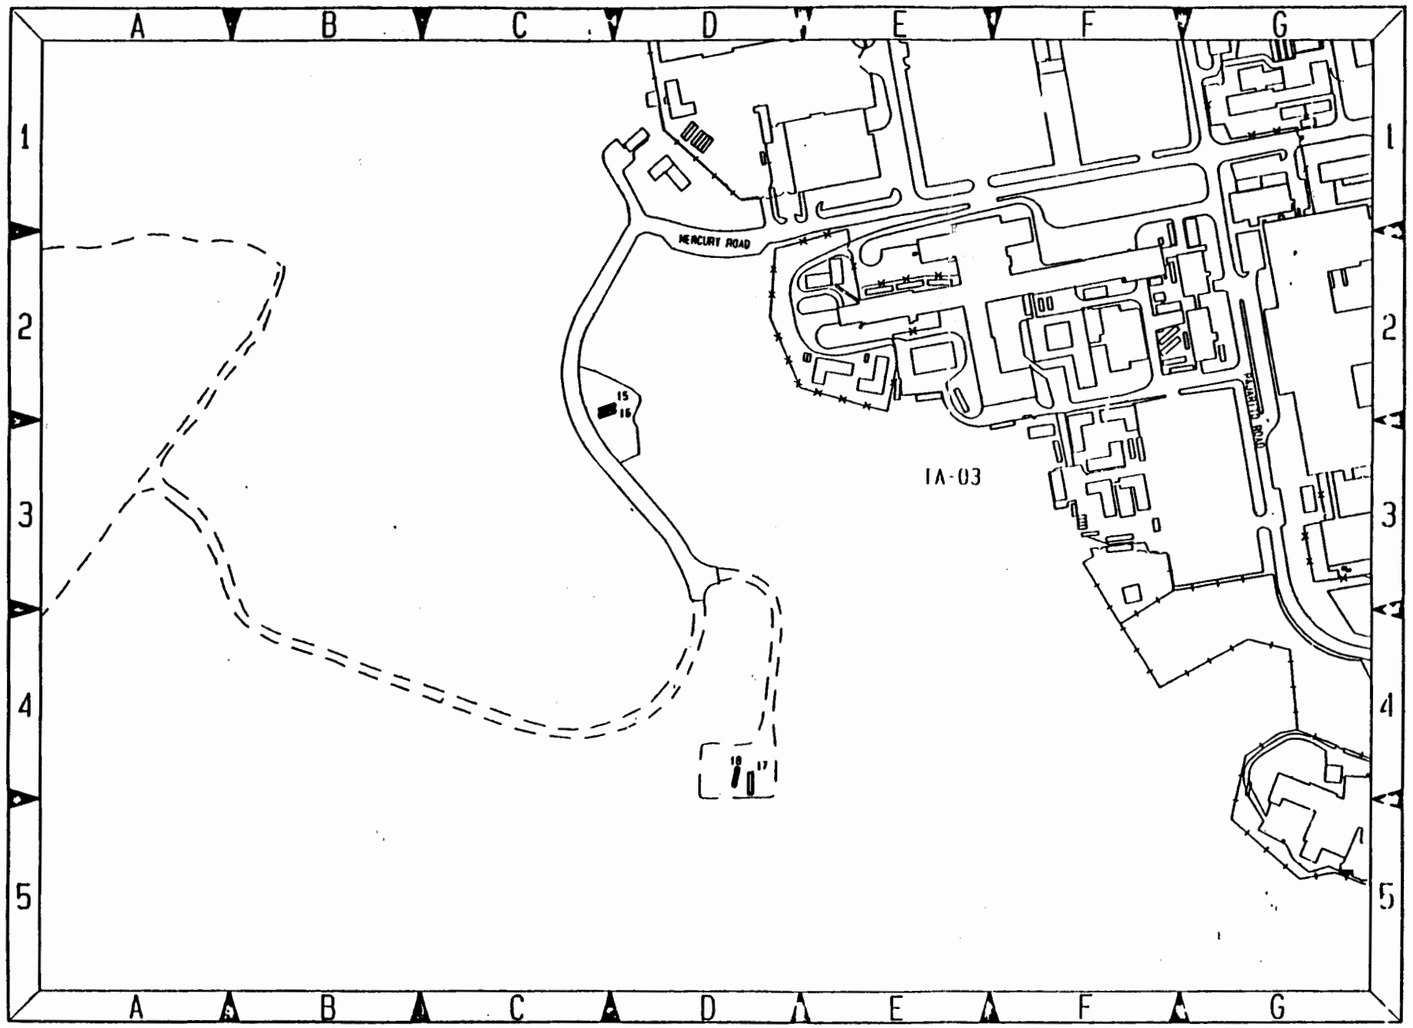

FIELD VERIFIED 03-29-1993

STRUCTURE NUMBER INDEX

STRUCTURE TA-NUMBER	STRUCTURE DESIGNATION	STRUCTURE NOMENCLATURE	STRUCTURE LOCATOR SHEET NO.	STRUCTURE LOCATOR MAP KEY
58-15	58-15	STORAGE TRAILER	1	C-2
58-16	58-16	STORAGE TRAILER	1	C-2
58-17	58-17	STORAGE TRAILER	1	D-4
58-18	58-18	STORAGE TRAILER	1	D-4

NO	DATE	CLASS. REV.	REVISIONS	DWN	VER	CHKD	REL	SUB	REC	APP

JOHNSON CONTROLS WORLD SERVICES INC.

AS-BUILT STRUCTURE LOCATION MAPS

TA-58

TWO MILE MESA NORTH SITE

DRAWN
VERIFIED
CHECKED
RELEASED
DATE 03-29-93

SUBMITTED
RECOMMENDED
APPROVED

Los Alamos — Los Alamos National Laboratory, Los Alamos, New Mexico 87545

SHEET 1 / 1

CLASSIFICATION UNC REVIEWER H. SALAZAR DATE 3-29-93

PROJECT ID 11952 | DRAWING NO. AB44 | REV. 1

JCI 91-020

STRUCTURE LOCATION MAPS

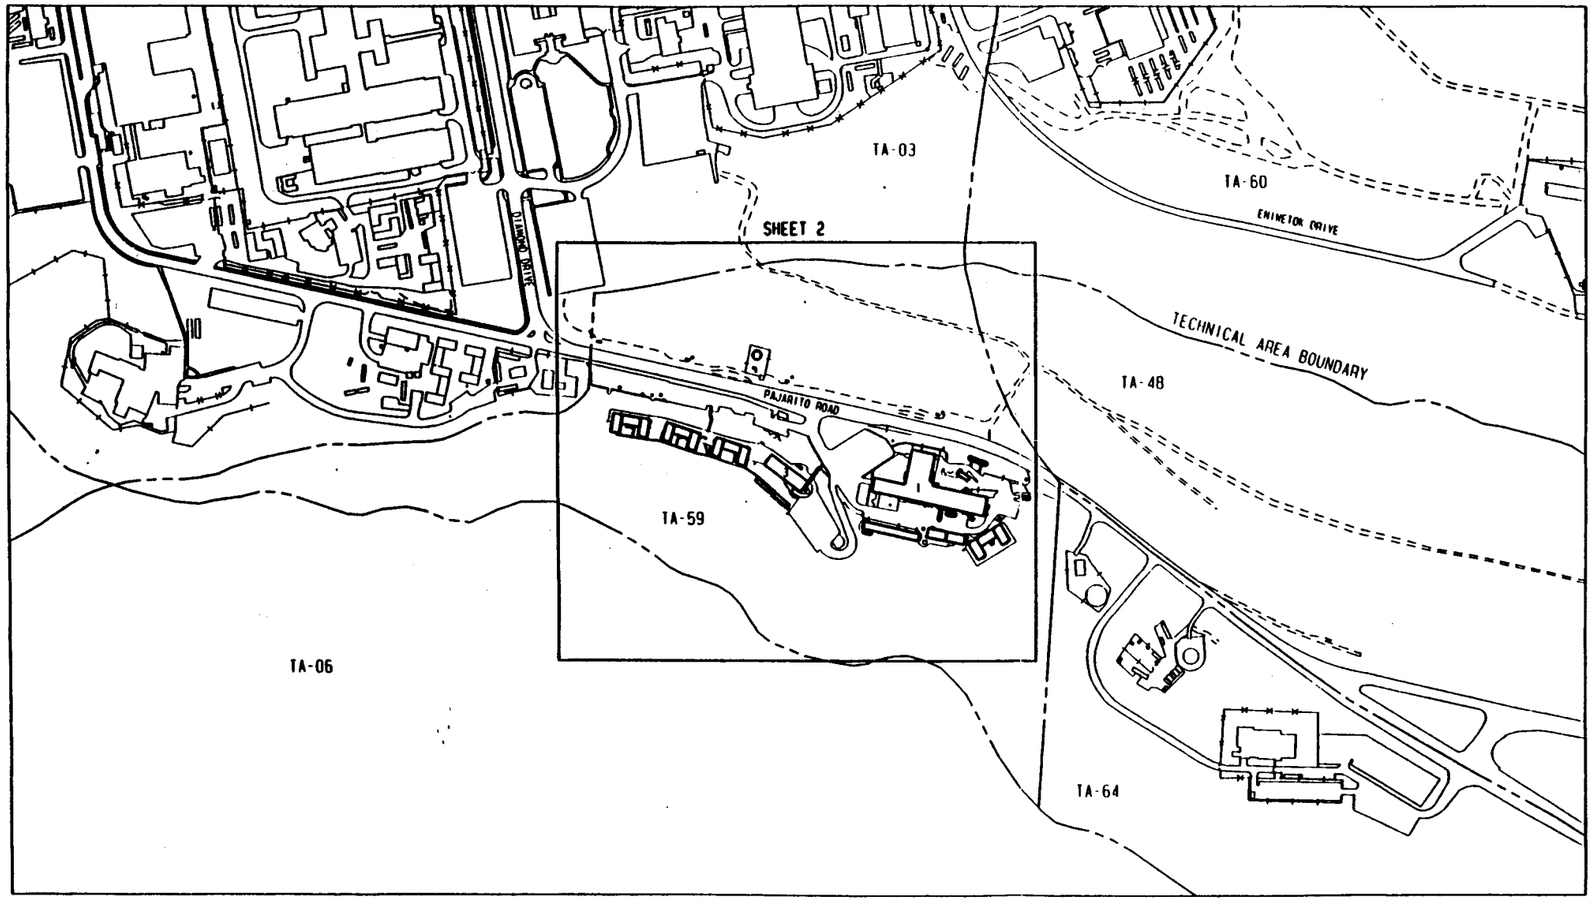

TA-59 KEY MAP

SCALE: 1:2400

200 0 200 400
FEET

N

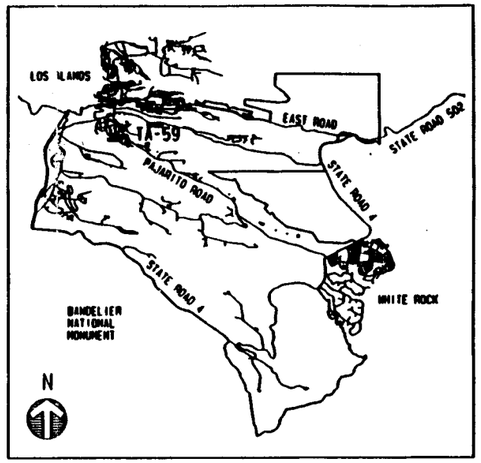

LOCATION PLAN

SCALE: NONE

NO	DATE	CLASS REV	REVISIONS	DWN	VER	CHKD	REL	SUB	REC	APP

JOHNSON CONTROLS WORLD SERVICES INC.

AS-BUILT STRUCTURE LOCATION MAPS

TA-59

OH SITE

DRAWN	J. NOME
VERIFIED	J. NOME
CHECKED	H. SALAZAR
RELEASED	H. SALAZAR
DATE	04-19-94

SUBMITTED: JERRY STATE
RECOMMENDED: BRIAN COHEN
APPROVED: ROBERT PROMEL

Los Alamos — Los Alamos National Laboratory, Los Alamos, New Mexico 87545

SHEET 1 of 2

CLASSIFICATION: U — REVIEWER: H. SALAZAR — DATE: 4-19-94

PROJECT ID: 11952 — DRAWING NO: AB45 — REV:

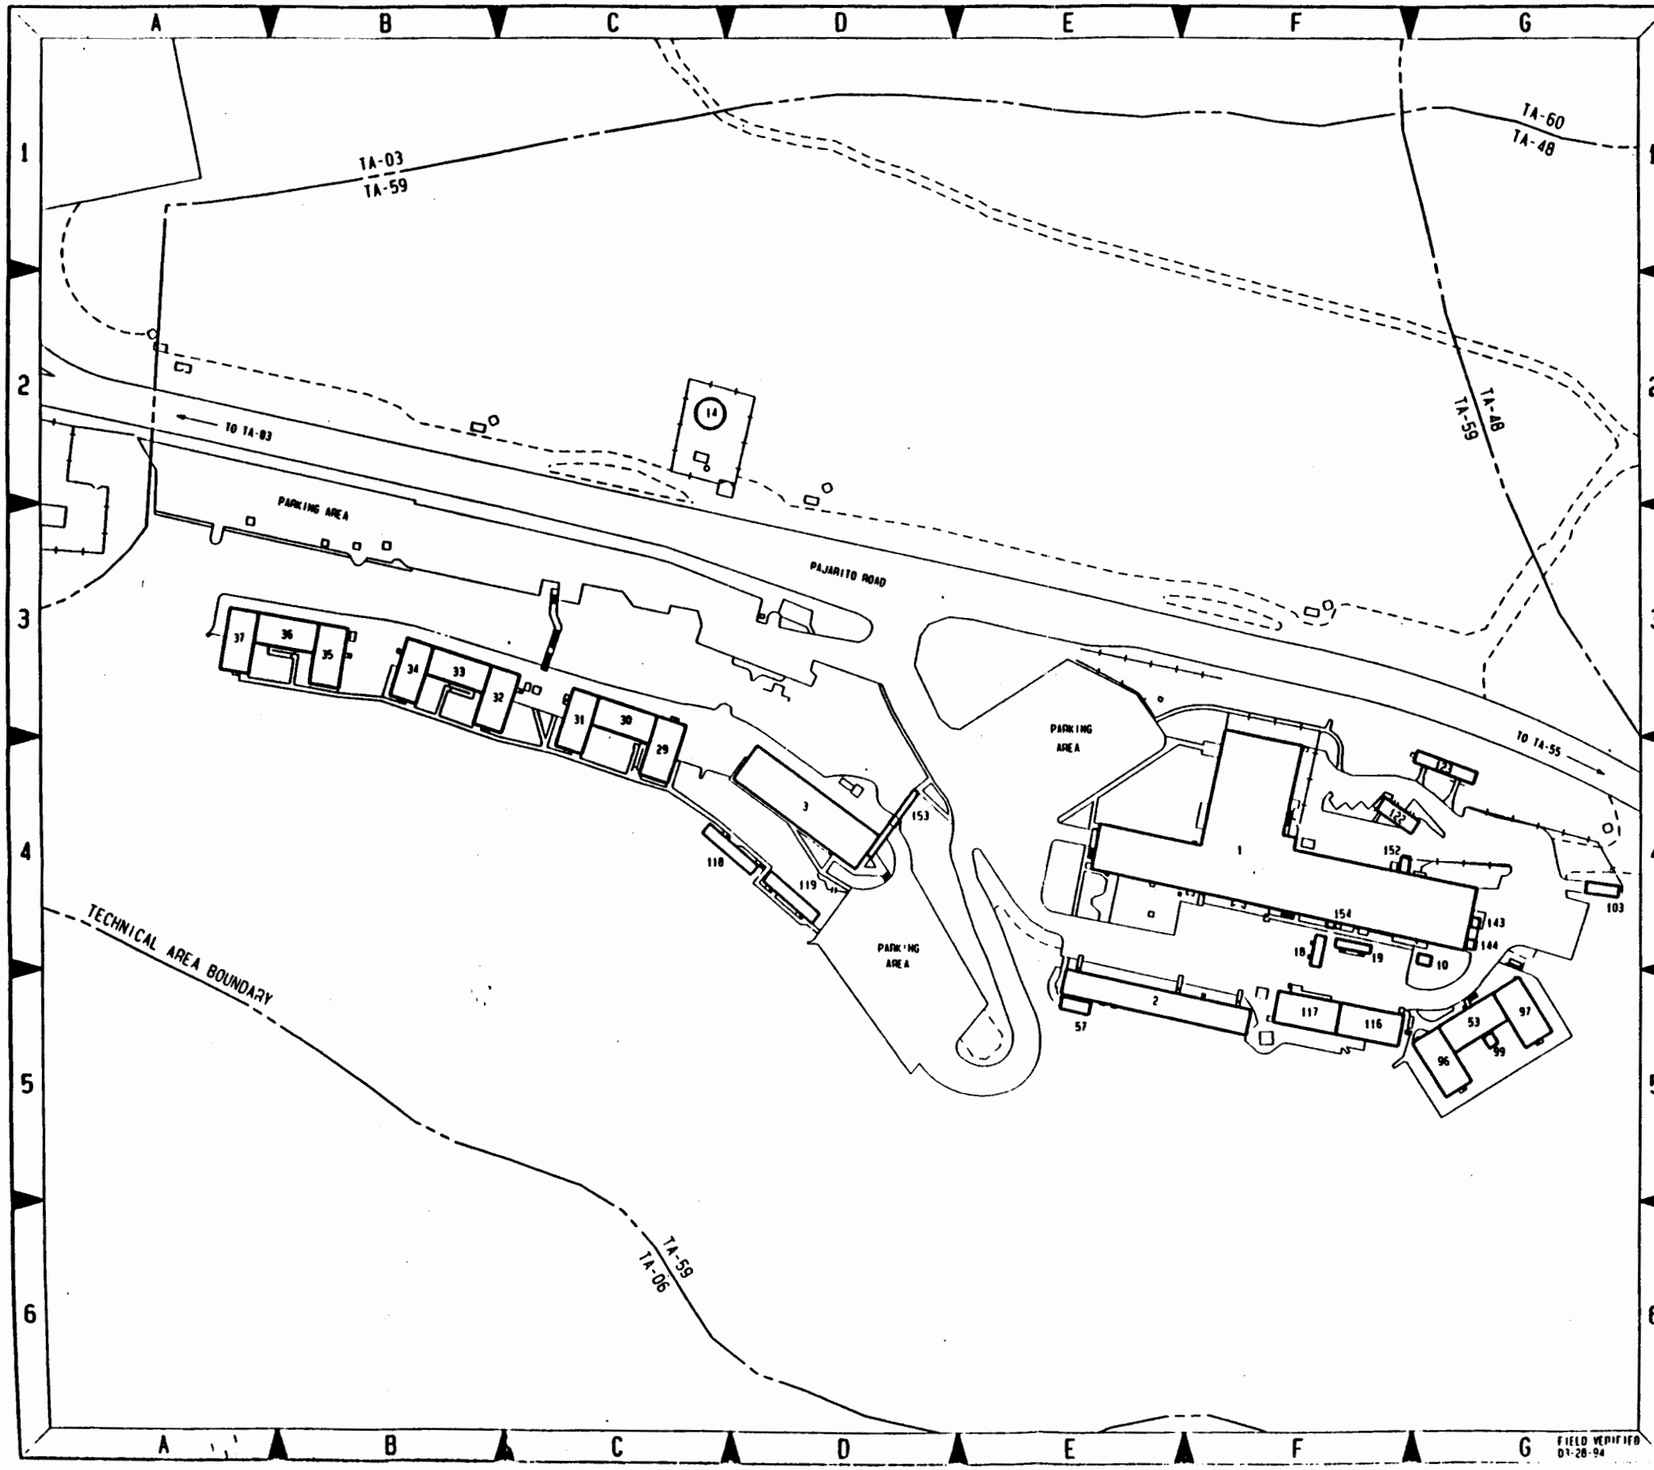

FIELD VERIFIED 01-28-94

STRUCTURE LOCATION INDEX

STRUCTURE TA-NUMBER	STRUCTURE DESIGNATION	STRUCTURE NOMENCLATURE	STRUCTURE LOCATION SHEET NO.	STRUCTURE LOCATION MAP KEY
59-1	59-1	OCCUPATIONAL HEALTH LAB	2	F-4
59-2	OH-2	MODULAR OFFICE BLDG	2	E-5
59-3	OH-3	OFFICE BUILDING	2	D-4
59-10	59-10	COOLING TOWER	2	G-4
59-14	59-14	WATER TANK	2	C-2
59-18	OH-18	TRAILER, OFFICE	2	F-4
59-19	OH-19	TRAILER, OFFICE	2	F-4
59-29	59-29	TRANSPORTABLE OFFICE BLDG.	2	C-4
59-30	59-30	TRANSPORTABLE OFFICE BLDG.	2	C-3
59-31	59-31	TRANSPORTABLE OFFICE BLDG.	2	C-3
59-32	59-32	TRANSPORTABLE OFFICE BLDG.	2	D-3
59-33	59-33	TRANSPORTABLE OFFICE BLDG.	2	D-3
59-34	59-34	TRANSPORTABLE OFFICE BLDG.	2	D-3
59-35	59-35	TRANSPORTABLE OFFICE BLDG.	2	D-3
59-36	59-36	TRANSPORTABLE OFFICE BLDG.	2	D-3
59-37	59-37	TRANSPORTABLE OFFICE BLDG.	2	A-3
59-53	OH-53	TRANSPORTABLE OFFFICE BLDG.	2	G-5
59-57	59-57	SHED	2	E-5
59-96	59-96	TRANSPORTABLE OFFICE BLDG.	2	G-5
59-97	59-97	TRANSPORTABLE OFFICE BLDG.	2	G-5
59-99	59-99	SHED	2	G-5
59-103	59-103	SHED	2	G-4
59-116	59-116	TRANSPORTABLE OFFICE BLDG.	2	F-5
59-117	59-117	TRANSPORTABLE OFFICE BLDG.	2	F-5
59-118	59-118	TRAILER, OFFICE	2	D-4
59-119	59-119	TRAILER, OFFICE	2	D-4
59-122	59-122	SHED, GARAGE	2	F-4
59-123	59-123	TRAILER, OFFICE	2	G-4
59-143	59-143	STORAGE FREEZER	2	G-4
59-144	59-144	STORAGE FREEZER	2	G-4
59-152	59-152	STORAGE BUILDING	2	F-4
59-153	59-153	PEDESTRIAN CATWALK	2	D-4
59-154	59-154	HAZ-STOR TRANSPORTAINER	2	F-4

N

SCALE: 1:720

60 0 60 120
FEET

NO	DATE	CLASS REV	REVISIONS	DWN	VER	CHKD	REL	SUB	REC	APP

JOHNSON CONTROLS WORLD SERVICES INC.

AS-BUILT STRUCTURE LOCATION MAPS

TA-59

OH SITE

DRAWN J. [illegible]
VERIFIED J. [illegible]
CHECKED R. SALAZAR
RELEASED R. SALAZAR
DATE 04-19-94

SUBMITTED JERIN FORME
RECOMMENDED BRIAN COMER
APPROVED ROBERT PARRINELLO

Los Alamos — Los Alamos National Laboratory, Los Alamos, New Mexico 87545

SHEET 2 / 2

CLASSIFICATION U REVIEWER R. SALAZAR DATE 4-19-94

PROJECT NO 11952

DRAWING NO AB45

REV

4 JUN 1994

STRUCTURE LOCATION MAPS

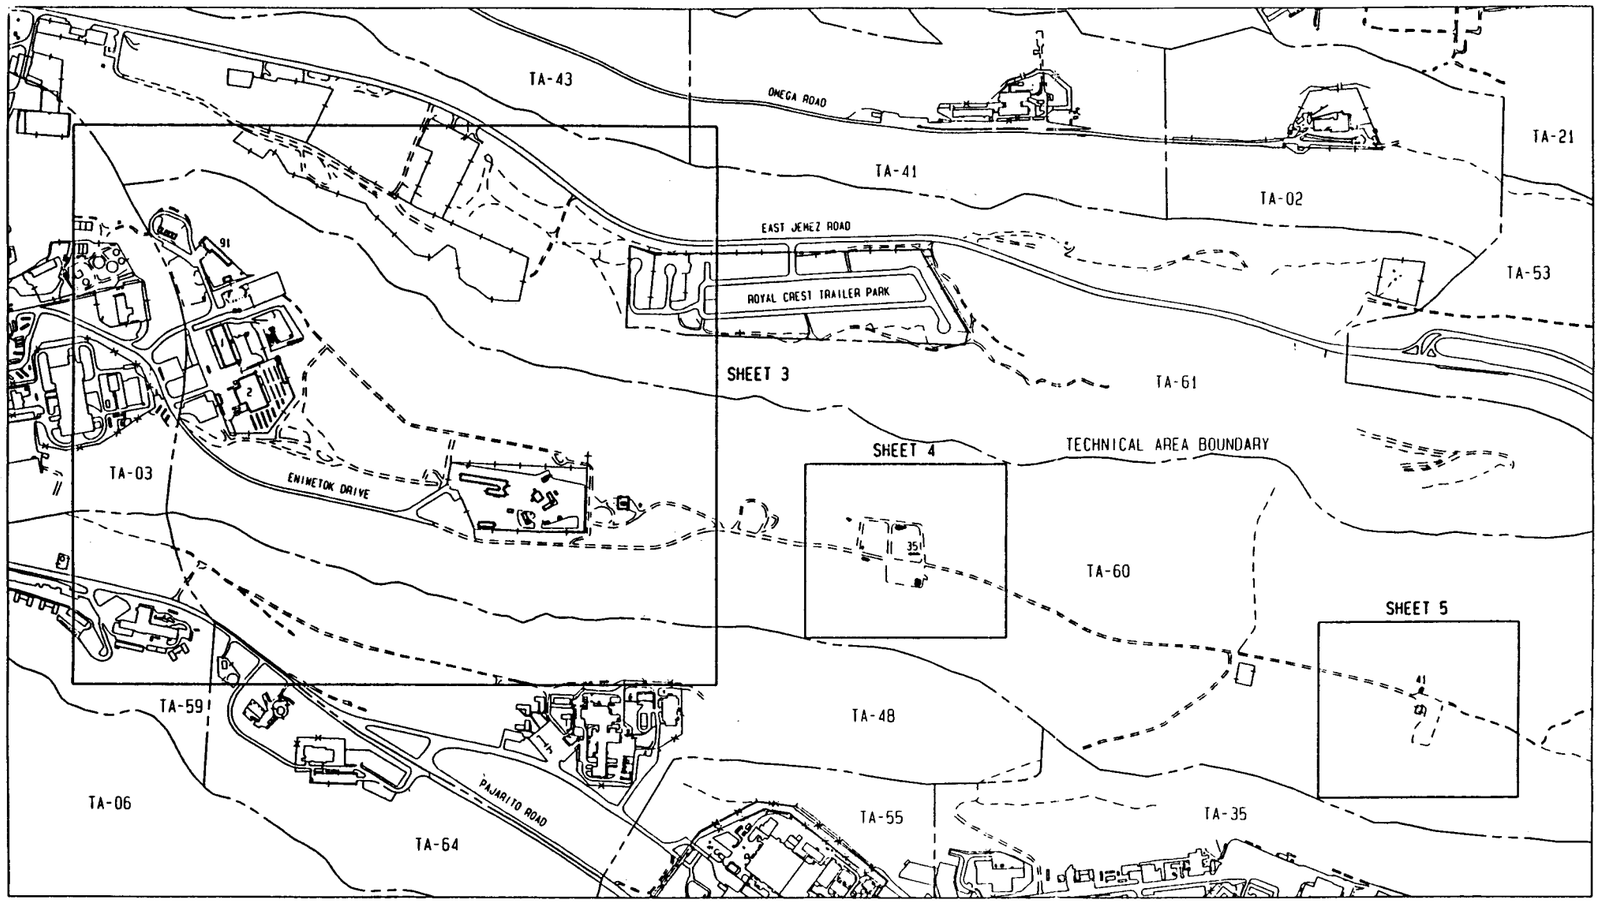

TA-60 KEY MAP

SCALE: 1:4800

400 0 400 800

FEET

N

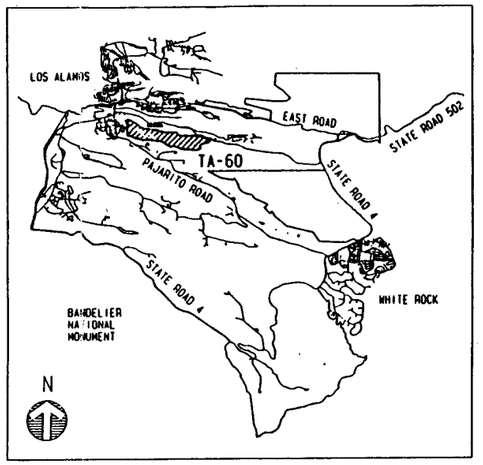

LOCATION PLAN

SCALE: NONE

NO	DATE	CLASS REV	REVISIONS	DWN	VER	CHKD	REL	SUB	REC	APP

JOHNSON CONTROLS WORLD SERVICES INC.

AS-BUILT STRUCTURE LOCATION MAPS

TA-60

SIGMA MESA SITE

DRAWN	J. HORE
VERIFIED	J. HORE
CHECKED	H. SALAZAR
RELEASED	H. SALAZAR
DATE	02-02-94

SUBMITTED JERRY FORTE

RECOMMENDED BRYAN LOWER

APPROVED ROBERT PROMMEL

Los Alamos — Los Alamos National Laboratory, Los Alamos, New Mexico 87545

SHEET 1 OF 5

CLASSIFICATION U REVIEWER H. SALAZAR DATE

PROJECT ID 11952

DRAWING NO AB46

REV

JC NO 91-020

FIELD VERIFIED 01-25-94

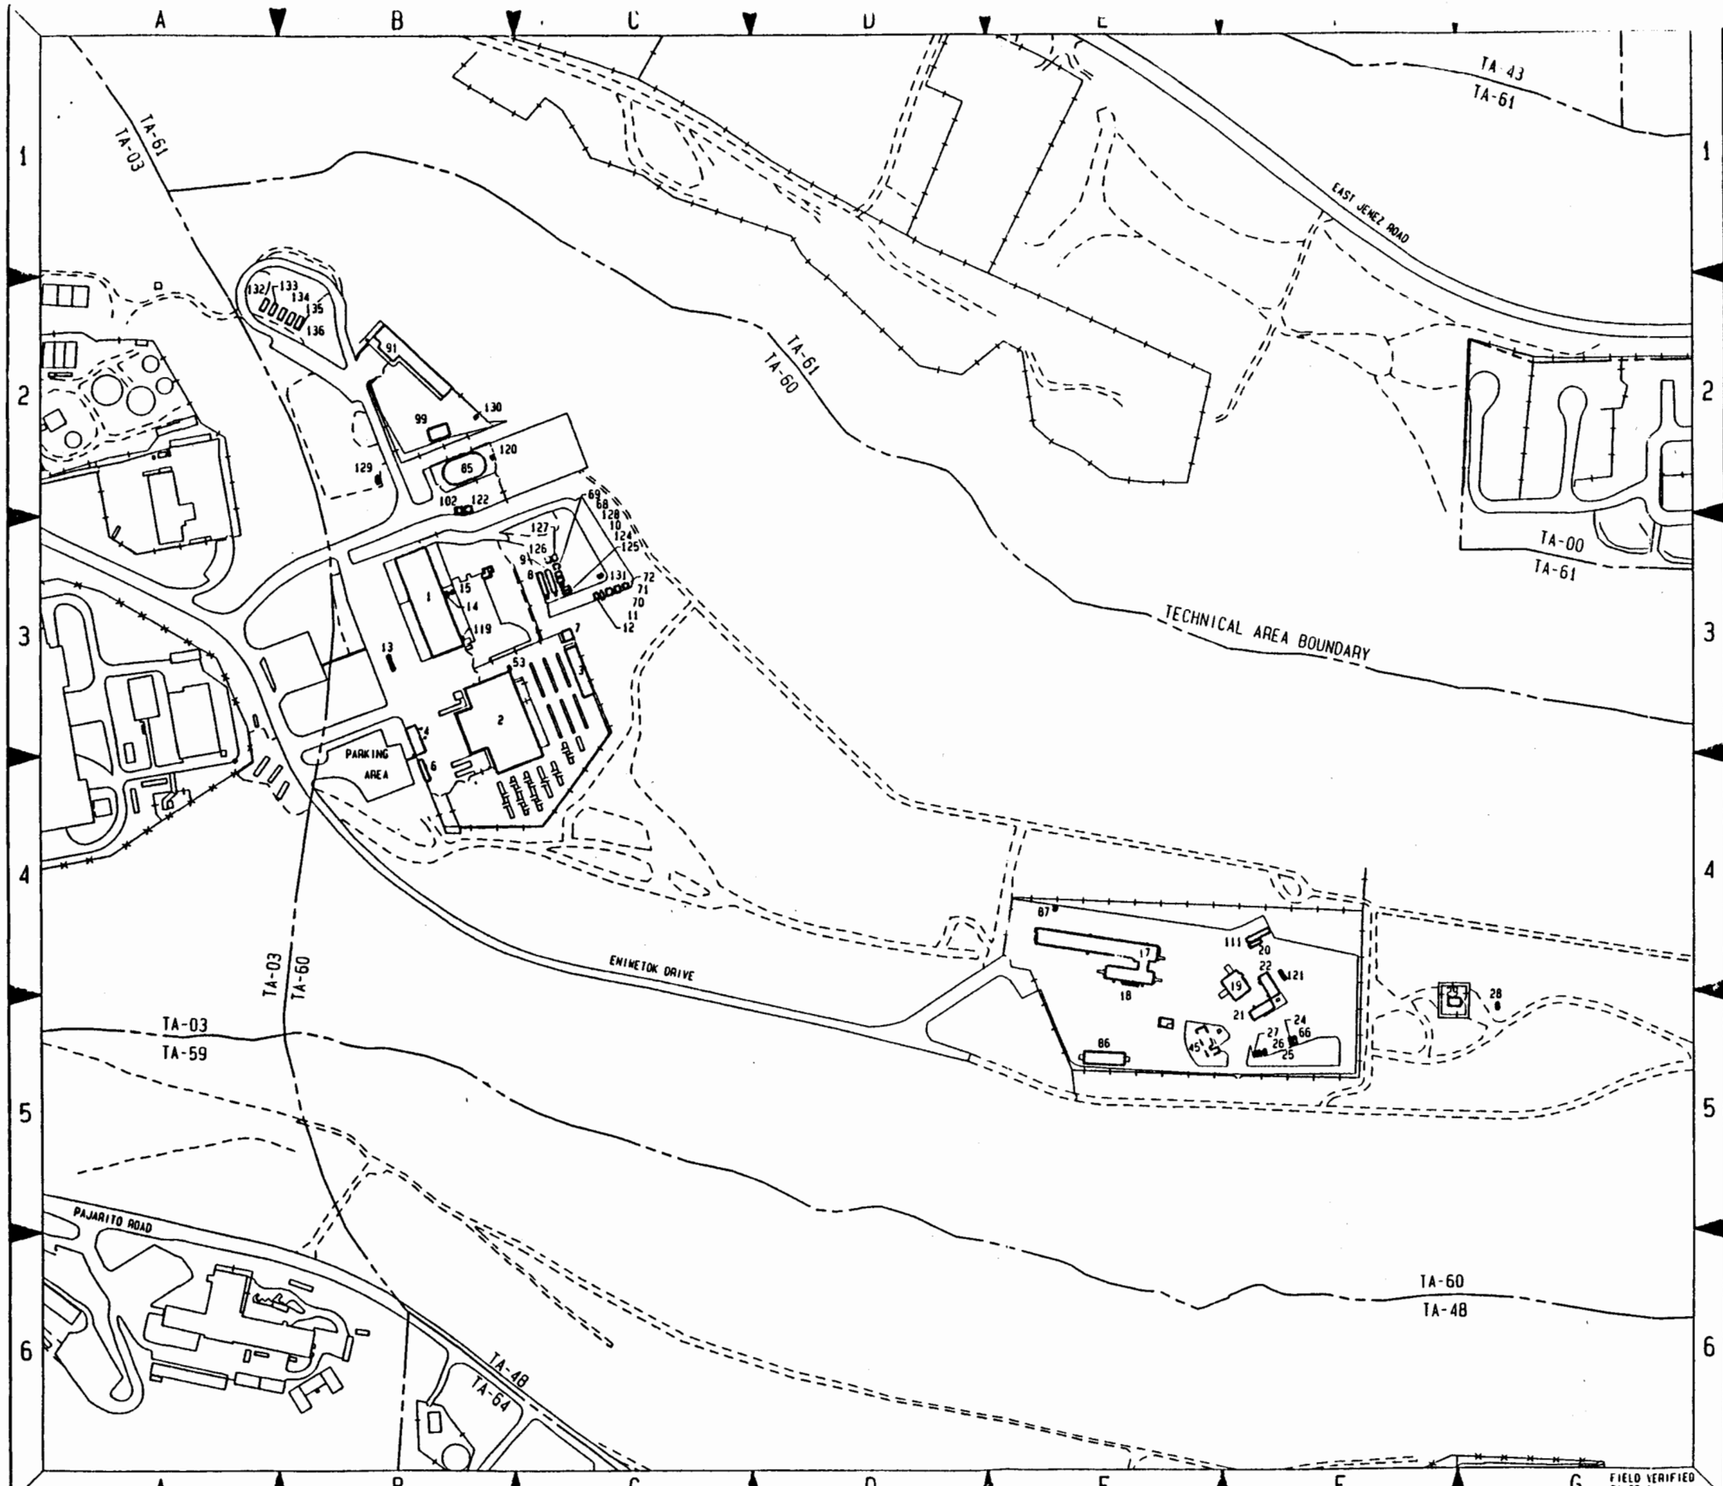

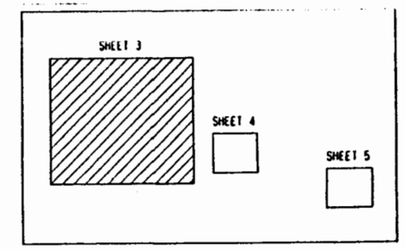

N

SCALE: 1:1920

160 0 160 320

FEET

NO	DATE	CLASS REV	REVISIONS	DWN	VER	CHKD	REL	SUB	REC	APP

JOHNSON CONTROLS WORLD SERVICES INC.

AS-BUILT STRUCTURE LOCATION MAPS

TA-60

SIGMA MESA SITE

DRAWN	J. HORK
VERIFIED	J. HORK
CHECKED	H. SALAZAR
RELEASED	H. SALAZAR
DATE	02-02-94

SUBMITTED JERRY FORTE — RECOMMENDED BRYAN COHEN — APPROVED ROBERT PROMMEL

Los Alamos — Los Alamos National Laboratory, Los Alamos, New Mexico 87545

SHEET 3 — 3 of 5

CLASSIFICATION — REVIEWER H. SALAZAR — DATE

PROJECT ID 11952 — DRAWING NO AB46 — REV

JCI NO 91-020

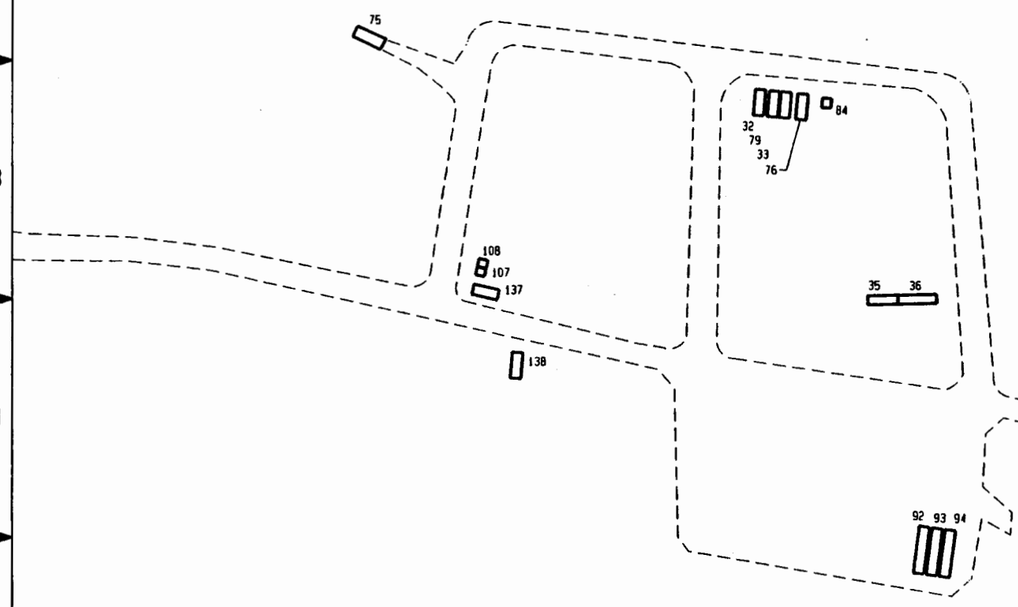

KEY MAP

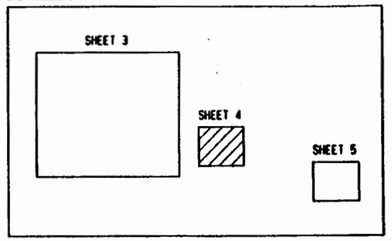

N

SCALE: 1:600

50 0 50 100

FEET

NO	DATE	CLASS REV	REVISIONS	DWN	VER	CHKD	REL	SUB	REC	APP
1	08-02-94		REVISED TO STATUS OF 07-25-94	JPH	JPH	HWS	HWS	JAF	BEC	RAP

JOHNSON CONTROLS WORLD SERVICES INC.

AS-BUILT STRUCTURE LOCATION MAPS

TA-60

SIGMA MESA SITE

DRAWN	J. HORK
VERIFIED	J. HORK
CHECKED	H. SALAZAR
RELEASED	H. SALAZAR
DATE	02-02-94

SUBMITTED JERRY FORTE | RECOMMENDED BRYAN COMER | APPROVED ROBERT PROMMEL

Los Alamos — Los Alamos National Laboratory, Los Alamos, New Mexico 87545

SHEET 4 OF 5

CLASSIFICATION U REVIEWER H. SALAZAR DATE 8-2-94

PROJECT ID	DRAWING NO	REV
11952	AB46	1

JCI NO 91-020

FIELD VERIFIED 07-25-94

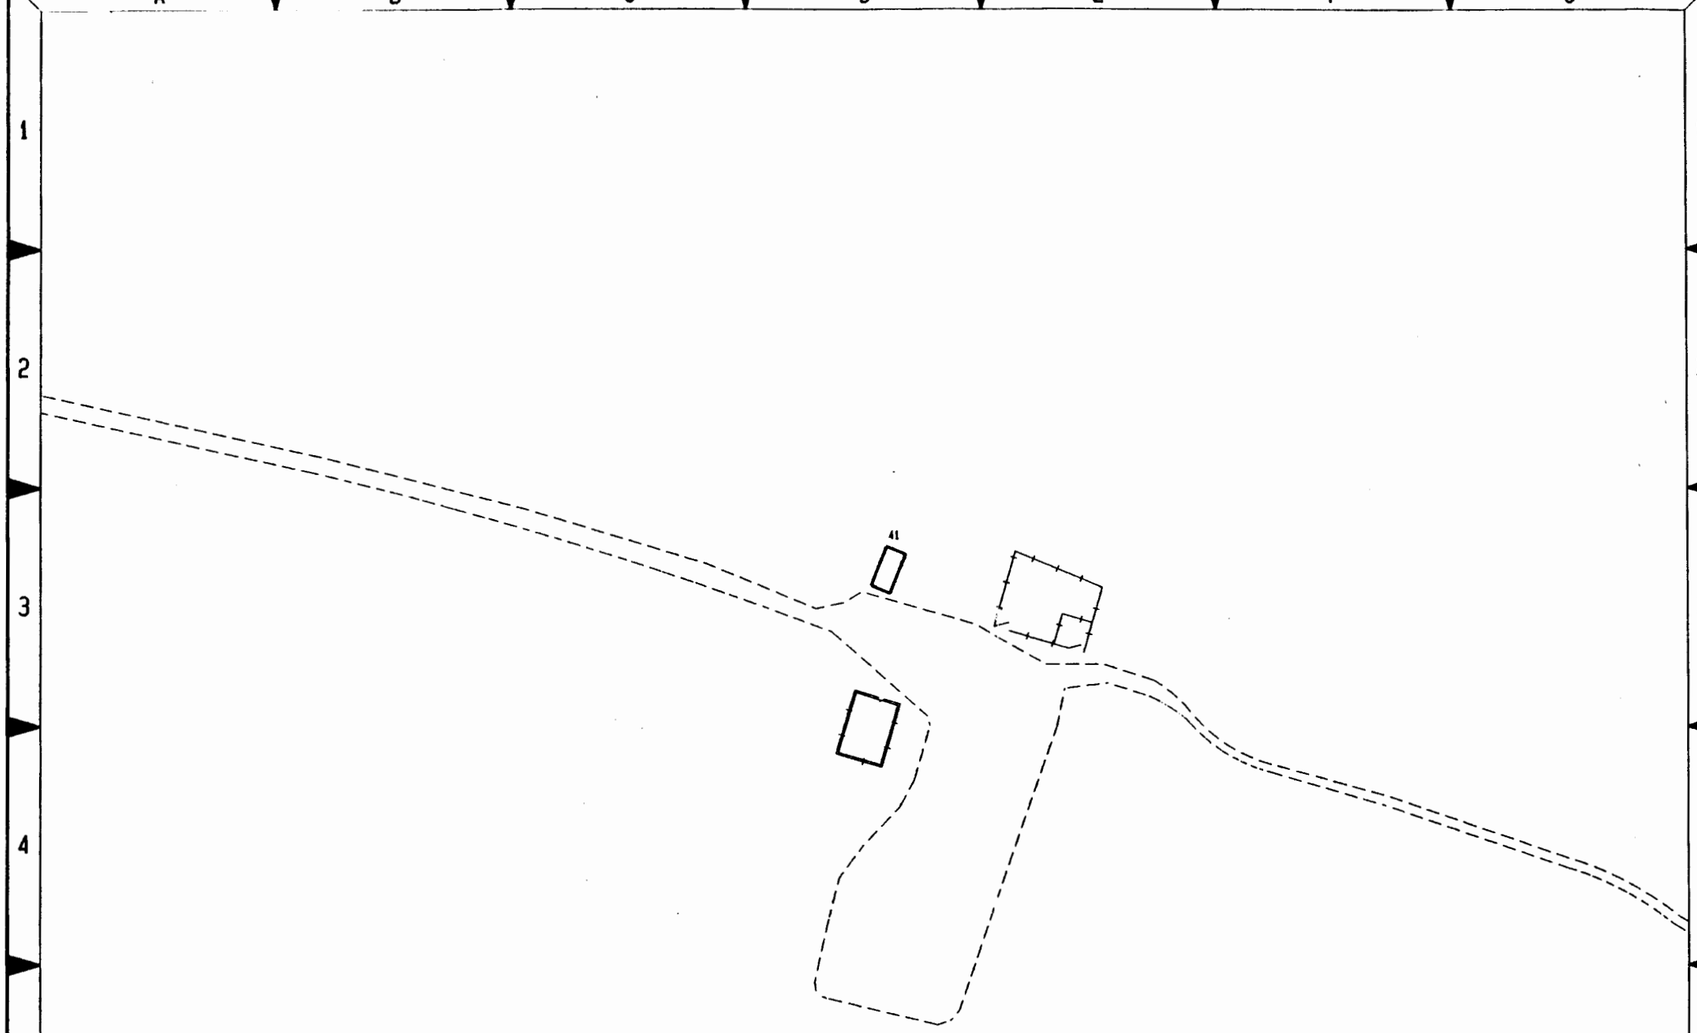

KEY MAP

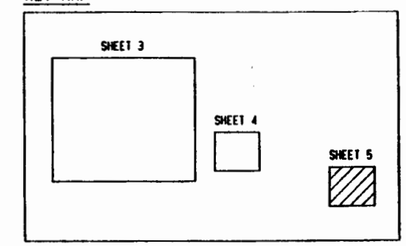

N

SCALE: 1:600

50 0 50 100

FEET

NO	DATE	CLASS REV	REVISIONS	DWN	VER	CHKD	REL	SUB	REC	APP
1	08-02-94		REVISED TO STATUS OF 07-25-94	JPH	JPH	HWS	HWS	JAF	BEC	RAP

JOHNSON CONTROLS WORLD SERVICES INC.

AS-BUILT STRUCTURE LOCATION MAPS

TA-60

SIGMA MESA SITE

DRAWN	J. NORK
VERIFIED	J. NORK
CHECKED	H. SALAZAR
RELEASED	H. SALAZAR
DATE	02-02-94

SUBMITTED JERRY FORTE — RECOMMENDED BRYAN COMER — APPROVED ROBERT PROMMEL

Los Alamos — Los Alamos National Laboratory, Los Alamos, New Mexico 87545

SHEET 5 OF 5

CLASSIFICATION U — REVIEWER H. SALAZAR — DATE 8-2-94

PROJECT ID	DRAWING NO	REV
11952	AB46	1

FIELD VERIFIED 07-25-94

JCI NO 91-020

STRUCTURE LOCATION MAPS

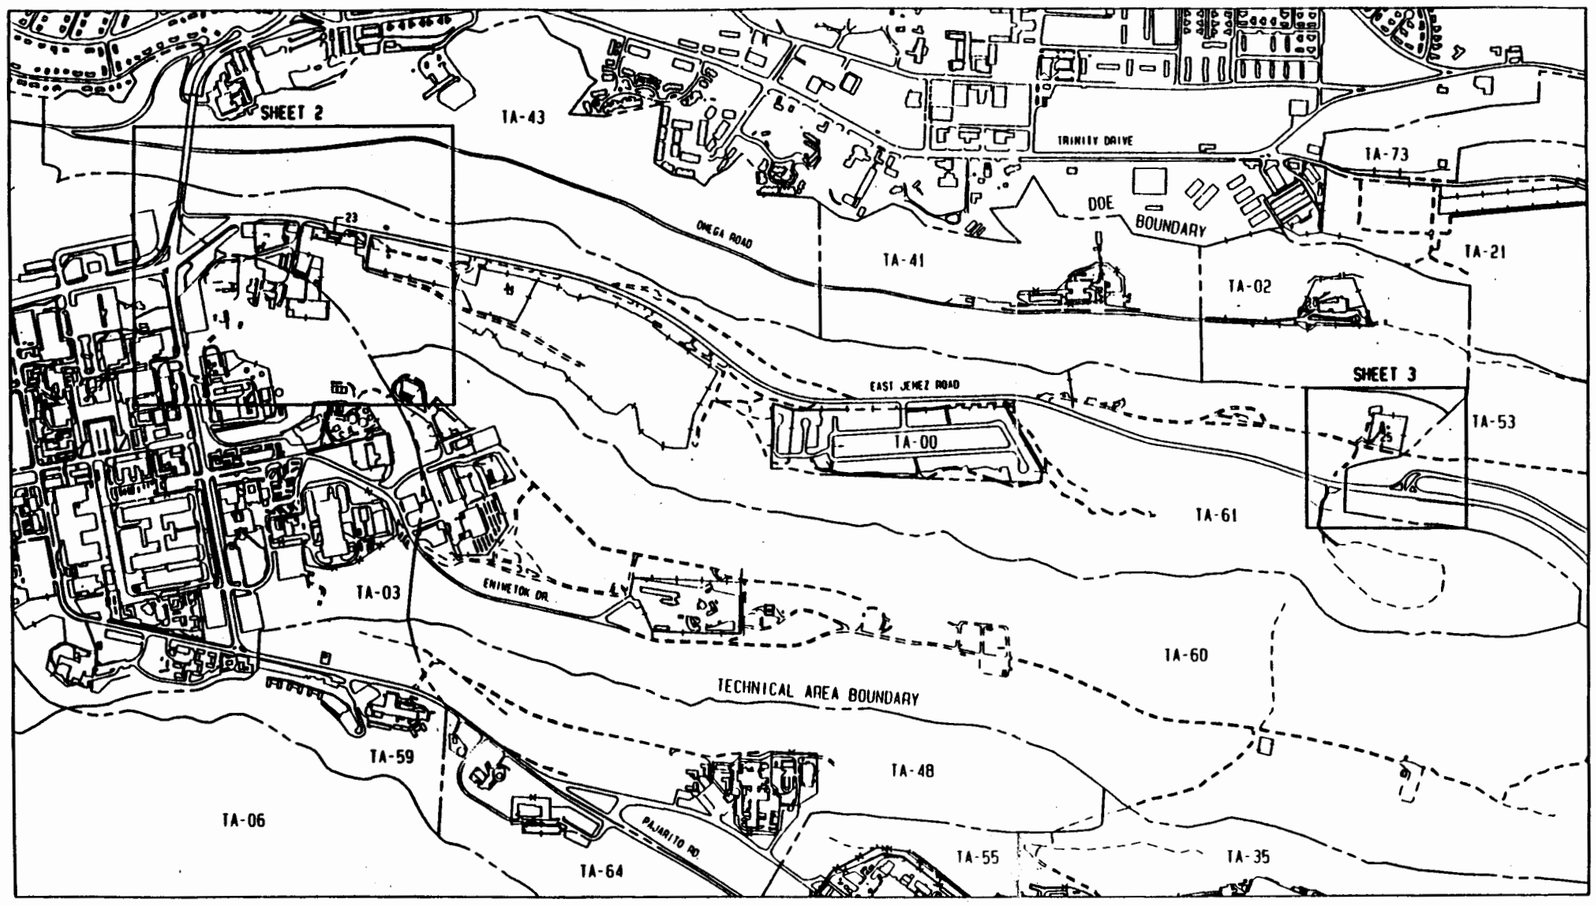

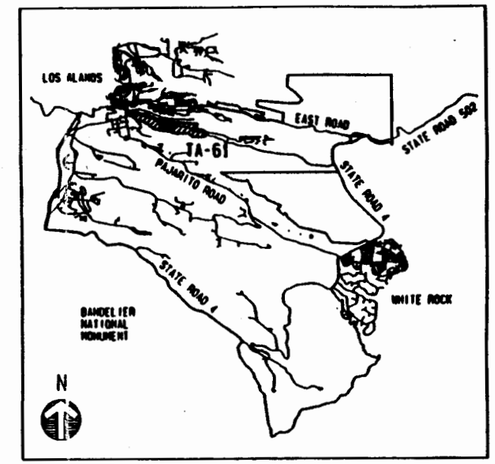

LOCATION PLAN

SCALE: NONE

TA-61 KEY MAP

SCALE: 1:6000

500 0 500 1000

FEET

N

NO	DATE	LAST REV	REVISIONS	DWN	VER	CHKD	REL	SUB	REC	APP

JOHNSON CONTROLS WORLD SERVICES INC.

AS-BUILT STRUCTURE LOCATION MAPS

TA-61

EAST JEMEZ SITE

DRAWN J. [illegible]
VERIFIED J. [illegible]
CHECKED [illegible]
RELEASED [illegible]
DATE 03-23-94

SUBMITTED [illegible]
RECOMMENDED BRIAN CAMERA [illegible]
APPROVED ROBERT PRONOL [illegible]

Los Alamos — Los Alamos National Laboratory, Los Alamos, New Mexico 87545

SHEET 1 — 1 of 3

CLASSIFICATION U — REVIEWER K. SALAZAR [illegible] — DATE 3-29-94

PROJECT ID 11952 — DRAWING NO AB47 — REV

020-16 OK 17

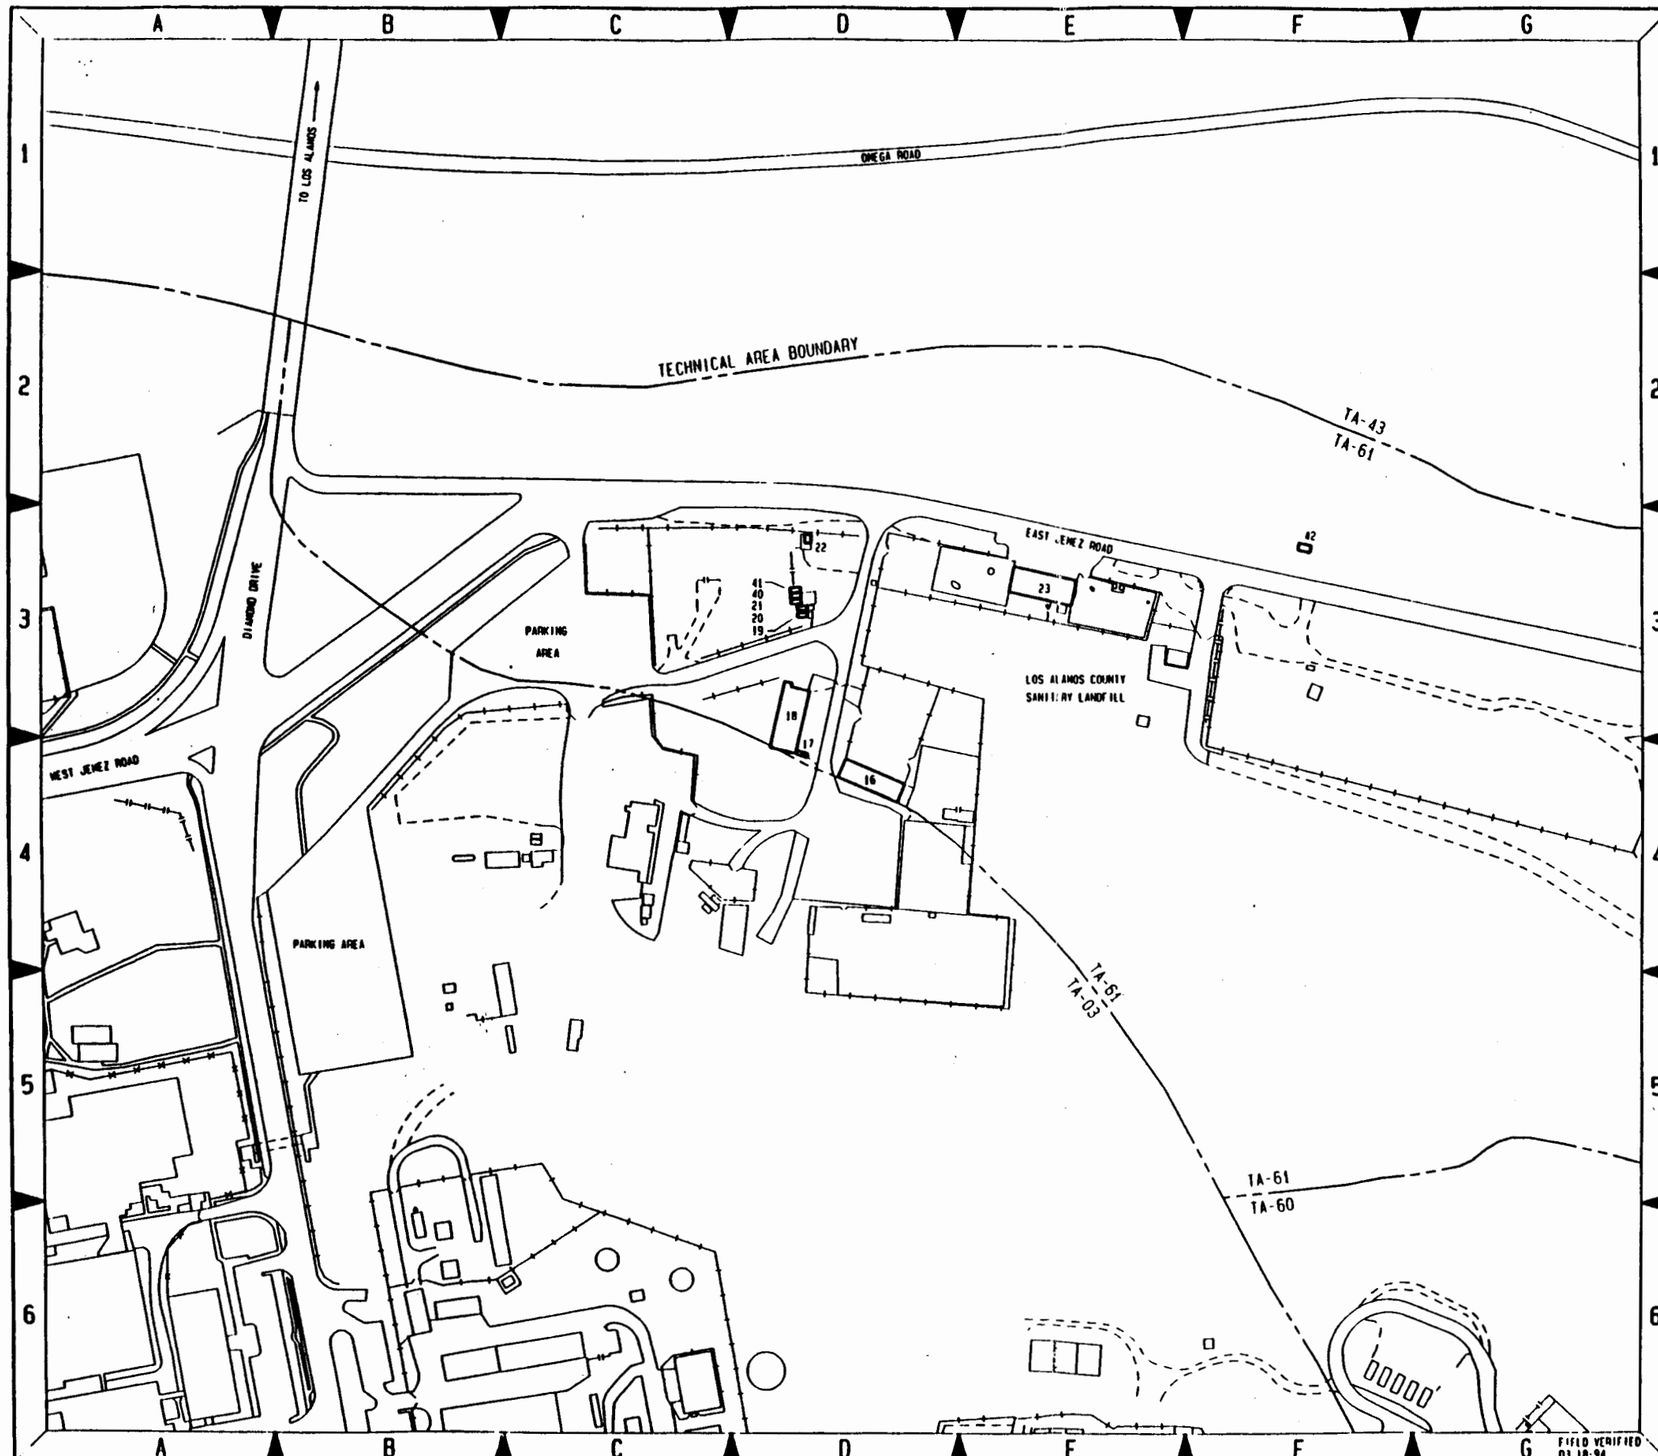

KEY MAP

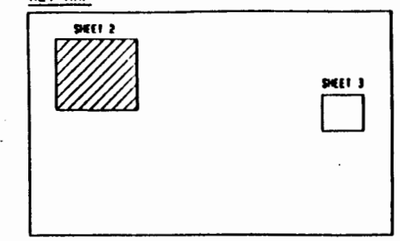

STRUCTURE LOCATION INDEX

STRUCTURE TA-NUMBER	STRUCTURE DESIGNATION	STRUCTURE NOMENCLATURE	STRUCTURE LOCATION SHEET NO.	STRUCTURE LOCATION MAP KEY
61-16	61-16	STORAGE BUILDING	2	D-4
61-17	61-17	STORAGE BUILDING	2	D-4
61-18	61-18	WAREHOUSE	2	D-3
61-19	61-19	STORAGE SHED	2	D-3
61-20	61-20	STORAGE SHED	2	D-3
61-21	61-21	STORAGE SHED	2	D-3
61-22	61-22	STORAGE SHED	2	D-3
61-23	61-23	MODEL SHOP	2	E-3
61-24	61-24	BLOWER HOUSE	3	D-2
61-25	61-25	STACK MONITORING BUILDING	3	D-2
61-26	61-26	BLOWER MAST	3	D-2
61-40	61-40	STORAGE SHED	2	D-3
61-41	61-41	STORAGE SHED	2	D-3
61-42	61-42	BOOSTER STATION	2	F-3

N

SCALE: 1:1200

100 0 100 200

FEET

NO	DATE	CLASS REV	REVISIONS	DWN	VER	CHKD	REL	SUB	REC	APP

JOHNSON CONTROLS WORLD SERVICES INC.

AS-BUILT STRUCTURE LOCATION MAPS

TA-61

EAST JEMEZ SITE

DRAWN J. NORE
VERIFIED J. NORE
CHECKED H. SALAZAR
RELEASED H. SALAZAR
DATE 03-23-94

SUBMITTED JERRY FORTE
RECOMMENDED BRIAN COHEN
APPROVED ROBERT PROMMEL

Los Alamos — Los Alamos National Laboratory, Los Alamos, New Mexico 87545

SHEET 2 / 3

CLASSIFICATION U — REVIEWER H. SALAZAR — DATE 3-28-94

PROJECT ID 11952 — DRAWING NO AB47 — REV

JCI NO 91-020

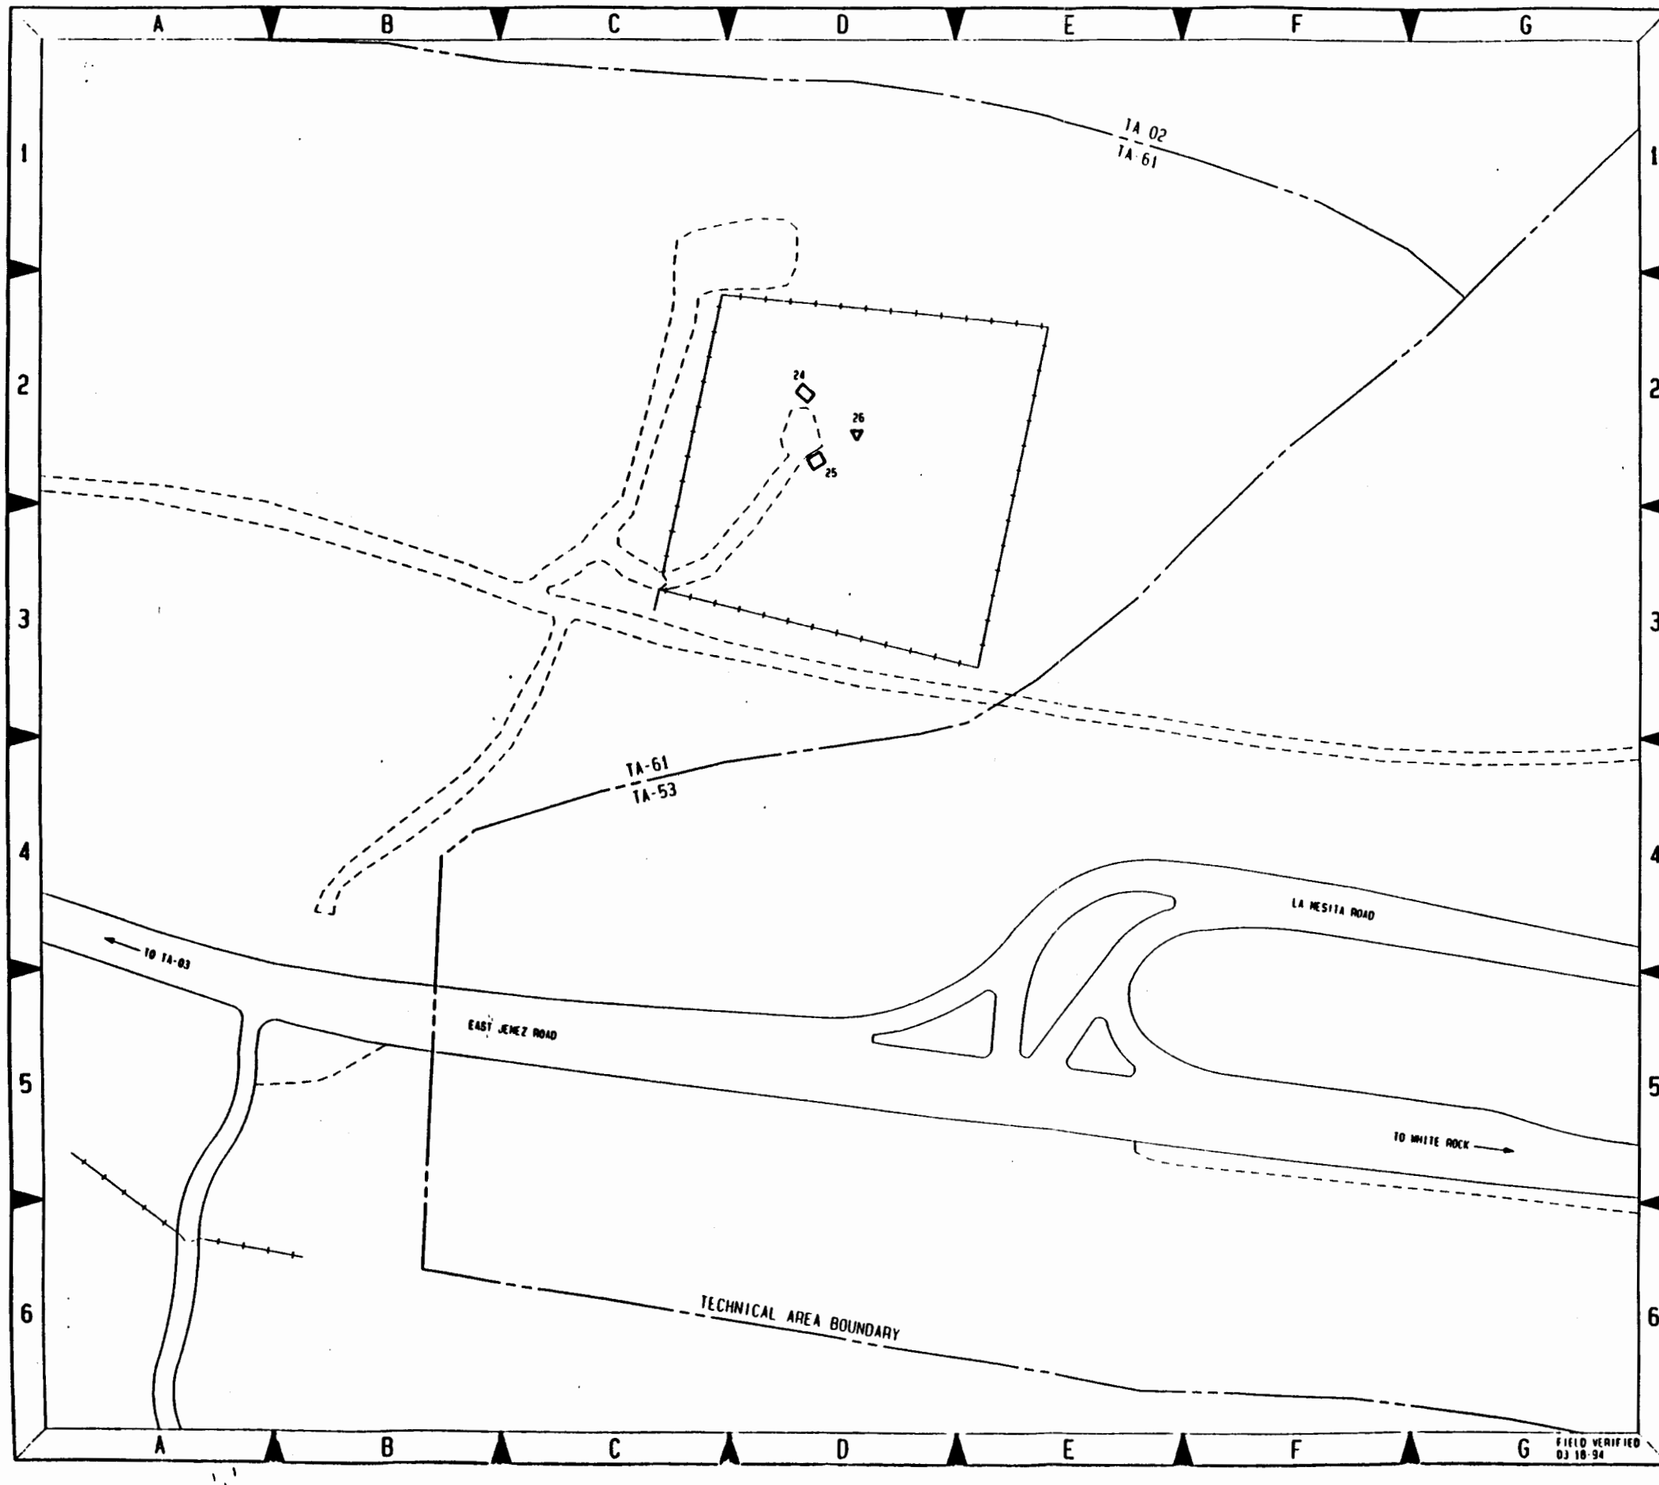

KEY MAP

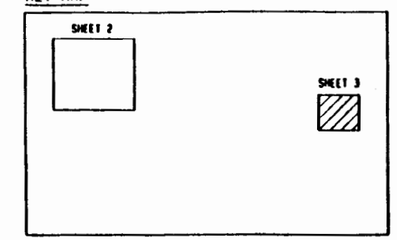

N

SCALE: 1:600

50 0 50 100

FEET

NO	DATE	CLASS REV	REVISIONS	DWN	VER	CHKD	REL	SUB	REC	APP

JOHNSON CONTROLS WORLD SERVICES INC.

AS-BUILT STRUCTURE LOCATION MAPS

TA-61

EAST JEMEZ SITE

DRAWN	A. [illegible]
VERIFIED	J. [illegible]
CHECKED	H. SALAZAR
RELEASED	H. SALAZAR
DATE	03-23-94

SUBMITTED JERRY [illegible] DATE

RECOMMENDED BRIAN COMER

APPROVED ROBERT PRUMMEL

Los Alamos — Los Alamos National Laboratory, Los Alamos, New Mexico 87545

SHEET 3 OF 3

CLASSIFICATION U REVIEWER H. SALAZAR DATE 5-18-94

PROJECT ID 11952

DRAWING NO AB47

REV

STRUCTURE LOCATION MAPS

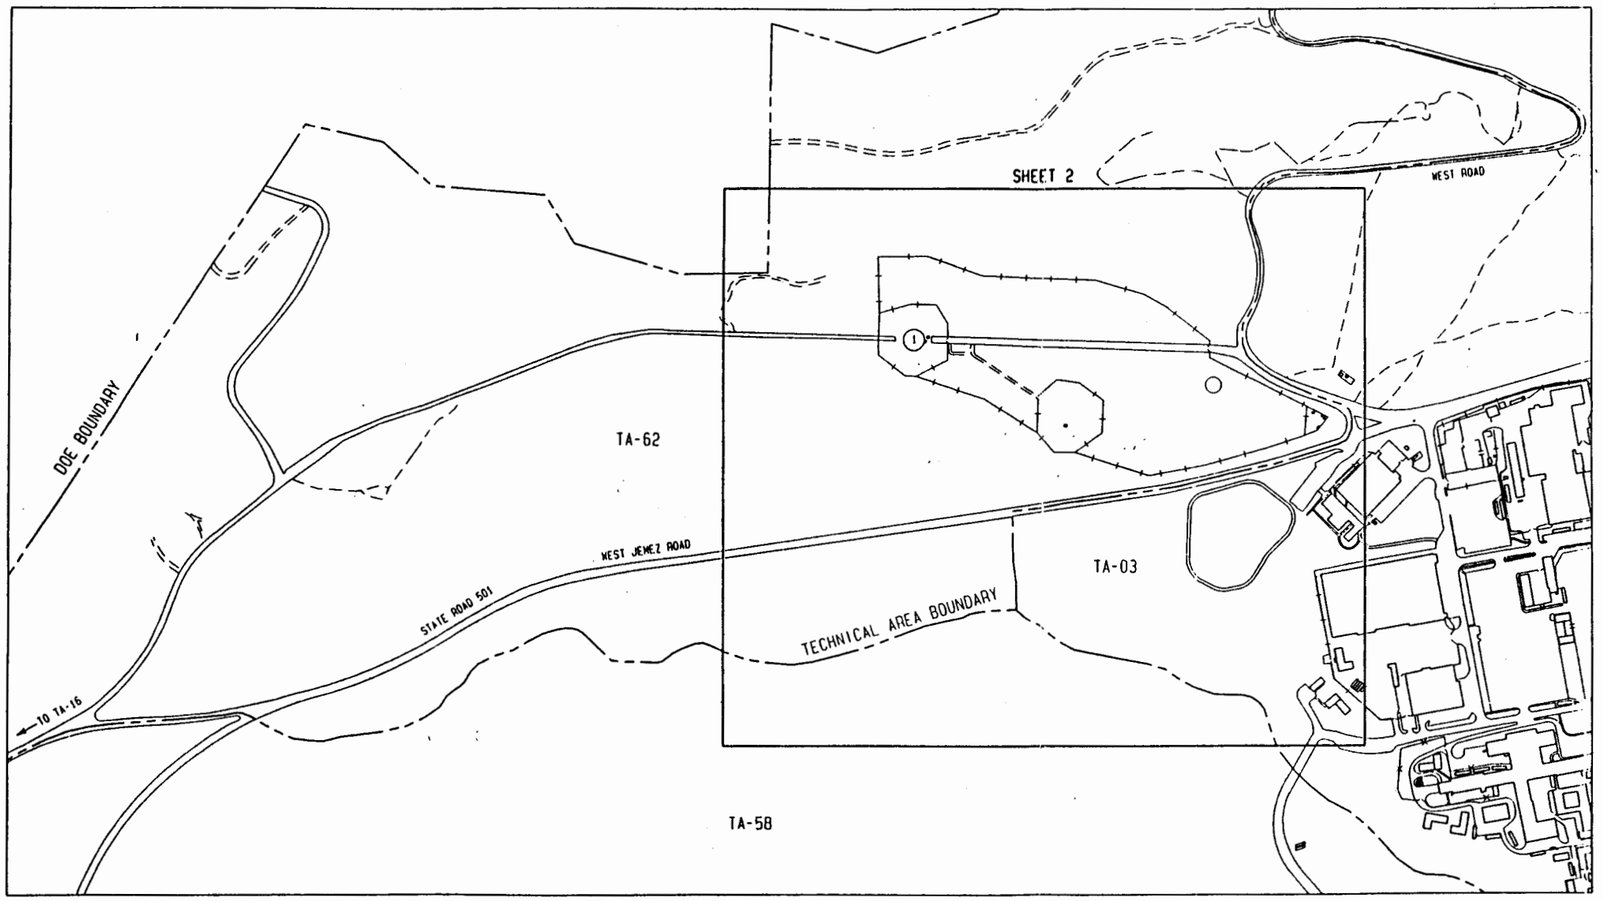

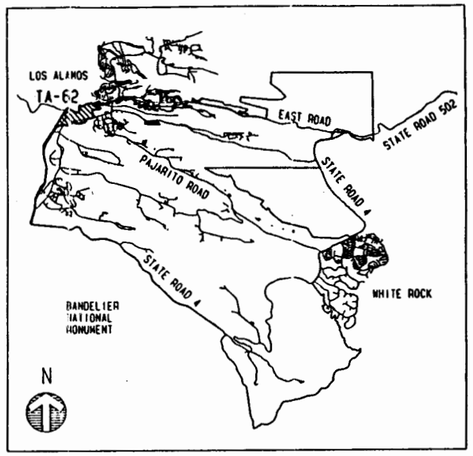

LOCATION PLAN

SCALE: NONE

TA-62 KEY MAP

SCALE: 1:3000

250 0 250 500

FEET

N

NO	DATE	CLASS REV	REVISIONS	DWN	VER	CHKD	REL	SUB	REC	APP

JOHNSON CONTROLS WORLD SERVICES INC.

AS-BUILT STRUCTURE LOCATION MAPS

TA-62

NORTHWEST SITE

DRAWN	J. CATA
VERIFIED	J. CATA
CHECKED	H. SALAZAR
RELEASED	H. SALAZAR
DATE	08-31-94

SUBMITTED JERRY FORT

RECOMMENDED BRYAN COWER

APPROVED ROBERT PROMMEL

Los Alamos — Los Alamos National Laboratory, Los Alamos, New Mexico 87545

SHEET 1 OF 2

CLASSIFICATION U — REVIEWER H. SALAZAR — DATE 8/31/94

PROJECT ID 11952 — DRAWING NO AB48 — REV

JCI NO 91-020

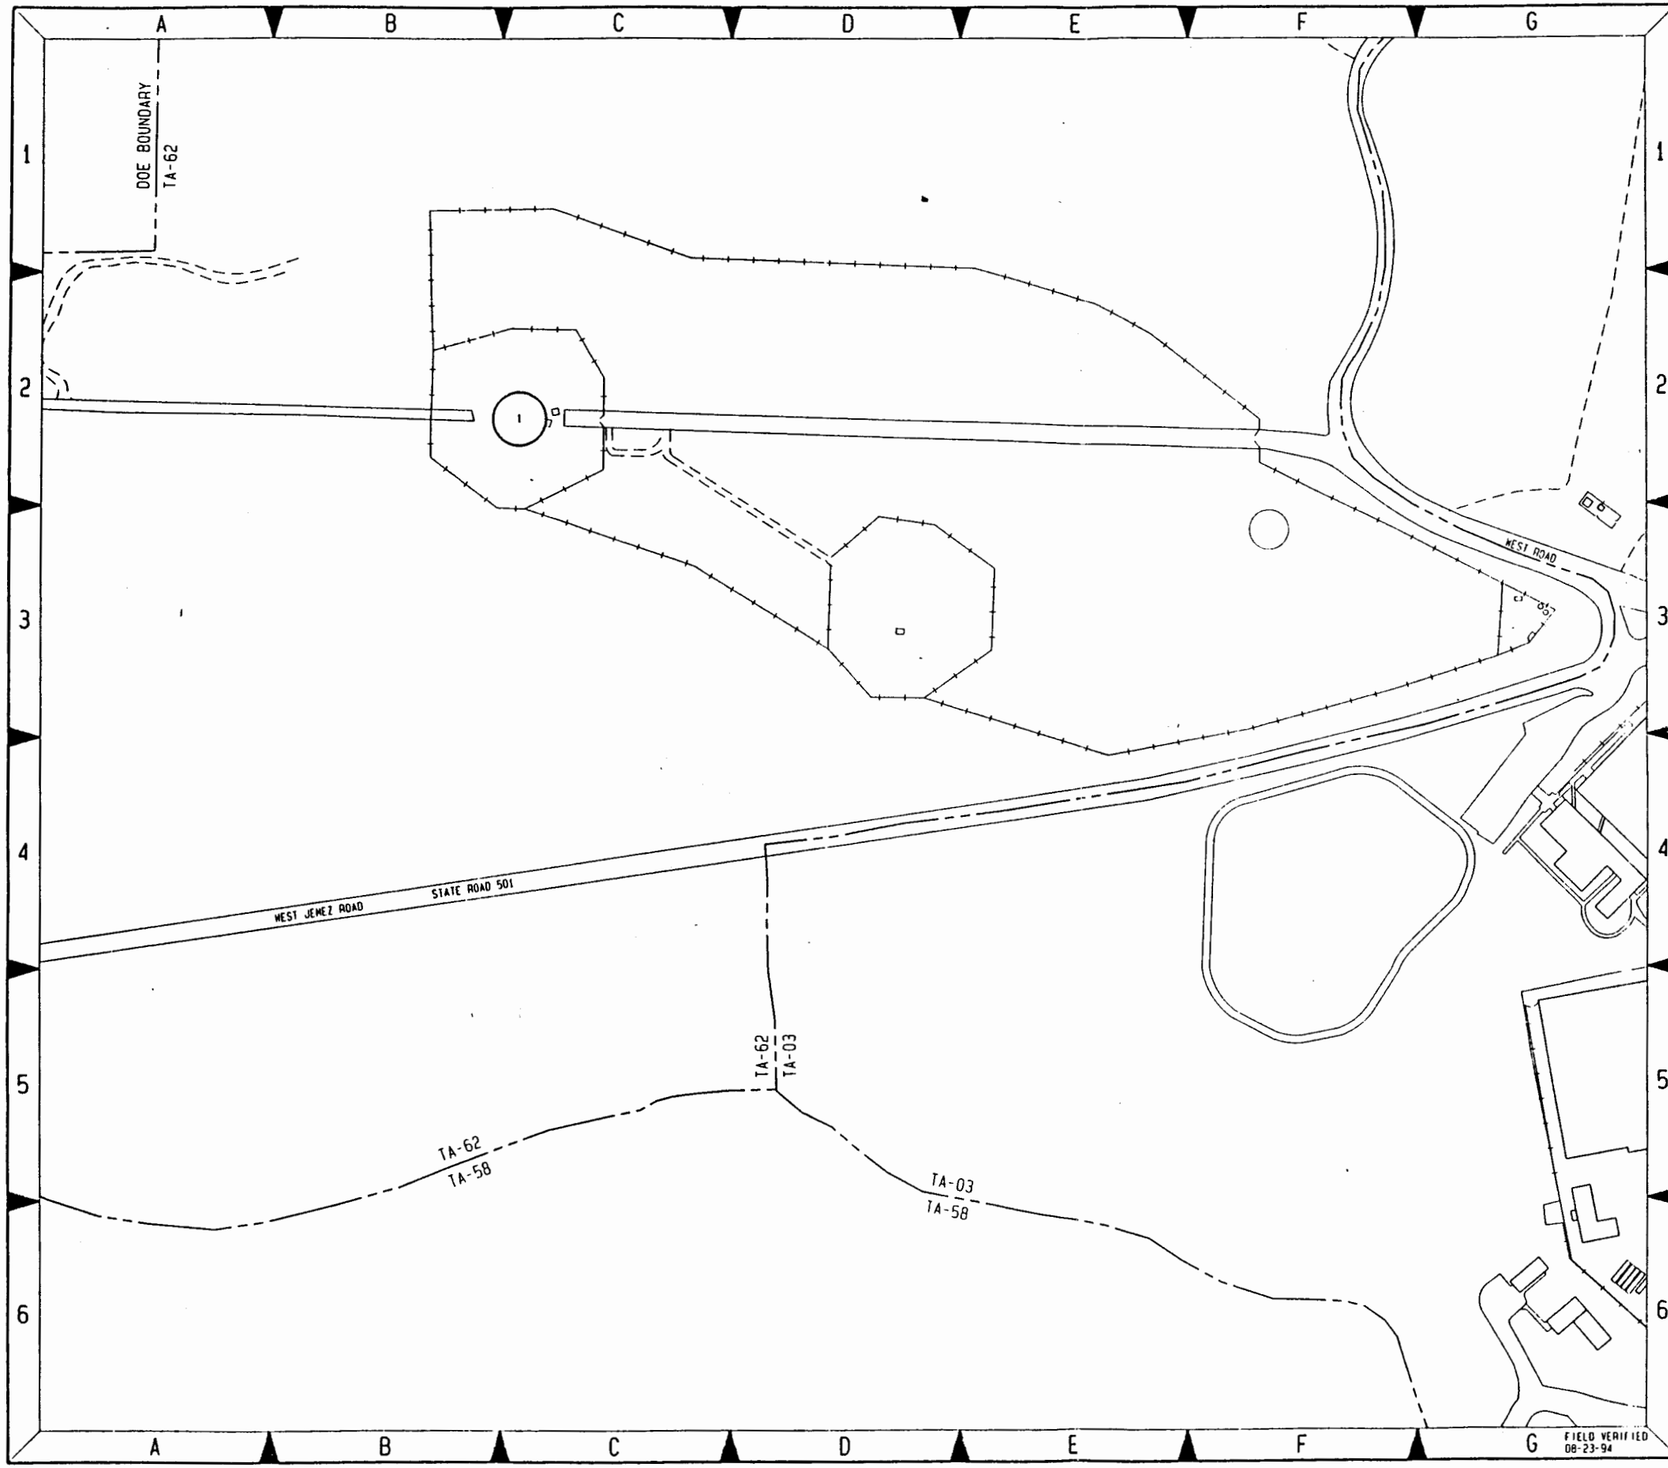

STRUCTURE LOCATION INDEX

STRUCTURE TA-NUMBER	STRUCTURE DESIGNATION	STRUCTURE NOMENCLATURE	STRUCTURE LOCATOR SHEET NO.	STRUCTURE LOCATOR MAP KEY
62-1	62-1	WATER TANK	2	C-2

N

SCALE: 1:1200

100 0 100 200

FEET

NO	DATE	CLASS REV	REVISIONS	DWN	VER	CHKD	REL	SUB	REC	APP

JOHNSON CONTROLS WORLD SERVICES INC.

AS-BUILT STRUCTURE LOCATION MAPS

TA-62

NORTHWEST SITE

DRAWN	J. CATA
VERIFIED	J. CATA
CHECKED	H. SALAZAR
RELEASED	H. SALAZAR
DATE	08-31-94

SUBMITTED JERRY FORTE

RECOMMENDED BRYAN COMER

APPROVED ROBERT PROMMEL

Los Alamos — Los Alamos National Laboratory, Los Alamos, New Mexico 87545

SHEET 2 — 2 of 2

CLASSIFICATION U — REVIEWER H. SALAZAR — DATE

PROJECT ID 11952 — DRAWING NO AB48 — REV

JCI NO 91-020

STRUCTURE LOCATION MAPS

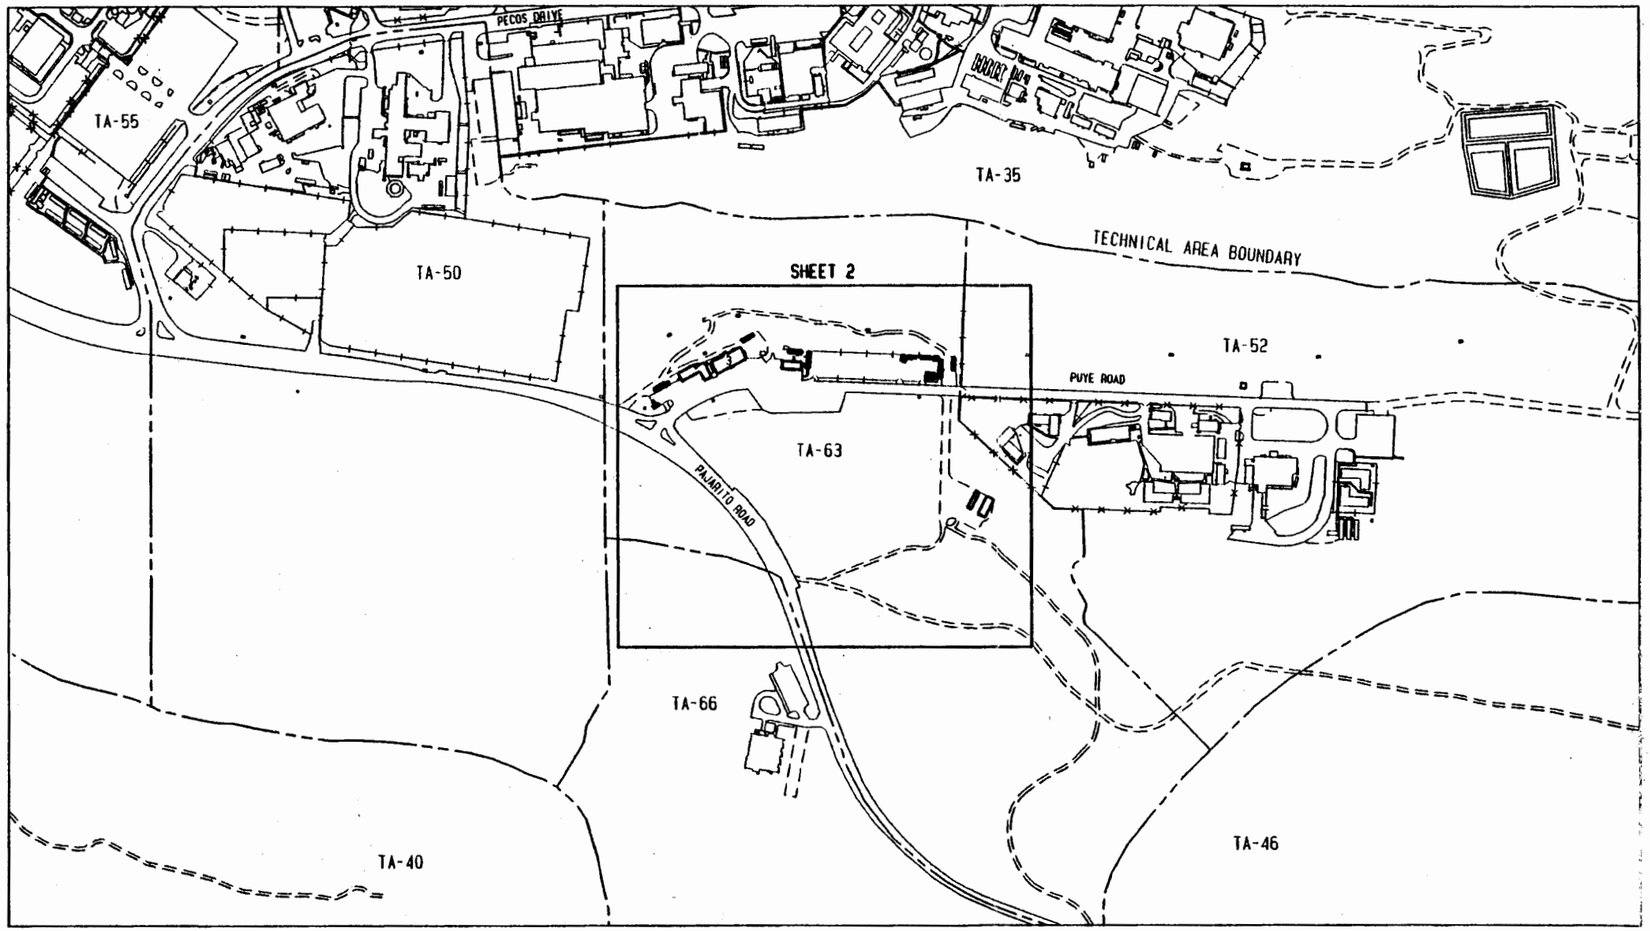

TA-63 KEY MAP

SCALE: 1:2400

200 0 200 400

FEET

N

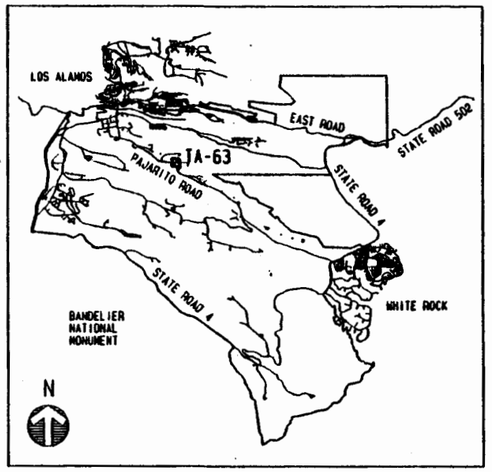

LOCATION PLAN

SCALE: NONE

NO	DATE	CLASS REV	REVISIONS	DWN	VER	CHKD	REL	SUB	REC	APP

JOHNSON CONTROLS WORLD SERVICES INC.

AS-BUILT STRUCTURE LOCATION MAPS

TA-63

PAJARITO SERVICE SITE

DRAWN	H. SALAZAR
VERIFIED	H. SALAZAR
CHECKED	G. BACA
RELEASED	H. SALAZAR
DATE	07-08-94

SUBMITTED JERRY FORTE — RECOMMENDED BRYAN COMER — APPROVED ROBERT PROMMEL

Los Alamos — Los Alamos National Laboratory, Los Alamos, New Mexico 87545

SHEET 1 OF 2

CLASSIFICATION U — REVIEWER H. SALAZAR — DATE 7/29/94

PROJECT ID 11952 — DRAWING NO AB49 — REV

JC: NO 91-020

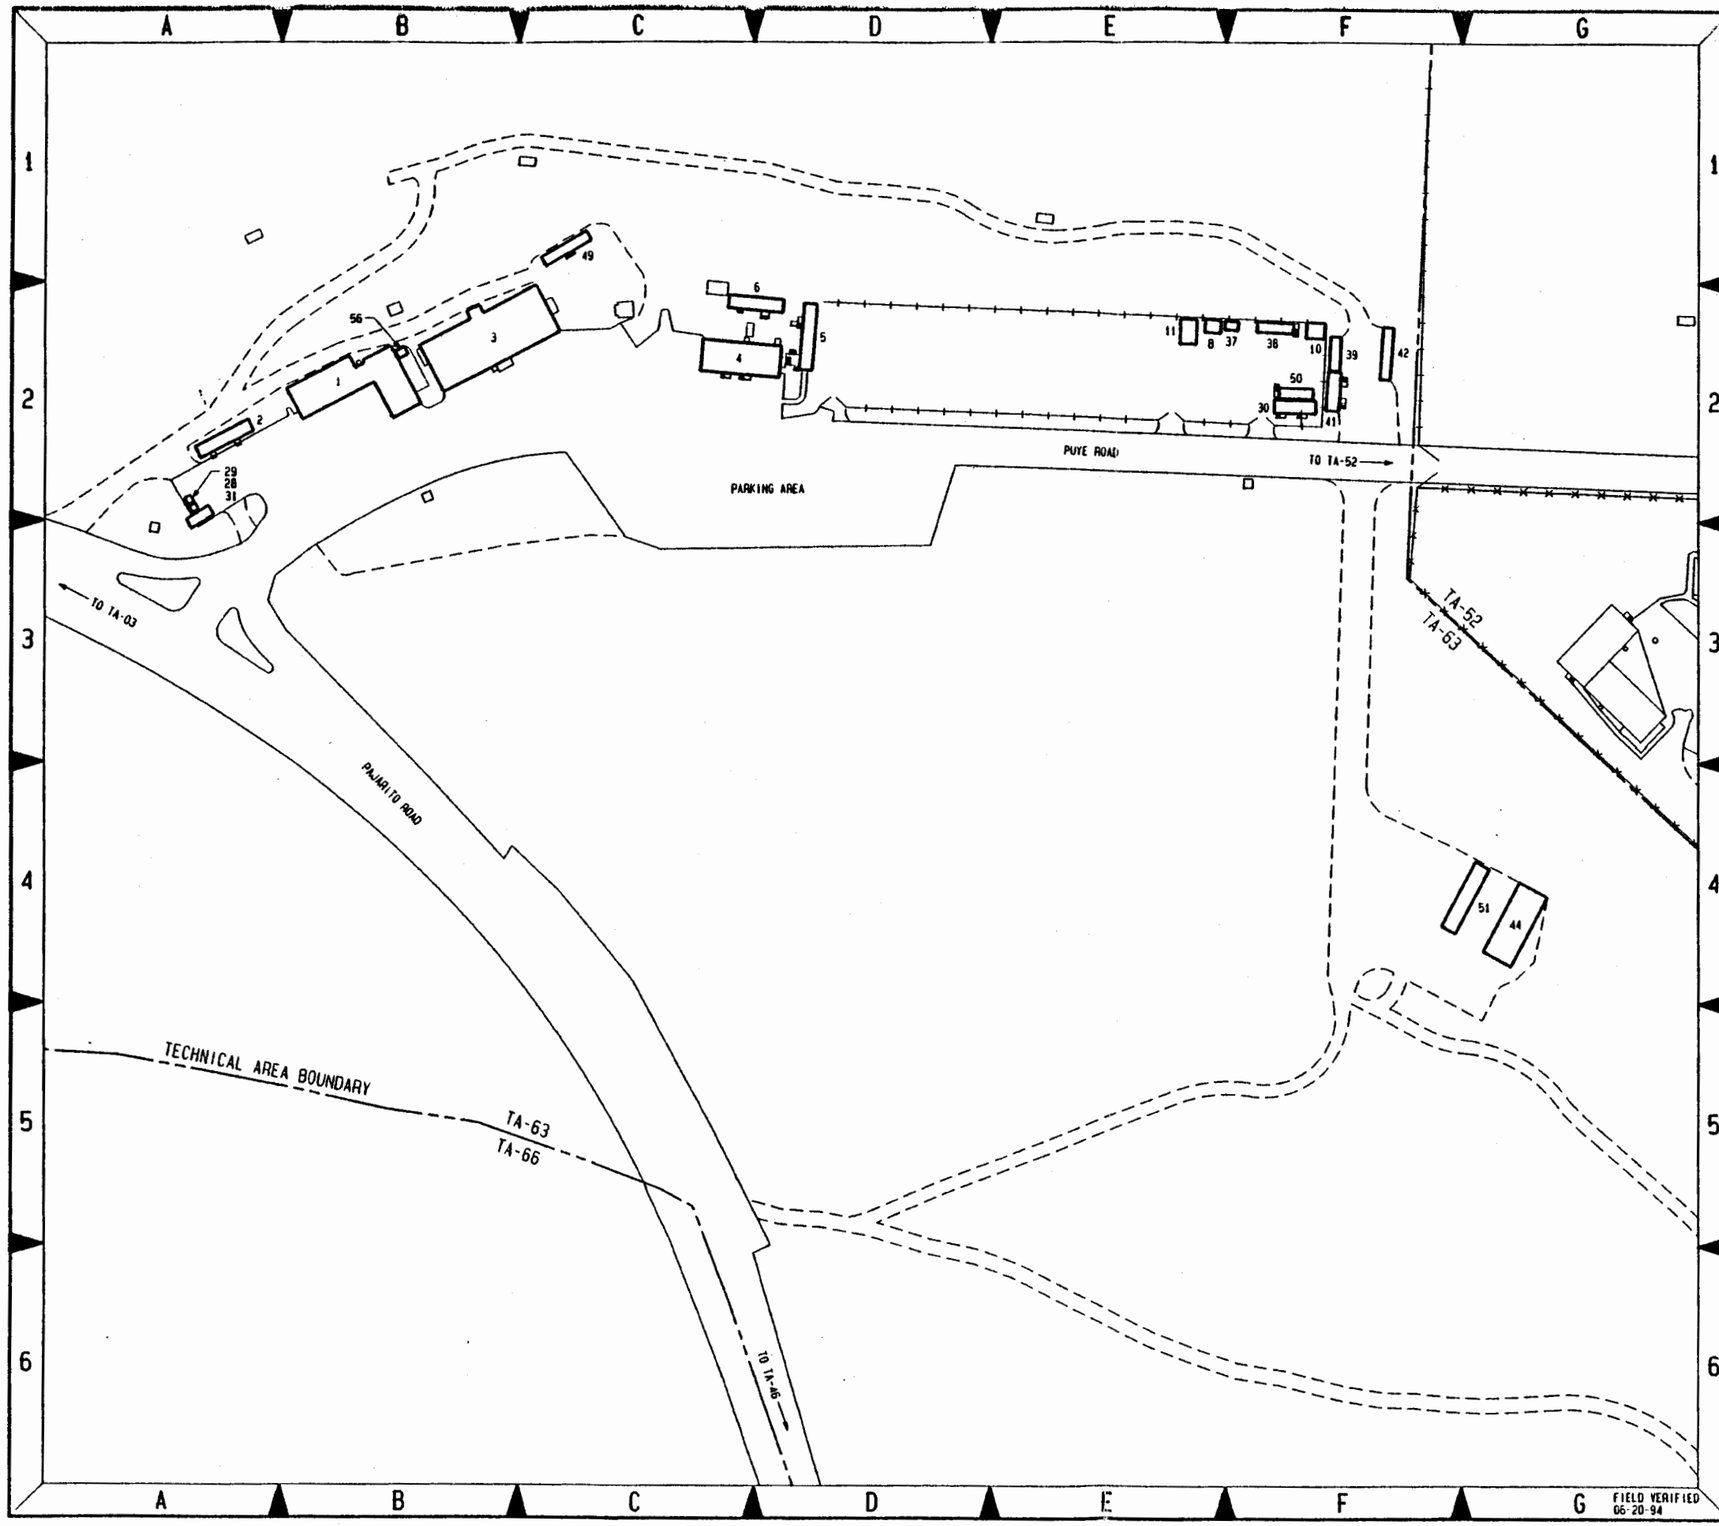

STRUCTURE LOCATION INDEX

STRUCTURE TA-NUMBER	STRUCTURE DESIGNATION	STRUCTURE NOMENCLATURE	STRUCTURE LOCATOR SHEET NO.	STRUCTURE LOCATOR MAP KEY
63-1	63-1	FSS-9 SECTION OFFICE	2	B-2
63-2	63-2	TRAILER, OFFICE	2	A-2
63-3	63-3	CRAFTS SHOP	2	B-2
63-4	63-4	TRAILER, OFFICE	2	C-2
63-5	63-5	TRAILER, OFFICE	2	D-2
63-6	63-6	TRAILER, OFFICE	2	D-2
63-8	63-8	PLYWOOD SHED	2	E-2
63-10	63-10	PLYWOOD SHED	2	F-2
63-11	63-11	METAL SHED	2	E-2
63-28	63-28	TRANSPORTAINER	2	A-2
63-29	63-29	TRANSPORTAINER	2	A-2
63-30	63-30	TRAILER	2	F-2
63-31	63-31	TRANSPORTAINER	2	A-2
63-37	63-37	METAL SHED	2	F-2
63-38	63-38	STORAGE VAN	2	F-2
63-39	63-39	STORAGE VAN	2	F-2
63-41	63-41	TRAILER	2	F-2
63-42	63-42	TRANSPORTAINER	2	F-2
63-44	63-44	TRAILER, OFFICE	2	G-4
63-49	63-49	TRANSPORTAINER	2	C-1
63-50	63-50	STORAGE VAN	2	F-2
63-51	63-51	TRAILER, OFFICE	2	G-4
63-56	63-56	TRANSPORTAINER	2	B-2

N

SCALE: 1:600

50 0 50 100

FEET

NO	DATE	CLASS REV	REVISIONS	DWN	VER	CHKD	REL	SUB	REC	APP

JOHNSON CONTROLS WORLD SERVICES INC.

AS-BUILT STRUCTURE LOCATION MAPS

TA-63

PAJARITO SERVICE SITE

DRAWN	H. SALAZAR
VERIFIED	H. SALAZAR
CHECKED	D. BACA
RELEASED	H. SALAZAR
DATE	07-08-94

SUBMITTED JERRY FORTE — RECOMMENDED BRYAN COWER — APPROVED ROBERT PROMMEL

Los Alamos — Los Alamos National Laboratory, Los Alamos, New Mexico 87545

SHEET 2 OF 2

CLASSIFICATION U — REVIEWER H. SALAZAR — DATE 7/08/94

PROJECT ID 11952 — DRAWING NO. AB49 — REV

JCI NO 91-020

TA-64

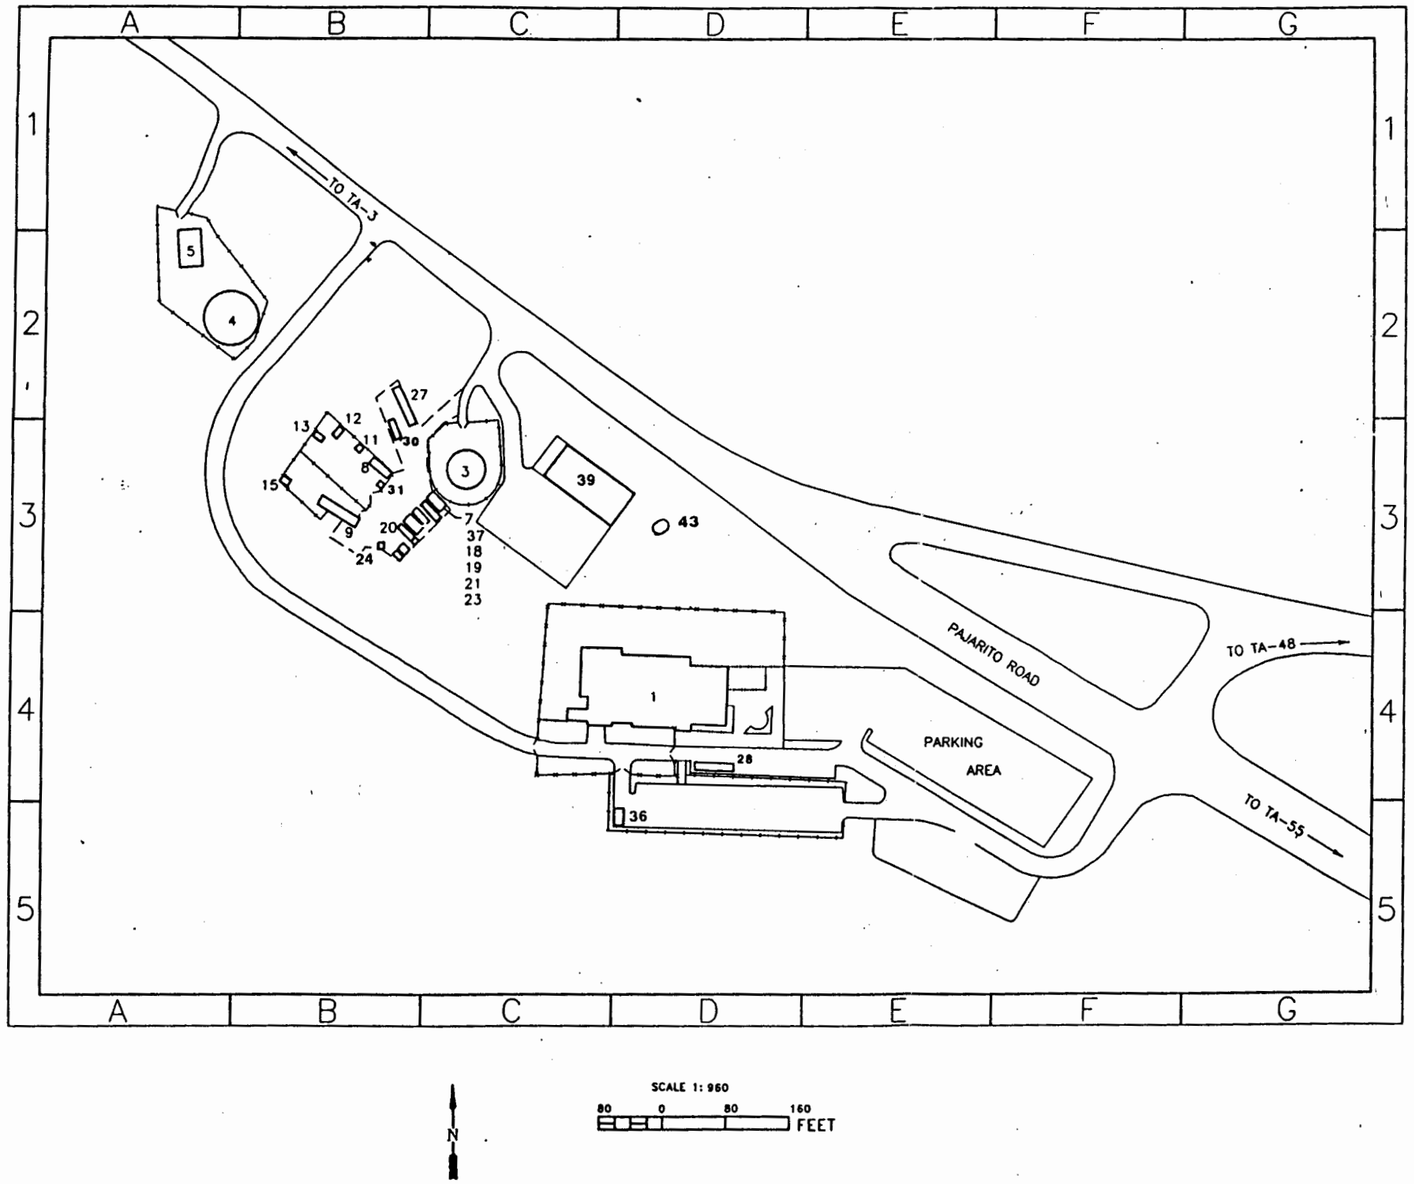

STRUCTURE TA-NUMBER	STRUCTURE DESIGNATION	STRUCTURE NOMENCLATURE	STRUCTURE LOCATOR SHEET NO.	STRUCTURE LOCATOR MAP KEY
64-1	64-1	CENTRAL GUARD FACILITY	1	D-4
64-3	64-3	WATER TANK	1	C-3
64-4	64-4	WATER TANK	1	A-2
64-5	64-5	BOOSTER STATION #3	1	A-2
64-7	64-7	SHED	1	C-3
64-8	64-8	TRAILER, STORAGE	1	B-3
64-9	64-9	TRAILER, OFFICE	1	B-3
64-11	64-11	TRANSPORTAINER	1	B-3
64-12	64-12	MILITARY SHELTER	1	B-3
64-13	64-13	MILITARY SHELTER	1	B-3
64-15	64-15	MILTARY SHELTER	1	B-3
64-18	64-18	TRANSPORTAINER	1	B-3
64-19	64-19	STORAGE SHED	1	B-3
64-20	64-20	TRANSPORTAINER	1	B-3
64-21	64-21	TRANSPORTAINER	1	B-3
64-23	64-23	STORAGE SHED	1	B-3
64-24	64-24	TRANSPORTAINER	1	B-3
64-27	64-27	TRAILER	1	B-2
64-28	64-28	TRAILER	1	D-4
64-30	64-30	STORAGE TRAILER	1	B-3
64-31	64-31	STORAGE SHED	1	B-3
64-36	64-36	SHED	1	D-5
64-37	64-37	SHED	1	C-3
64-39	64-39	HAZ-MAT RESPONSE TEAM FACILITY	1	C-3
64-43	64-43	HAZ-MAT TEMP. STORAGE DOME	1	D-3

SCALE 1: 960

80 0 80 160 FEET

N

LATEST DISTRIBUTION
31AUG94
EMERGENCY RESPONSE MAP
UPDATED DRAWING

NO.	DATE	CLASS REV.	REVISIONS	DWN	DES	CKD	REL	SUB	REC	APP

FACILITIES ENGINEERING DIVISION

STRUCTURE LOCATION MAP

TA-64

CENTRAL GUARD FACILITY

BLDG.

DRAWN	J. MORK
DESIGN	
CHECKED	B. COMER
RELEASED	B. COMER
DATE	03-29-91

SUBMITTED RECOMMENDED APPROVED

LOS ALAMOS — LOS ALAMOS NATIONAL LABORATORY, LOS ALAMOS, NEW MEXICO 87545

SHEET 1 OF 1

CLASSIFICATION U REVIEWER DATE 4-15-91

LAB JOB NO. DRAWING NO. ENG-R 5597 REV. 2

AUTOGIS

STRUCTURE LOCATION MAPS

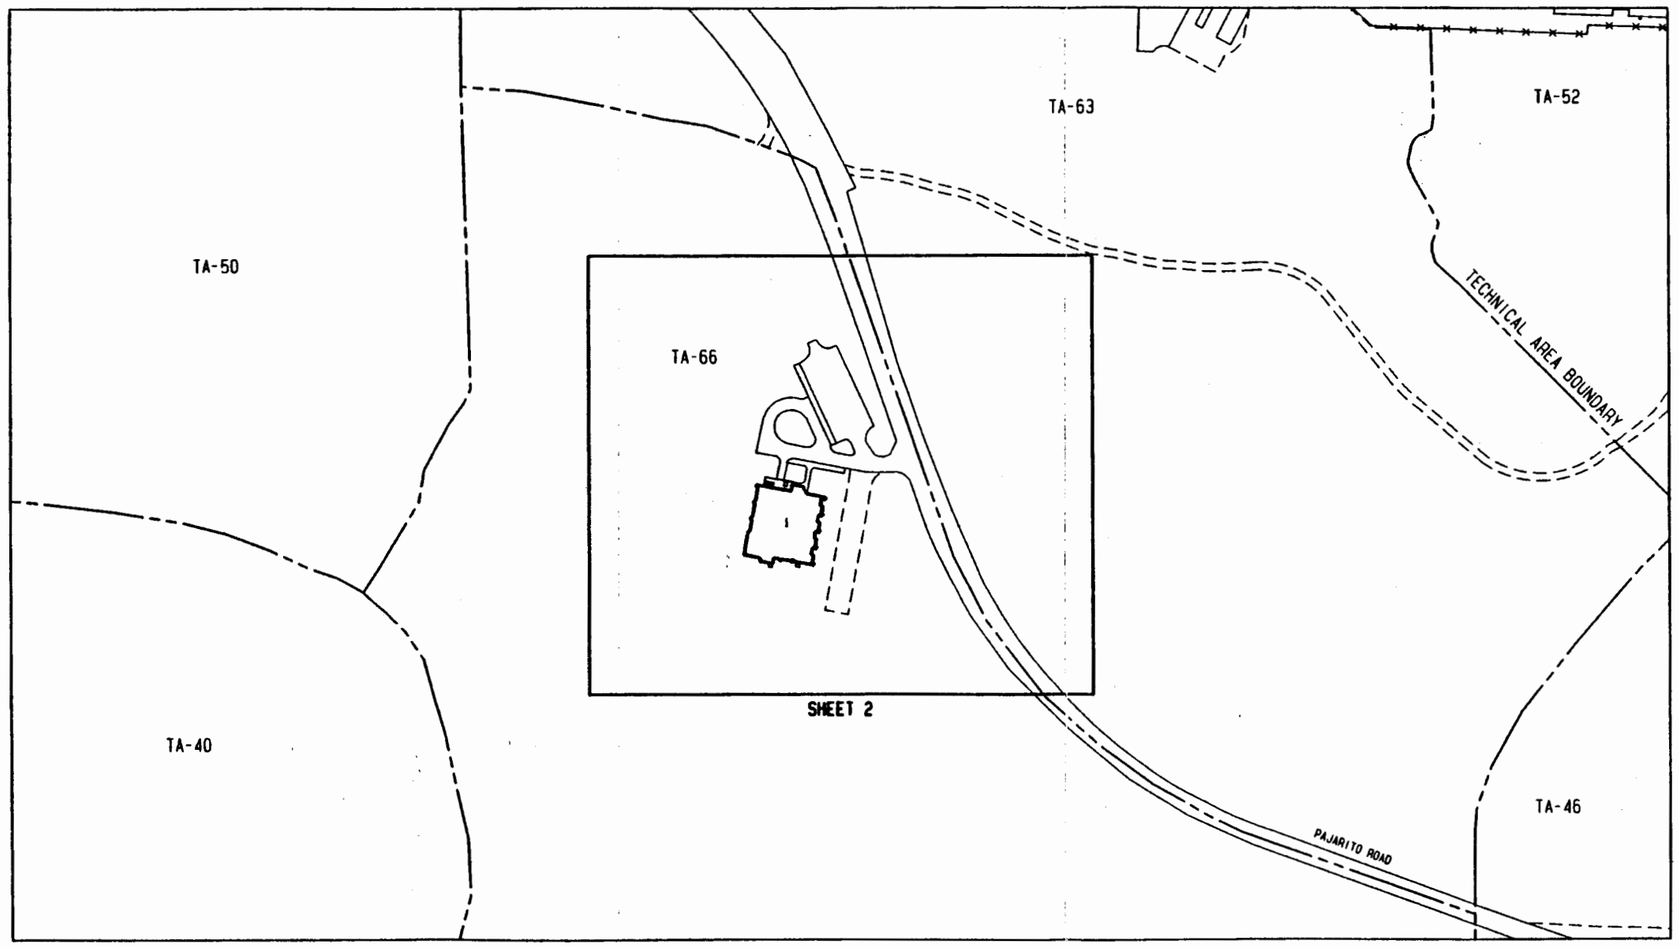

TA-66 KEY MAP

SCALE: 1:1200

100 0 100 200

FEET

N

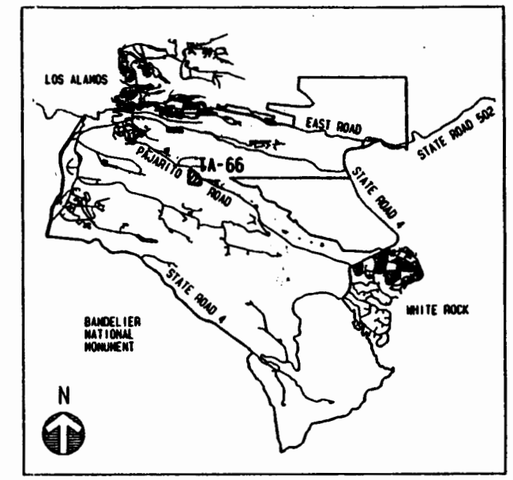

LOCATION PLAN

SCALE: NONE

NO	DATE	CLASS REV	REVISIONS	DWN	VER	CHKD	REL	SUB	REC	APP

JOHNSON CONTROLS WORLD SERVICES INC.

AS-BUILT STRUCTURE LOCATION MAPS

TA-66

CENTRAL TECHNICAL SUPPORT SITE

DRAWN	H. SALAZAR
VERIFIED	D. BACA / H. SALAZAR
CHECKED	J.
RELEASED	H. SALAZAR
DATE	06-30-94

SUBMITTED JERRY FORTE — RECOMMENDED BRYAN COWER — APPROVED ROBERT PROMMEL

Los Alamos — Los Alamos National Laboratory, Los Alamos, New Mexico 87545

SHEET 1 OF 2

CLASSIFICATION U — REVIEWER H. SALAZAR — DATE 6/27/94

PROJECT ID 11952 — DRAWING NO AB51 — REV

JCI NO 91-020

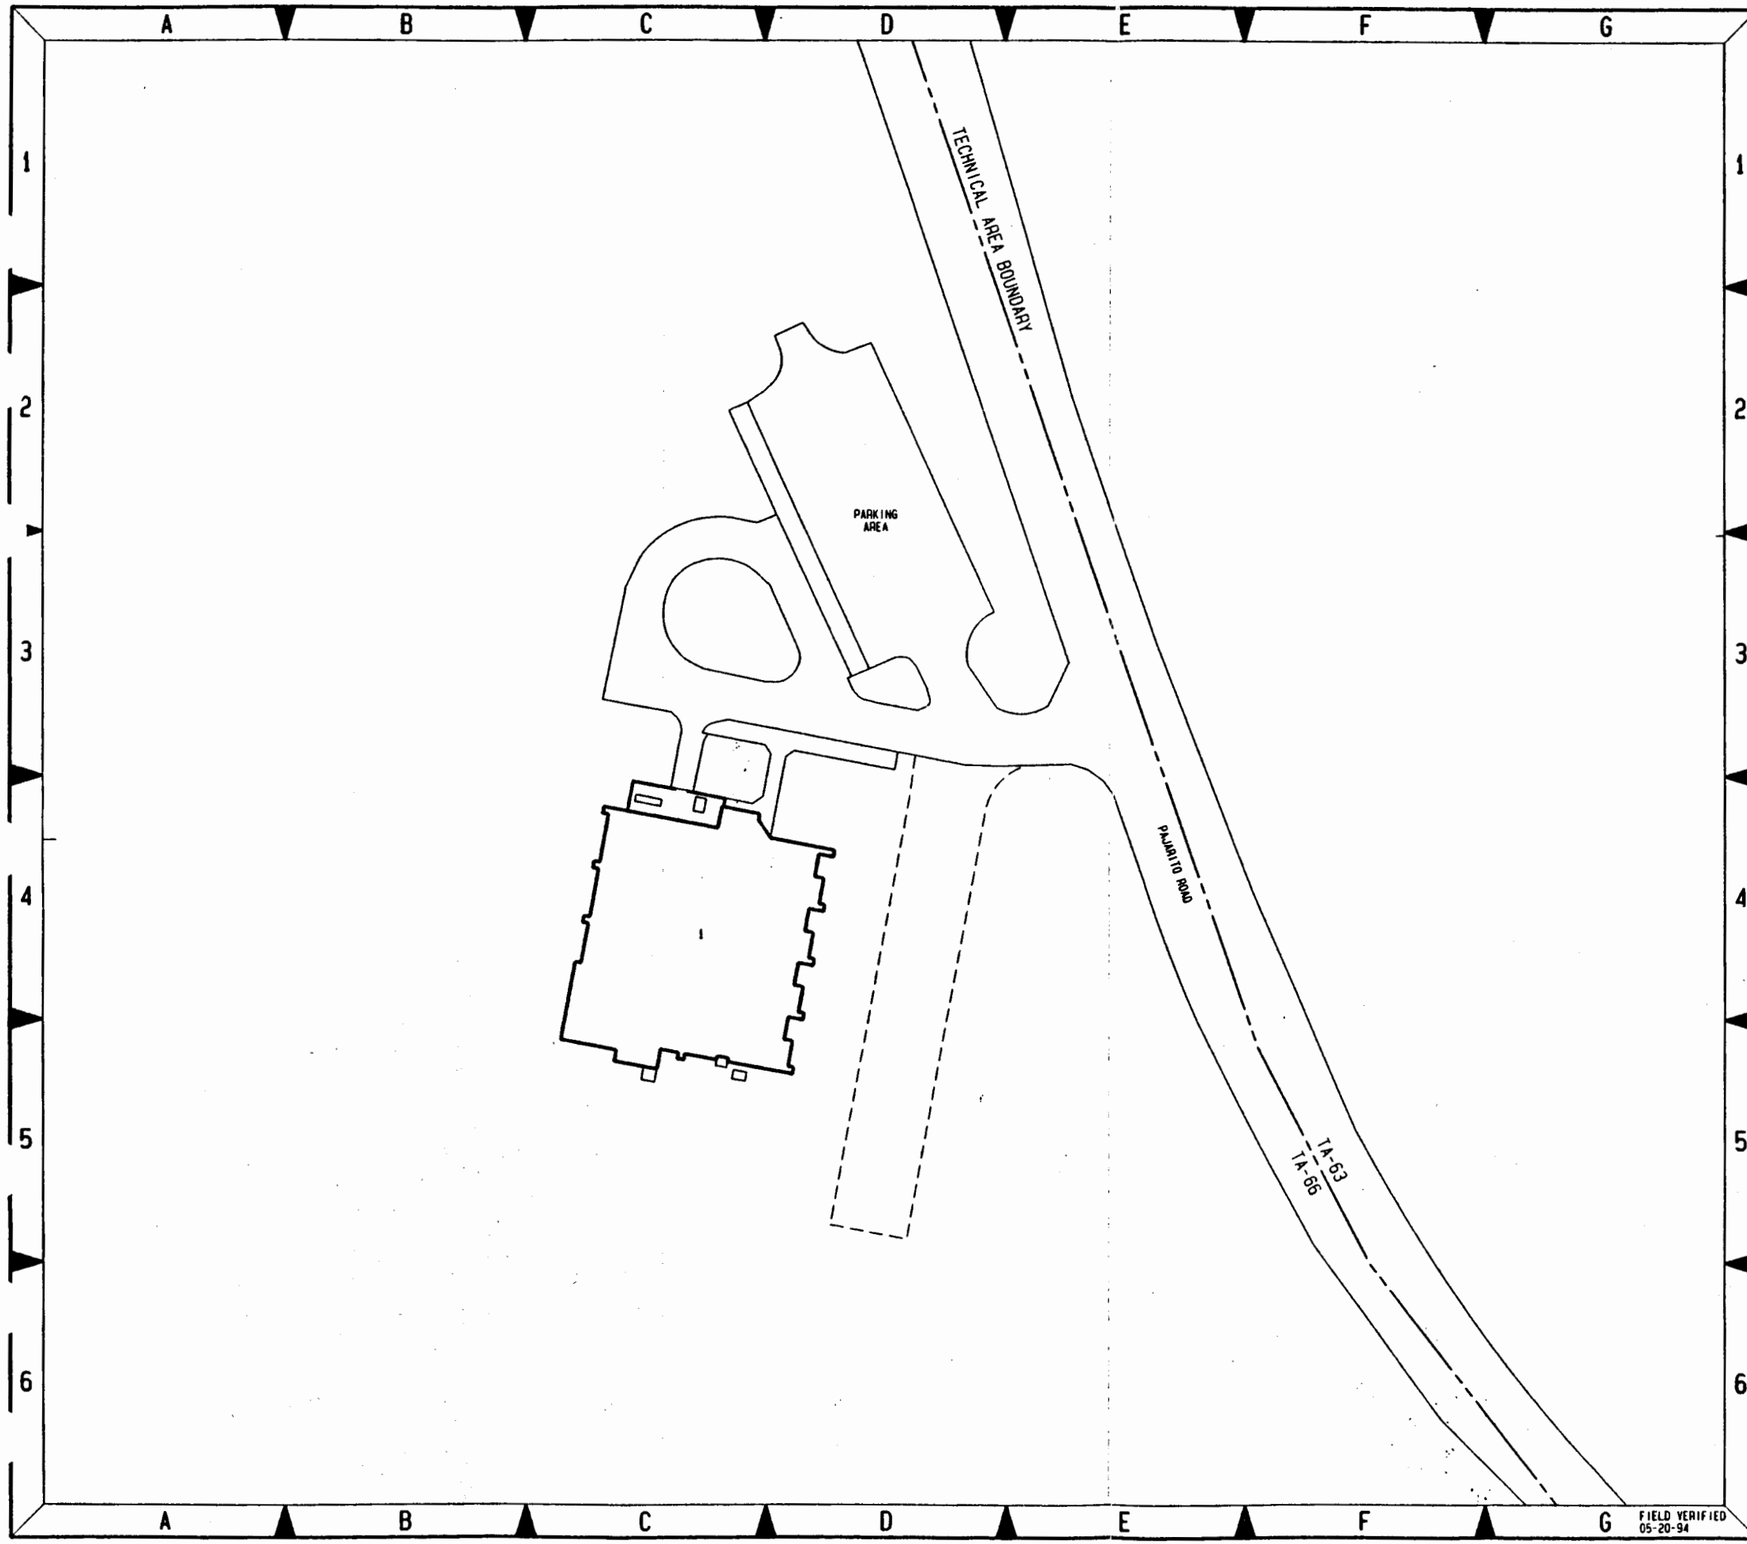

FIELD VERIFIED 05-20-94

STRUCTURE LOCATION INDEX

STRUCTURE TA-NUMBER	STRUCTURE DESIGNATION	STRUCTURE NOMENCLATURE	STRUCTURE LOCATOR SHEET NO.	STRUCTURE LOCATOR MAP KEY
66-1	66-1	ATAC OFFICE BUILDING	2	C-4

N

SCALE: 1:360

30 0 30 60

FEET

NO	DATE	CLASS REV	REVISIONS	DWN	VER	CHKD	REL	SUB	REC	APP

JOHNSON CONTROLS WORLD SERVICES INC.

AS-BUILT STRUCTURE LOCATION MAPS

TA-66

CENTRAL TECHNICAL SUPPORT SITE

DRAWN	H. SALAZAR
VERIFIED	D. BACA, H. SALAZAR
CHECKED	J. [illegible]
RELEASED	H. SALAZAR
DATE	06-30-94

SUBMITTED JERRY FORTE — RECOMMENDED BRYAN COHEN — APPROVED ROBERT PROMMEL

Los Alamos — Los Alamos National Laboratory, Los Alamos, New Mexico 87545

SHEET 2 — 2 of 2

CLASSIFICATION U — REVIEWER H. SALAZAR — DATE 6/29/94

PROJECT ID	DRAWING NO	REV
11952	AB51	

JCI NO 91-020

TA-69

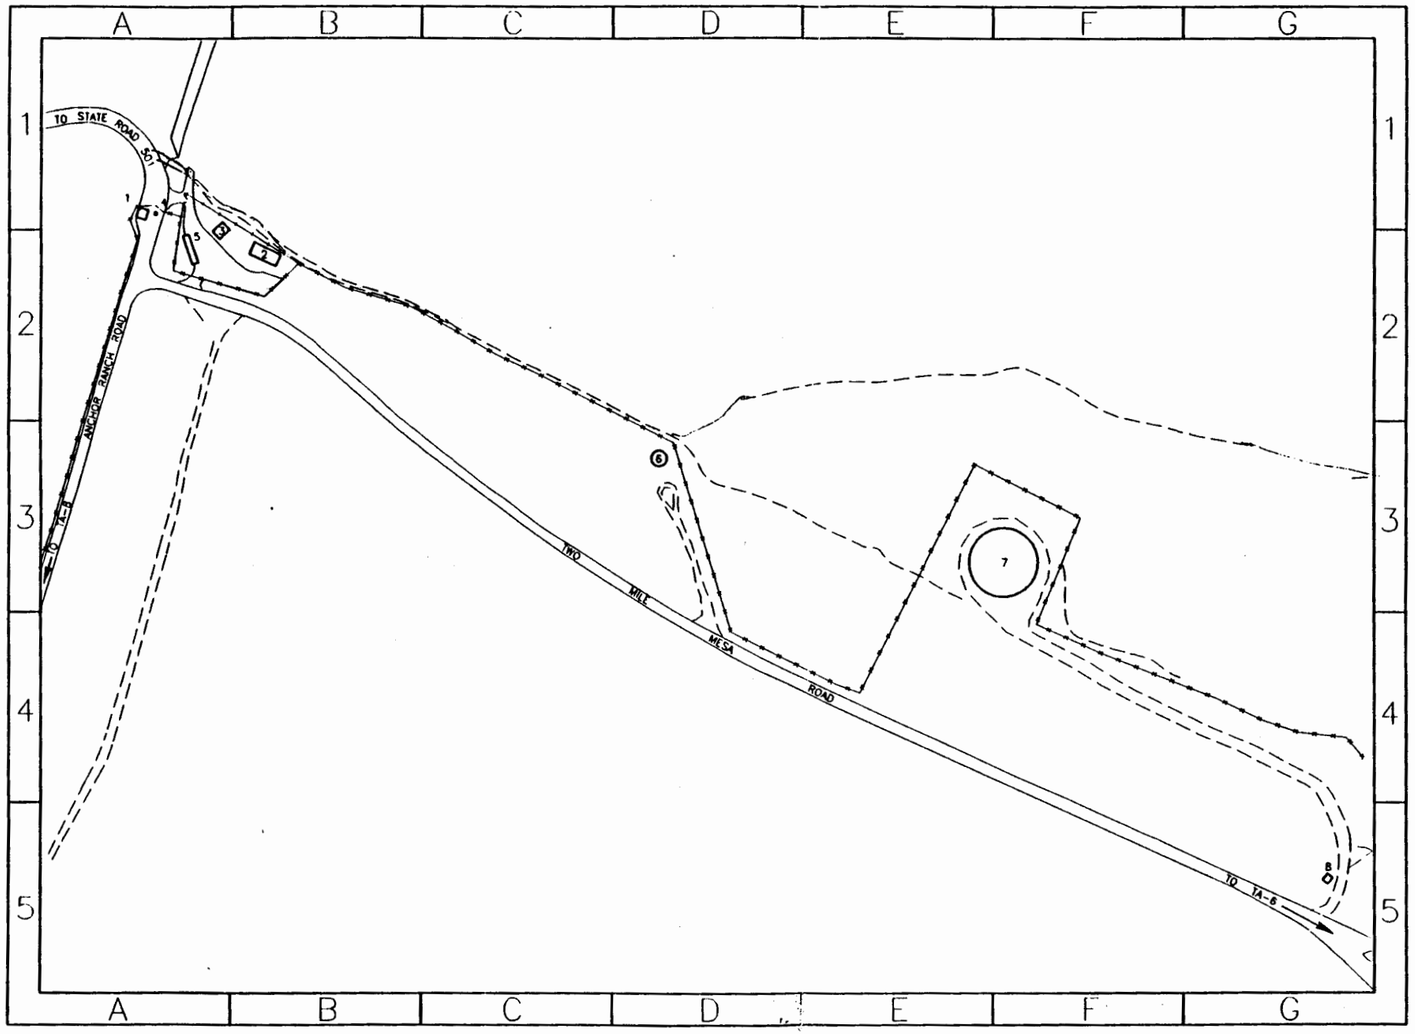

SCALE 1: 1580

130 0 130 260 FEET

N

STRUCTURE NUMBER INDEX

STRUCTURE TA-NUMBER	STRUCTURE DESIGNATION	STRUCTURE NOMENCLATURE	STRUCTURE LOCATOR SHEET NO.	STRUCTURE LOCATOR MAP KEY
69- 1	69- 1	GUARD HOUSE	1	A-1
69- 2	69- 2	TRAILER, OFFICE	1	B-2
69- 3	69- 3	INCINERATOR BUILDING	1	A-1
69- 4	69- 4	GUARD HOUSE	1	A-1
69- 5	69- 5	TRAILER, OFFICE	1	A-2
69- 6	69- 6	WATER TANK	1	D-3
69- 7	69- 7	WATER TANK	1	F-3
69- 8	69- 8	BACKFLOW PREVENTER BLDG.	1	G-5

NO.	DATE	CLASS REV.	REVISIONS	DWN	DES	CKD	REL	SUB	REC	APP

FACILITIES ENGINEERING DIVISION

STRUCTURE LOCATION MAP
TA-69

BLDG.

DRAWN	C.SANDOVAL
DESIGN	
CHECKED	B. COMER
RELEASED	B. COMER
DATE	93-07-01

SUBMITTED | RECOMMENDED | APPROVED

LOS ALAMOS — LOS ALAMOS NATIONAL LABORATORY, LOS ALAMOS, NEW MEXICO 87545

SHEET 1 OF 1

CLASSIFICATION U REVIEWER DATE 4-15-91

LAB JOB NO. | DRAWING NO. ENG-R 7128 | REV. 1

AUTOGIS

TA-72

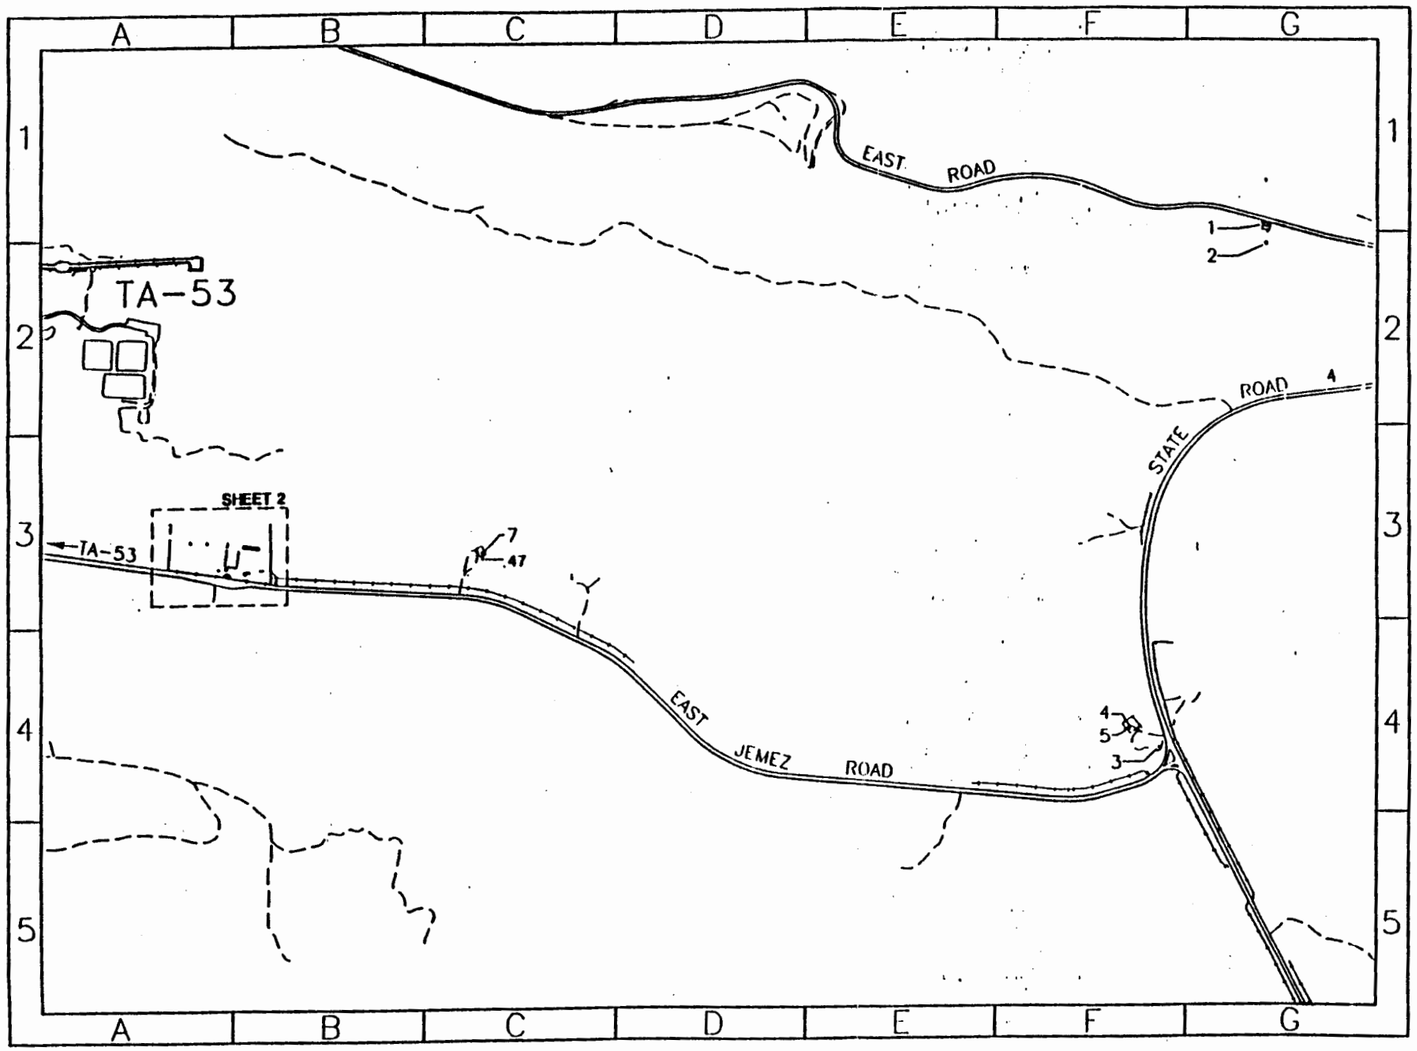

SCALE 1: 6000

500 0 500 1000 FEET

N

LATEST DISTRIBUTION
30SEPT92
EMERGENCY RESPONSE MAP
UPDATED DRAWING

STRUCTURE NUMBER INDEX

STRUCTURE TA-NUMBER	STRUCTURE DESIGNATION	STRUCTURE NOMENCLATURE	STRUCTURE LOCATOR SHEET NO.	STRUCTURE LOCATOR MAP KEY
72- 1	72- 1	LOS ALAMOS BOOSTER STA. #3	1	G-1
72- 2	72- 2	WATER TANK	1	G-1
72- 3	72- 3	WELL CHLORINATOR BLDG.	1	F-4
72- 4	72- 4	PAJARITO WELL #1	1	F-4
72- 5	72- 5	PAJARITO SAND TRAP	1	F-4
72- 7	72- 7	PAJARITO WELL #3	1	C-3
72- 8	72- 8	OFFICE BUILDING	2	D-4
72- 9	72- 9	RANGE HOUSE	2	E-4
72- 10	72- 10	SCORING AREA	2	E-4
72- 11	72- 11	FIRING STATION	2	E-3
72- 12	72- 12	WEAPONS CLEANING AREA	2	E-4
72- 13	72- 13	STORAGE BUILDING	2	D-4
72- 14	72- 14	STORAGE SHED	2	D-4
72- 15	72- 15	LOW HOUSE	2	C-2
72- 16	72- 16	HIGH HOUSE	2	B-2
72- 37	72- 37	TRANSPORTAINER	2	D-3
72- 38	72- 38	TRANSPORTAINER	2	E-2
72- 39	72- 39	ADMINISTRATION BLDG.	2	E-3
72- 40	72- 40	CANOPY	2	F-3
72- 41	72- 41	TOWER	2	F-3
72- 47	72- 47	WELL FLUORIDE BUILDING	1	C-3

NO.	DATE	CLASS. REV.	REVISIONS	DWN	DES	CKD	REL	SUB	REC	APP

FACILITIES ENGINEERING DIVISION

STRUCTURE LOCATION MAP
TA-72

DRAWN C.SANDOVAL
DESIGN
CHECKED B CONNER
RELEASED B CONNER
DATE 03-07-91

BLDG.

SUBMITTED | RECOMMENDED | APPROVED

LOS ALAMOS — LOS ALAMOS NATIONAL LABORATORY, LOS ALAMOS, NEW MEXICO 87545

SHEET 1 of 2

CLASSIFICATION U REVIEWER | DATE

LAB JOB NO.

DRAWING NO. ENG-R 7126

REV. 2

AUTOCAD

TA-72

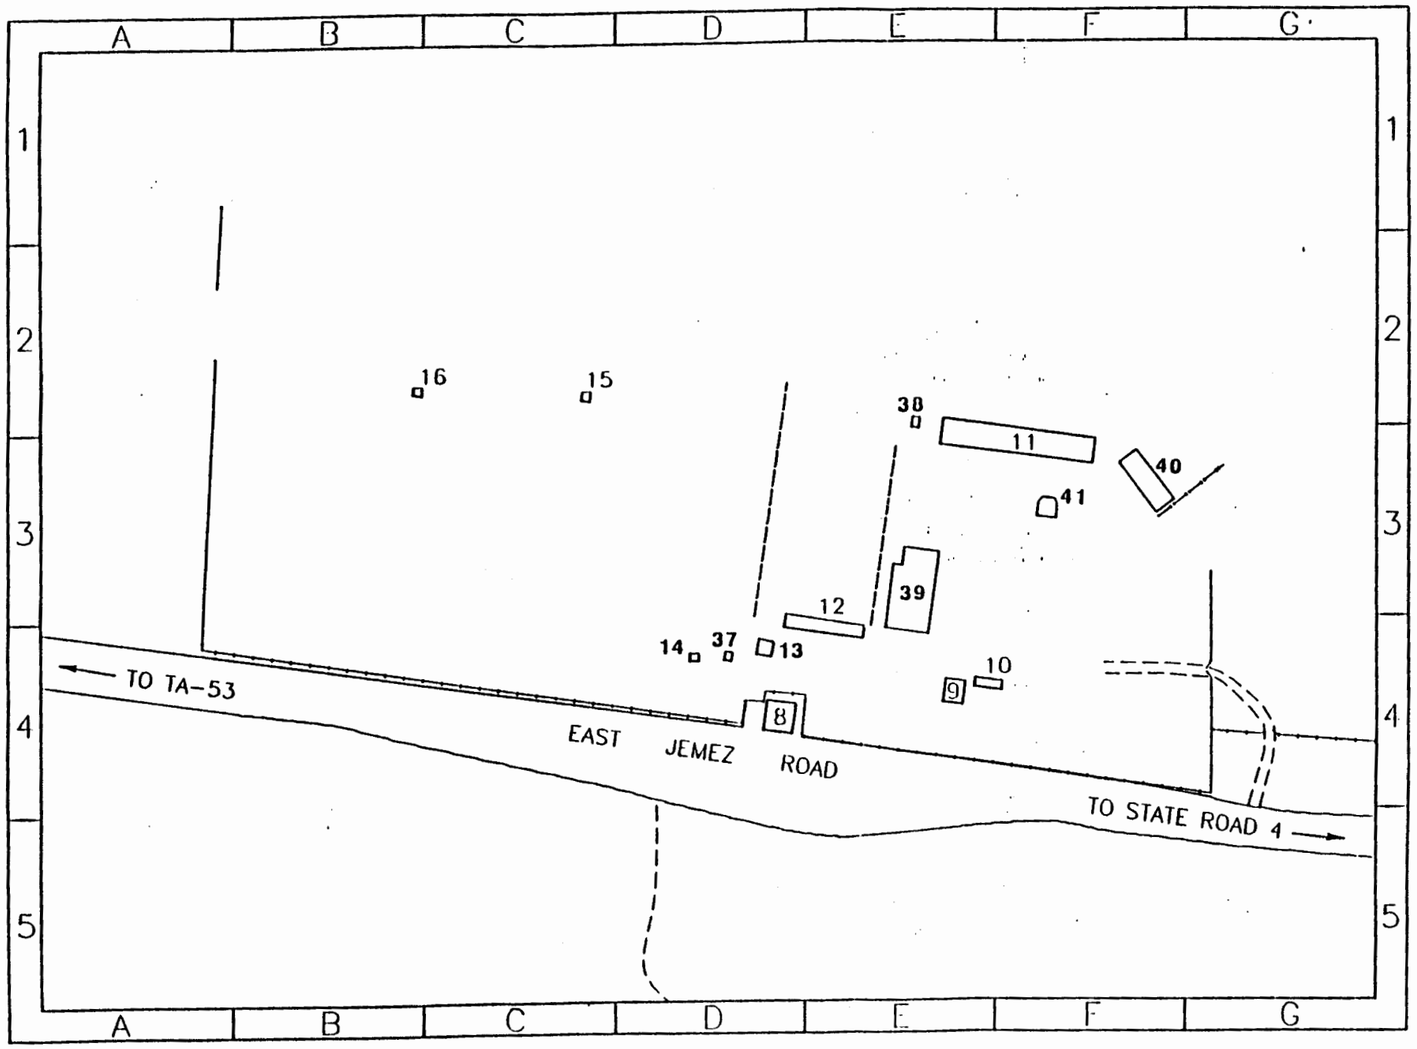

SCALE 1: 600

50 0 50 100 FEET

N

LATEST DISTRIBUTION
3 SEPT 92
EMERGENCY RESPONSE MAP
UPDATED DRAWING

NO	DATE	REV	REVISIONS	DWN	DES	CKD	REL	SUB	REC	APP

FACILITIES ENGINEERING DIVISION

STRUCTURE LOCATION MAP
TA-72

BLDG.

DRAWN	C. SANDOVAL
DESIGN	
CHECKED	B COKER
RELEASED	B COKER
DATE	03-07-91

SUBMITTED | RECOMMENDED | APPROVED

LOS ALAMOS — LOS ALAMOS NATIONAL LABORATORY, LOS ALAMOS, NEW MEXICO 87545

SHEET 2 OF 2

CLASSIFICATION U REVIEWER DATE

LAB JOB NO.

DRAWING NO. ENG-R 7126

REV 2

AUTOCIS

TA-73

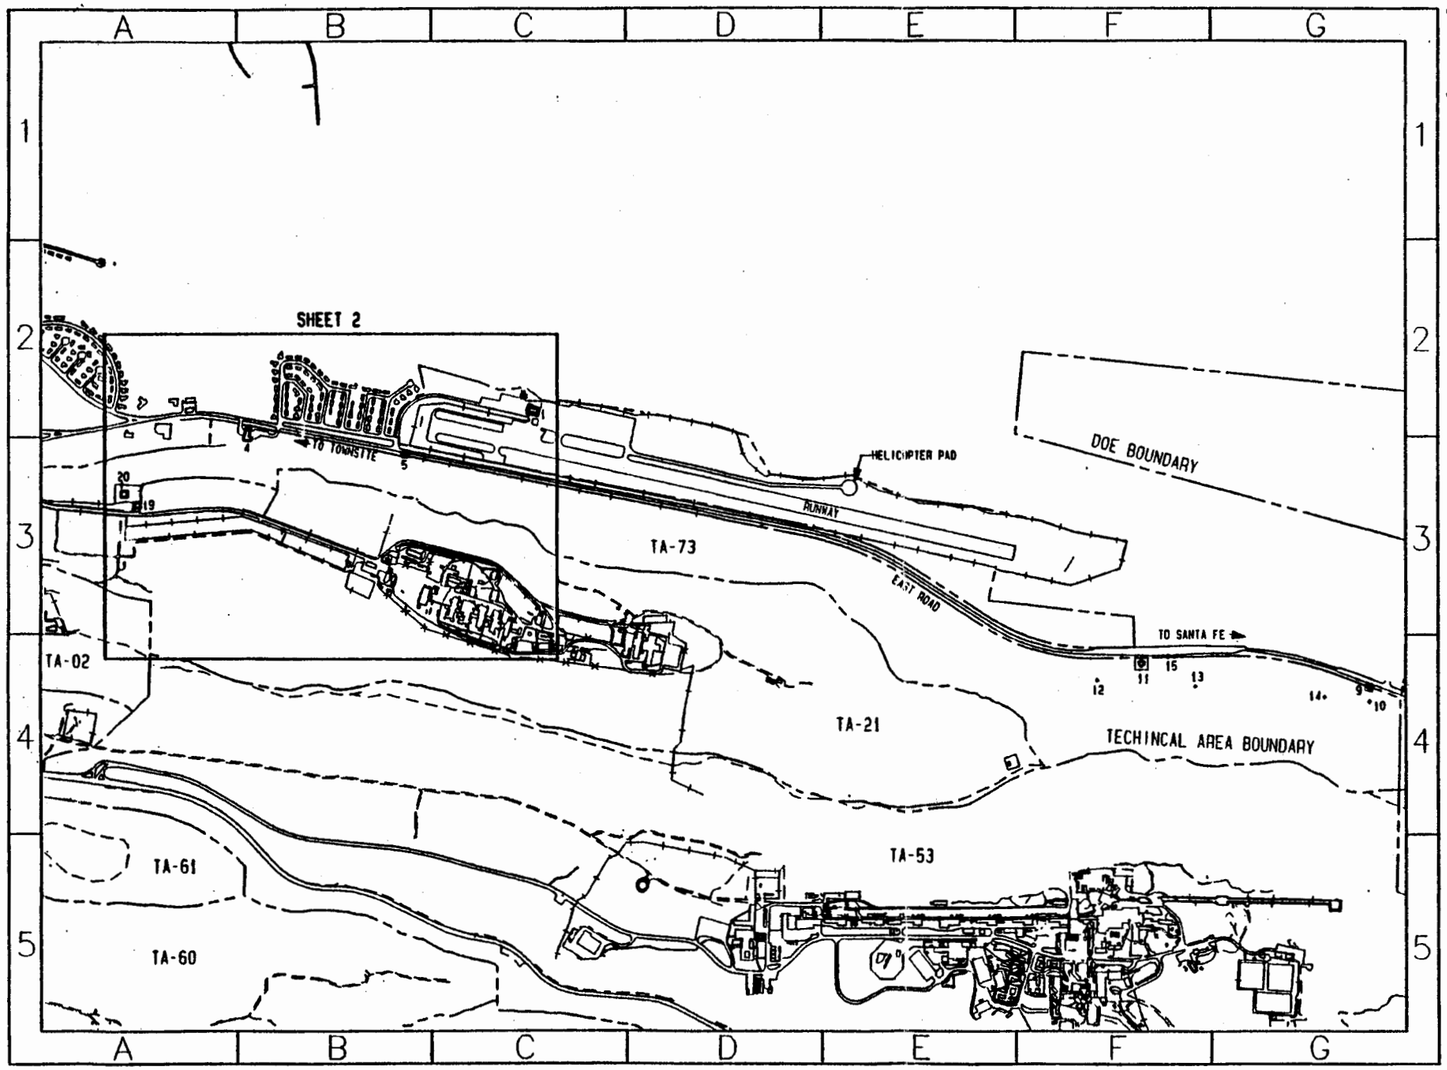

SCALE 1: 6300

525 0 525 1050 FEET

N

STRUCTURE NUMBER INDEX

STRUCTURE TA-NUMBER	STRUCTURE DESIGNATION	STRUCTURE NOMENCLATURE	STRUCTURE LOCATOR SHEET NO.	STRUCTURE LOCATOR MAP KEY
73-1	73-1	AIR TERMINAL FACILITY	2	G-2
73-2	73-2	STORAGE BUILDING	2	G-1
73-3	73-3	MORGAN SHED	2	G-2
73-4	73-4	AIRPORT FIRE STATION	2	A-2
73-5	73-5	EAST GAS METER STATION	2	A-5
73-9	73-9	BOOSTER STATION	1	G-4
73-10	73-10	WATER TANK	1	G-4
73-11	73-11	WATER TANK	1	F-4
73-12	73-12	SHED	1	F-4
73-13	73-13	SHED	1	F-4
73-14	73-14	SHED	1	G-4
73-15	73-15	WEATHER STATION	1	G-4
73-19	73-19	FIRE STATION #2	2	A-3
73-20	73-20	DRILL TOWER	2	A-3

LATEST DISTRIBUTION
15JULY94
EMERGENCY RESPONSE MAP
UPDATED DRAWING

NO.	DATE	CLASS REV.	REVISIONS	DWN	DES	CKD	REL	SUB	REC	APP

FACILITIES ENGINEERING DIVISION

STRUCTURE LOCATION MAP
TA-73
AIRPORT SITE

BLDG.

DRAWN	C.SANDOVAL
DESIGN	
CHECKED	B. COMER
RELEASED	B. COMER
DATE	03-07-91

SUBMITTED RECOMMENDED APPROVED

LOS ALAMOS — LOS ALAMOS NATIONAL LABORATORY, LOS ALAMOS, NEW MEXICO 87545

SHEET 1 of 2

CLASSIFICATION U REVIEWER DATE 4-15-91

LAB JOB NO. DRAWING NO. ENG-R 7125 REV. 2

AUTOCIS

TA-73

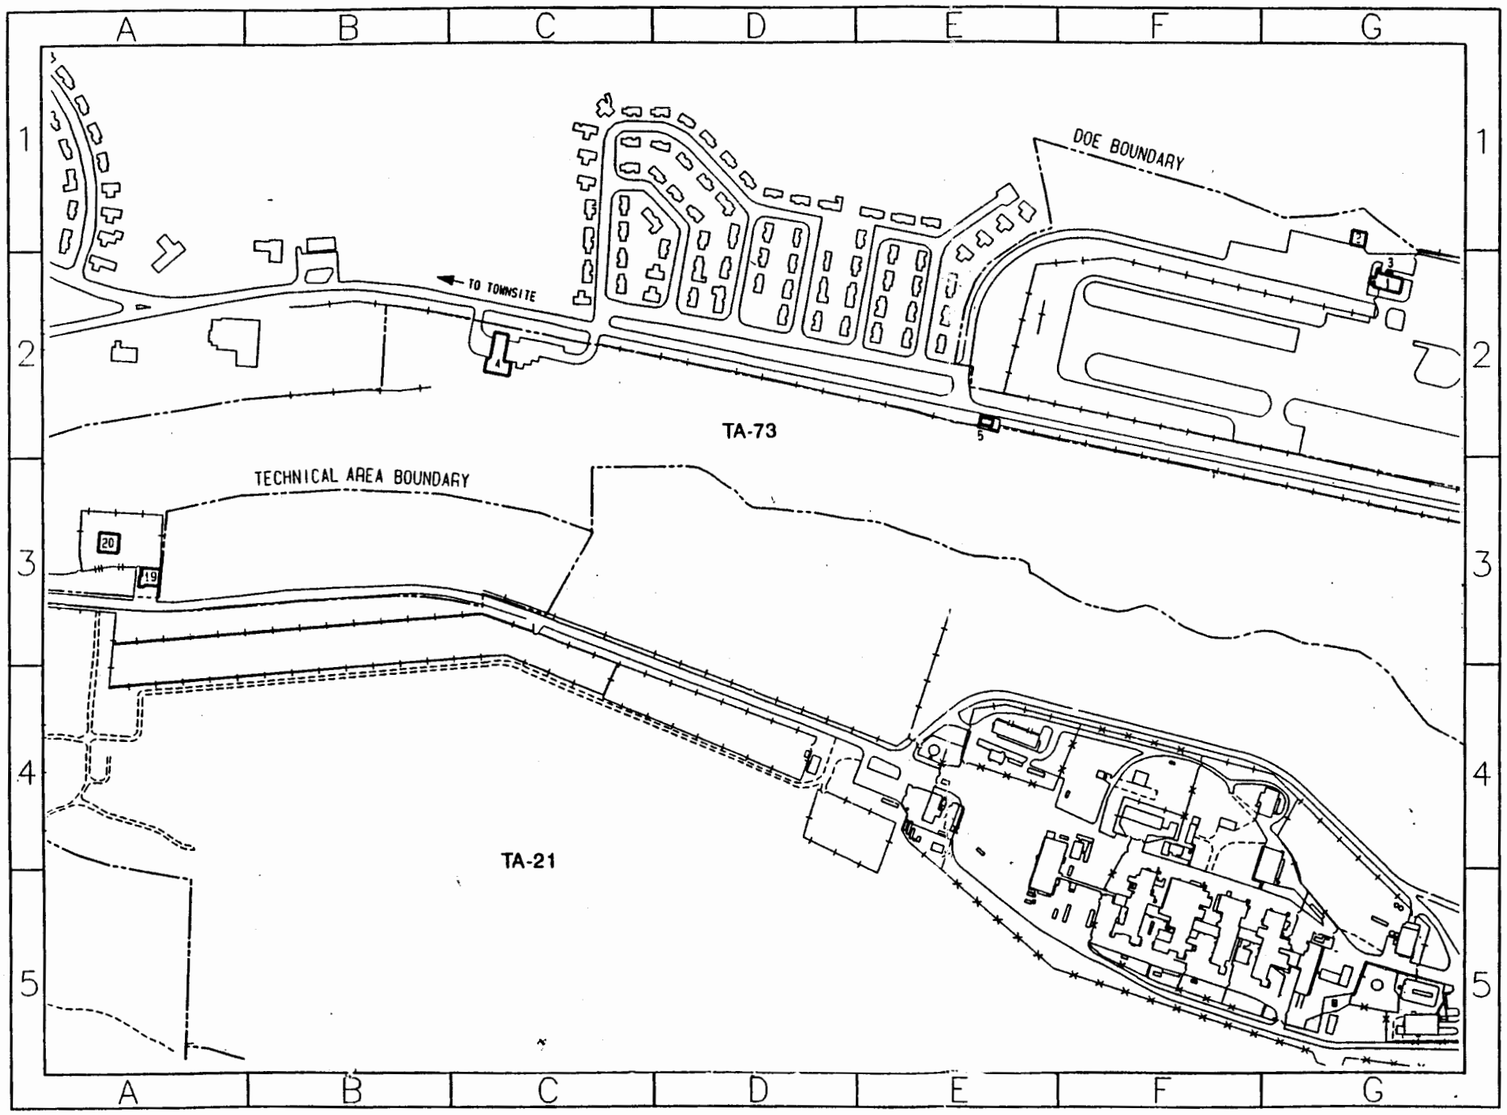

SCALE 1: 840

70 0 70 140 FEET

N

LATEST DISTRIBUTION
15JULY94
EMERGENCY RESPONSE MAP
UPDATED DRAWING

NO.	DATE	CLASS REV.	REVISIONS	DWN	DES	CKD	REL	SUB	REC	APP

FACILITIES ENGINEERING DIVISION

STRUCTURE LOCATION MAP
TA-73
AIRPORT SITE

BLDG.

DRAWN	C.SANDOVAL
DESIGN	
CHECKED	B. COMER
RELEASED	B. COMER
DATE	03-07-91

SUBMITTED RECOMMENDED APPROVED

LOS ALAMOS — LOS ALAMOS NATIONAL LABORATORY, LOS ALAMOS, NEW MEXICO 87545

SHEET 2 OF 2

CLASSIFICATION U REVIEWER DATE 4-15-91

LAB JOB NO.

DRAWING NO. ENG-R 7125

REV. 2

AUTOGIS