090191

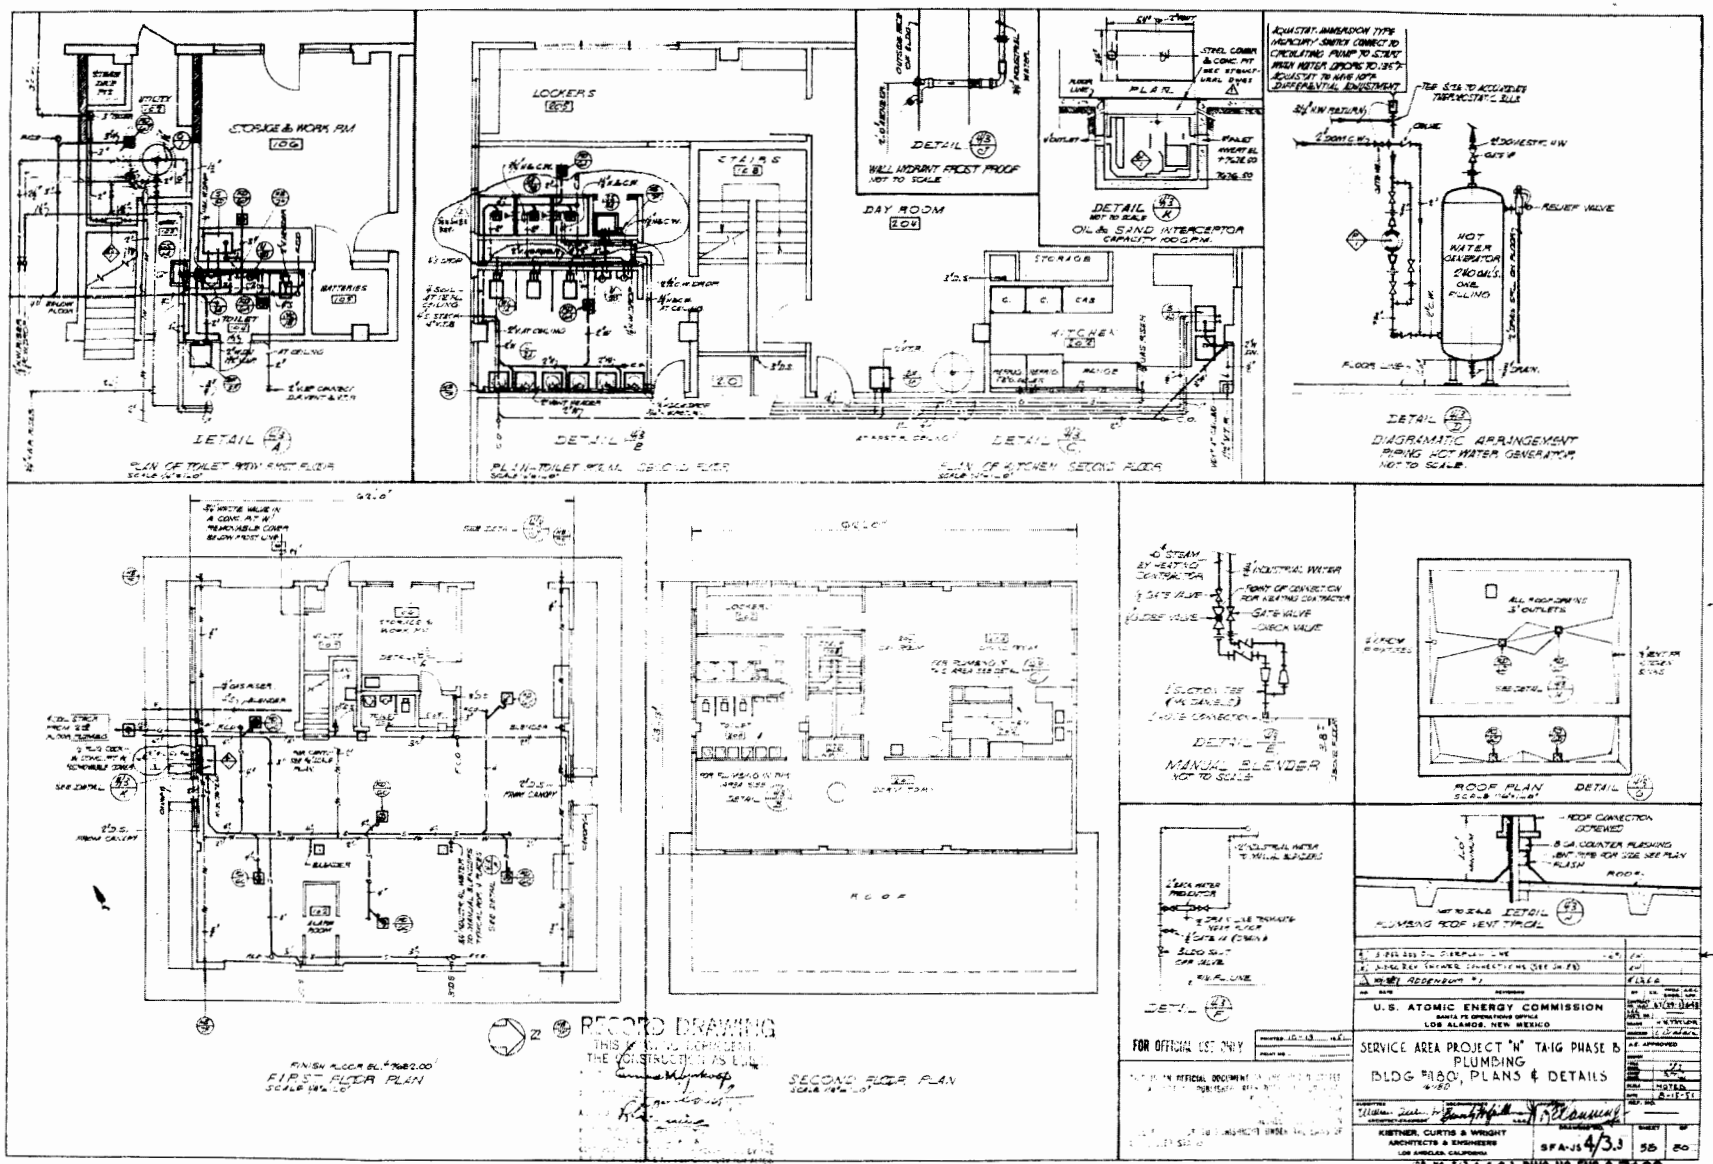

RECORD DRAWING
THIS DRAWING REPRESENTS
THE CONSTRUCTION AS BUILT

14635