101813

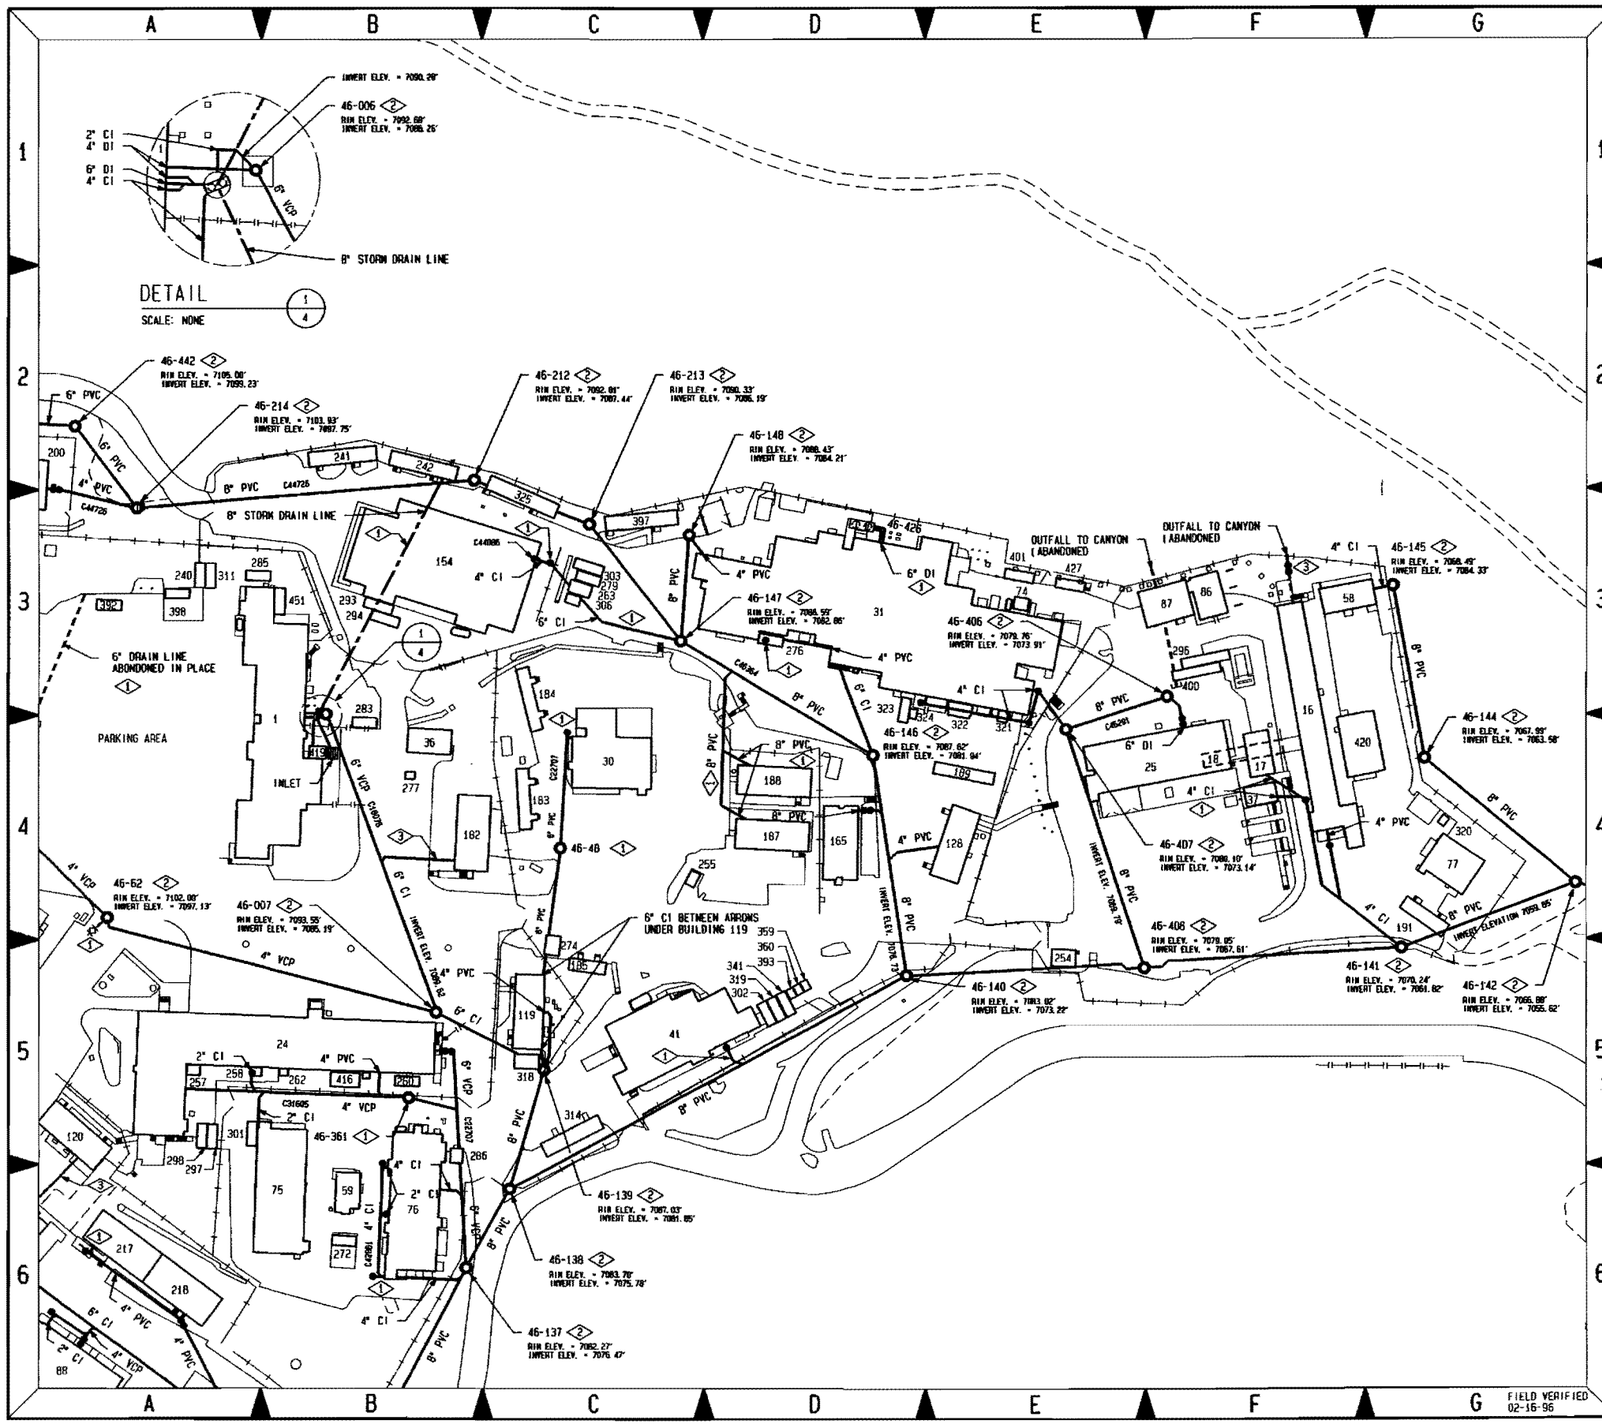


KEY MAP

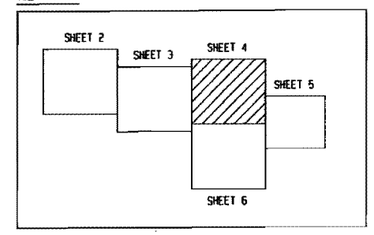


LEGEND

- SANITARY SEWER LINE, GRAVITY
- SANITARY SEWER LINE, FORCE MAIN
- SANITARY SEWER LINE, TREATED EFFLUENT
- MANHOLE W/NUMBER
- CLEANOUT
- DOUBLE CLEANOUT
- HOLDING TANK
- SEPTIC TANK
- LEACH FIELD
- LIFT STATION
- AIR INJECTION STATION
- AIR RELIEF STATION
- DISTRIBUTION BOX
- SEEPAGE PIT
- PLUG
- CI - CAST IRON
- DI - DUCTILE IRON
- FM - FORCE MAIN
- PE - POLYETHYLENE
- PVC - POLYVINYL CHLORIDE
- STL - STEEL
- TSE - TREATED SEWAGE EFFLUENT
- VCP - VITRIFIED CLAY PIPE
- 1 - UNABLE TO LOCATE
- 2 - UNABLE TO FIELD VERIFY NUMBER
- 3 - UNABLE TO VERIFY NO, SIZE AND/OR MAT'L

N

SCALE: 1:600

50 0 50 100

FEET

| NO | DATE | CLASS REV | DESCRIPTION | DWN | VER | CHKD | SUB | APP |
|---|---|---|---|---|---|---|---|---|

JOHNSON CONTROLS

UTILITY RECORD DRAWINGS

SANITARY SEWER SYSTEM

TA-46

DRAWN: C. SAMORA, R. GONZALES
VERIFIED: C. SAMORA, R. GONZALES
CHECKED: H. SALAZAR
DATE: 04-29-96

SUBMITTED: JERRY FORTE
APPROVED FOR RELEASE: ED HOTR, NELL SMITHOUR

Los Alamos — Los Alamos National Laboratory, Los Alamos, New Mexico 87545

SHEET 4 OF 6

CLASSIFICATION U — REVIEWER H. SALAZAR — DATE 5-28-96

PROJECT ID: 13650 — DRAWING NO: AB584 — REV

JCI NO 92-009

FIELD VERIFIED 02-16-96

31050