NOTE:
1. ASPHALT PADS DO NOT NEED TO BE PATCHED PER RALPH MARSH (ENG-3) PHONE 667-3547
2. PERMIT REQUIRED BY STATE FOR SEPTIC TANK AND LEACH FIELD PRIOR TO CONSTRUCTION. CONTACT STEVE RAE (HSE-8) PHONE 665-1869.
3. AREA TO BE HYDROSEEDED SHALL BE AT THE DISCRETION OF DAVID CHASTAIN (ENG-1) PHONE 667-3591

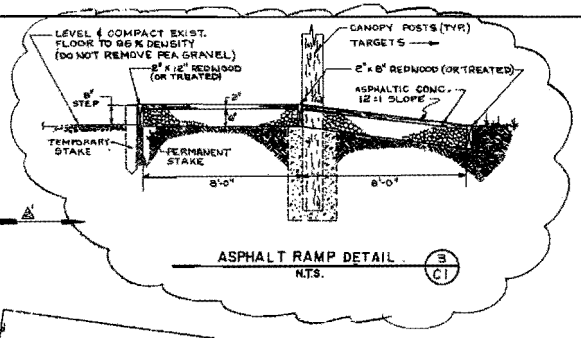

ASPHALT RAMP DETAIL (B/C1)
N.T.S.

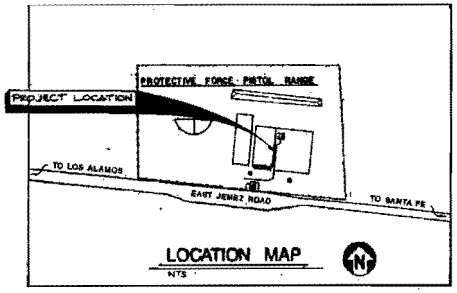

LOCATION MAP
NTS

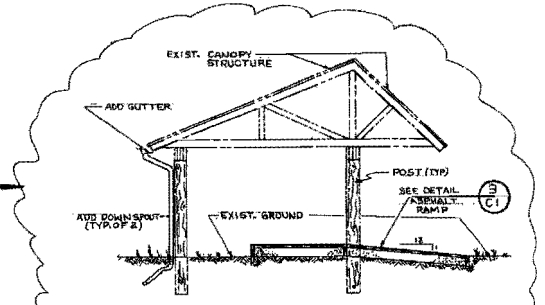

CANOPY SECTION (E/C1)
SCALE: 1/4" = 1'-0"

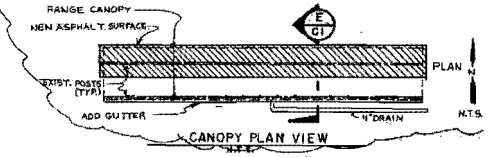

CANOPY PLAN VIEW

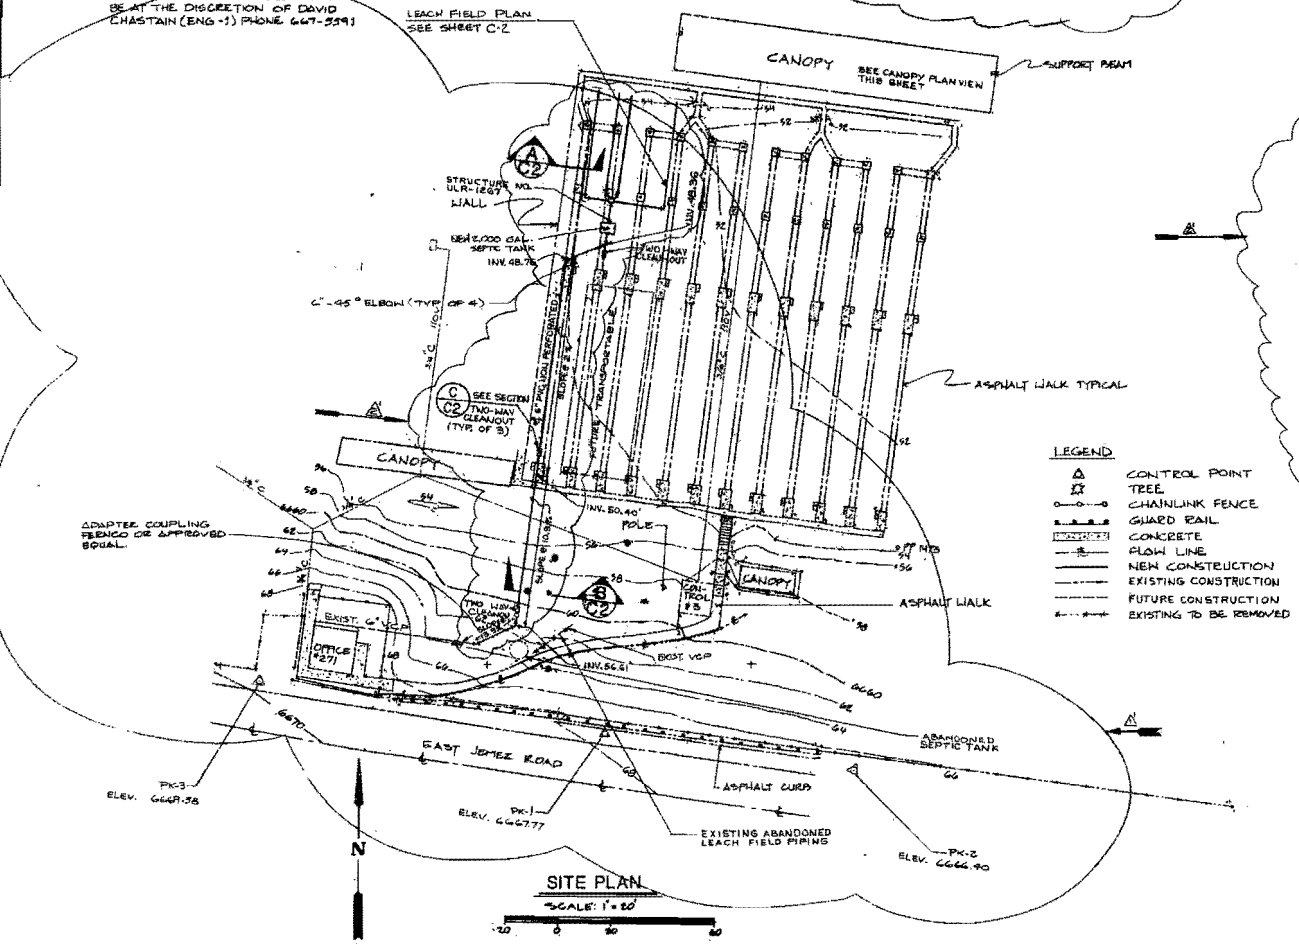

SITE PLAN
SCALE: 1" = 20'

LEGEND
- CONTROL POINT
- TREE
- CHAINLINK FENCE
- GUARD RAIL
- CONCRETE
- FLOW LINE
- NEW CONSTRUCTION
- EXISTING CONSTRUCTION
- FUTURE CONSTRUCTION
- EXISTING TO BE REMOVED

NO.	DATE	PLANT REV.	REVISIONS	DRW.	DES.	CHKD.	REQ. SUP.	REQ. D.O.	ENG. DIV.	ENG. S.G.
3	11/6/89		AS-BUILT	RL	MT					
2	4/4/89		REVISED NOTES, IN REF. TO ABANDONED SEPTIC TANK.	RG	MT					

Pan Am World Services, Inc.
LABORATORY SERVICES DIVISION

SEPTIC TANK AND LEACH FIELD
FIRING RANGE, TA-0

CIVIL: SITE PLAN
BLDG. ULR-1267 TA-0

DRAWN: RGCCASTILLO
CHECKED:
DESIGN: D. TRUMBLE
CHECKED:
RELEASED:
DATE: 11/21/88

SUBMITTED: RECOMMENDED: D.D. Kerkes APPROVED:

Los Alamos — Los Alamos National Laboratory, Los Alamos, New Mexico 87545

SHEET C1 1 OF 4

CLASSIFICATION: U REVIEWER: D.D. Kerkes DATE: 12-2-88

REQUESTING DIV. 08-00 REQUESTING GROUP 08-10 | LAB JOB NO. 9914-0 | DRAWING NO. ENG-C45621 | REV. 2

STATE 88-183 UT

10423 4

31612