~~OFFICIAL USE ONLY~~ EMD 9/27/09

~~CONFIDENTIAL~~

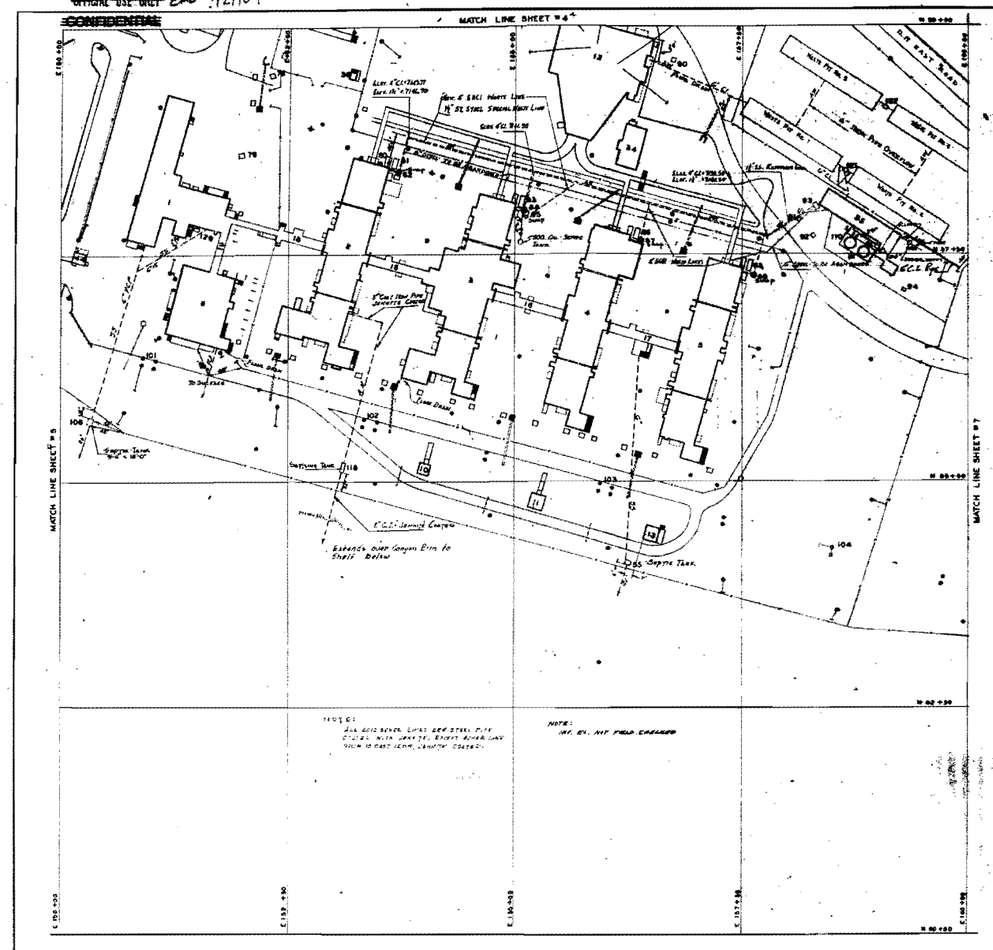

~~OFFICIAL USE ONLY~~ EMD 9/27/09

Drawn by R.D. Kraber 12-21-56

Designed by Nancy E. Williams 1-4-57

~~CONFIDENTIAL~~

INDEX TO SHEETS
NO SCALE

LEGEND

SS — SANITARY SEWER
AS — ACID WASTE

REFERENCE:
Field Book No. F-1126, Page 80
Eng. 4-3-17, EBCL, F-1125, 1126, 1115

5	10-8-57	ADD SEPTIC TANK OFFSET & CHANGE PIPE LINE TO BLDG 53		
2	9/12/57	Revised to Field Check Status Of 11-20-56		
1	10/9/56	Revised to Field Check Status		
NO.	DATE	REVISIONS	BY	CHK

AUTHORIZED FOR: CONSTRUCTION / SAFETY / FIELD PROJ. / REC.

LOS ALAMOS SCIENTIFIC LABORATORY
UNIVERSITY OF CALIFORNIA
ENGINEERING DEPARTMENT — LOS ALAMOS, N.M.

UTILITY LOCATION PLAN
TA-21 DP-SITE
SEWER SYSTEM

CHECKED — RECOMMENDED SER — APPROVED — GROUP LEADER — ENG. DIV. DIRECTOR
DRAWN C.M. — DATE 11-21-56
SCALE 1 IN.=50 FT — SHEET 6 OF 8 — ENG-R115

~~CONFIDENTIAL~~

EMD 9/27/09 ~~OFFICIAL USE ONLY~~ INFO. SHOWN CURRENT AS OF 11-20-56 LAB. JOB NO. 1339

32076

SB

10 6966