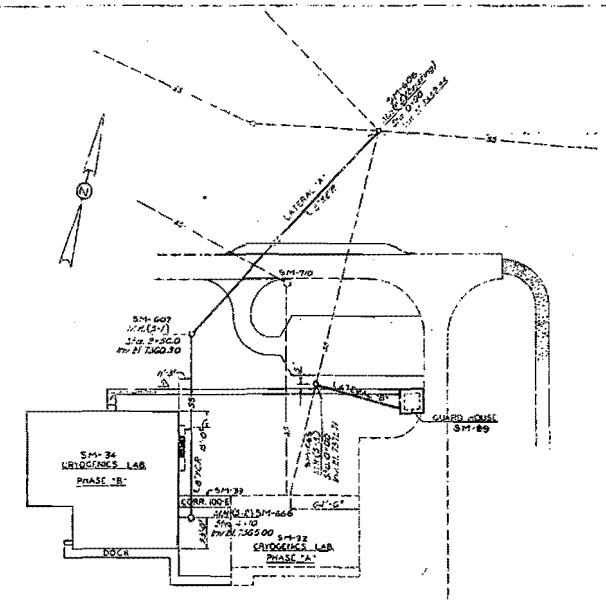

SANITARY SEWERS - PLAN

Scale: 1" = 50'

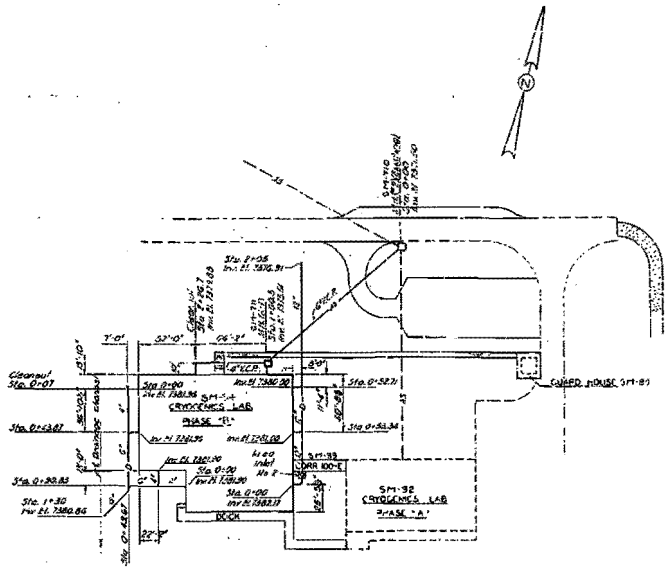

ACID SEWER AND ROOF DRAINS - PLAN

Scale: 1" = 50'

LEGEND

	PROPOSED	EXISTING
SANITARY SEWER	SS	SS
" " MANHOLE		
ACID SEWER	AS	AS
" " MANHOLE		
DRAIN LINE	D	
BITUMINOUS PAVEMENT		
PATROL ROAD		
CONCRETE SIDEWALK		
BUILDINGS		

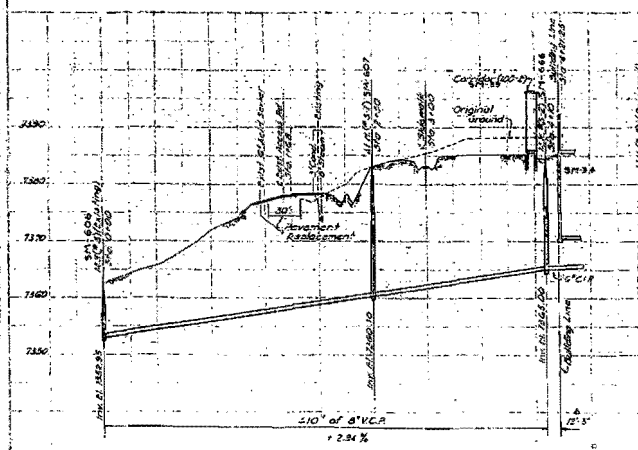

SANITARY SEWER LATERAL "A"

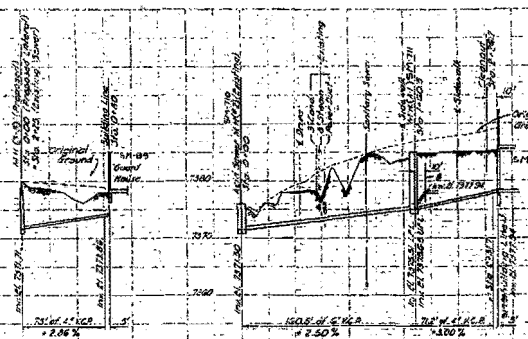

SANITARY SEWER LATERAL "B"

ACID SEWER

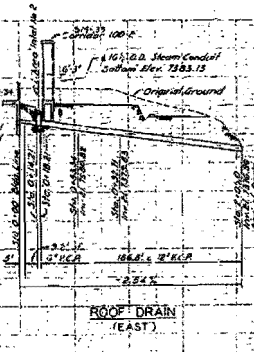

ROOF DRAIN (EAST)

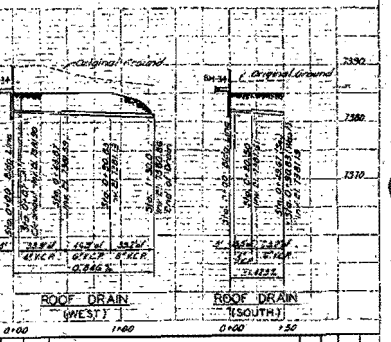

AS BUILT DRAWING

RECOMMENDED

APPROVED

FOR OFFICIAL USE ONLY

THIS IS AN OFFICIAL DOCUMENT OF THE UNITED STATES. IT MAY NOT BE PUBLISHED, REPRODUCED, OR USED FOR OTHER THAN OFFICIAL PURPOSES WITHOUT THE PRIOR WRITTEN CONSENT OF THE UNITED STATES ATOMIC ENERGY COMMISSION AND IS SUBJECT, TO RECALL. ANY VIOLATION MAY BE SUBJECT TO PUNISHMENT UNDER THE LAWS OF THE UNITED STATES.

2	7-15-55	ADDED STRUCTURE NO'S.	TFF	JAS
1	11-15-54	REVISED DIMENSIONS	CRD	TRS
NO.	DATE	REVISIONS	BY	CK

U. S. ATOMIC ENERGY COMMISSION
LOS ALAMOS FIELD OFFICE
LOS ALAMOS, NEW MEXICO

CRYOGENICS LABORATORY SM-24

CIVIL

PLAN-PROFILE SEWERS AND DRAINS

TA-3 PHASE "B" PROJECT 1

DATE	12-51
DRAWN	FRD
CHECKED	FRD
A-E APPROVED	
ENGRS	ERD
	CAS
SCALE	AS NOTED
DATE	10-9-53

SUBMITTED BY C.A. Slocum
A-E APPROVED
DRAWN BY T.A. Trimmell
CHECKED BY R.R. Shannon

BLACK & VEATCH
CONSULTING ENGINEERS
KANSAS CITY, MISSOURI

LA-AA-2009 | SHEET 10 | OF 123

34085

LAB JOB 1270

L.A.S.I. DWG. NO. ENG-C17618

ENTERED

110574