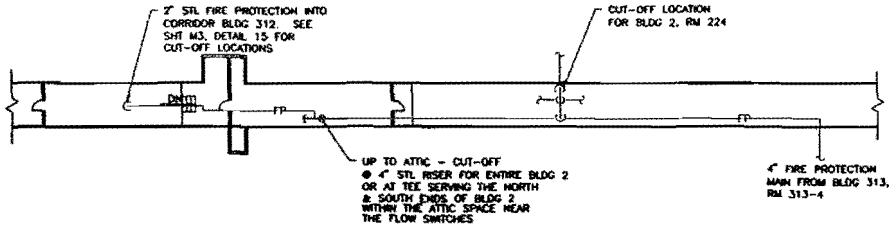

FIRE PROTECTION, BLDG 2 (14/M3)

SCALE: NONE

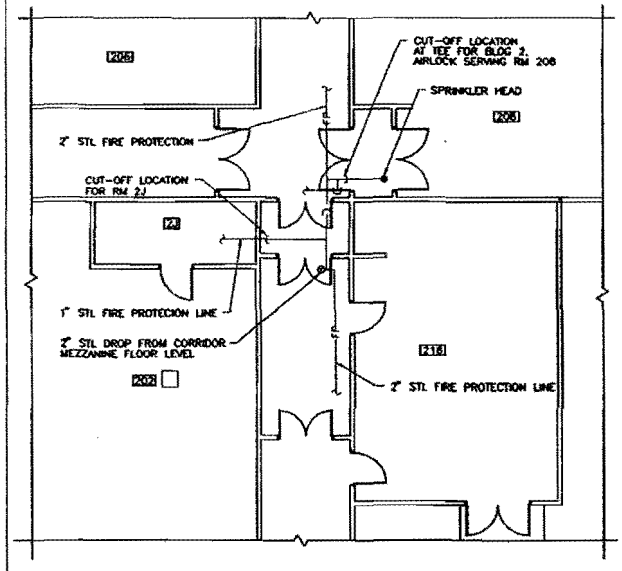

FIRE PROTECTION, BLDG 2 (15/M3)

SCALE: NONE

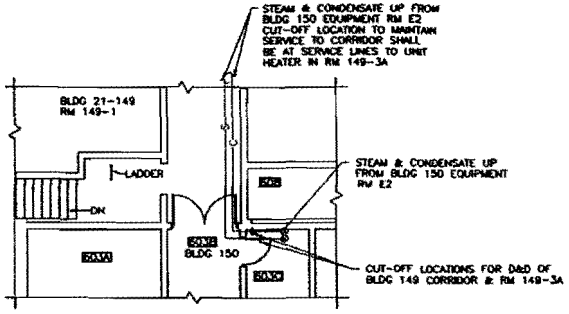

STEAM & CONDENSATE, BLDG 149 (16/M3)

SCALE: NONE

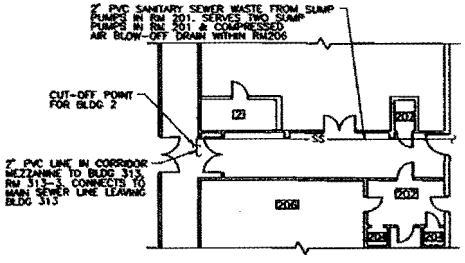

SANITARY SEWER SYSTEM, BLDG 2 (17/M3)

SCALE: NONE

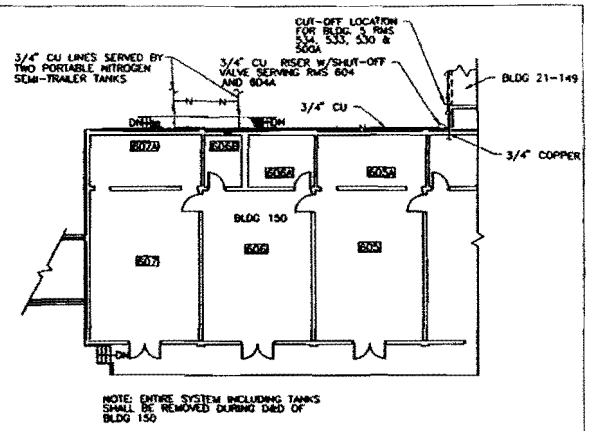

NOTE: ENTIRE SYSTEM INCLUDING TANKS SHALL BE REMOVED DURING D&D OF BLDG 150

NITROGEN SYSTEM, BLDG 150 & 5 (18/M3)

SCALE: NONE

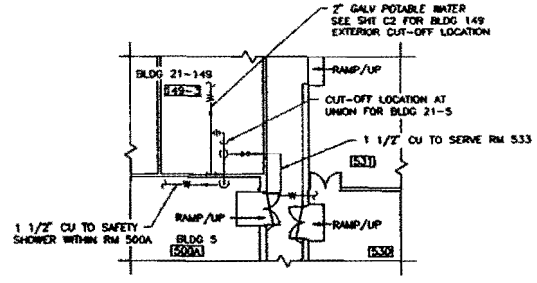

POTABLE WATER LINE, BLDG 5 (19/M3)

SCALE: NONE

NO	DATE	CLASS REV	DESCRIPTION	DWN	VER	CHKD	SUB	APP

JOHNSON CONTROLS

AS-BUILT TA-21 DECONTAMINATION AND DECOMMISSIONING PROJECT

MECH. DETAILS

DRAWN A. MARTINEZ
VERIFIED
CHECKED
DATE 02-10-98

BLDG 2, 5, 149 & 150 TA-21

SUBMITTED JERRY FONTE
APPROVED FOR RELEASE SAM BROUGHTON

Los Alamos — Los Alamos National Laboratory, Los Alamos, New Mexico 87545

SHEET M3 10 OF 45

CLASSIFICATION U REVIEWER T. GUSSOFF DATE 8-1-96

PROJECT # ****

DRAWING NO AB683

REV

FIELD VERIFIED 07-17-96

ENTERED

111440

34313