OFFICIAL USE ONLY

~~CONFIDENTIAL~~

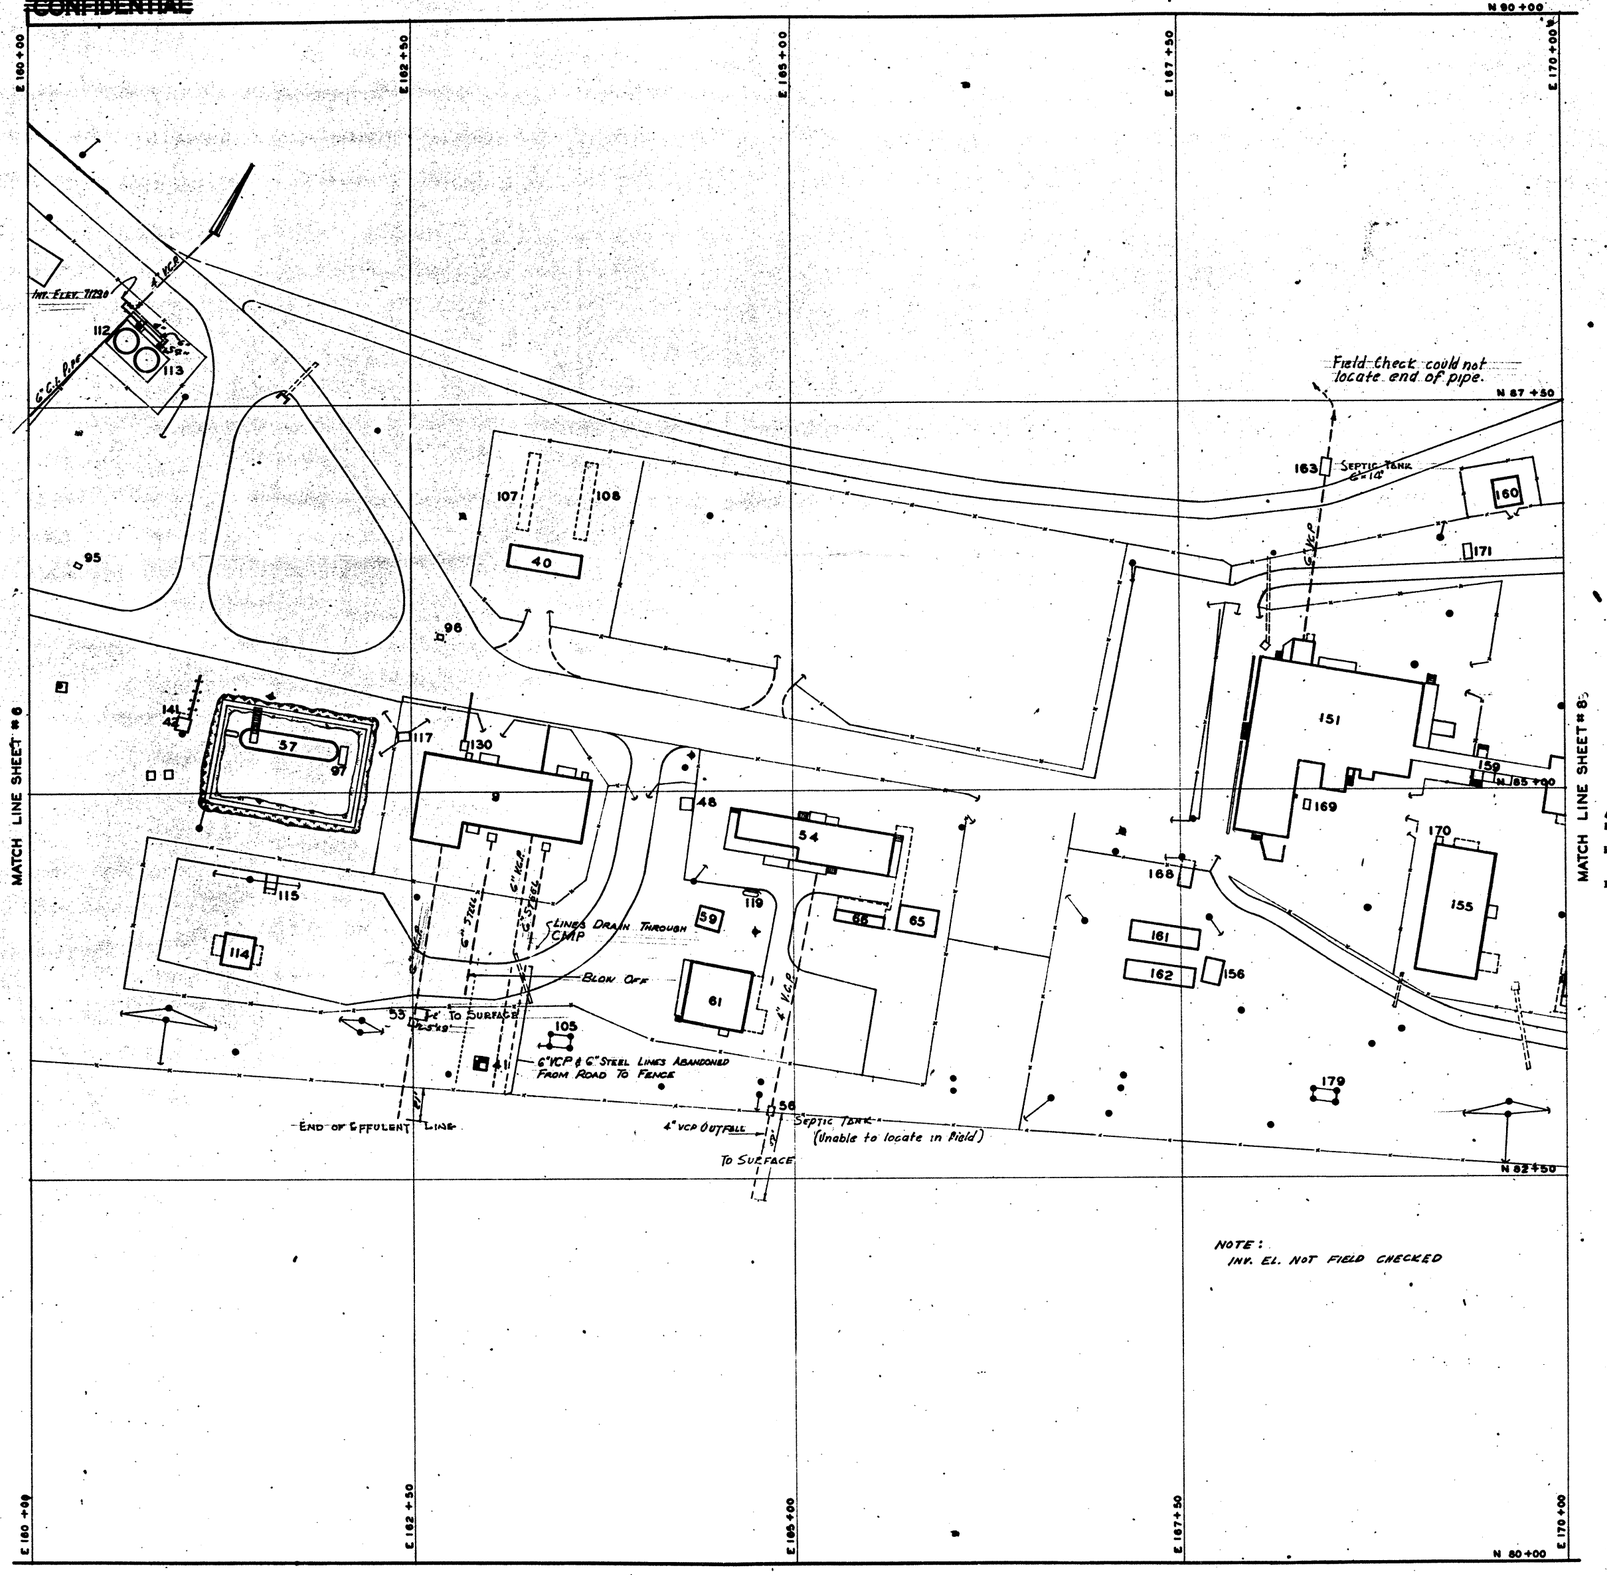

OFFICIAL USE ONLY

Classification changed to _____ by authority of the U. S. Atomic Energy Commission,

Per R. D. Krohn 12-31-58.
(Person authorizing change in classification) (Date)

By Harry E. Williams 1-6-59.
(Signature of person making the change, and date)

~~CONFIDENTIAL~~

~~This material contains information affecting the national defense of the United States within the meaning of the espionage laws Title 18, U. S. C., Secs. 793 and 794, the transmission or revelation of which in any manner to an unauthorized person is prohibited by law.~~

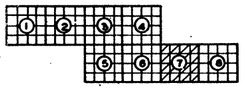

INDEX TO SHEETS
NO SCALE

LEGEND:

SS — SANITARY SEWER
AW — ACID WASTE

NO.	DATE	REVISIONS	BY	CHKD	GRP. LDR.	ENG. DIV.
2	8-22-58	REVISED TO FIELD CHECK STATUS OF 1-20-56	J.H.	[illegible]	[illegible]	[illegible]
1	12/24/56	Revised to Field Check Status	SJK	[illegible]	[illegible]	[illegible]

AUTHORIZED FOR: HEALTH, SAFETY, FIRE PROT., SEC.

LOS ALAMOS SCIENTIFIC LABORATORY
UNIVERSITY OF CALIFORNIA
ENGINEERING DEPARTMENT — LOS ALAMOS, N. M.

UTILITY LOCATION PLAN
TA-21 DP-SITE
SEWER SYSTEM

CHECKED	RECOMMENDED	APPROVED
[signature] DESIGNER	SER GROUP LEADER	[signature] ENG. DEPT. OFFICE

DRAWN	DATE	DRAWING NO.
D.M.	10-21-54	ENG-R 1195
SCALE 1 IN.=50 FT.	SHEET 7 OF 8	

~~CONFIDENTIAL~~

OFFICIAL USE ONLY INFO. SHOWN CURRENT AS OF 1-20-56 LAB. JOB NO. 1339

10422