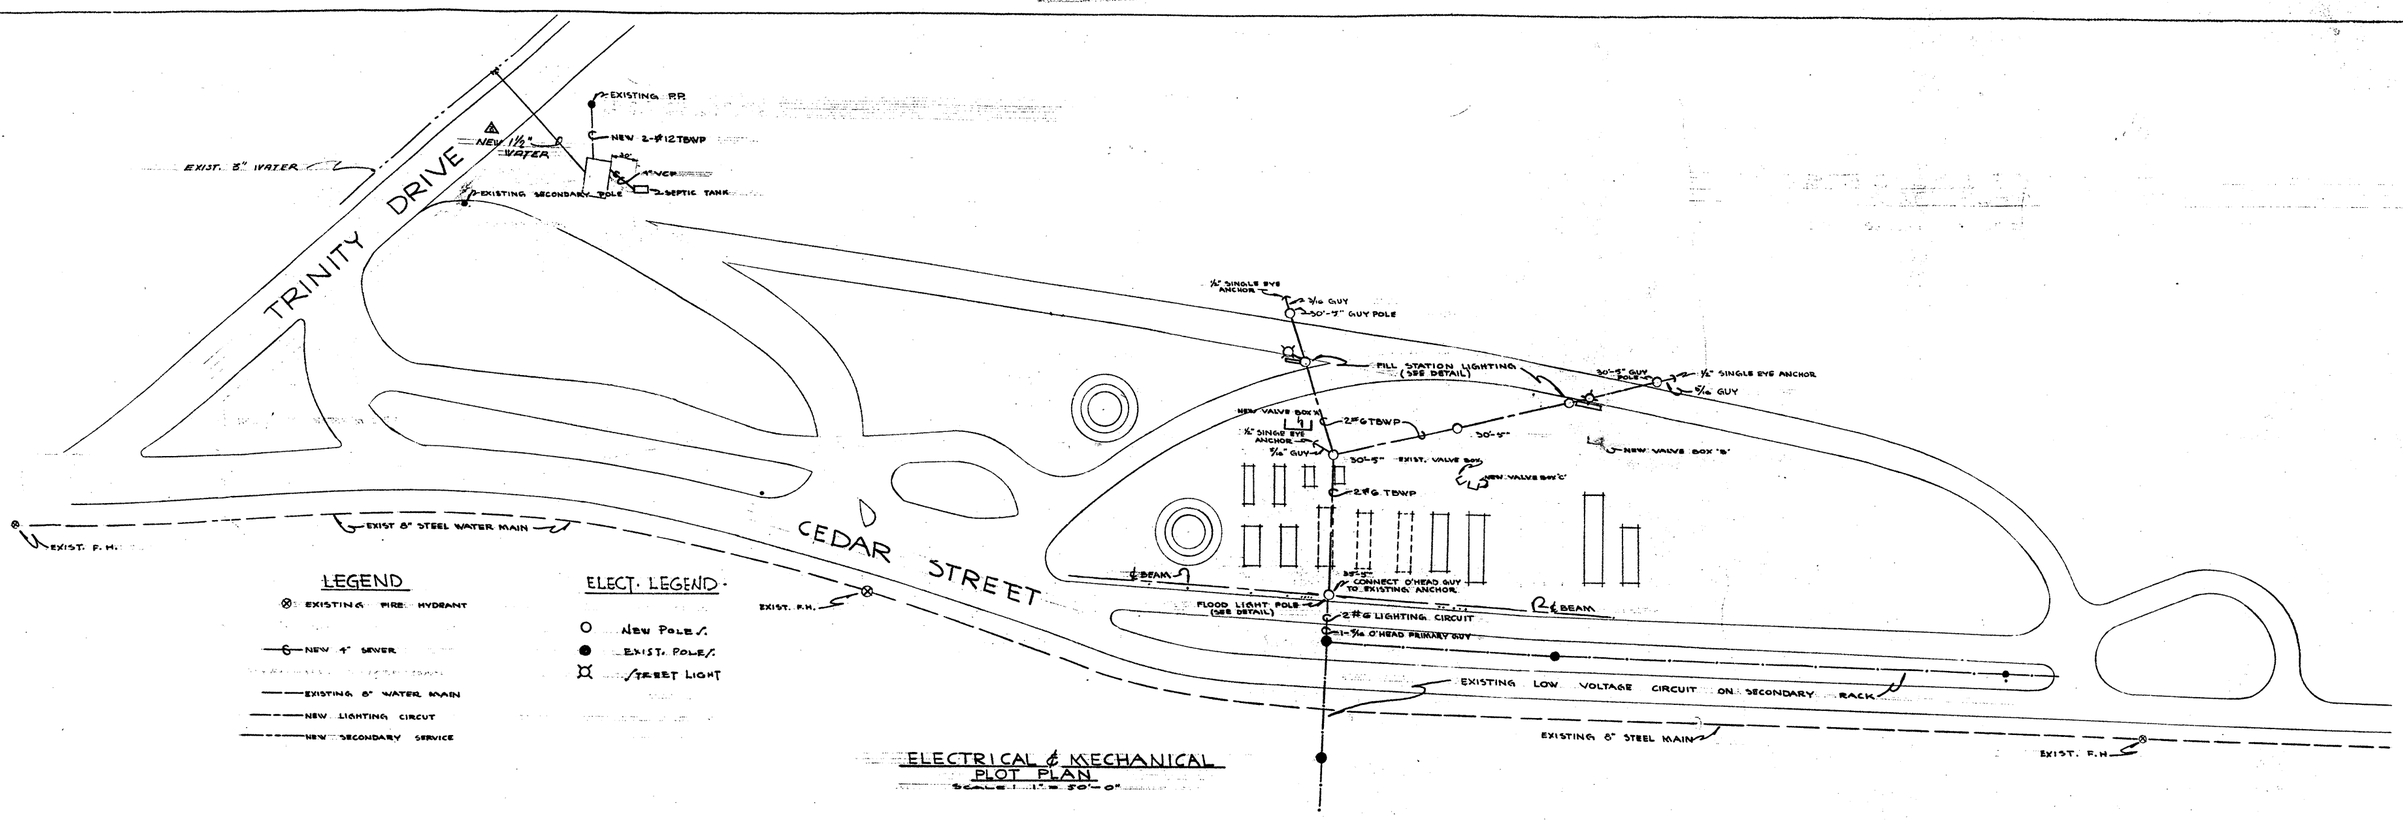

ELECTRICAL & MECHANICAL PLOT PLAN
SCALE: 1" = 50'-0"

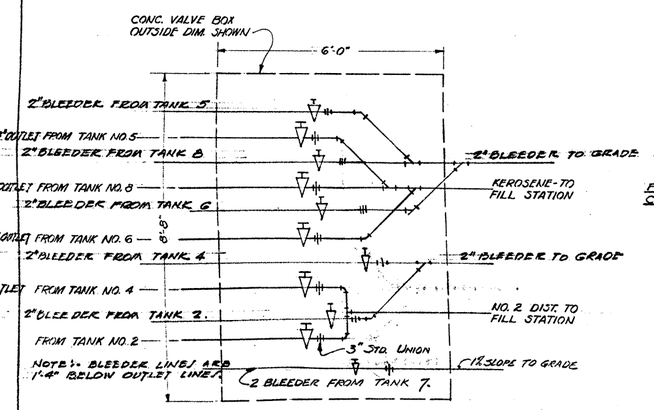

VALVE BOX 'A'

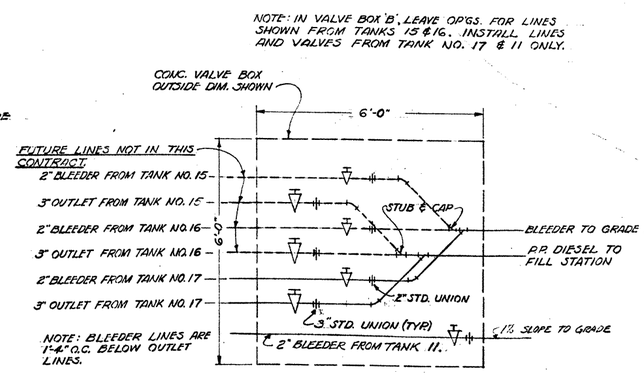

VALVE BOX 'B'

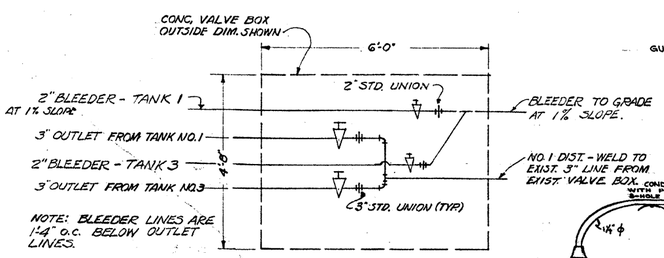

VALVE BOX 'C'

NOTE: 1. FOR CONC. VALVE BOX DETAILS, SEE SHT 3.
2. TELEPHONES WILL BE INSTALLED BY GOVERNMENT

PIPING DIAGRAMS FOR VALVE BOXES
NO SCALE

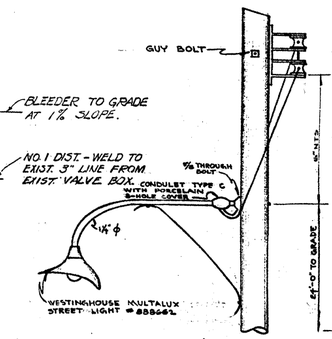

FILL STATION LIGHTING
NO SCALE

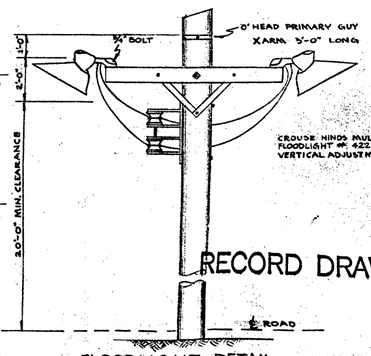

FLOODLIGHT DETAIL
NO SCALE

RECORD DRAWING

▲ CHANGE ORDER #5

ATOMIC ENERGY COMMISSION • BOX 1539 • LOS ALAMOS, NEW MEX.		
FUEL TANK FARM		DRAWING NO. Z-252
ELECTRICAL & MECHANICAL PLOT PLAN & DETAILS		DRAWN: J.M.C.
THE ZIA COMPANY		CHECKED: G.R.H.
		DATE: 6-17-48
SUBMITTED: THE ZIA CO.	RECOMMENDED: CHIEF ENGINEERING SEC.	APPROVED: DIRECTOR OF OPERATION
		SHEET 4 OF 5 SHEETS

AS BUILT 11-12-48 R.H.M. DELETED 1½" WATER TO EXIST. 8" MAIN. ADDED 1½" WATER SERVICE TO EXIST. 2" LINE. 9-2-48

DELETE TANKS 15 & 16 6/21 ALC

REVISIONS

REC'D ___ LOGGED ___ TO VAULT ___

ENG-C 49054

MICROFILMED FROM BEST AVAILABLE MATERIAL

10423