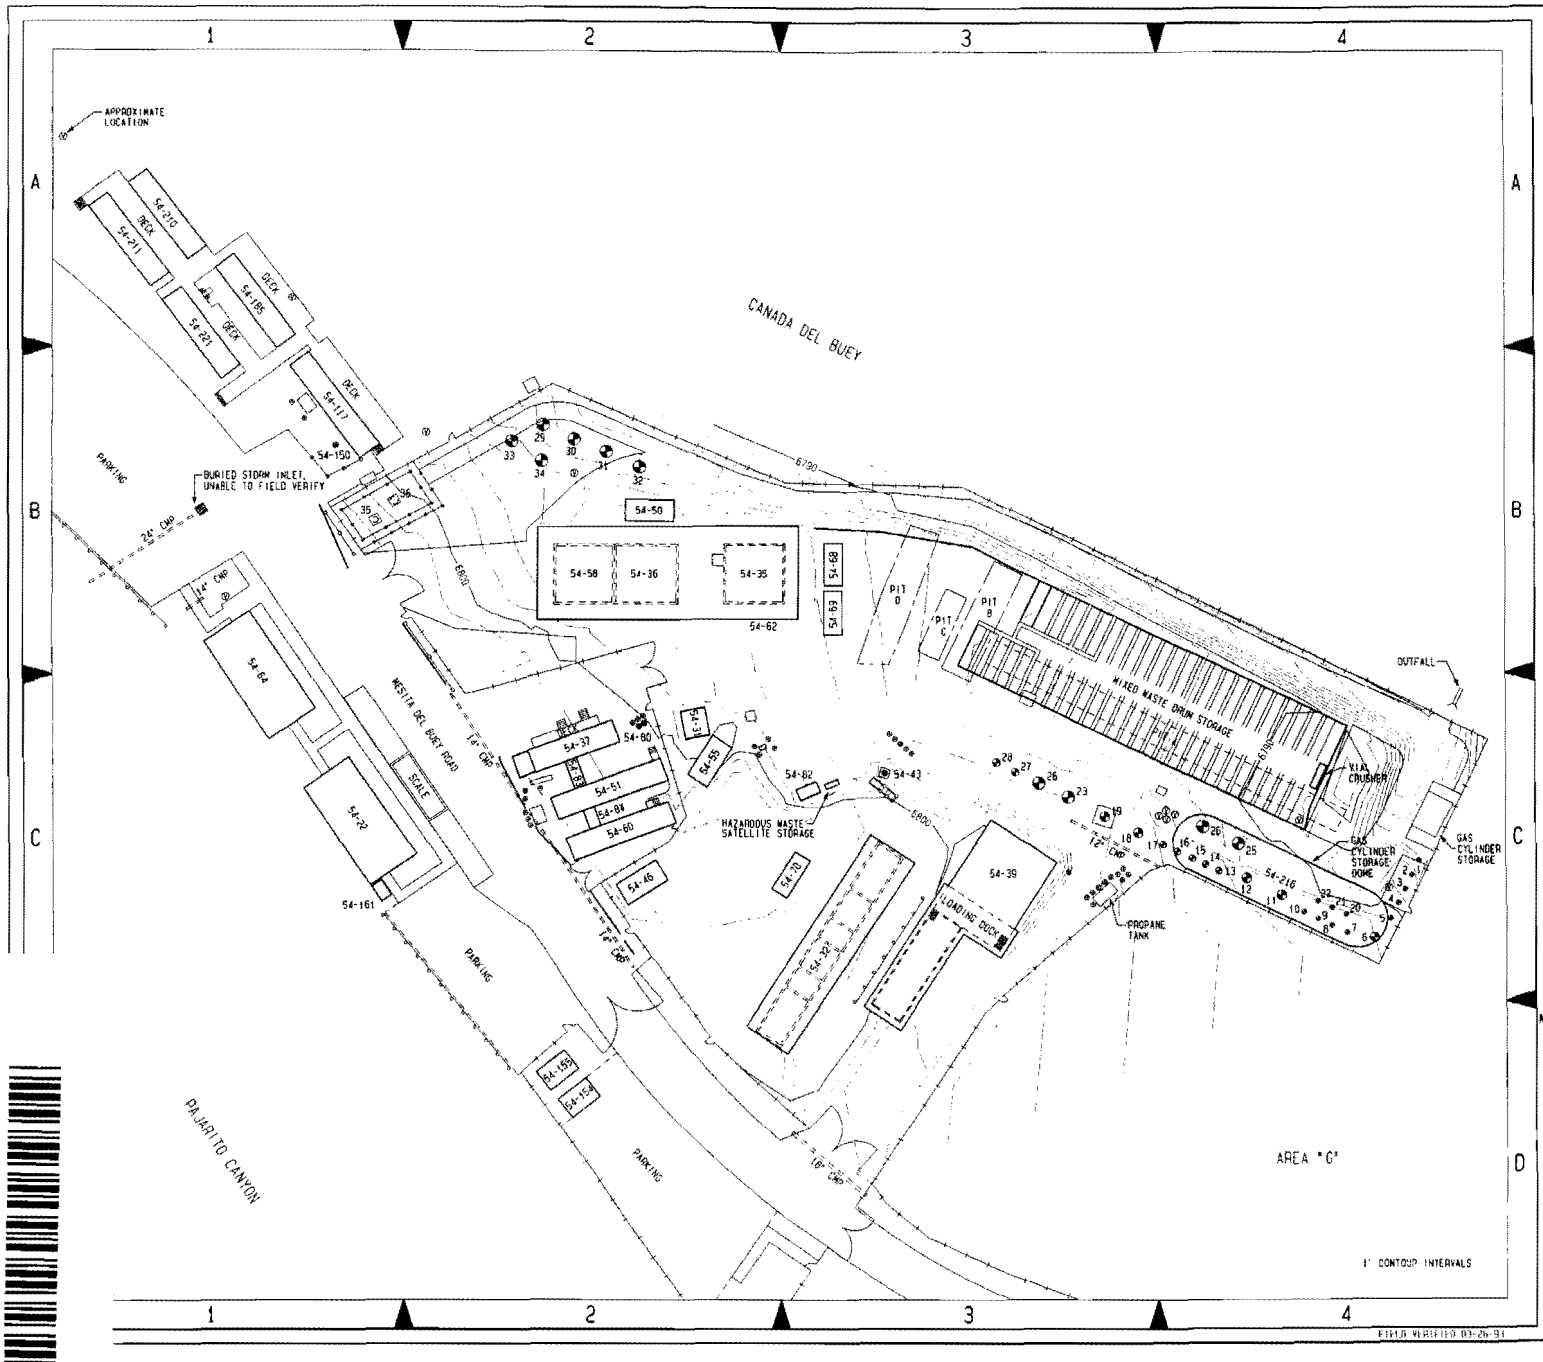

STRUCTURE NUMBER INDEX

STRUCTURE TA-NUMBER DESIGNATION	STRUCTURE NOMENCLATURE	STRUCTURE LOCATOR SHEET NO.
54-22	TRANSPORTABLE OFFICE BUILDING	1
54-31	STORAGE BUILDING	1
54-32	COVERED WASTE STORAGE PAD	1
54-35	TREATMENT PAD	1
54-36	SAMPLING PAD	1
54-37	OFFICE TRAILER	1
54-39	PCB BUILDING & CONTAINMENT PAD	1
54-43	HOLDING TANK	1
54-46	TOOL STORAGE SHED	1
54-50	EQUIPMENT STORAGE SHED	1
54-51	OFFICE TRAILER	1
54-55	OFFICE BUILDING	1
54-58	TRANSPORTATION PAD	1
54-60	OFFICE TRAILER	1
54-62	CANOPY OVER MD-35, MD-36, MD-58	1
54-64	TRANSPORTABLE OFFICE BUILDING	1
54-68	MODULAR STORAGE BUILDING	1
54-69	MODULAR STORAGE BUILDING	1
54-70	MODULAR STORAGE BUILDING	1
54-80	HOLDING TANK	1
54-82	DRUM CRUSHER	1
54-83	WALKWAY	1
54-84	WALKWAY	1
54-117	OFFICE TRAILER	1
54-150	HOLDING TANK	1
54-154	SUPPLIES STORAGE SHED	1
54-155	PCB SUPPLIES STORAGE SHED	1
54-161	SHED	1
54-185	OFFICE TRAILER	1
54-210	OFFICE TRAILER	1
54-211	OFFICE TRAILER	1

LEGEND

- CHEMICAL WASTE DISPOSAL PIT
- INDUSTRIAL FENCE
- SURFACE IMPOUNDMENTS (CLOSED OUT)
- CHAIN FENCE
- GUARDRAIL
- HANDRAIL
- LEAD STRINGER SHAFT
- CAPPED STORAGE SHAFT (SIZE INDICATES SHAFT DIAMETER)*
- GUARD POST
- ASPHALT CURBING
- VAPOR MONITORING WELL
- STAIRS
- HOLDING TANK LID
- CMP - CORRUGATED METAL PIPE

NOTE:

1. ALL CAPPED STORAGE SHAFTS AND PITS ARE BURIED AND WERE NOT FIELD VERIFIED. LOCATIONS SHOWN WERE OBTAINED FROM C-45259, SHT. 4

SCALE: 1:360

30 0 30 60 FEET

N

MF	NO	DATE	CLASS REV	REVISIONS	DWN	VER	CHKD	REL	SUB

JOHNSON CONTROLS WORLD SERVICES INC.

AS-BUILT CRITICAL FACILITY
TA-54 "AREA L"
CIVIL: SITE PLAN

DRAWN / VERIFIED / CHECKED / RELEASED / DATE

SUBMITTED JERRY PORTE — RECOMMENDED FRED THOMPSON 4/8/93 — APPROVED ED LOPEZ

Los Alamos — Los Alamos National Laboratory, Los Alamos, New Mexico 87545

SHEET C1

CLASSIFICATION — REVIEWER HAROLD SALAZAR — DATE

PROJECT ID 014292 — DRAWING NO AB113

JCI #93-016

ERID 76052

11921