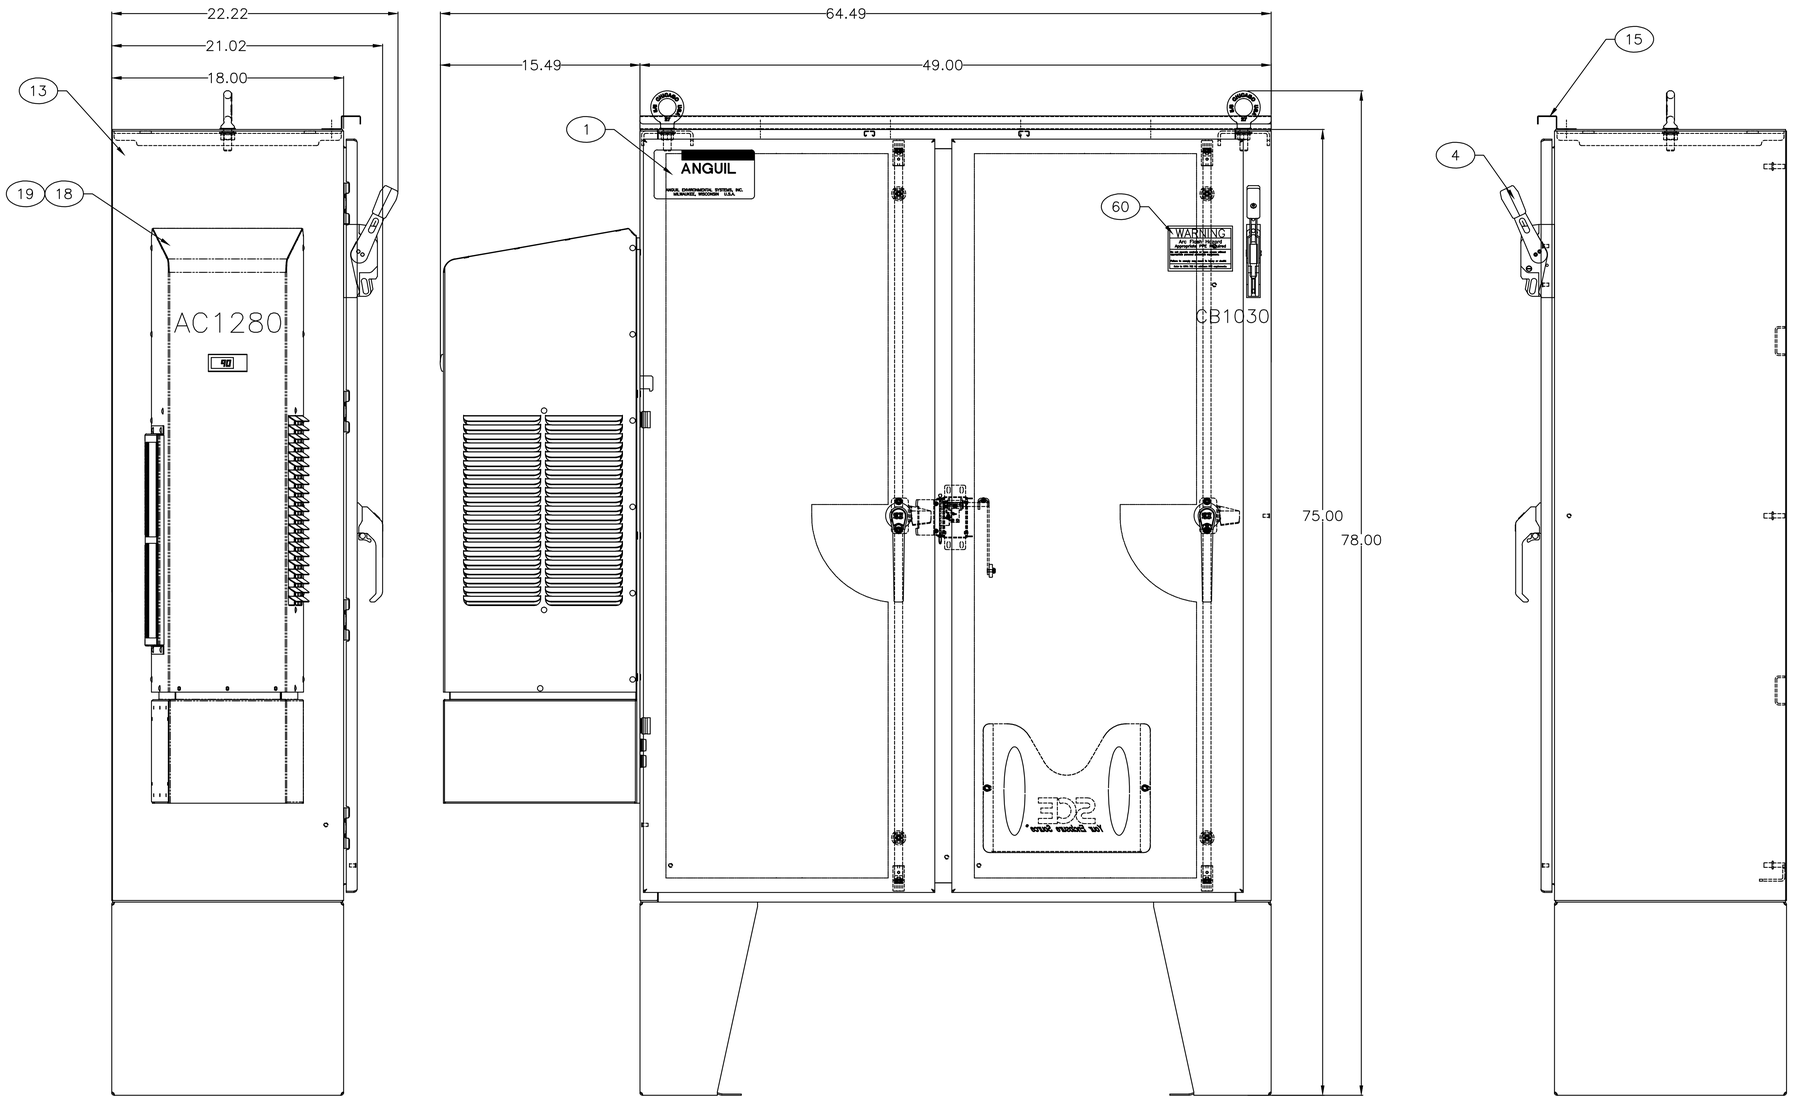

ENCLOSURE SIZE: 60" X 49" X 18"
APPROXIMATE ENCLOSURE WEIGHT: 1100 LB.

REV	BY	DATE	CHANGE
A	RLG	9/18/12	AS BUILT

ANGUIL

ANGUIL ENVIRONMENTAL SYSTEMS, INC.
MILWAUKEE, WISCONSIN

TITLE
MODEL 20 CATALYTIC OXIDIZER
POWER PANEL
ENCLOSURE DETAILS

DRAWING NO. 16512451

PAGE 2 OF 9

REV. A

CUSTOMER
SHAW ENVIRONMENTAL

KIRTLAND AFB, NM

SOURCE –

NOTE:

DRAWN RLG DATE 8/19/12

AUTOCAD PATH JOBS\16000s\16512\ELEC

SCALE NONE

CHECKED: DATE:

APPROVED: DATE:

LAST CHANGED BY: DATE: