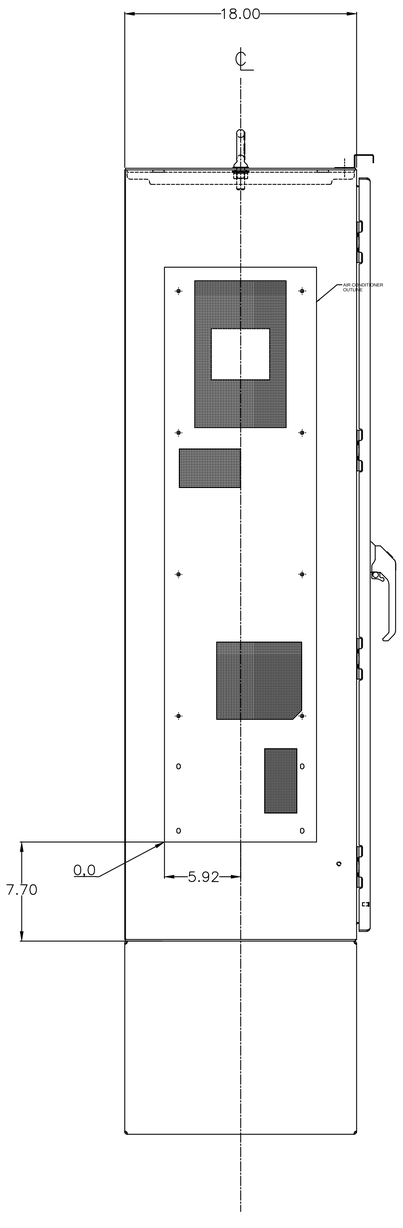


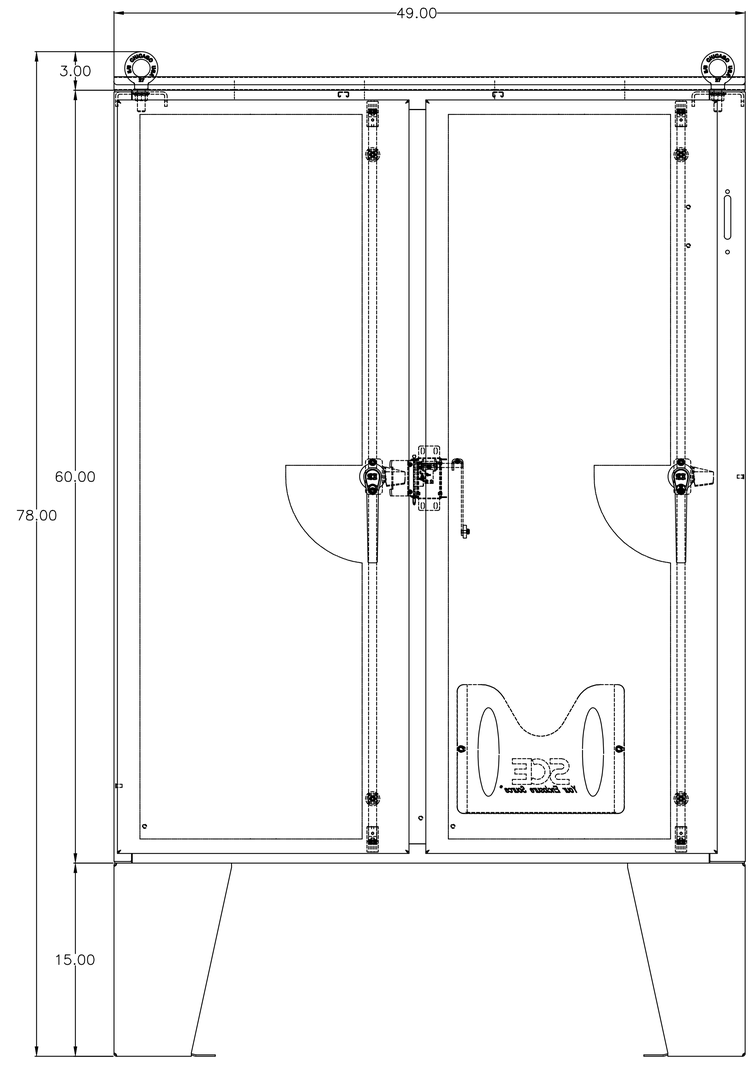


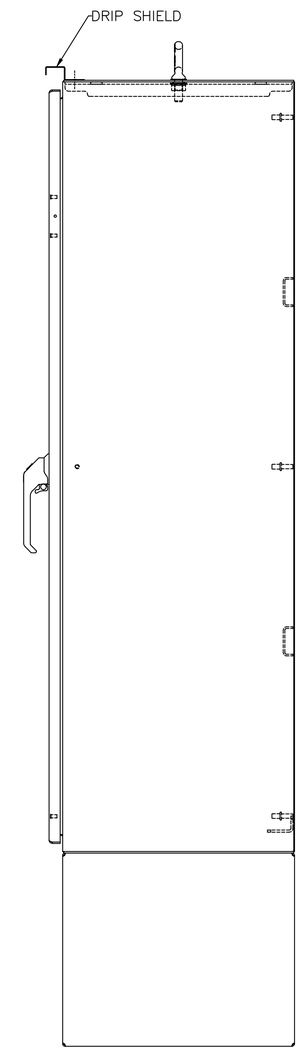


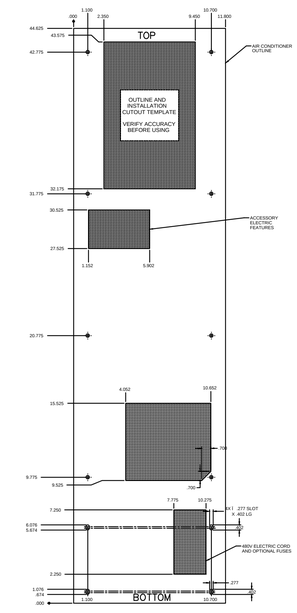


AIR CONDITIONER CUTOUT DETAIL

| REV | BY | DATE | CHANGE |
|---|---|---|---|
| A | RLG | 9/18/12 | AS BUILT |

ANGUIL

ANGUIL ENVIRONMENTAL SYSTEMS, INC.
MILWAUKEE, WISCONSIN

TITLE
MODEL 20 CATALYTIC OXIDIZER
POWER PANEL
ENCLOSURE CUTOUT DETAILS

DRAWING NO. 16512452

PAGE 3 OF 9

REV. A

CUSTOMER
SHAW ENVIRONMENTAL

KIRTLAND AFB, NM

SOURCE –

NOTE:

DRAWN RLG DATE 8/19/12

AUTOCAD PATH JOBS\16000s\16512\ELEC

SCALE NONE

CHECKED: DATE:

APPROVED: DATE:

LAST CHANGED BY: DATE: