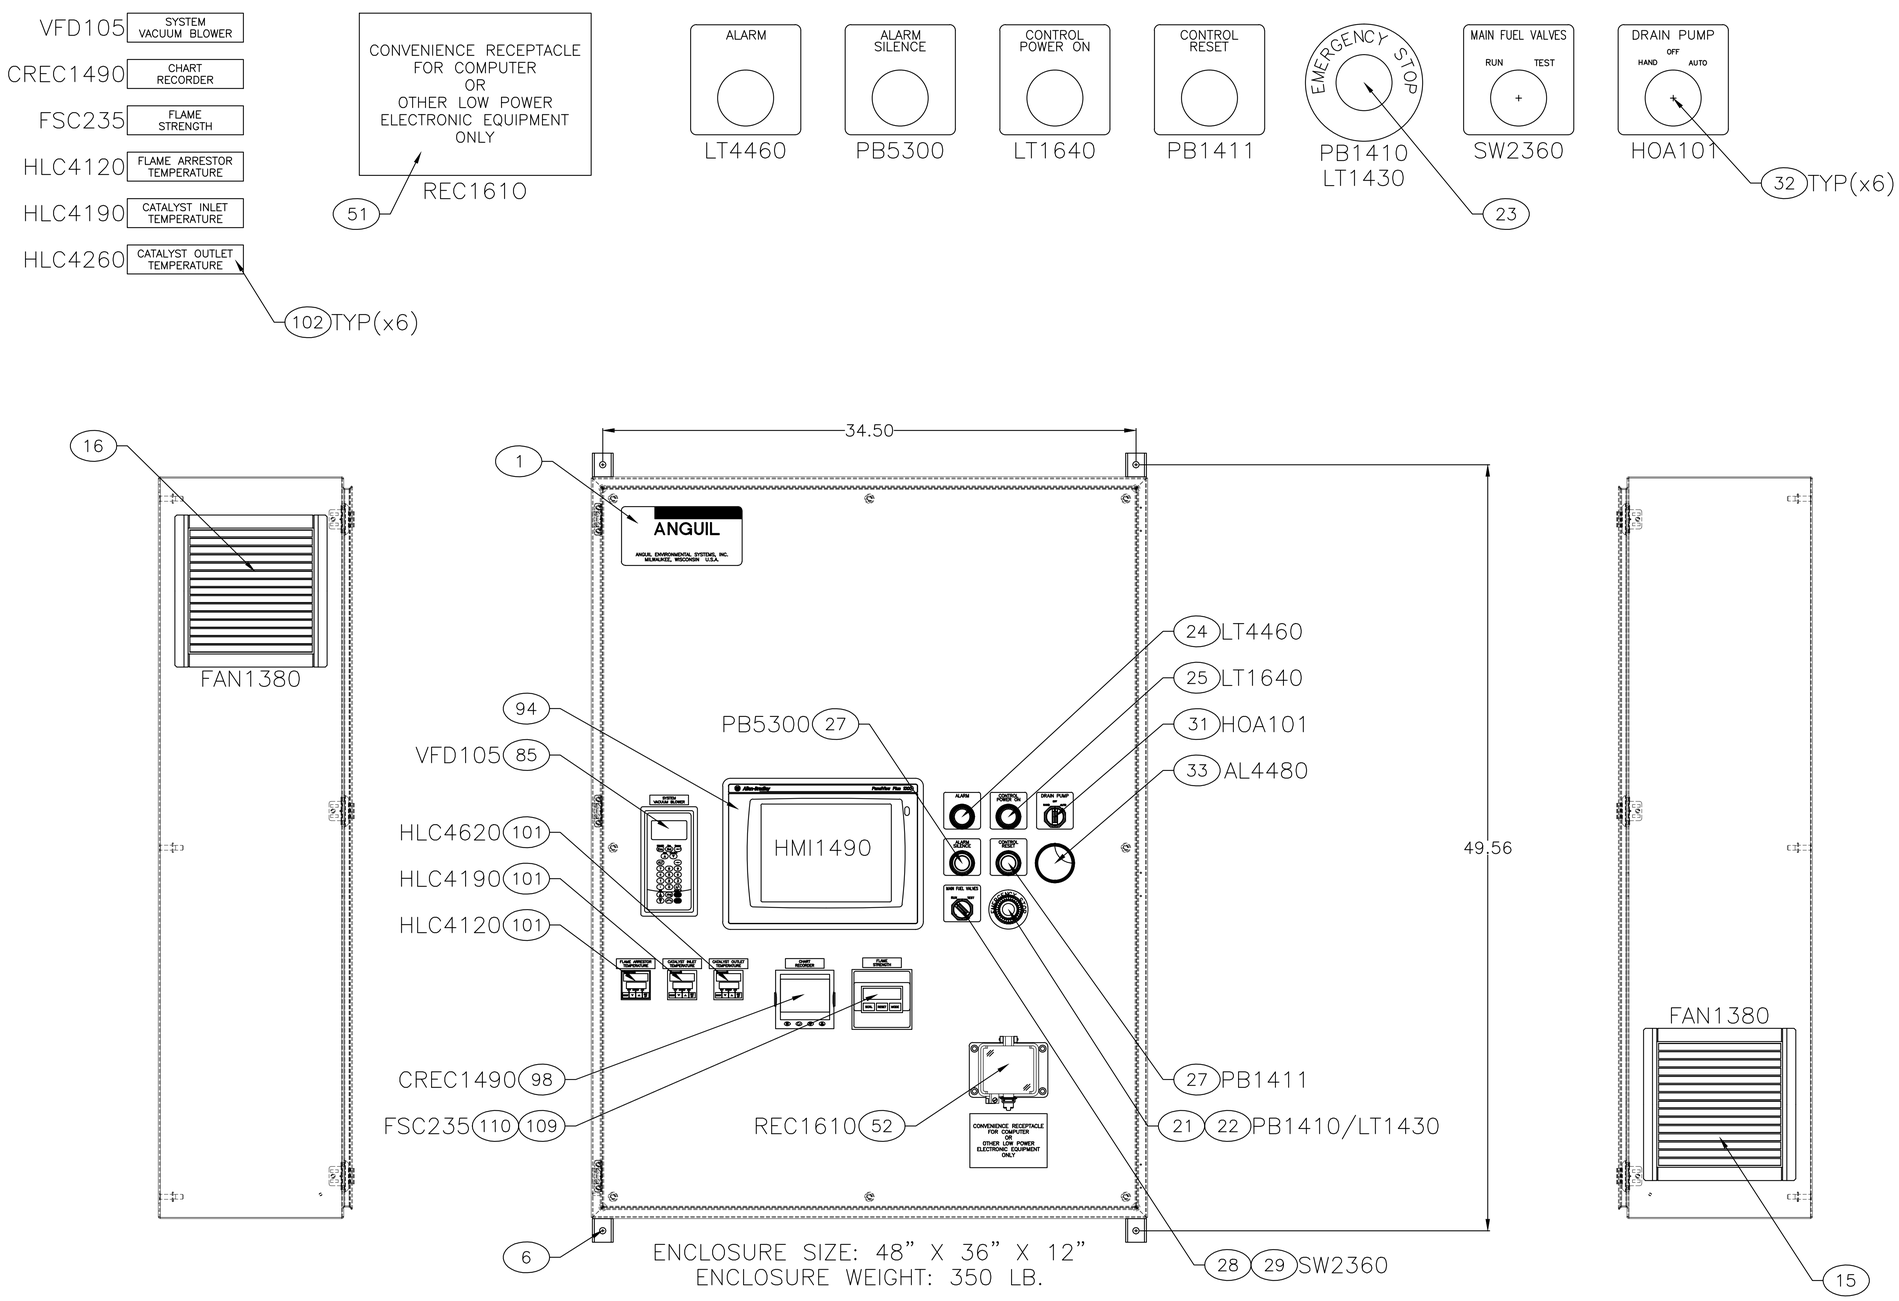

REV	BY	DATE	CHANGE
A	RLG	9/18/12	AS BUILT

ANGUIL ENVIRONMENTAL SYSTEMS, INC.
MILWAUKEE, WISCONSIN

TITLE: MODEL 20 CATALYTIC OXIDIZER
MAIN CONTROL PANEL
ENCLOSURE DETAILS

DRAWING NO. 16512455

REV. A

CUSTOMER: SHAW ENVIRONMENTAL
KIRTLAND AFB, NM

PAGE 6 OF 9

SOURCE –

NOTE:

DRAWN RLG DATE 8/19/12

AUTOCAD PATH JOBS\16000s\16512\ELEC

SCALE NONE

CHECKED: DATE:

APPROVED: DATE:

LAST CHANGED BY: DATE: