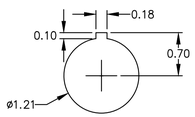

DETAIL A
30MM OPERATOR
(TYP OF 23)

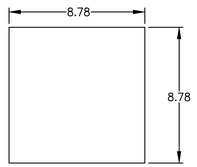

DETAIL B
RITTAL FILTER FAN
P/N 3241110

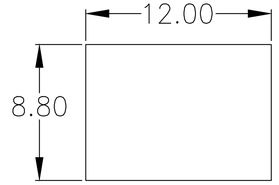

DETAIL C
PANELVIEW 1000 PLUS COMPACT
2711PC-T10C4D1

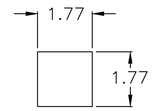

DETAIL D
BARBER COLMAN
07SL-91113-000-0-00

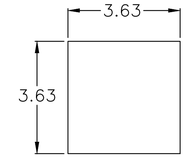

DETAIL E
FIREYE
FLAME CONTROLLER

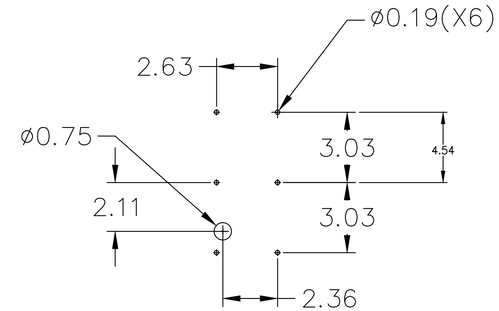

DETAIL G
AB HIM MODULE
20-HIM-C3S

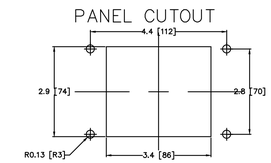

DETAIL I
GRACE ENGINEERING
P-R2-K3RF5

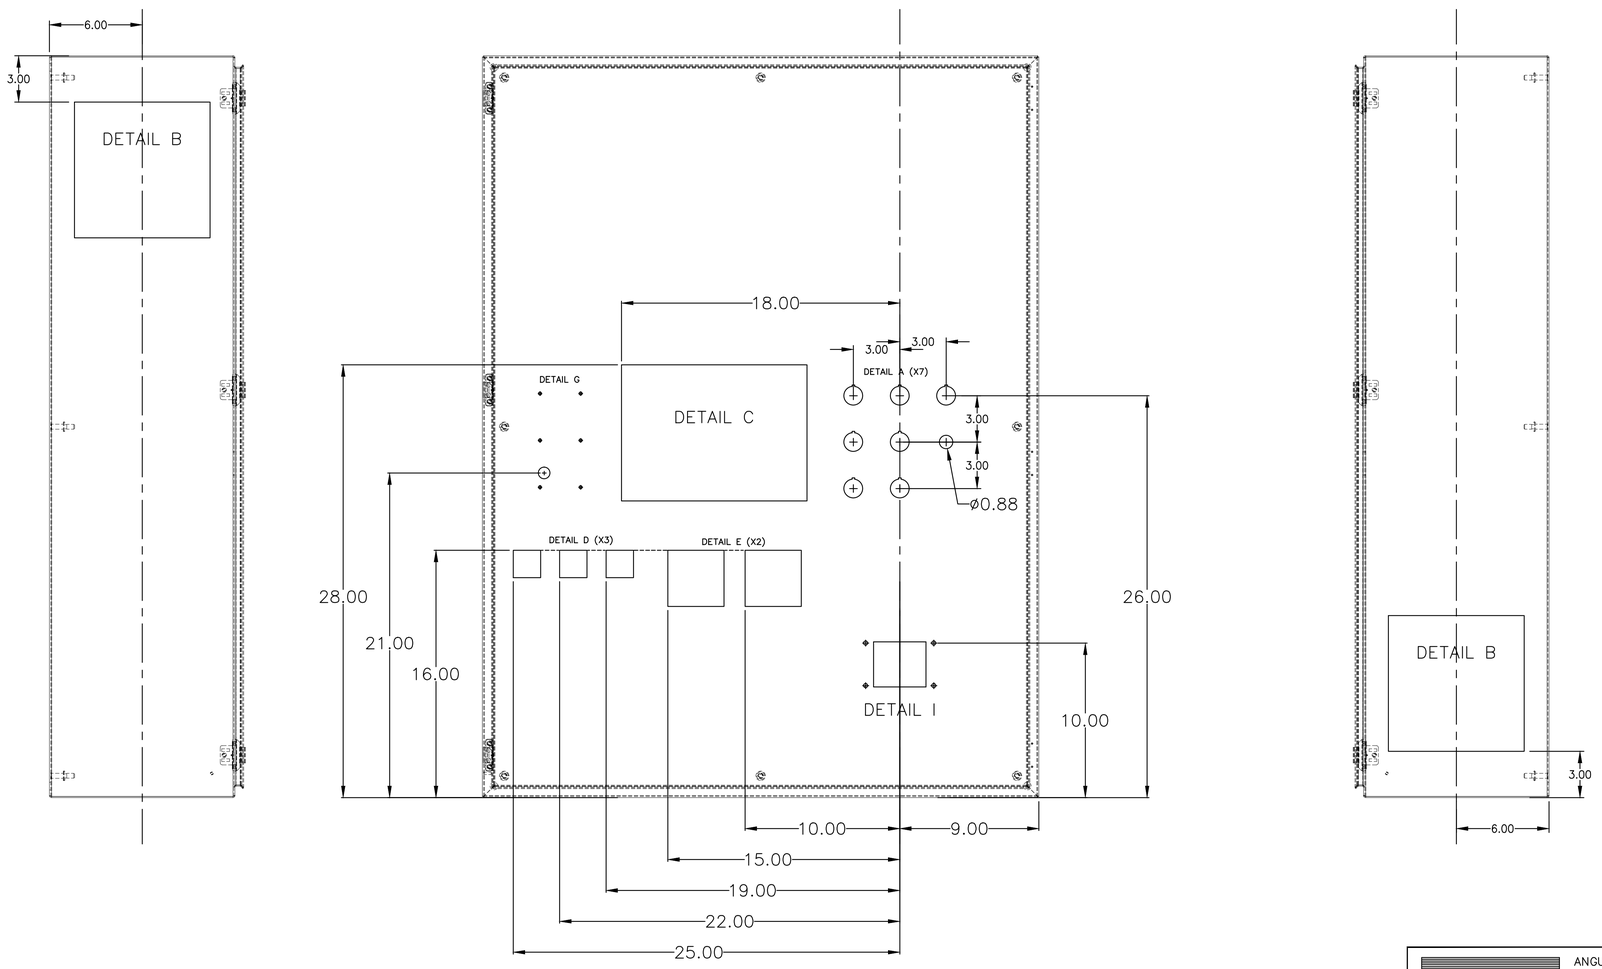

REV	BY	DATE	CHANGE
A	RLG	9/18/12	AS BUILT

ANGUIL

ANGUIL ENVIRONMENTAL SYSTEMS, INC.
MILWAUKEE, WISCONSIN

TITLE
MODEL 20 CATALYTIC OXIDIZER
MAIN CONTROL PANEL
ENCLOSURE CUTOUT DETAILS

DRAWING NO. 16512456

REV. A

CUSTOMER
SHAW ENVIRONMENTAL
KIRTLAND AFB, NM

PAGE 7 OF 9

SOURCE –

NOTE:

DRAWN	DATE	AUTOCAD PATH	SCALE	CHECKED:	APPROVED:	LAST CHANGED BY:
RLG	8/19/12	JOBS\16000s\16512\ELEC	NONE	DATE:	DATE:	DATE: