SURVEY OF

MONITORING WELLS & OTHER POINTS
BULK FUELS FACILITY
KIRTLAND AIR FORCE BASE

BERNALILLO COUNTY, NEW MEXICO

MAY 2011

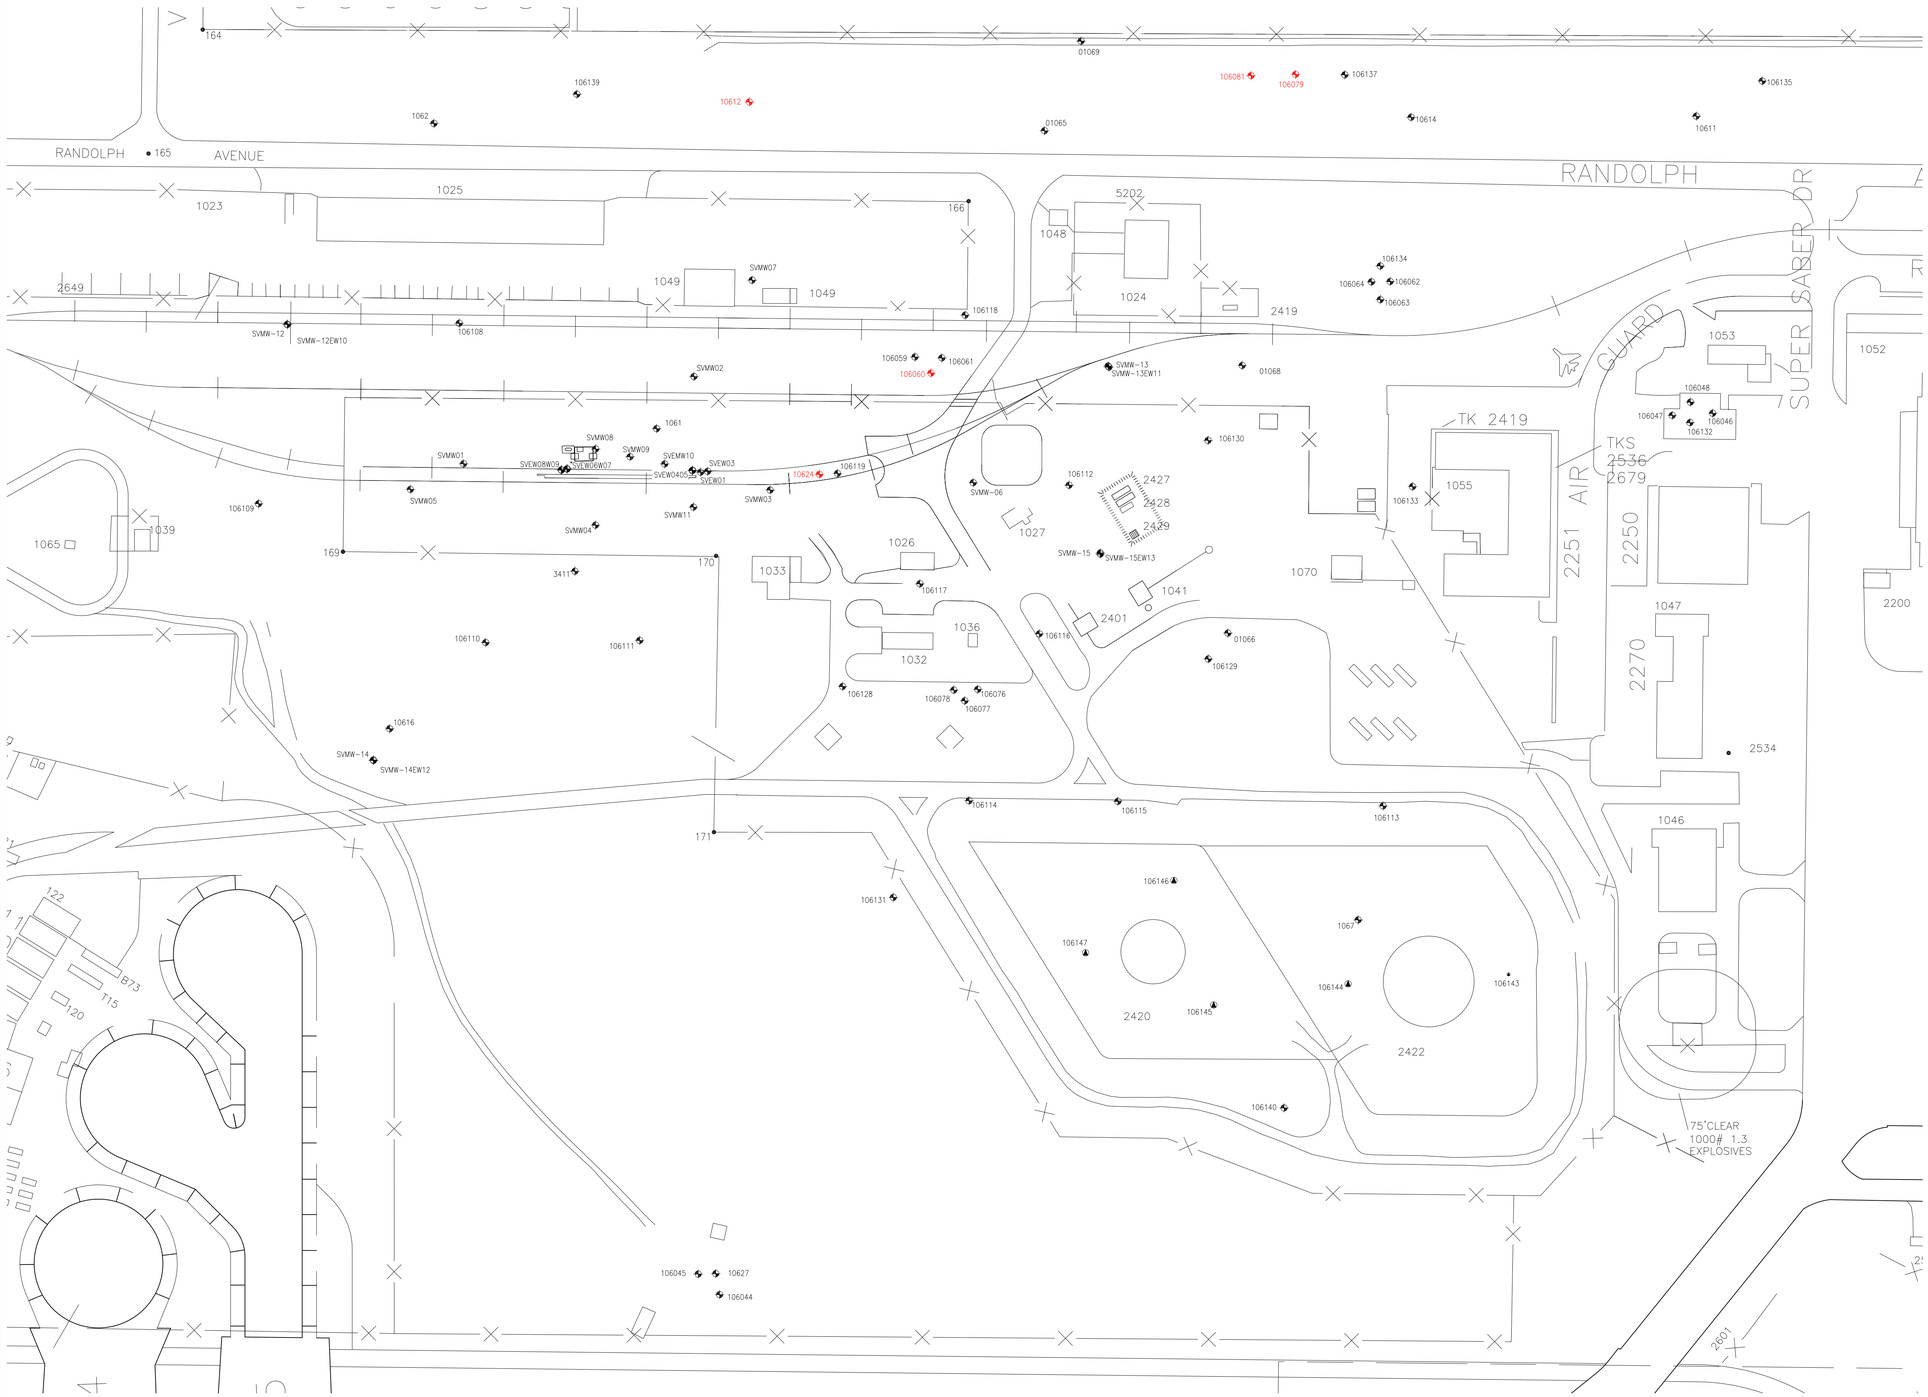

SCALE: 1" = 100'

100 50 0 100

LEGEND

- CONTROL POINT
- PREVIOUSLY SURVEYED MONITORING WELLS
- PREVIOUSLY SURVEYED SSB GROUND LOCATIONS (SEE DATES AND COORDINATES ON SHEET 2)
- SITE IMPROVEMENT POINTS
- NEWLY SURVEYED MONITORING WELLS (MAY 2011)

NOTES

1. GRID COORDINATES ARE NAD 83 DATUM VALUES BASED ON NEW MEXICO STATE PLANE COORDINATE SYSTEM, CENTRAL ZONE. BASIS OF COORDINATES ARE PUBLISHED VALUES OF NATIONAL GEODETIC SURVEY (NGS) CONTROL STATION "HANGAR" AND BEARING N84°36'13"E BETWEEN NGS CONTROL STATION "HANGAR" AND NGS CONTROL STATION "1 M18". PROJECT CONVERSION FACTORS ARE GRID-TO-GROUND=1.000343197744 AND GROUND-TO-GRID=0.99965692.
2. ELEVATIONS ARE NAVD 88 DATUM VALUES BASED ON NGS CONTROL STATION "HANGAR", ELEVATION = 5,343.43 FEET. GPS/RTK METHODS AND GEOID99 MODEL WERE USED TO DETERMINE ELEVATIONS OF ALL SURVEYED POINTS.
3. DRAWING COORDINATES ARE GRID.
4. POINTS SHOWN IN RED COLOR WERE ADDED TO THE DRAWING IN MAY 2011.

26033MW-3-5-25-2011

Plat & Survey By:
ALBUQUERQUE SURVEYING CO. INC., 2119 Menaul Blvd. N.E., Albuquerque, New Mexico 87107 Ph. (505) 884-2036